



**PROFILE**  
SCALE: HORIZ. 1" = 40'  
VERT. 1" = 4'

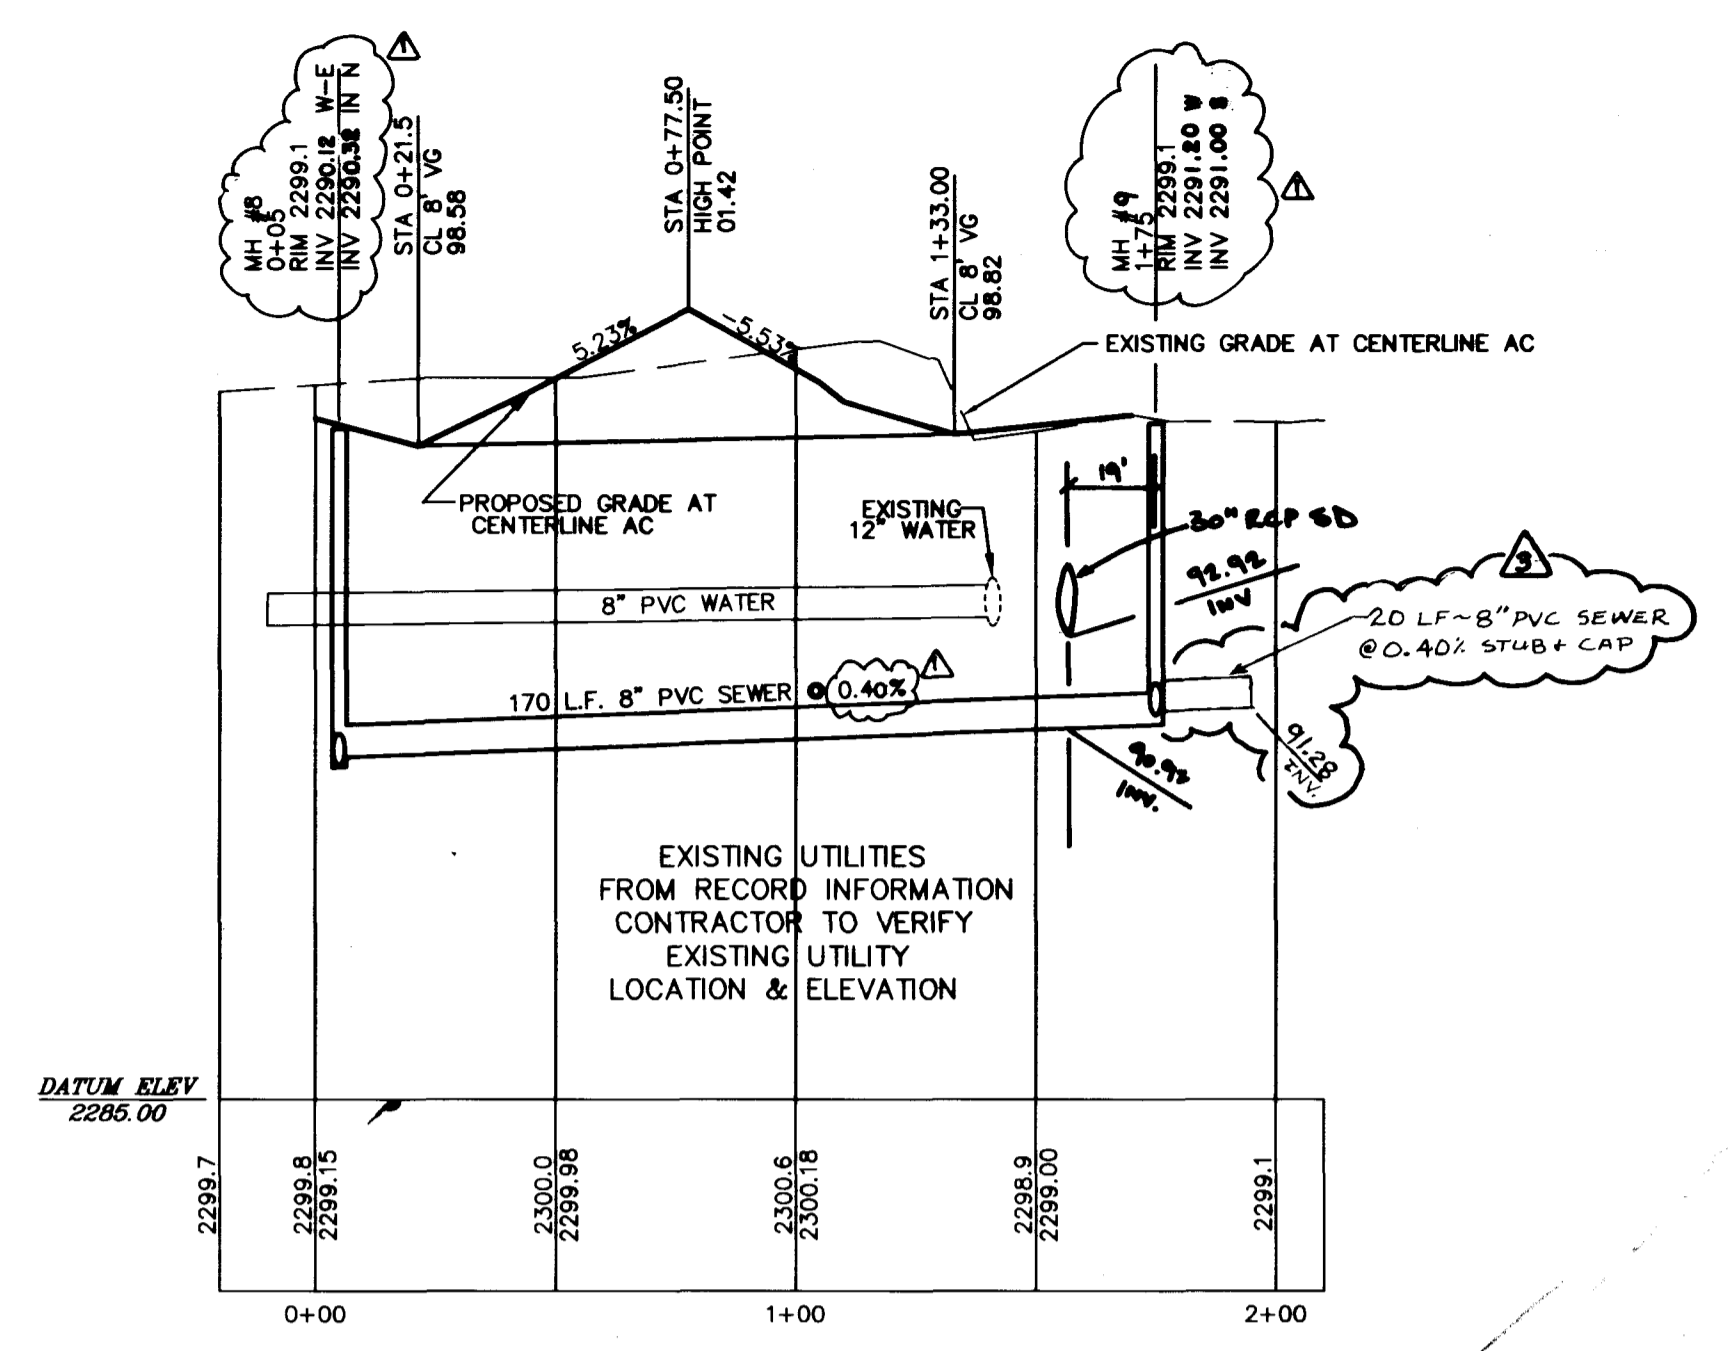


**PROFILE**  
SCALE: HORIZ. 1" = 40'  
VERT. 1" = 4'




**NOTE:**  
ALL STATIONS ARE REFERENCED TO CENTERLINE OF PRIVATE STREET, NOT CENTERLINE OF AC.  
ALL GRADES SHOWN IN PROFILE ARE REFERENCED TO CENTERLINE OF AC (CROWN LINE) AT THAT STATION.  
SEE TYPICAL SECTION

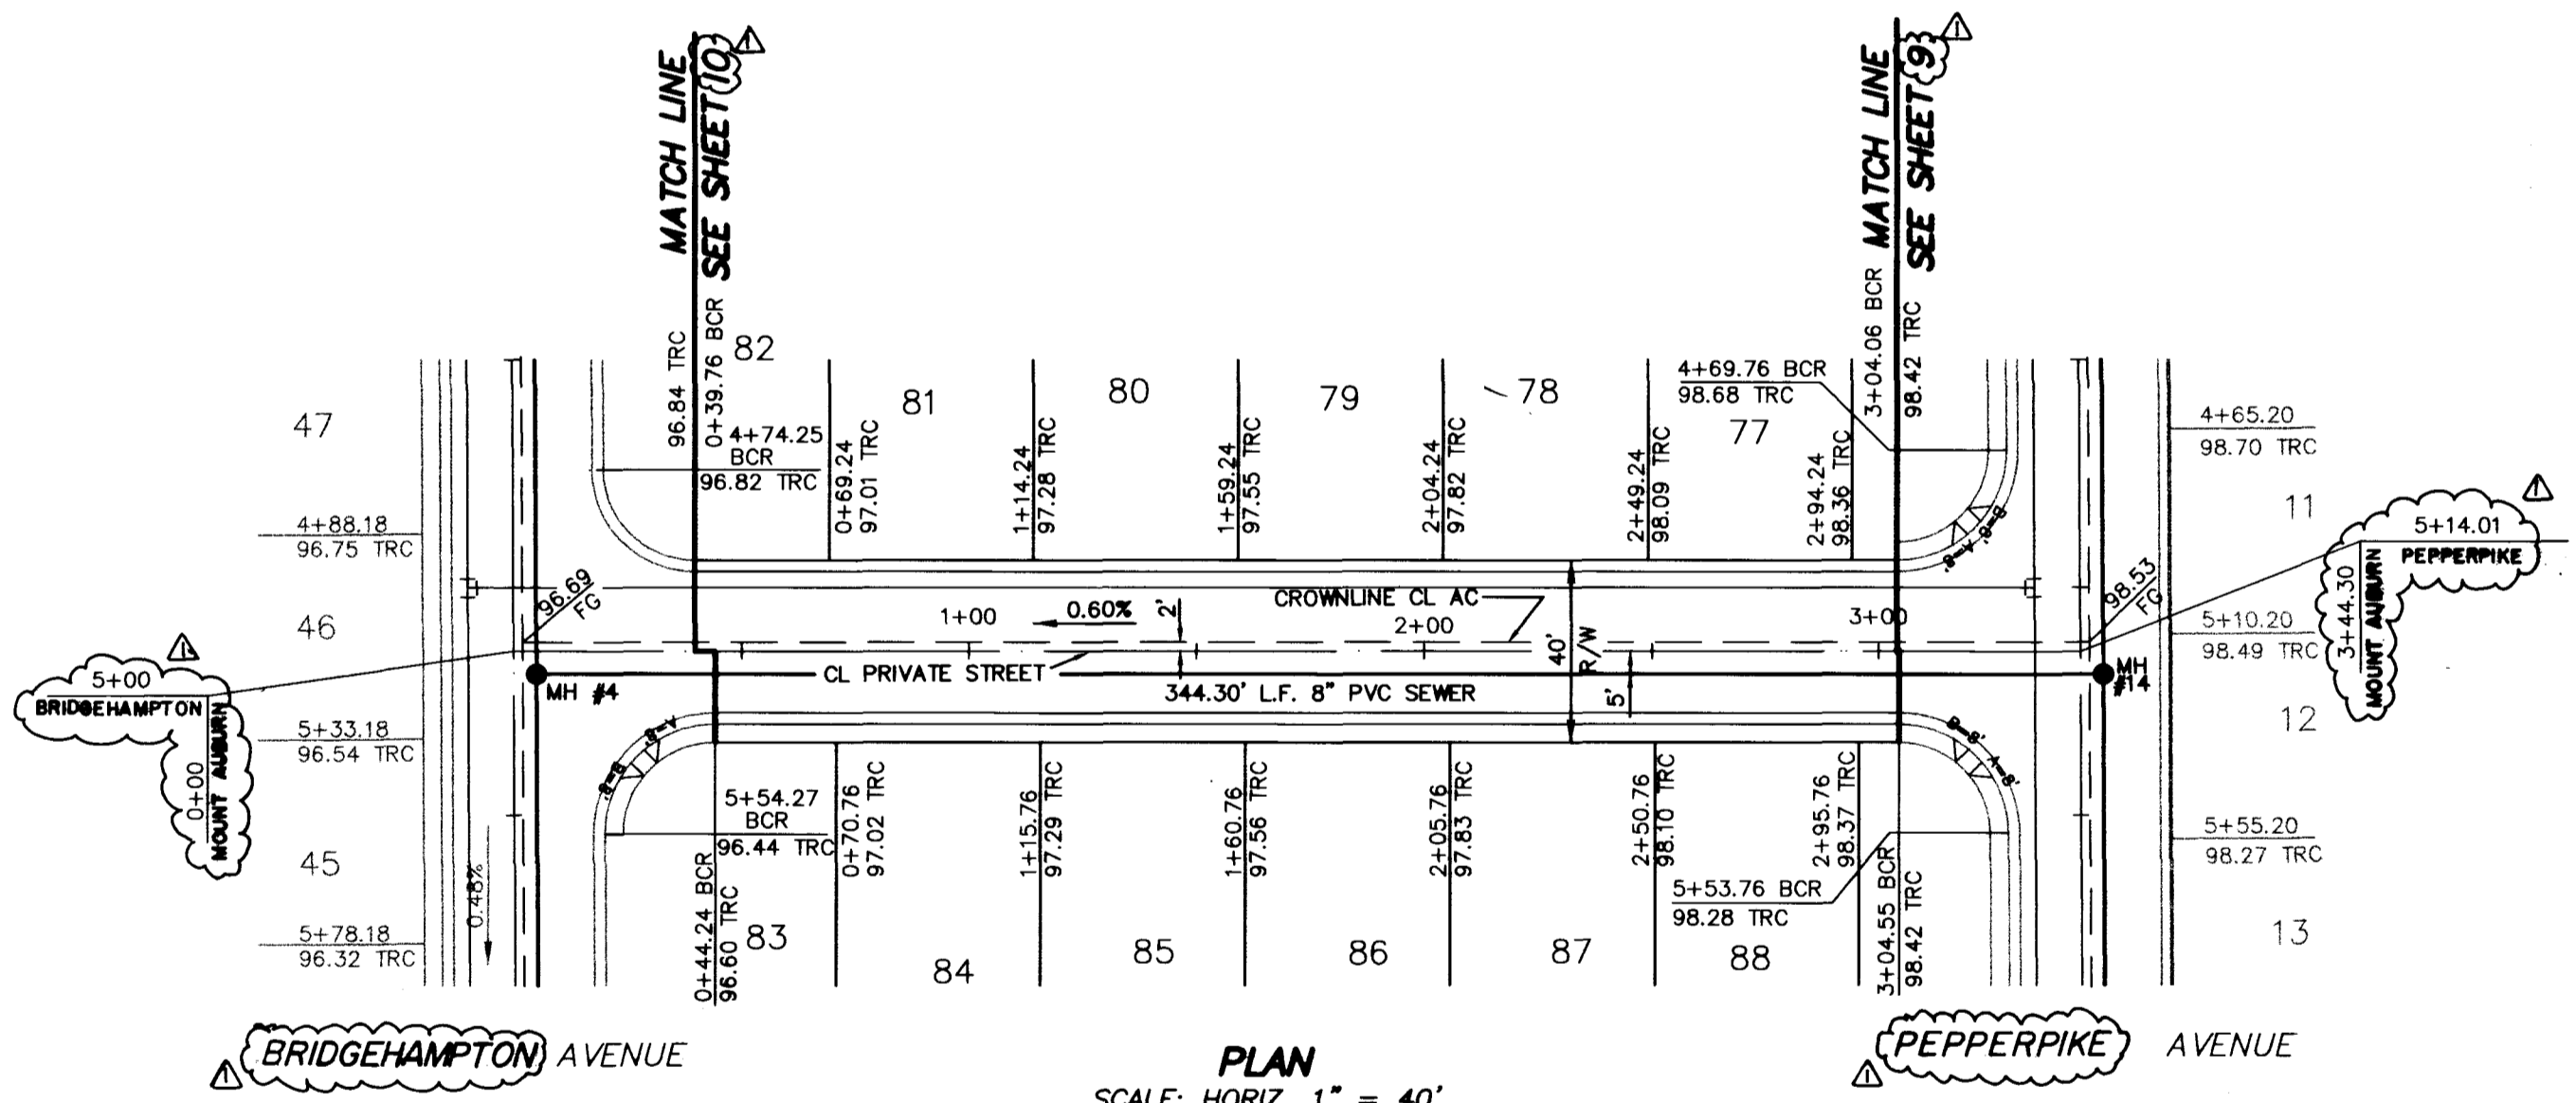

**MOUNT AUBURN STREET**  
(PRIVATE STREET)  
SCALE: HORIZ. 1" = 40'

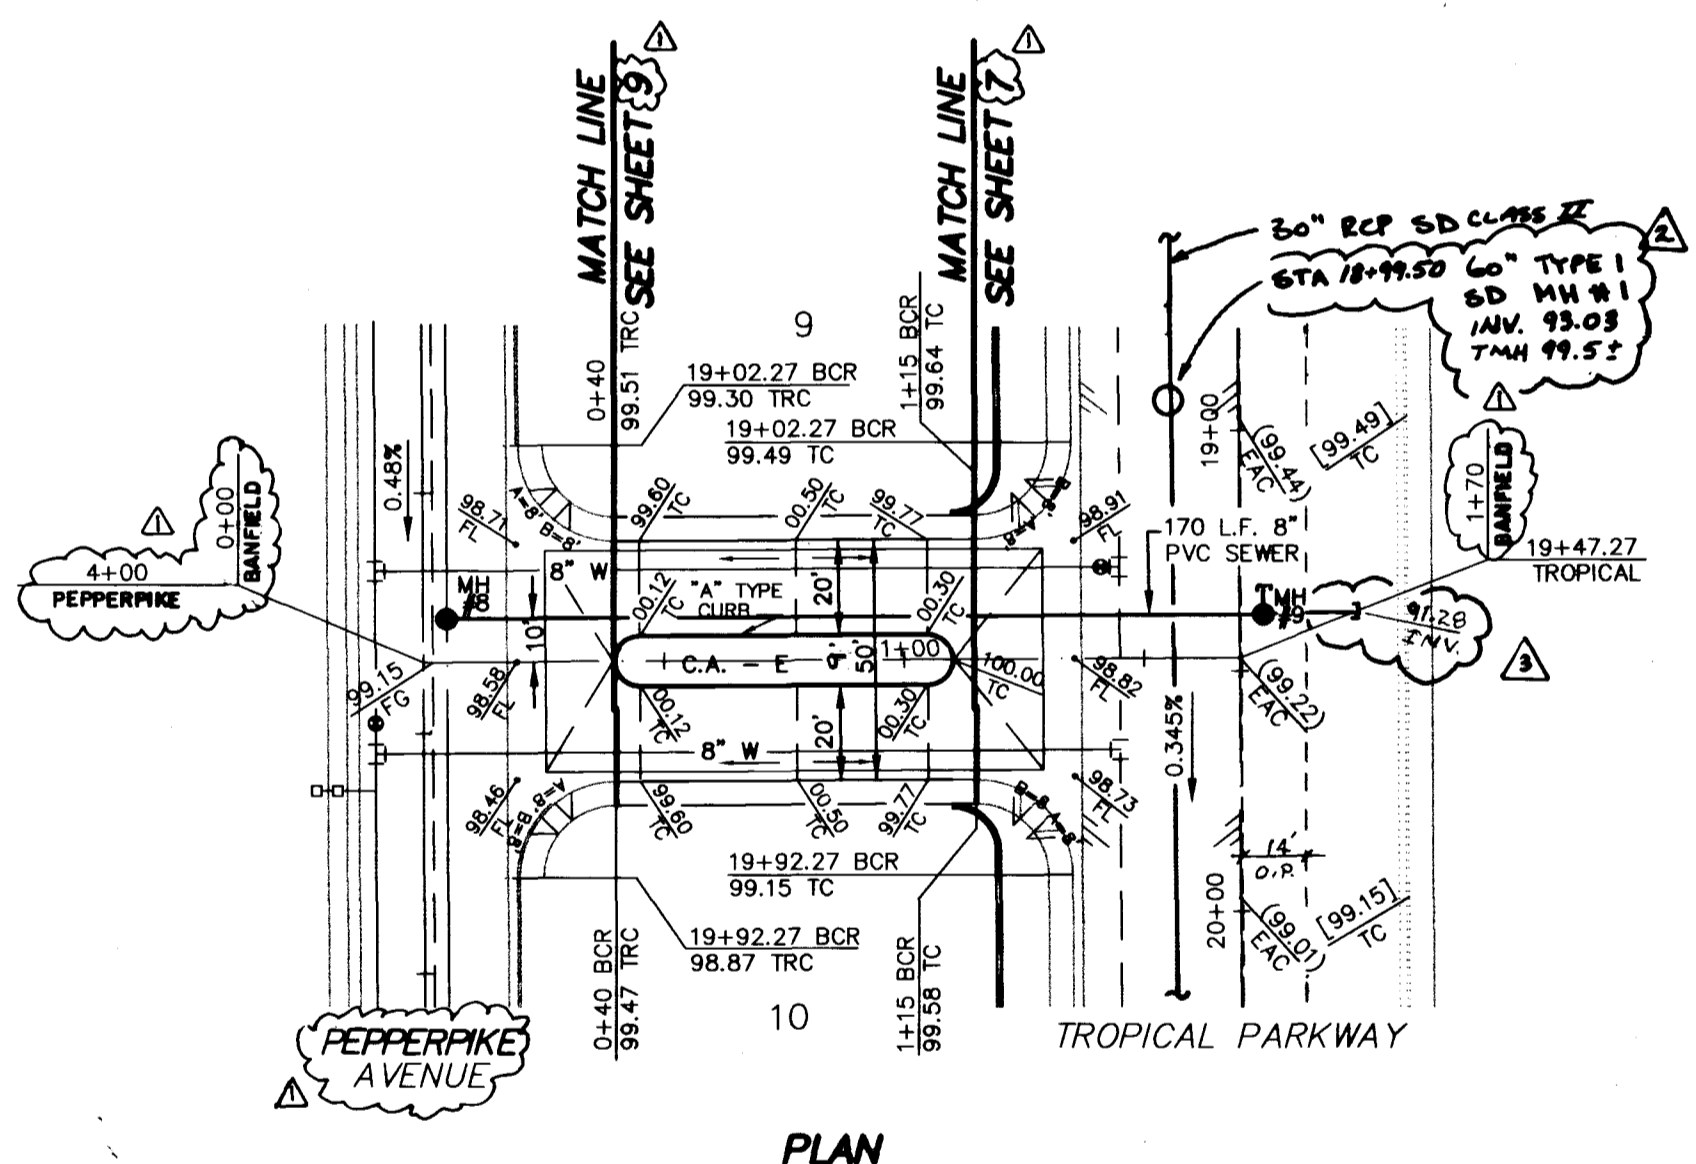

**BANFIELD STREET**  
(PRIVATE STREET)  
SCALE: HORIZ. 1" = 40'

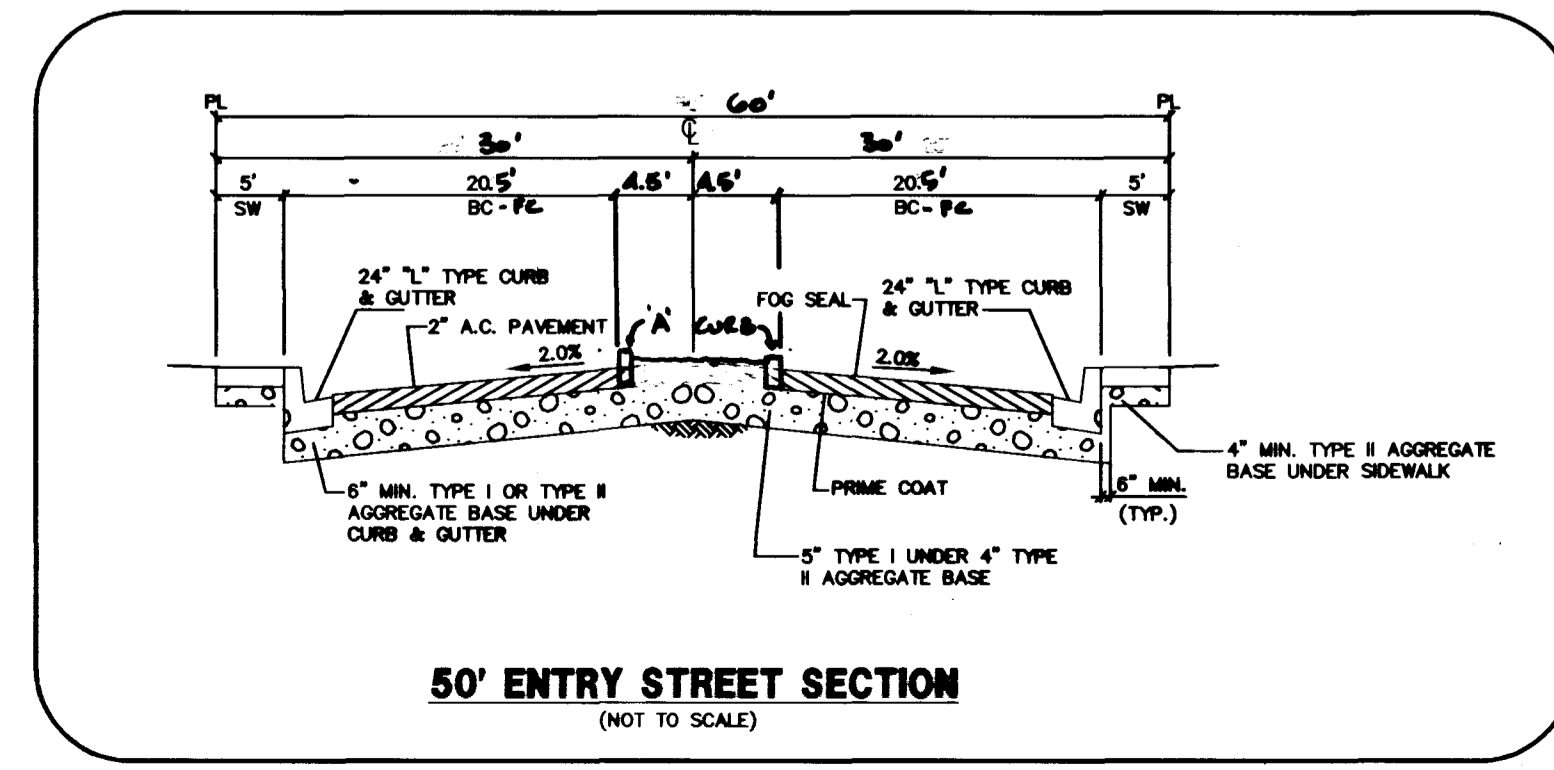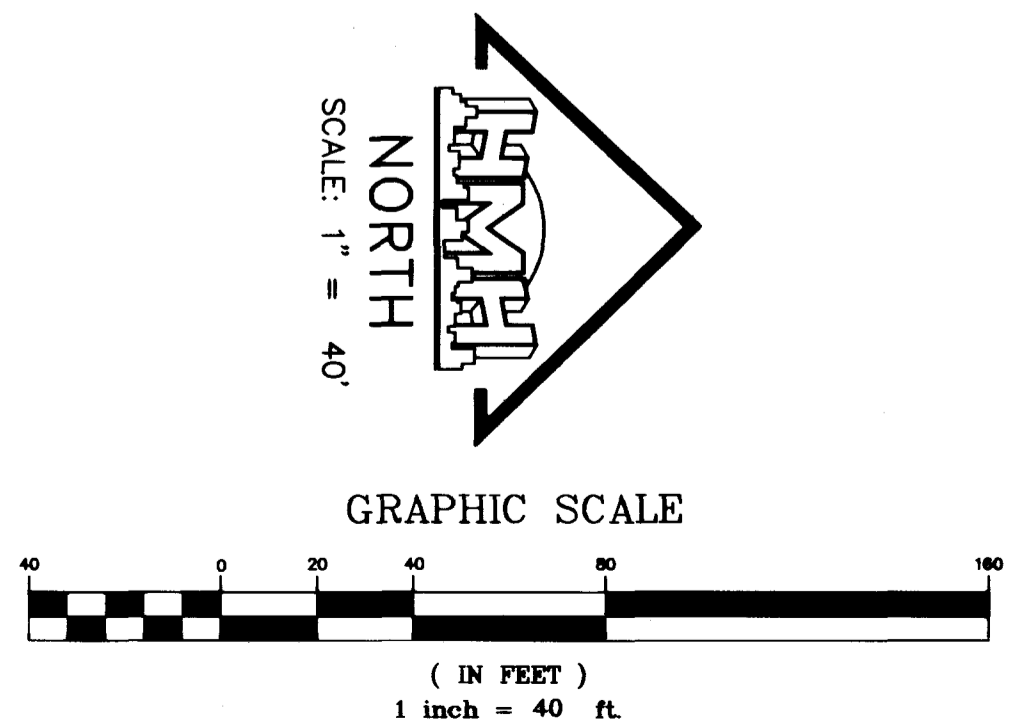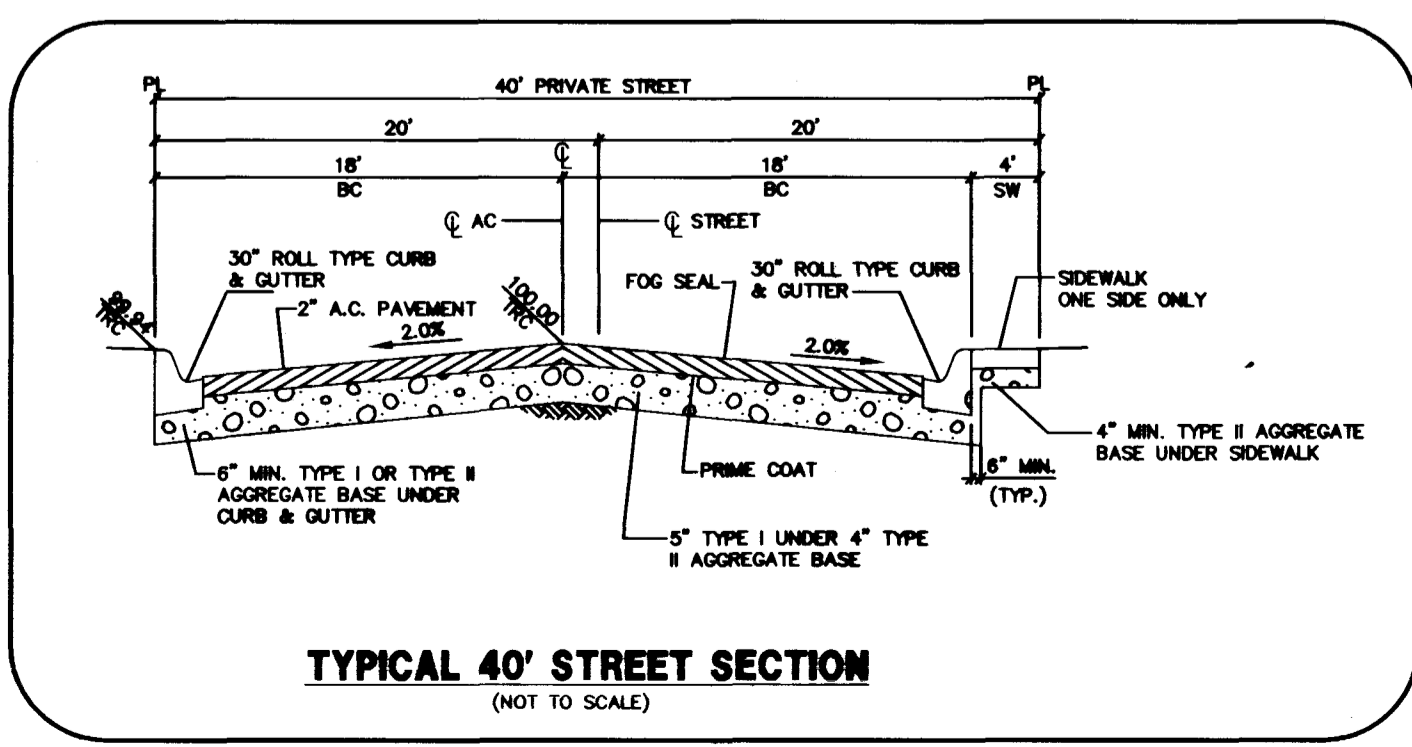

**BENCHMARK**  
CITY OF LAS VEGAS VERTICAL CONTROL #38-1LV90-36N4  
RIVET AND PLATE IN SOUTH TOP OF CURB, ANN ROAD AT  
CURB ANGLE POINT, 1530' EAST OF CALVERTS STREET.  
NAVD88 DATUM ELEVATION: 696.2262 METERS (2284.20 FEET)

**PROFESSIONAL ENGINEER SEAL**  
DAVID M. HUCKLE  
CIVIL  
No. 5256  
1/15/18

**PULTE HOMES**  
EAGLE CREEK ESTATES SOUTH UNIT 1  
MOUNT AUBURN STREET  
AND BANFIELD STREET  
PLAN AND PROFILE

**SHEET 12**  
OF 13 SHEETS

REV. DATE: 8/17/18, 9/11/18  
DESCRIPTION: REVISION ST. MARKS, SAN SEWER ELEVATIONS & GRADES, RELOCATE EXISTING 4" & ADD 8" 17" CL. SEWER, ADD 20' L.F. 8" PVC SEWER, STUB

8-17-18  
9/11/18  
DL 9/15/18

8080 WEST SAHARA-SUITE D  
LAS VEGAS, NEVADA 89117  
PHONE: (702) 256-7850  
FAX: (702) 256-1710

C:\DRAWINGS\EAGLE\SO\TH\1\PROJECT\1\1E-SHT-12.dwg Mon Apr 13 08:22:27 1998 DRK

05201

10324

1074-4555-1

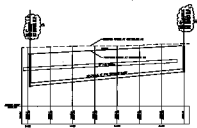




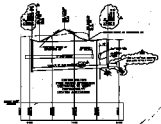







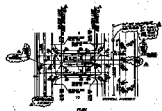











