
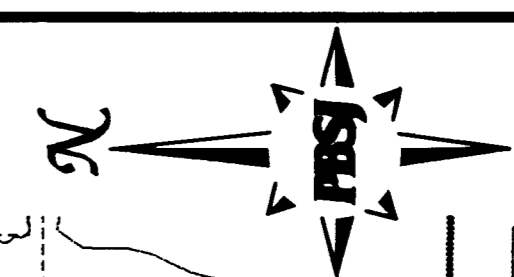


MATCHLINE STA 182+00.00
SEE DWG No. C17

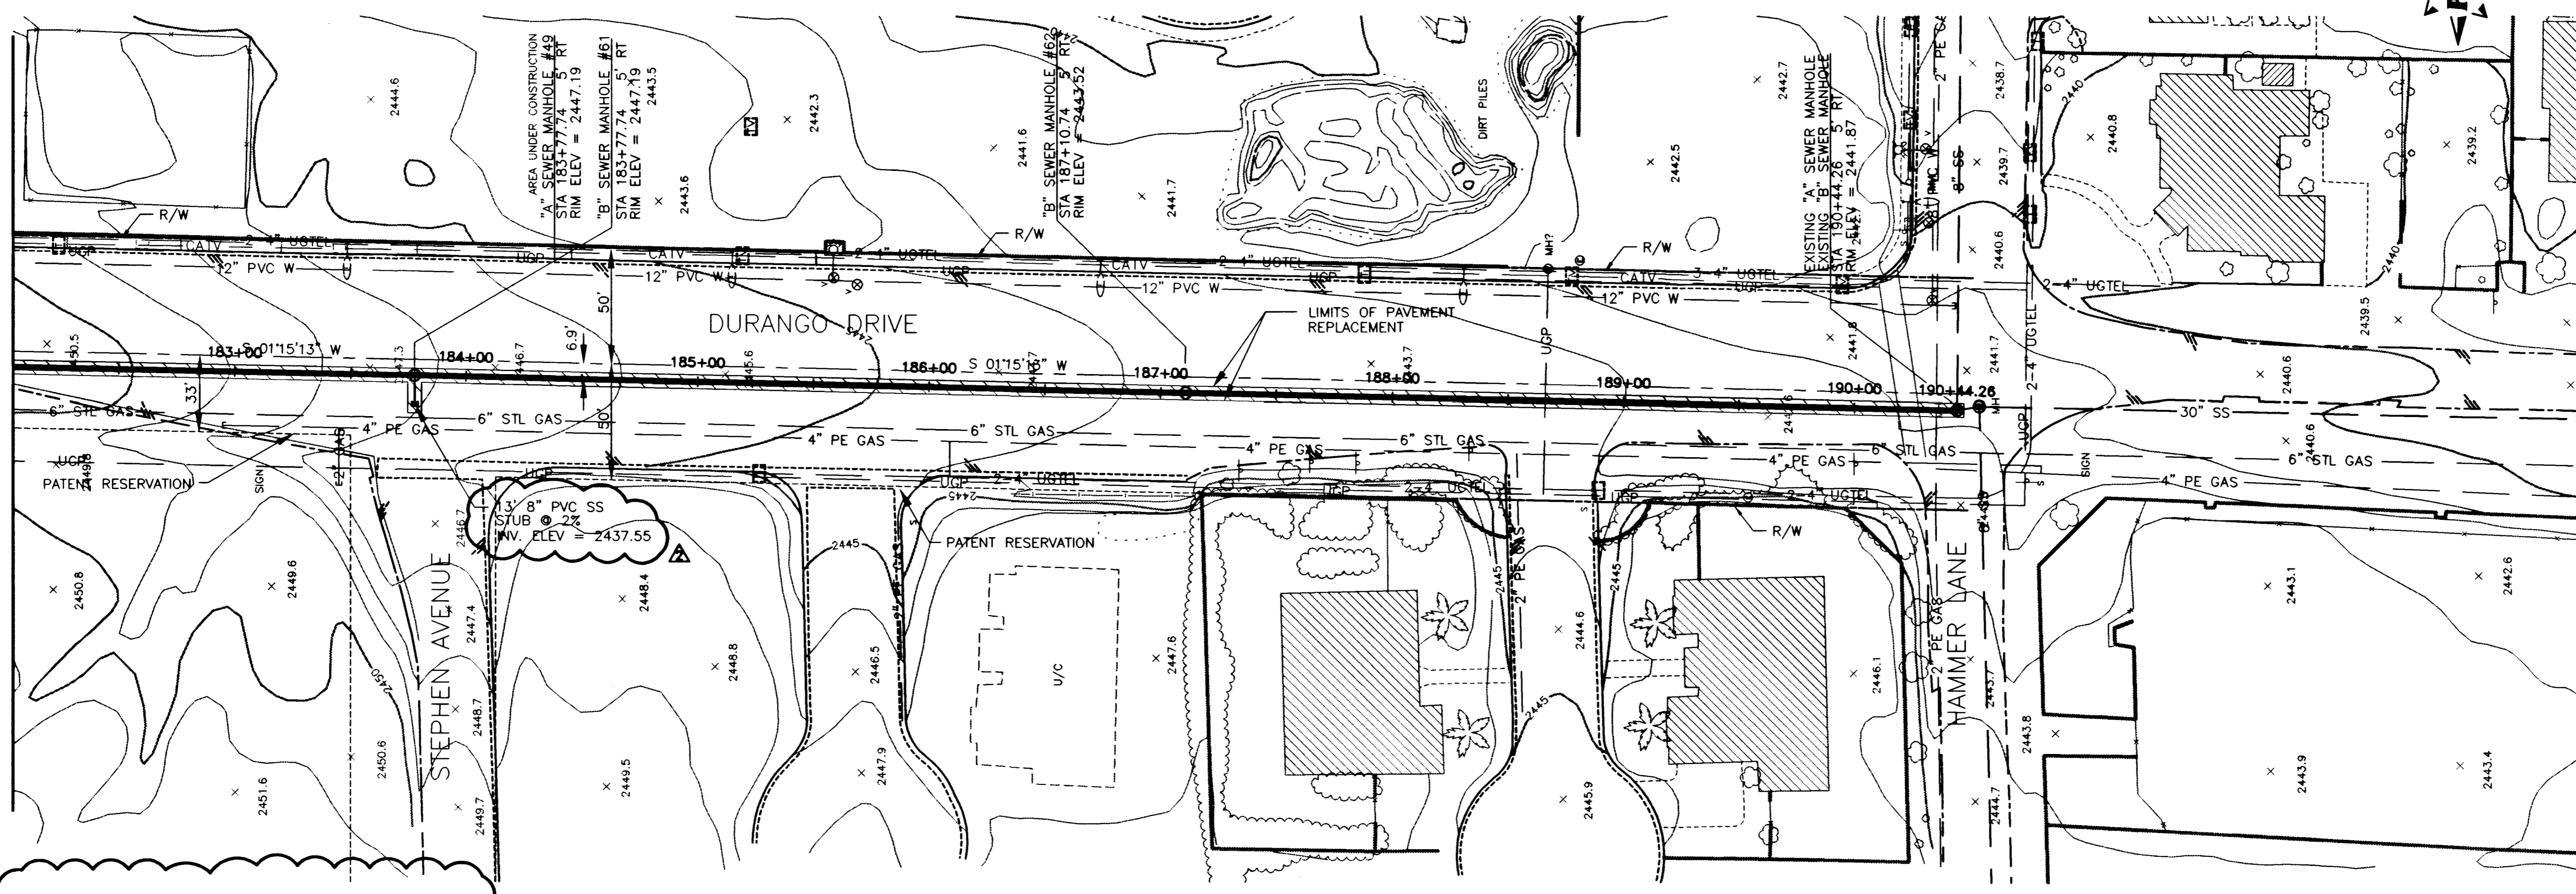

SANITARY SEWER ALTERNATIVES


ALT "A" - 8" SEWER STA 1+03.75 TO STA 18+80.47
10" SEWER STA 18+80.47 TO STA 98+90.83
27" SEWER STA 98+90.83 TO STA 125+20.39
30" SEWER STA 125+20.39 TO STA 156+66.01
36" SEWER STA 156+66.01 TO STA 190+44.26
ALT "B" - 8" SEWER STA 1+03.75 TO STA 190+44.26 (FOR BIDDING PURPOSES ONLY)

NOTE:
ALL EXISTING UTILITY LOCATIONS SHOWN HEREON ARE APPROXIMATE ONLY. IT SHALL BE THE CONTRACTOR'S RESPONSIBILITY TO DETERMINE THE EXACT VERTICAL AND HORIZONTAL LOCATION OF ALL EXISTING UNDERGROUND UTILITIES PRIOR TO CONSTRUCTION AND RELOCATE THESE UTILITIES AS NECESSARY. NO REPRESENTATION IS MADE THAT ALL UTILITIES ARE SHOWN HEREON. THE ENGINEER ASSUMES NO LIABILITY FOR UTILITIES NOT SHOWN OR UTILITIES NOT SHOWN IN THEIR PROPER LOCATIONS.

SCALE: HORIZ. 1"=40'
VERT. 1"=4'

Call before you Dig
1-800-227-2600

MATCHLINE STA 182+00.00
SEE DWG No. C17

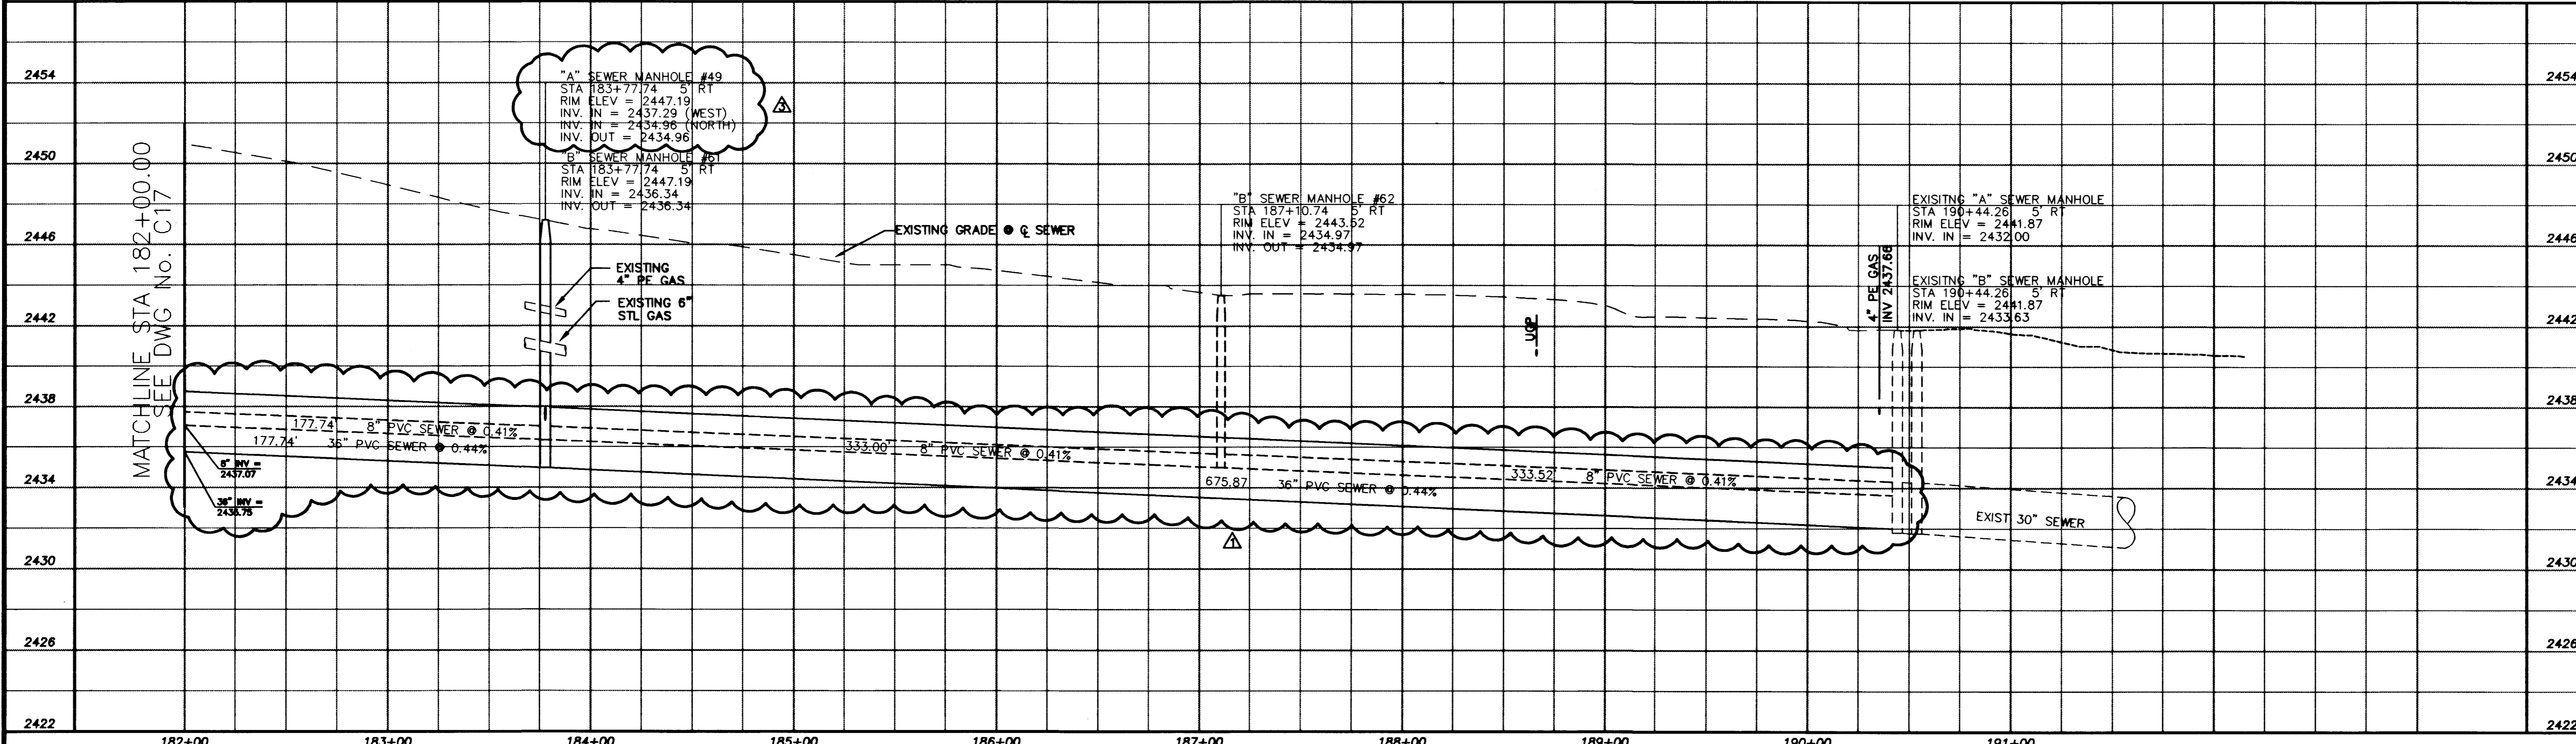


REVISIONS

NO.	DATE	DESCRIPTION	APPROVED
1	10/1/98	Changed Pipe Size from 36" to 30"	
2	10/1/98	Changed Pipe Invert Elevation	
3	10/1/98	Changed Manhole Invert Elevation	
4	10/1/98	Changed Manhole Invert Elevation	

DURANGO INTERCEPTOR SEWER
DESIGNED BY: J. LUSTIG
CHECKED BY: L. ANTWEIL
DATE: 8-31-98


PBS&J
501 N. Green Valley Hwy.
Henderson, Nevada 89014
PHONE: 702/733-7200
FAX: 702/733-7200

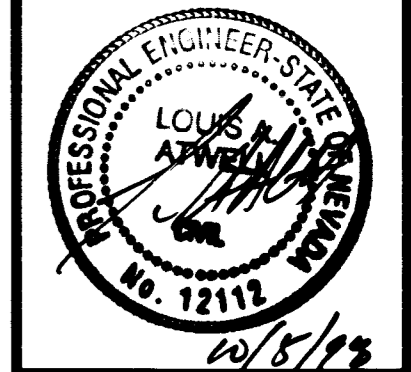

Department of Public Works
**DURANGO INTERCEPTOR SEWER
PLAN AND PROFILE**
STA 182+00.00 TO STA 190+44.26



DRAWING No. 23
C18

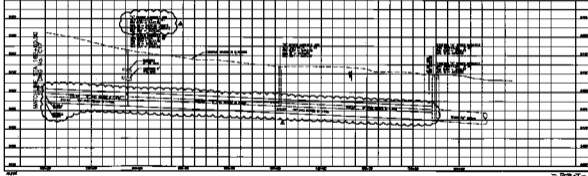














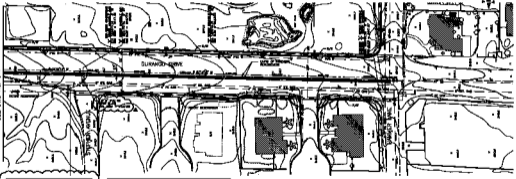









