


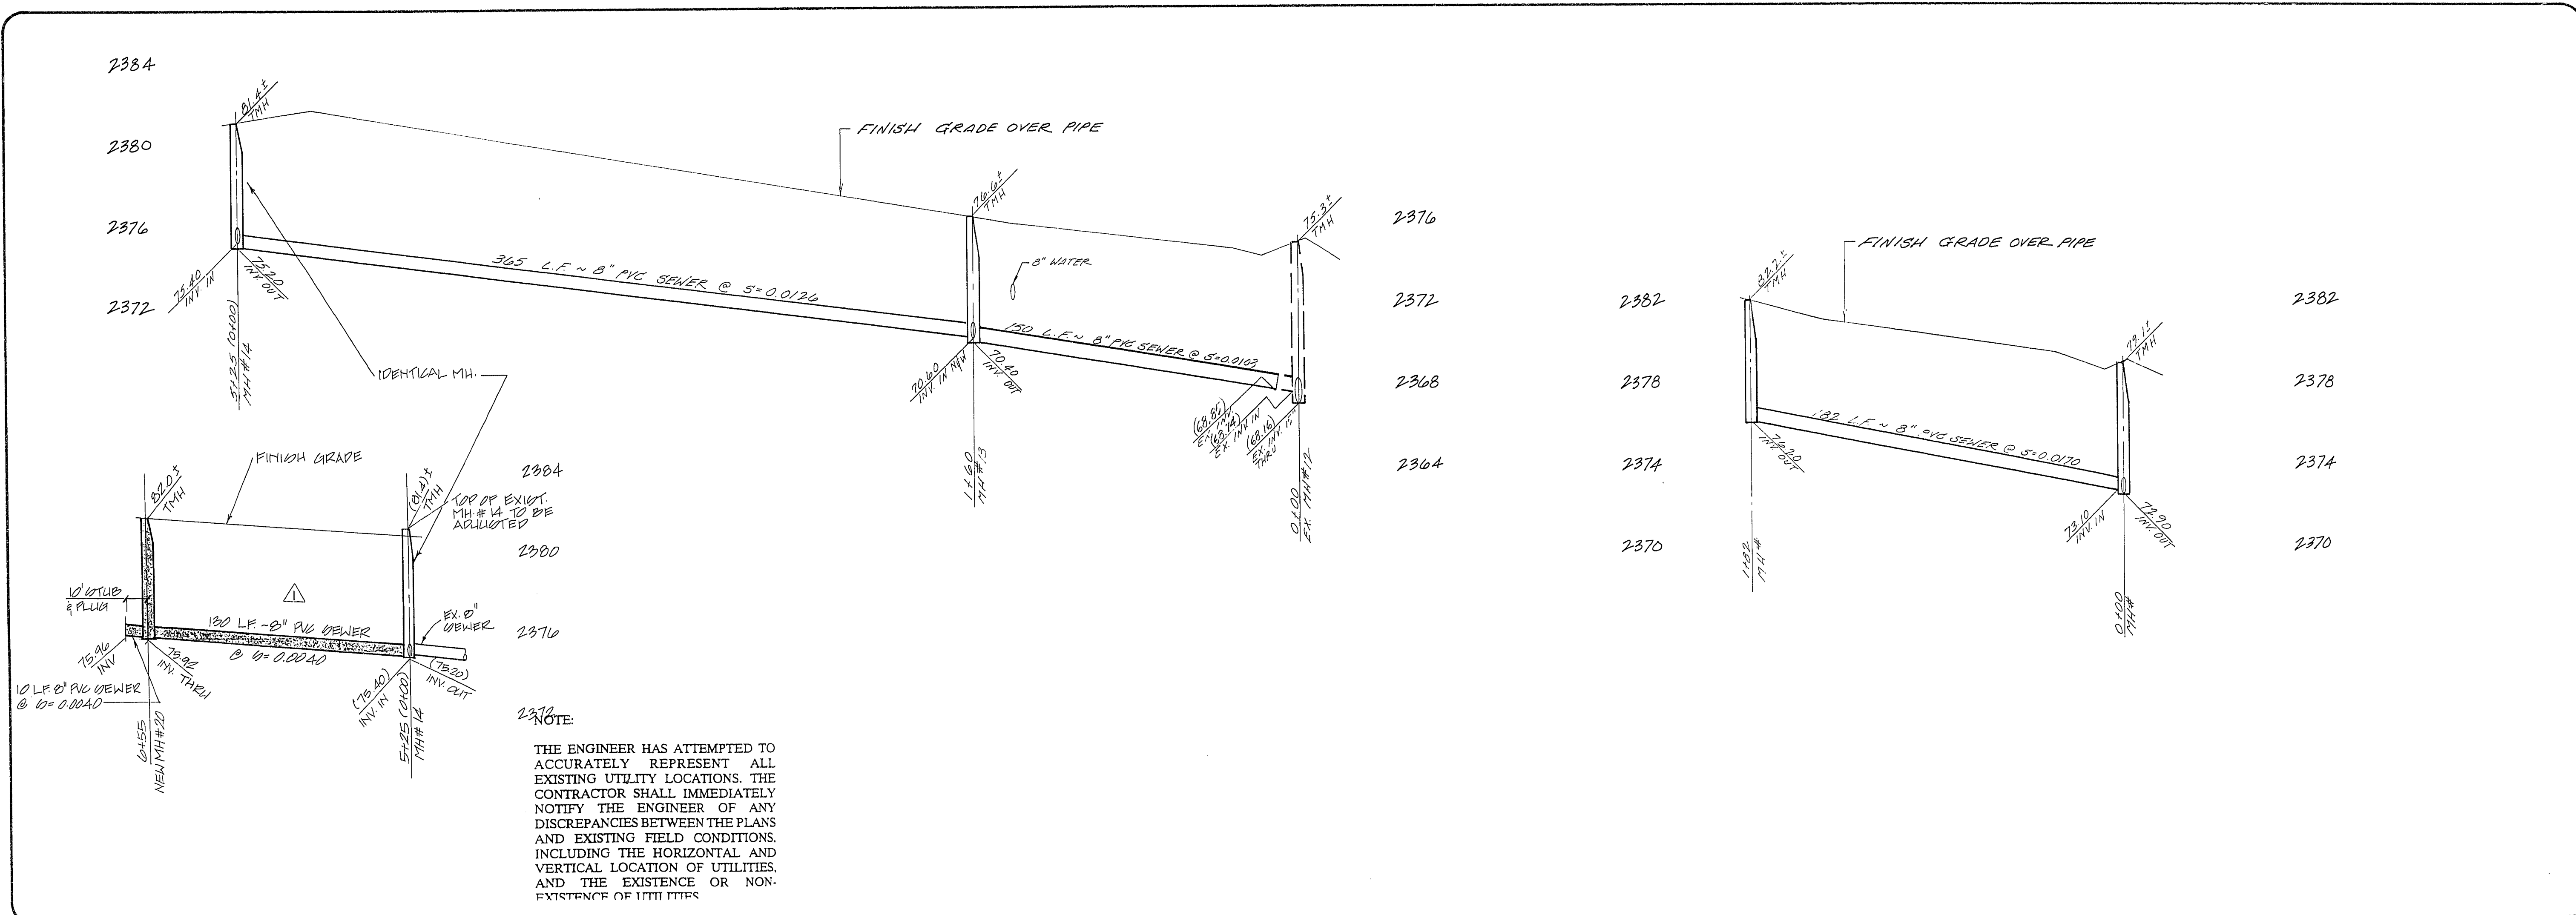

REV	DATE	BY	REVISION
1	10/1/89	RLM	REV. SEWER ON DESERT BREEZE AVE. PER SHEET 2-4

HONVEST CORP.
LAS VEGAS, NEVADA

CONSULTING ENGINEERS - PLANNERS
2300 PASEO DEL PRADO BUILDING A SUITE 100
LAS VEGAS, NEVADA 89102 PHONE (702) 873-7550

vtm nevada

