


| | | | |
|---------------------------|---------|-----|----------------------------|
| AMERICAN WEST HOMES, INC. | DATE | BY | REVISION |
| CITY OF LAS VEGAS, NEVADA | 8/12/96 | CKH | 1. Rev. CLV Easements |
| | 7/20/96 | CKH | 2. Adding 8" CLV Easements |

CONSULTING ENGINEERS • PLANNERS • LAND SURVEYORS
 2727 SOUTH RAINBOW BOULEVARD
 LAS VEGAS, NEVADA 89102-5148 PHONE (702) 873-7550 FAX (702) 362-2597

vtm nevada

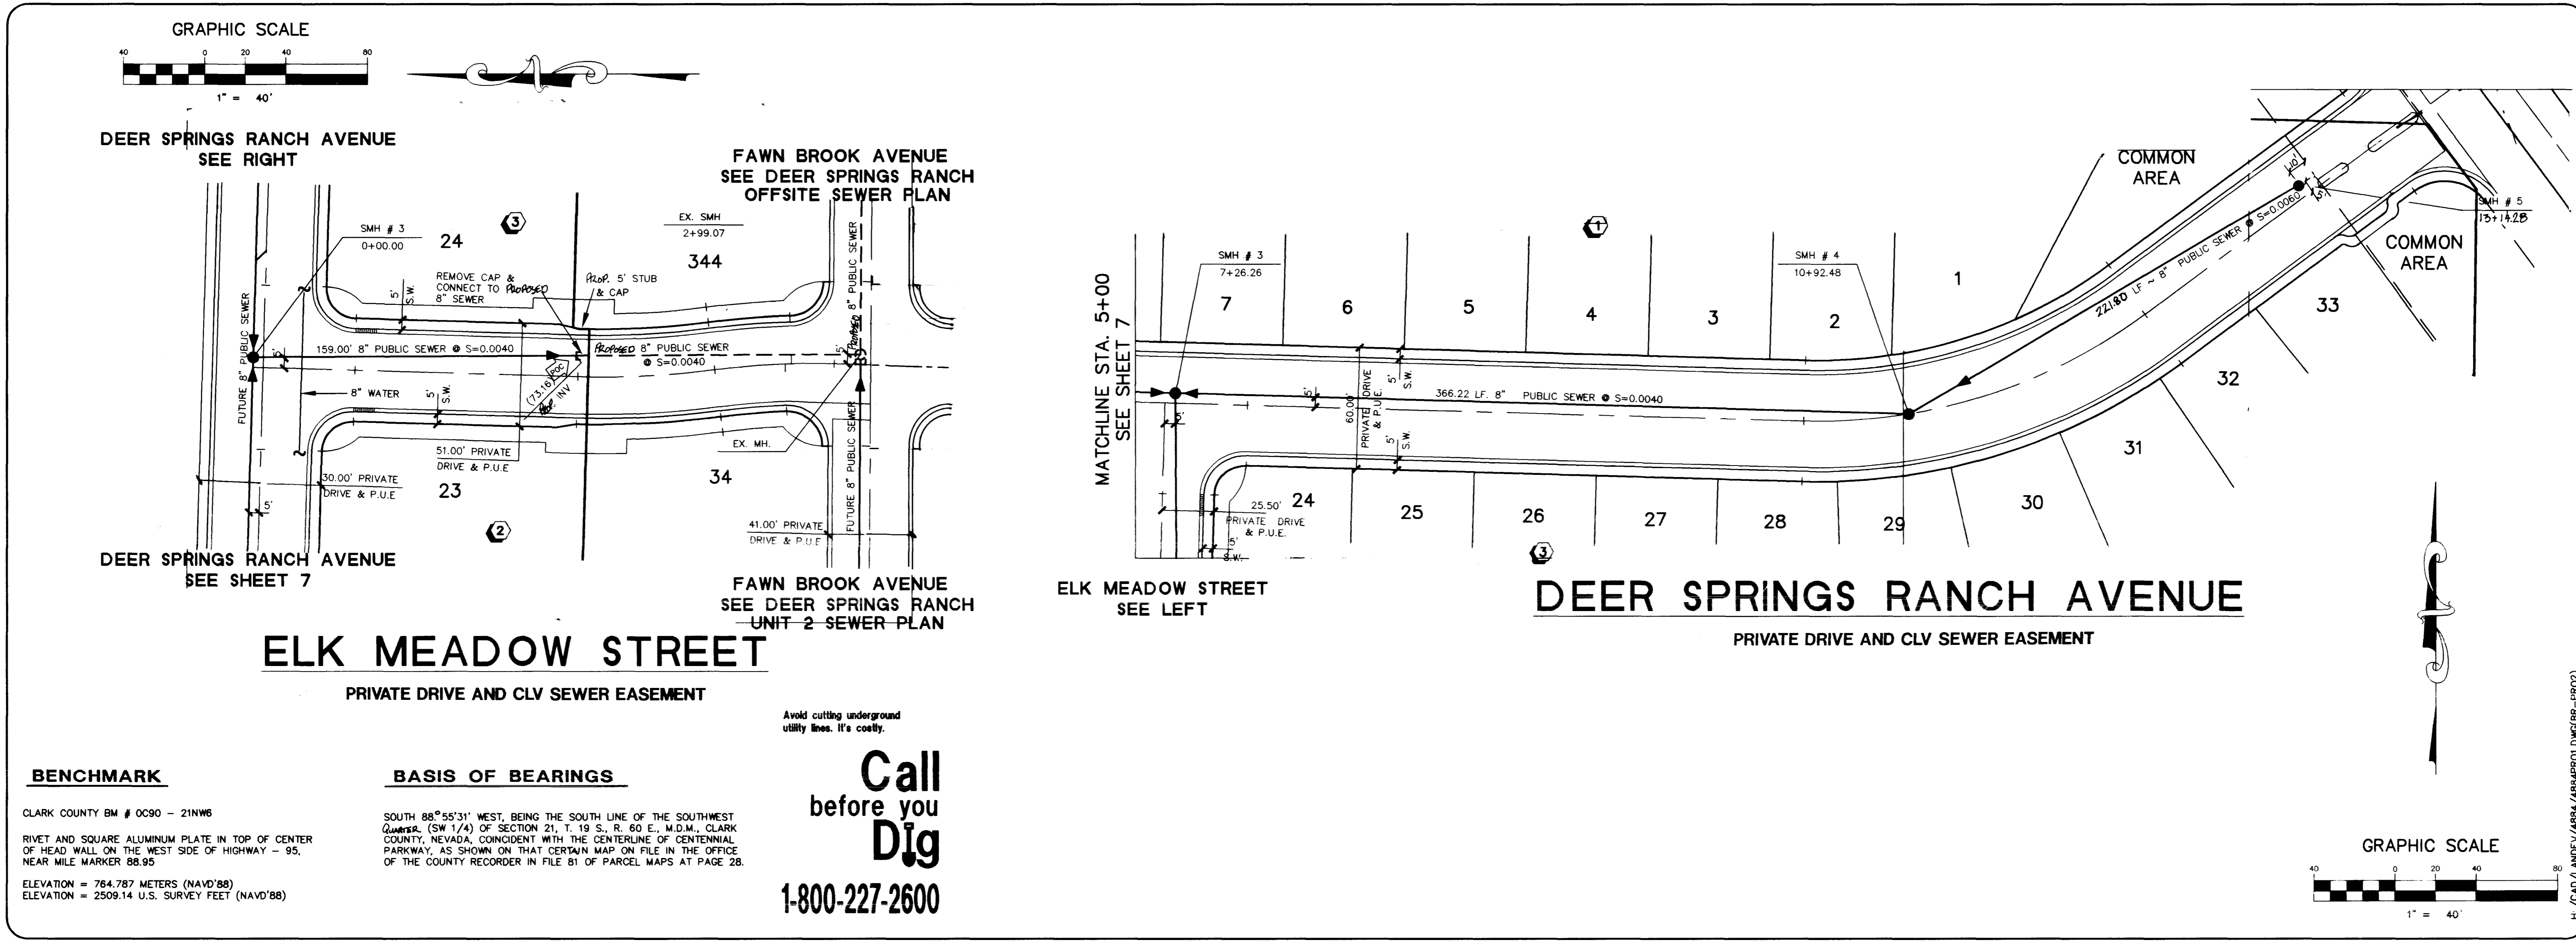

SEWER PLAN - PROFILE
DEER SPRINGS AVENUE
DEER SPRINGS RANCH
 UNIT - 1

PROJECT


SEAL
 CIVIL ENGINEER
 NO. 1065
 10 JUNE 96

WD NO. 4884-1
 BY CKH/RDM
 DATE MAR, '96
 SCALE HORIZ. 1"=40'
 VERT. 1"=4'
 SHEET 8 OF 9 SHEETS


H:\CAL\LANDEV\4884\4884PLOT1.dwg Non Jun 03 15:55:28 1996 Plotted by: MGB

5043


307Y-4478-1

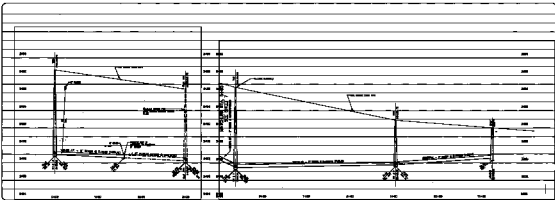


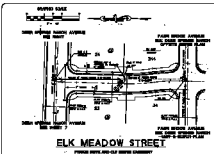

ELK MEADOW STREET

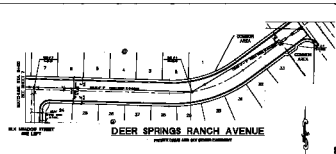

DEER SPRINGS RANCH AVENUE






Call before you Dig

 8