
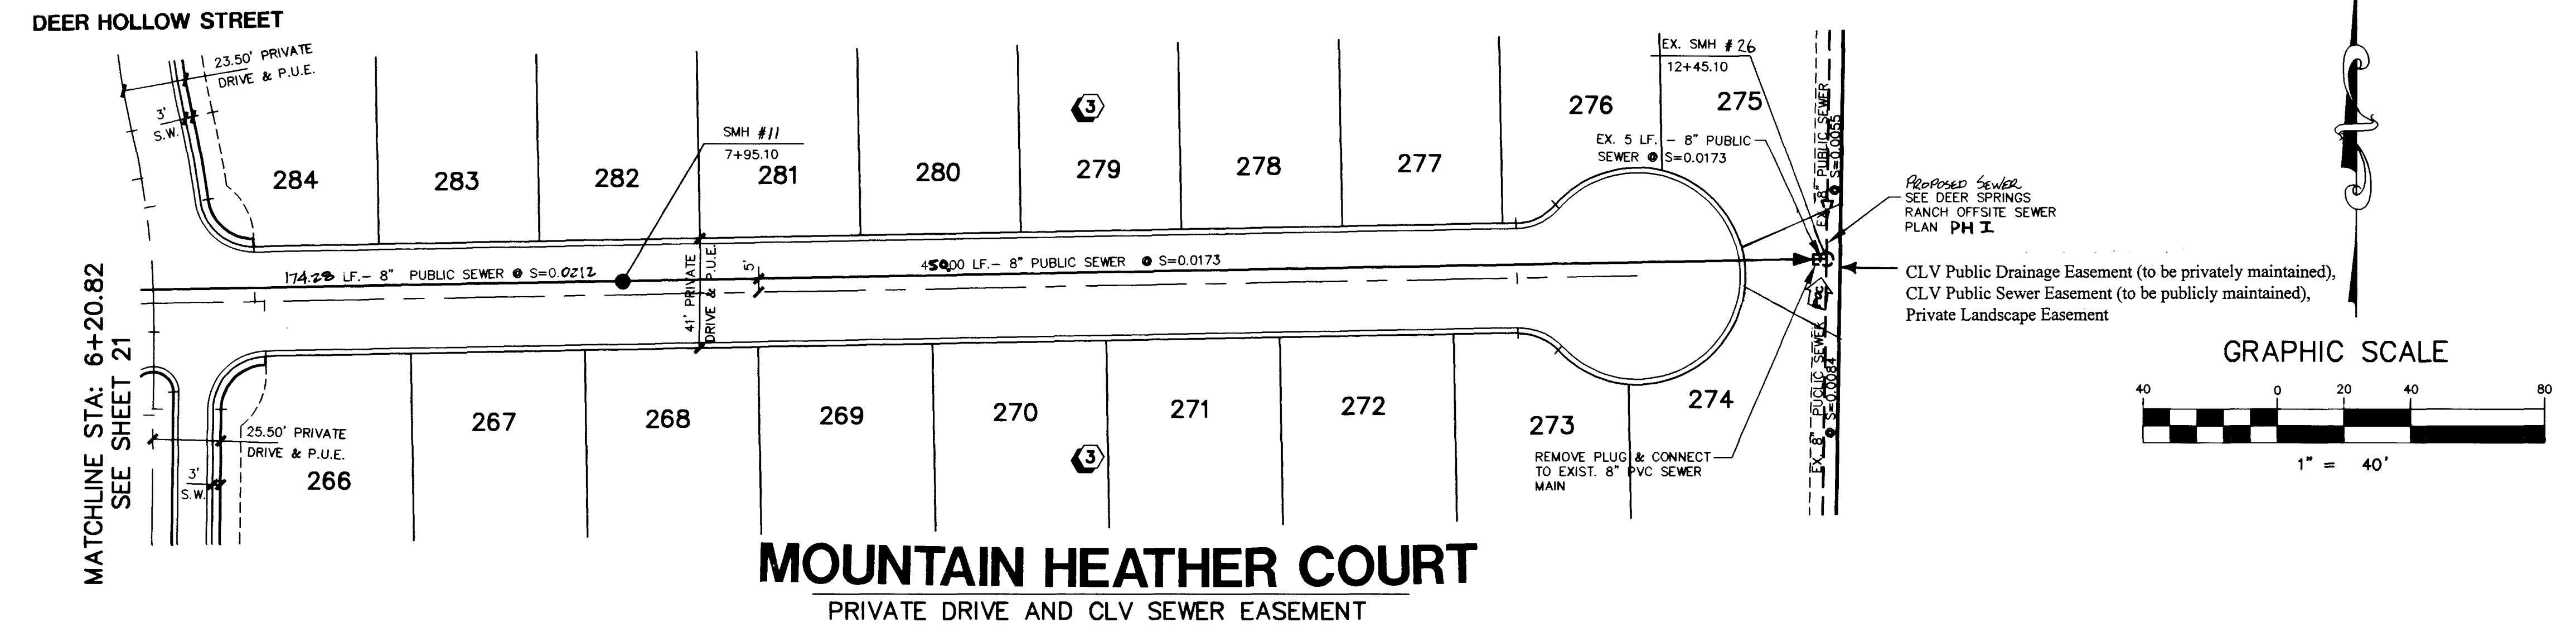


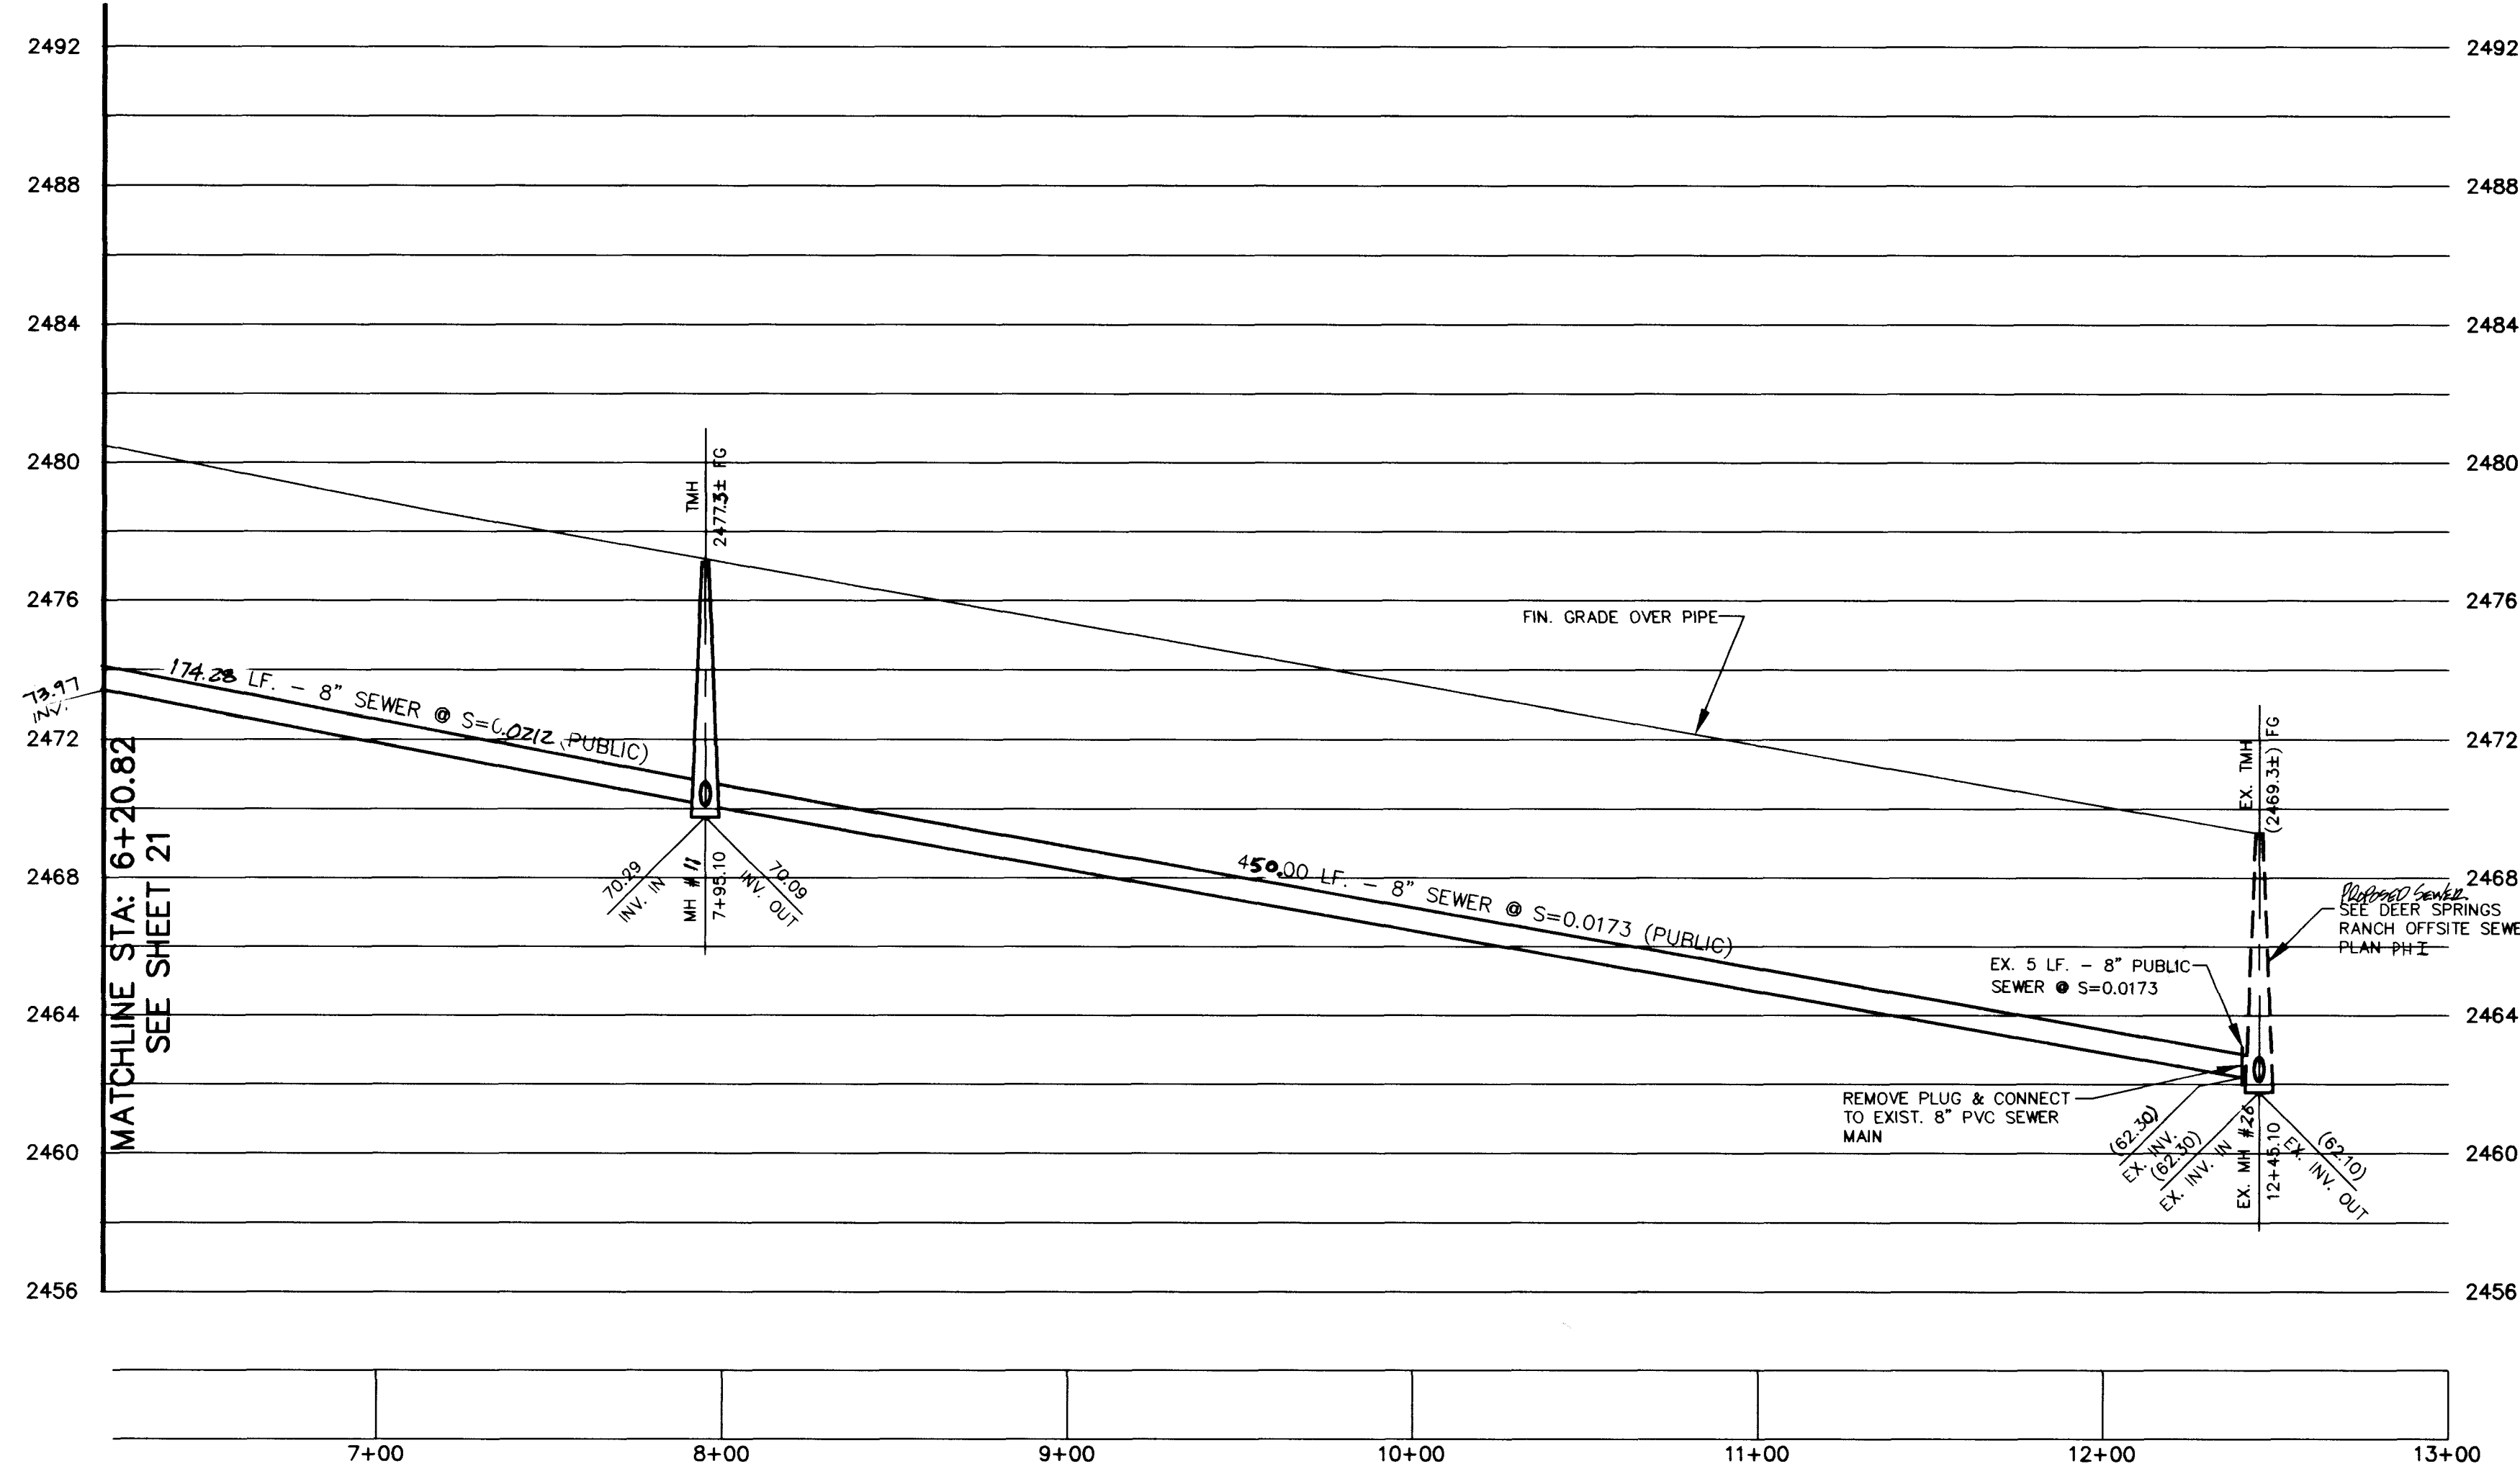

BASIS OF BEARINGS


SOUTH 88° 55' 31" WEST, BEING THE SOUTH LINE OF THE SOUTHWEST QUATER (SW 1/4) OF SECTION 21, T. 19 S., R. 60 E., M.D.M., CLARK COUNTY, NEVADA, COINCIDENT WITH THE CENTERLINE OF CENTENNIAL PARKWAY, AS SHOWN ON THAT CERTAIN MAP ON FILE IN THE OFFICE OF THE COUNTY RECORDER IN FILE 81 OF PARCEL MAPS AT PAGE 28.

BENCHMARK


CLARK COUNTY BM # 0C90 - 21NWS
RIVET AND SQUARE ALUMINUM PLATE IN TOP OF CENTER OF HEAD WALL ON THE WEST SIDE OF HIGHWAY - 95, NEAR MILE MARKER 86.95
ELEVATION = 764.787 METERS (NAVD'88)
ELEVATION = 2509.14 U.S. SURVEY FEET (NAVD'88)

Avoid cutting underground utility lines. It's costly.

Call before you Dig
1-800-227-2600

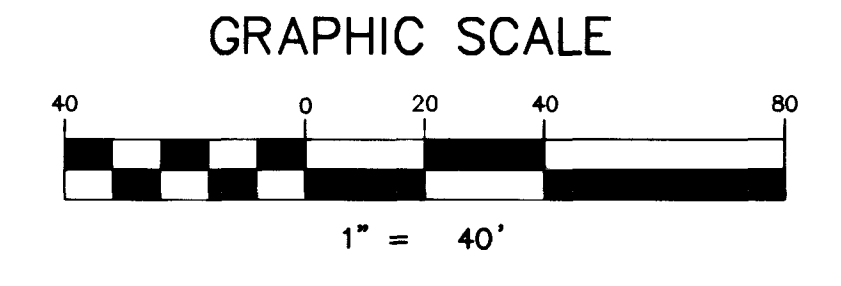


AMERICAN WEST HOMES, INC.
CITY OF LAS VEGAS, NEVADA

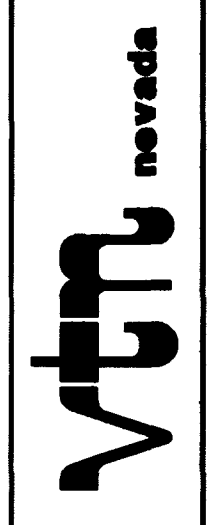

CONSULTING ENGINEERS • PLANNERS • LAND SURVEYORS
2727 SOUTH RAINBOW BOULEVARD
LAS VEGAS, NEVADA 89102-5148 PHONE (702) 873-7550 FAX (702) 362-2597

SEWER PLAN - PROFILE
MOUNTAIN HEATHER COURT
DEER SPRINGS RANCH
UNIT - 2

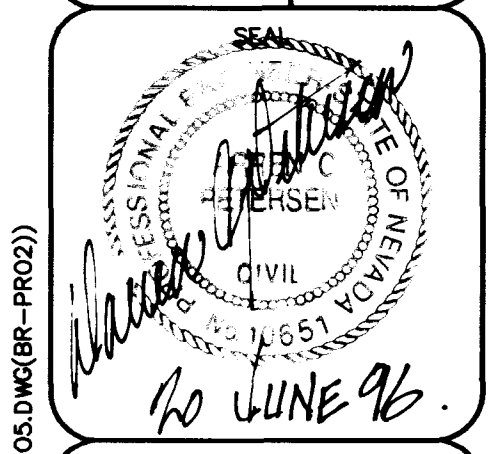

WO NO. 4884-2
BY CKH/RDM
DATE MAR., '96
SCALE HORIZ. 1"=40'
VERT. 1"=4'
SHEET 22 OF 28 SHEETS

H: /CAD/LANDEV/4884/4884PROG.DWG(BG-PRO2)

3074
3074-4478-2

