
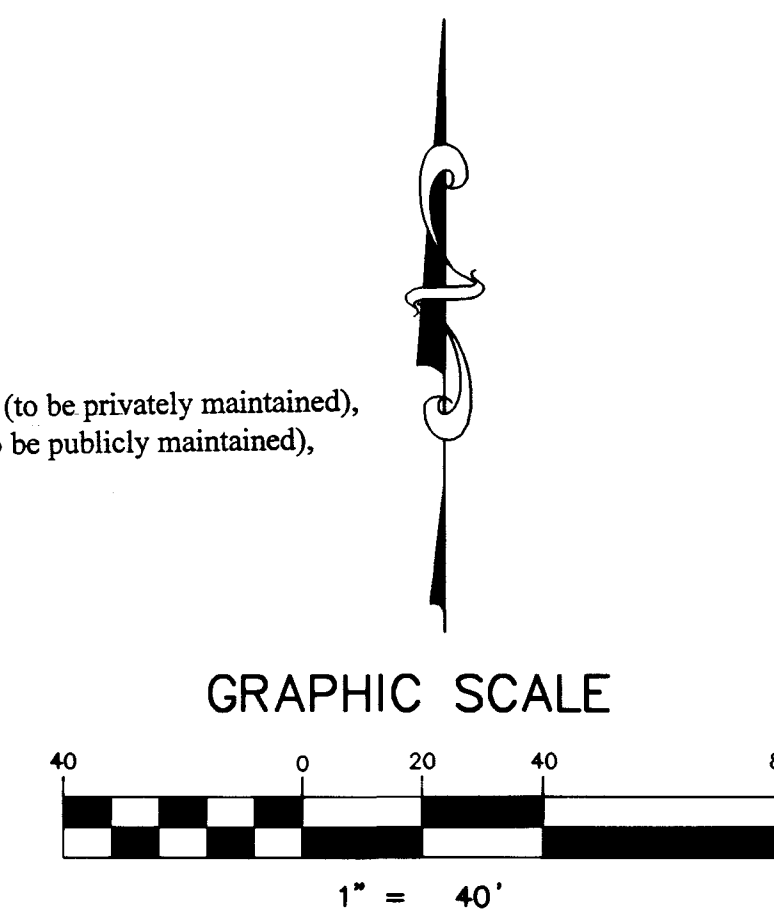
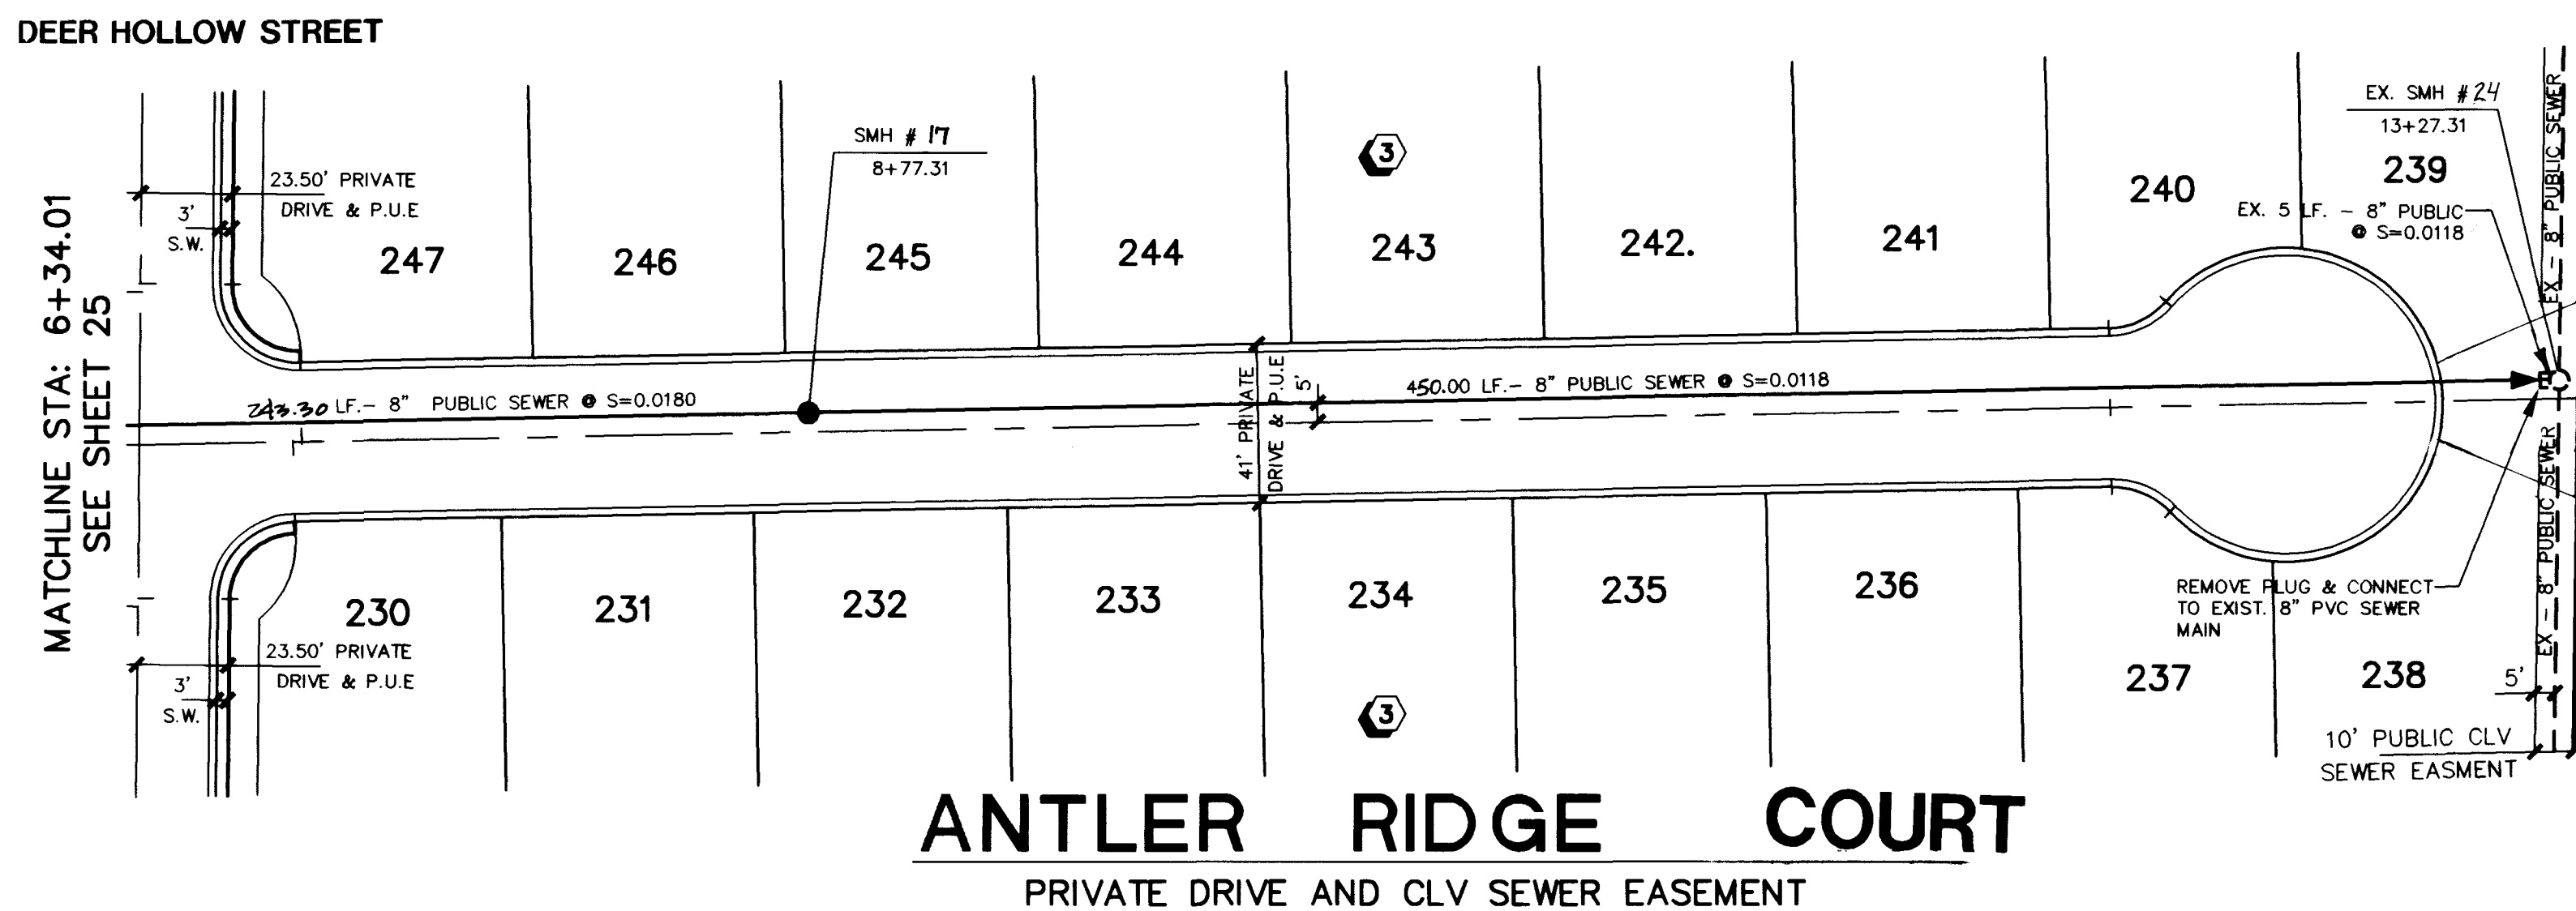


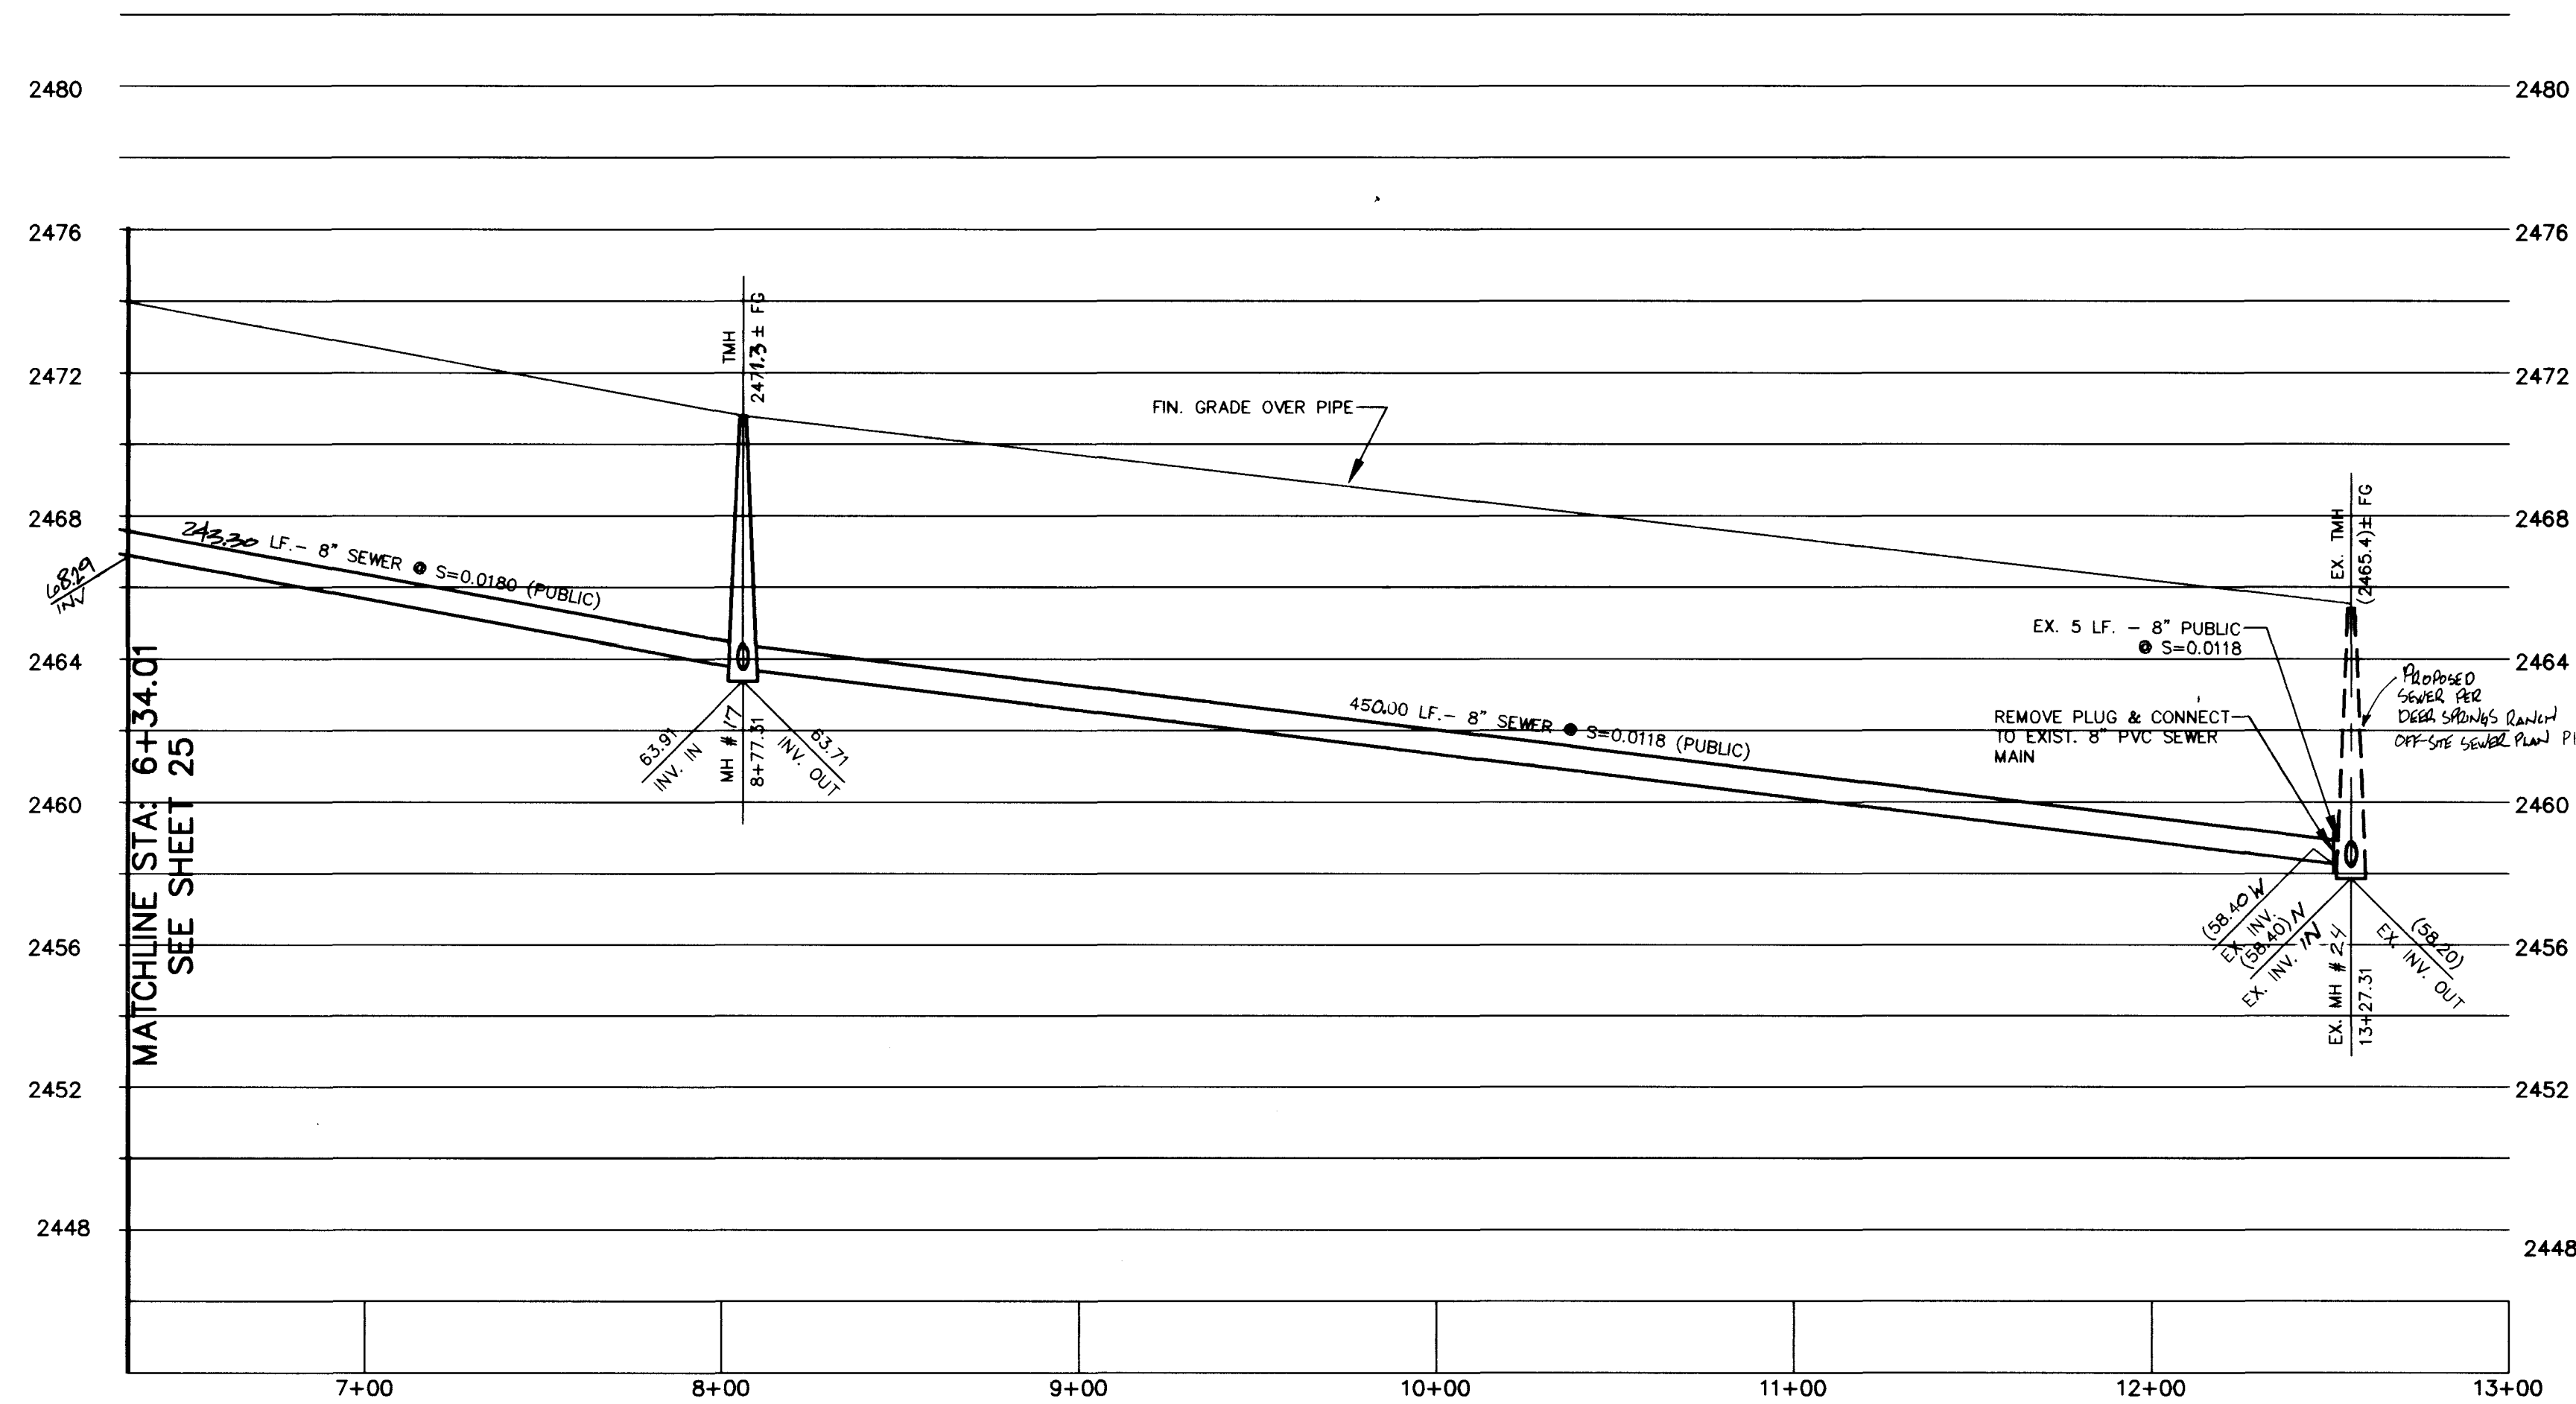

# BASIS OF BEARINGS

SOUTH 88°55'31" WEST, BEING THE SOUTH LINE OF THE SOUTHWEST QUATER (SW 1/4) OF SECTION 21, T. 19 S., R. 60 E., M.D.M., CLARK COUNTY, NEVADA, COINCIDENT WITH THE CENTERLINE OF CENTENNIAL PARKWAY, AS SHOWN ON THAT CERTAIN MAP ON FILE IN THE OFFICE OF THE COUNTY RECORDER IN FILE 81 OF PARCEL MAPS AT PAGE 28.

# BENCHMARK

CLARK COUNTY BM # 0090 - 21NW6

RIVET AND SQUARE ALUMINUM PLATE IN TOP OF CENTER OF HEAD WALL ON THE WEST SIDE OF HIGHWAY - 95, NEAR MILE MARKER 88.95

ELEVATION = 764.787 METERS (NAVD'88)  
ELEVATION = 2509.14 U.S. SURVEY FEET (NAVD'88)

Avoid cutting underground utility lines. It's costly.

**Call  
before you  
Dig**

**1-800-227-2600**


# SEWER PLAN - PROFILE

# ANTLER RIDGE COURT

# DEER SPRINGS RANCH

UNIT - 2

H:\ROAD\LAND\VE\4884\4884PR07.DWG (88-PR02)

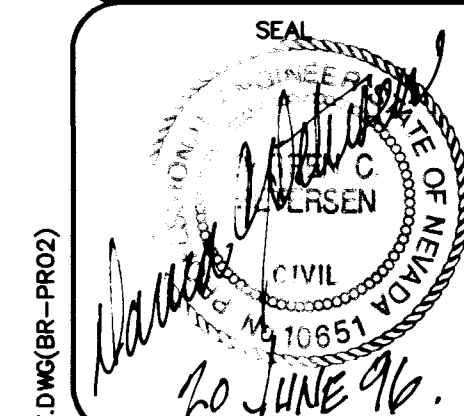

WO NO. **4884-2**

BY **CKH/RDM**

DATE **MAR., '96**

SCALE HORIZ. 1"=40'  
VERT. 1"=4'

SHEET

**26** OF 28 SHEETS

AMERICAN WEST HOMES, INC.  
CITY OF LAS VEGAS, NEVADA



CONSULTING ENGINEERS • PLANNERS • LAND SURVEYORS  
2727 SOUTH RAINBOW BOULEVARD  
LAS VEGAS, NEVADA 89102-5148 PHONE (702) 873-7550 FAX (702) 382-2597

| REV | DATE    | BY  | REVISION                                 |
|-----|---------|-----|------------------------------------------|
| 1   | 2-12-97 | CKH | DESIGN STREET NAMES PER FINAL MAP 7/6/96 |

