
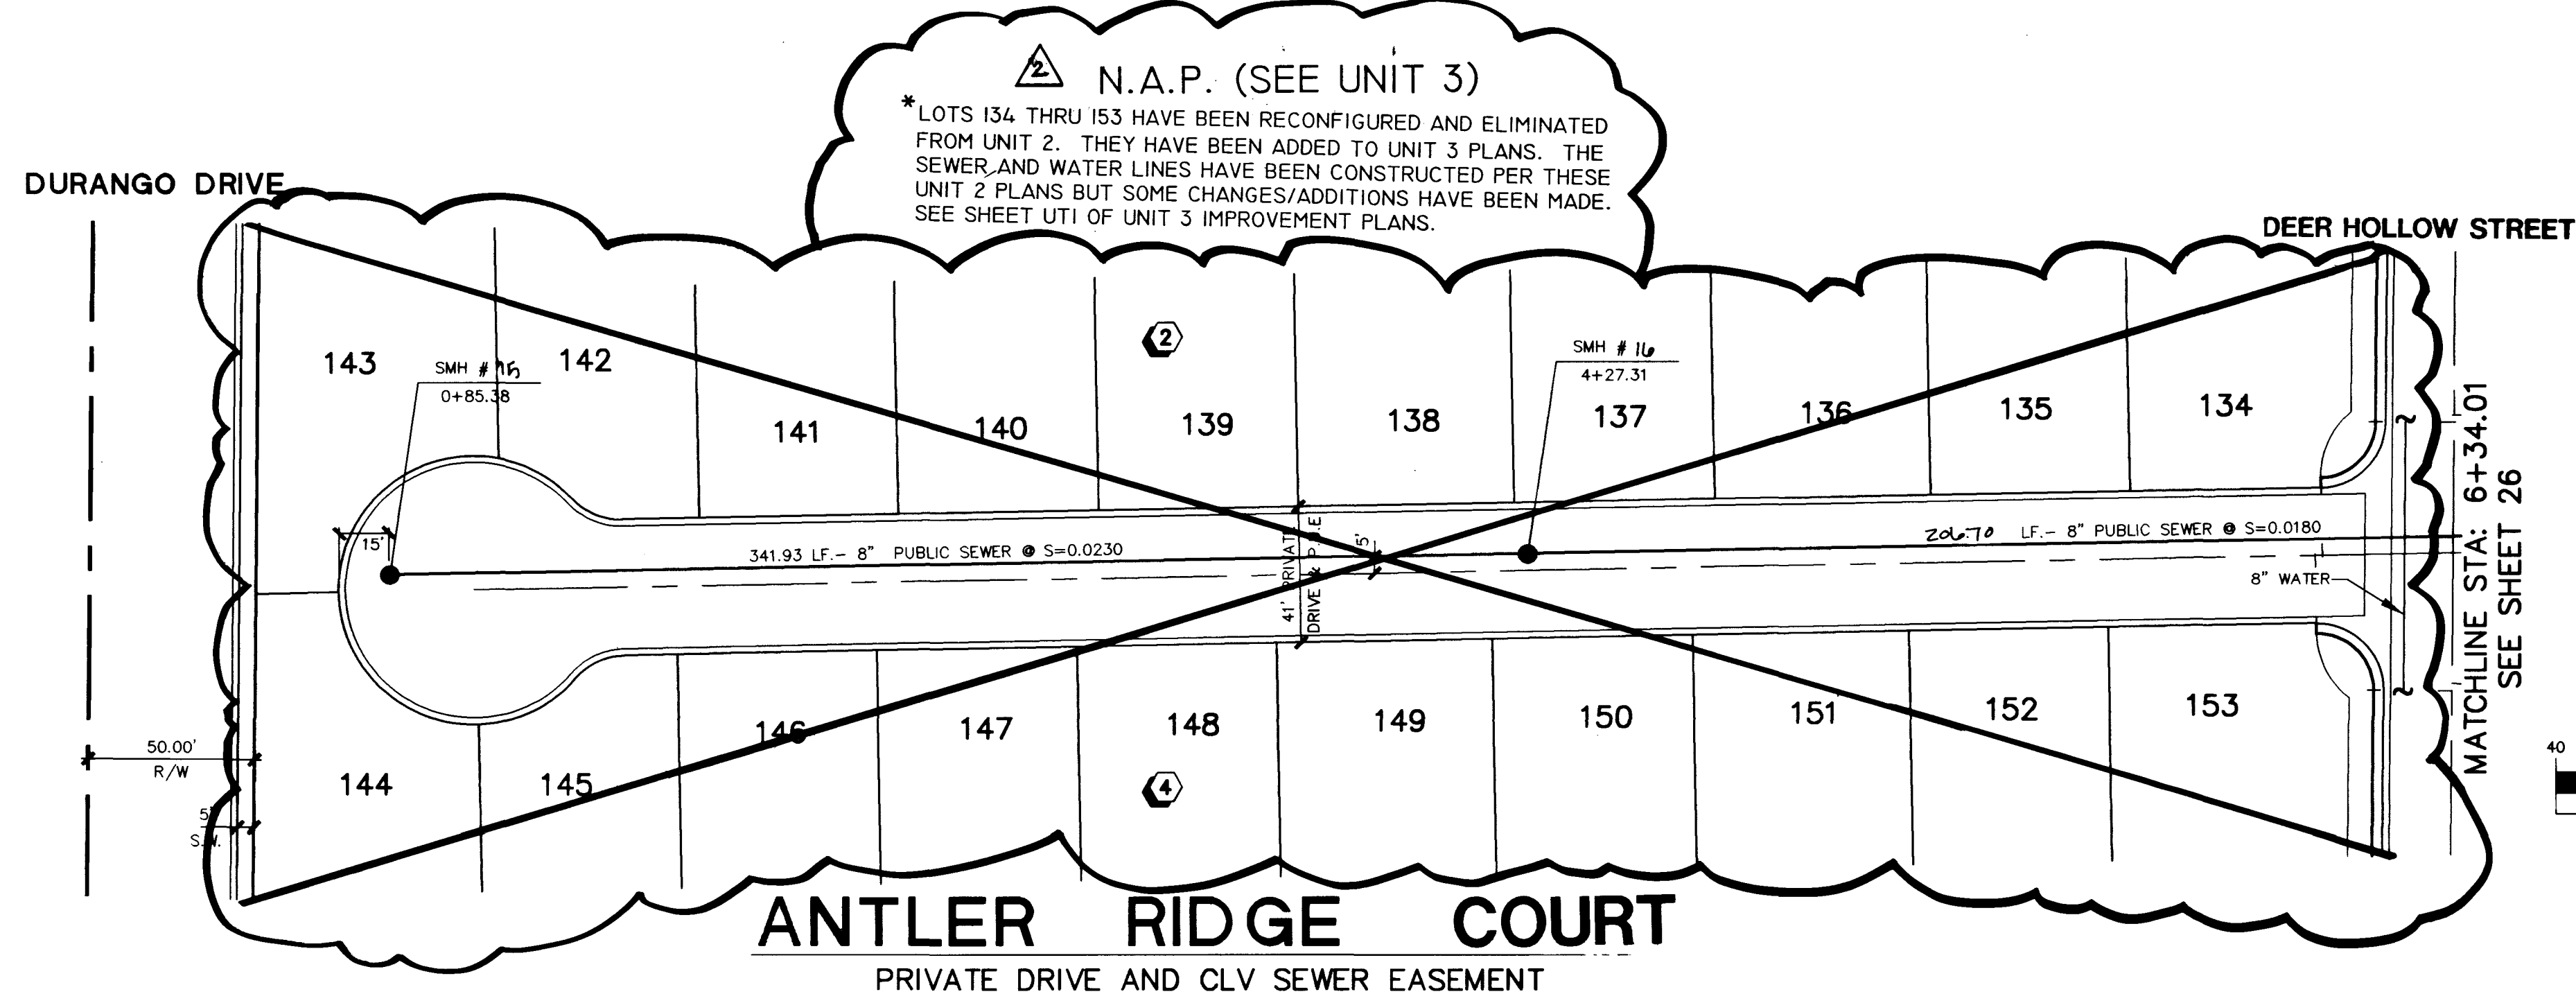


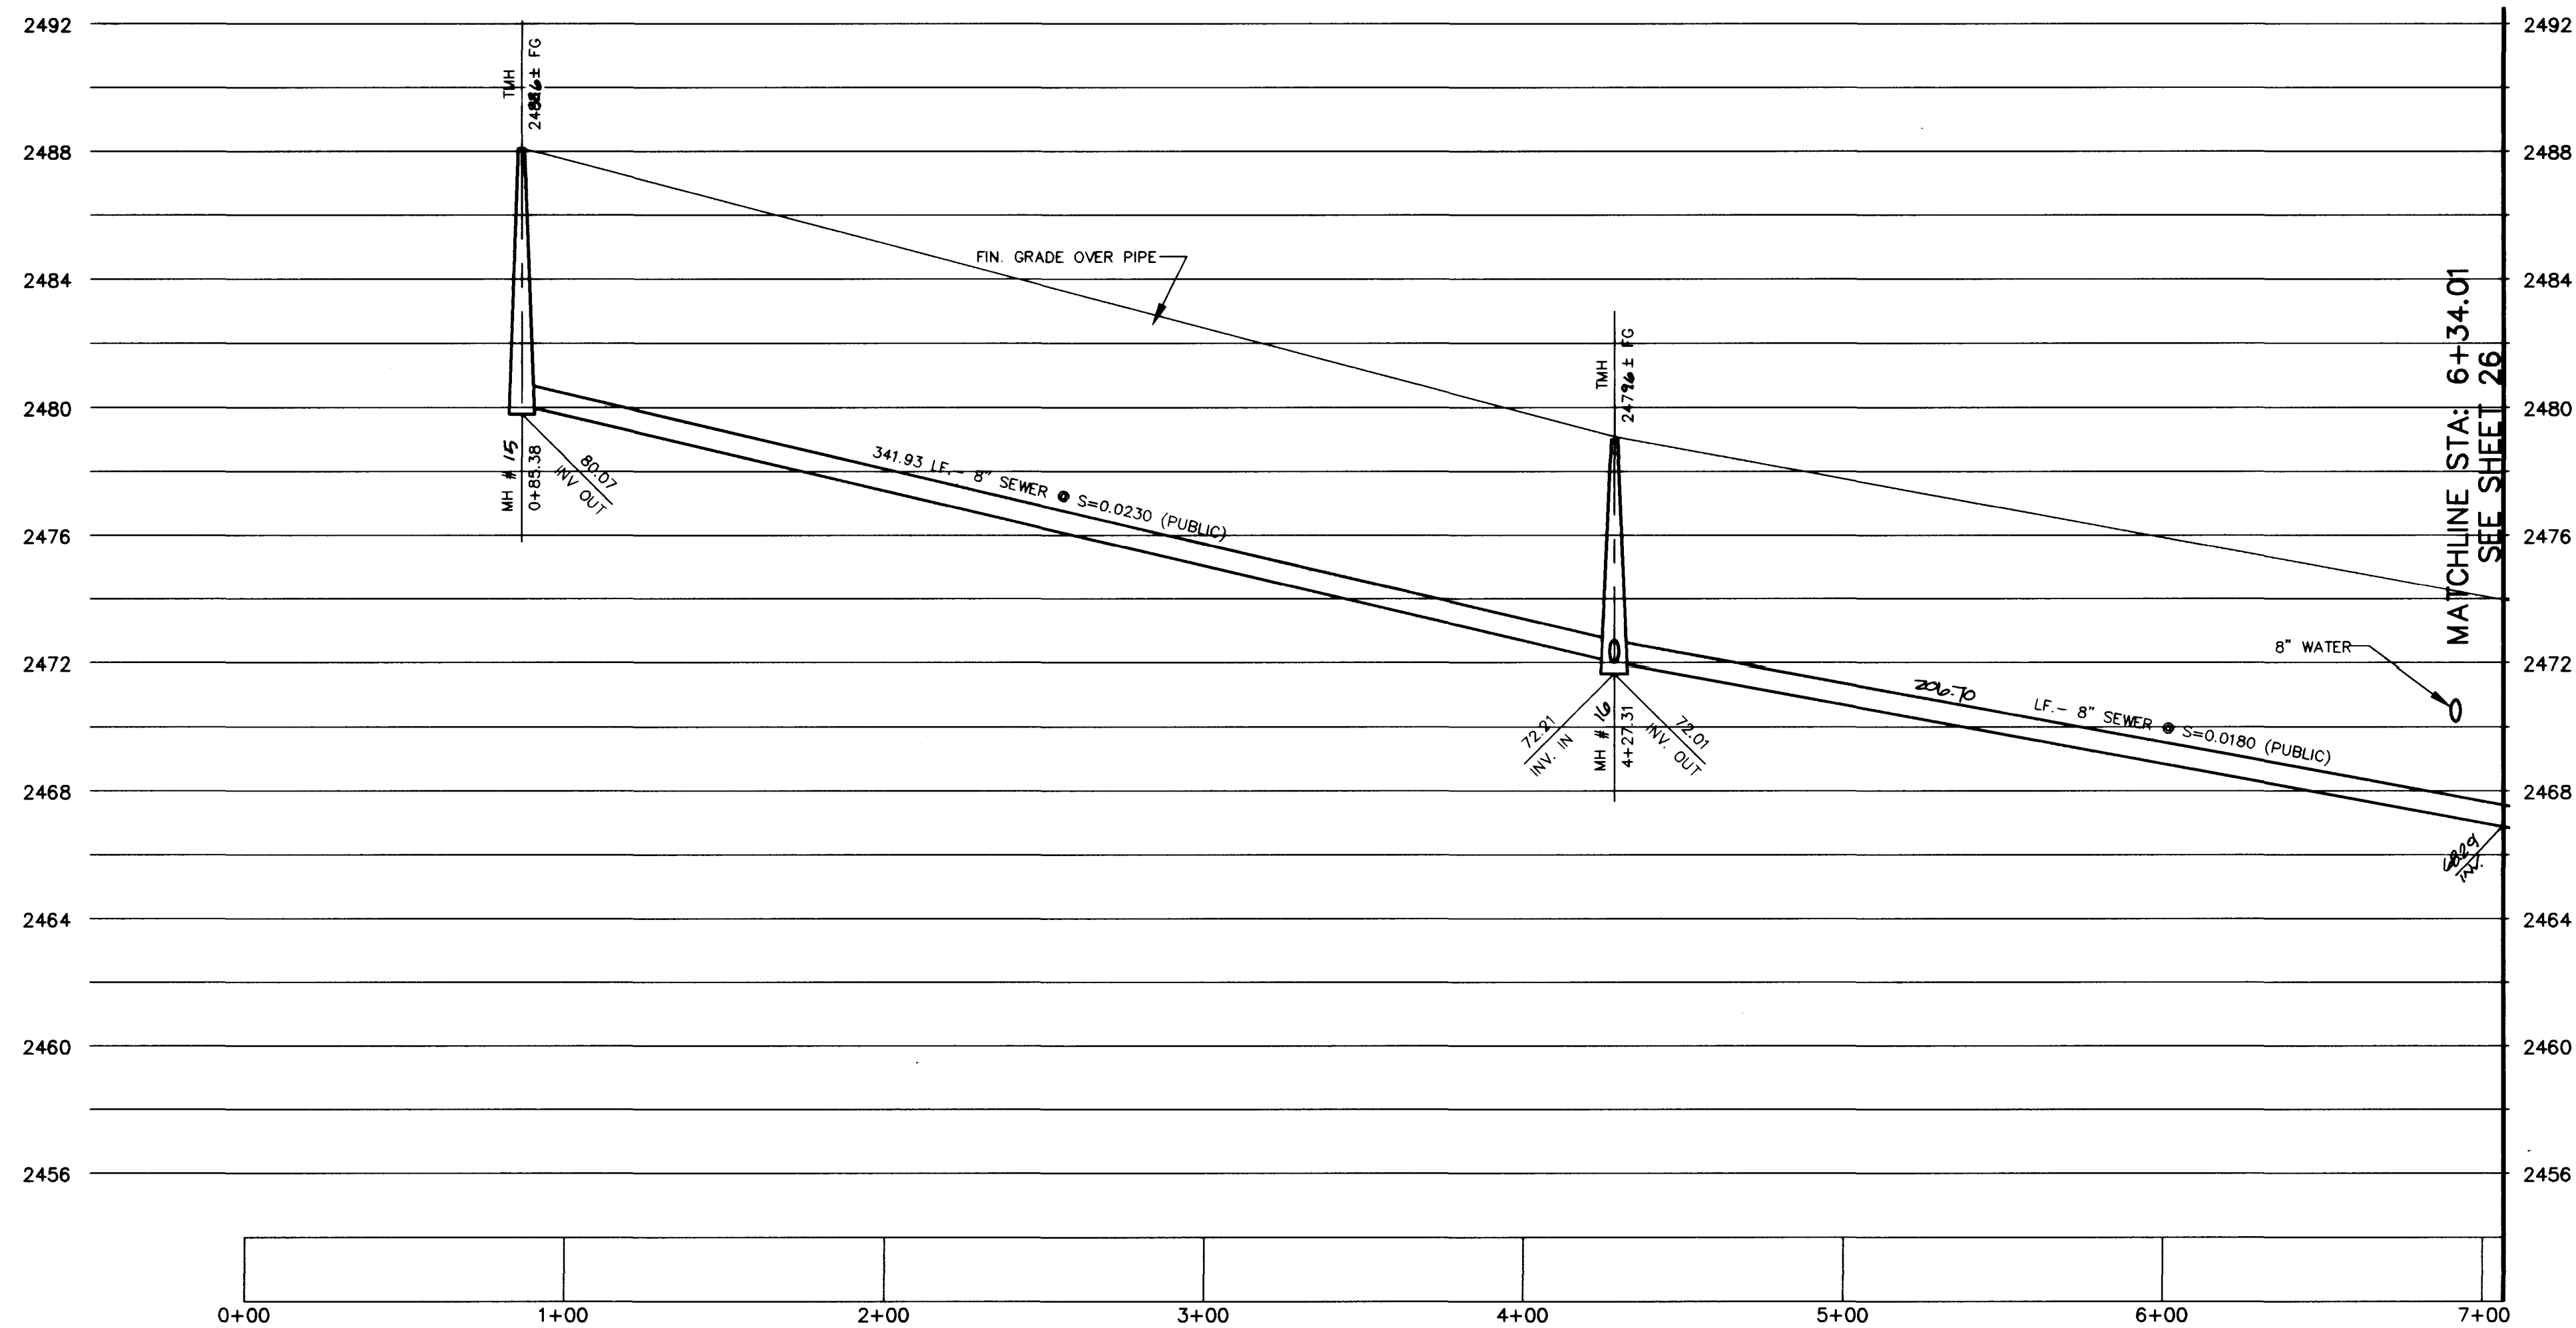

BASIS OF BEARINGS

SOUTH $88^{\circ}55'31''$ WEST, BEING THE SOUTH LINE OF THE SOUTHWEST QUARTER (SW 1/4) OF SECTION 21, T. 19 S., R. 60 E., M.D.M., CLARK COUNTY, NEVADA, COINCIDENT WITH THE CENTERLINE OF CENTENNIAL PARKWAY, AS SHOWN ON THAT CERTAIN MAP ON FILE IN THE OFFICE OF THE COUNTY RECORDER IN FILE 81 OF PARCEL MAPS AT PAGE 28.

BENCHMARK

CLARK COUNTY BM # 0C90 - 21NW6

RIVET AND SQUARE ALUMINUM PLATE IN TOP OF CENTER OF HEAD WALL ON THE WEST SIDE OF HIGHWAY - 95, NEAR MILE MARKER 88.95

ELEVATION = 764.787 METERS (NAVD'88)
ELEVATION = 2509.14 U.S. SURVEY FEET (NAVD'88) (NGVD 29)

Avoid cutting underground utility lines. It's costly.

Call before you Dig
1-800-227-2600


AMERICAN WEST HOMES, INC.
CITY OF LAS VEGAS, NEVADA

vtm nevada

CONSULTING ENGINEERS • PLANNERS • LAND SURVEYORS
2727 SOUTH RAINBOW BOULEVARD
LAS VEGAS, NEVADA 89102-5148 PHONE (702) 873-7550 FAX (702) 362-2597

SEWER PLAN - PROFILE
ANTLER RIDGE COURT
DEER SPRINGS RANCH
UNIT 2

TITLE PROJECT

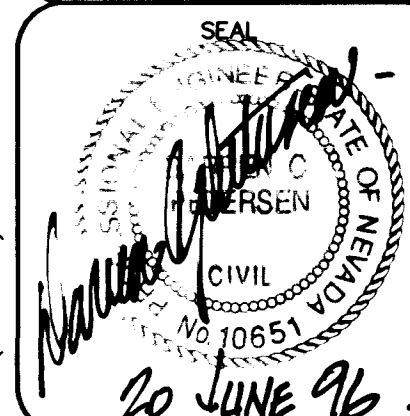

WO NO. 4884-2
BY CKH/RDM
DATE MAR., '96
SCALE HORIZ. 1"=40'
SCALE VERT. 1"=4'
SHEET 25 OF 28 SHEETS

