



H:\VAD\LANDEV\4884\4884SEW Fr1 Aug 23 08:22:12 1996 Plotted by: MGB

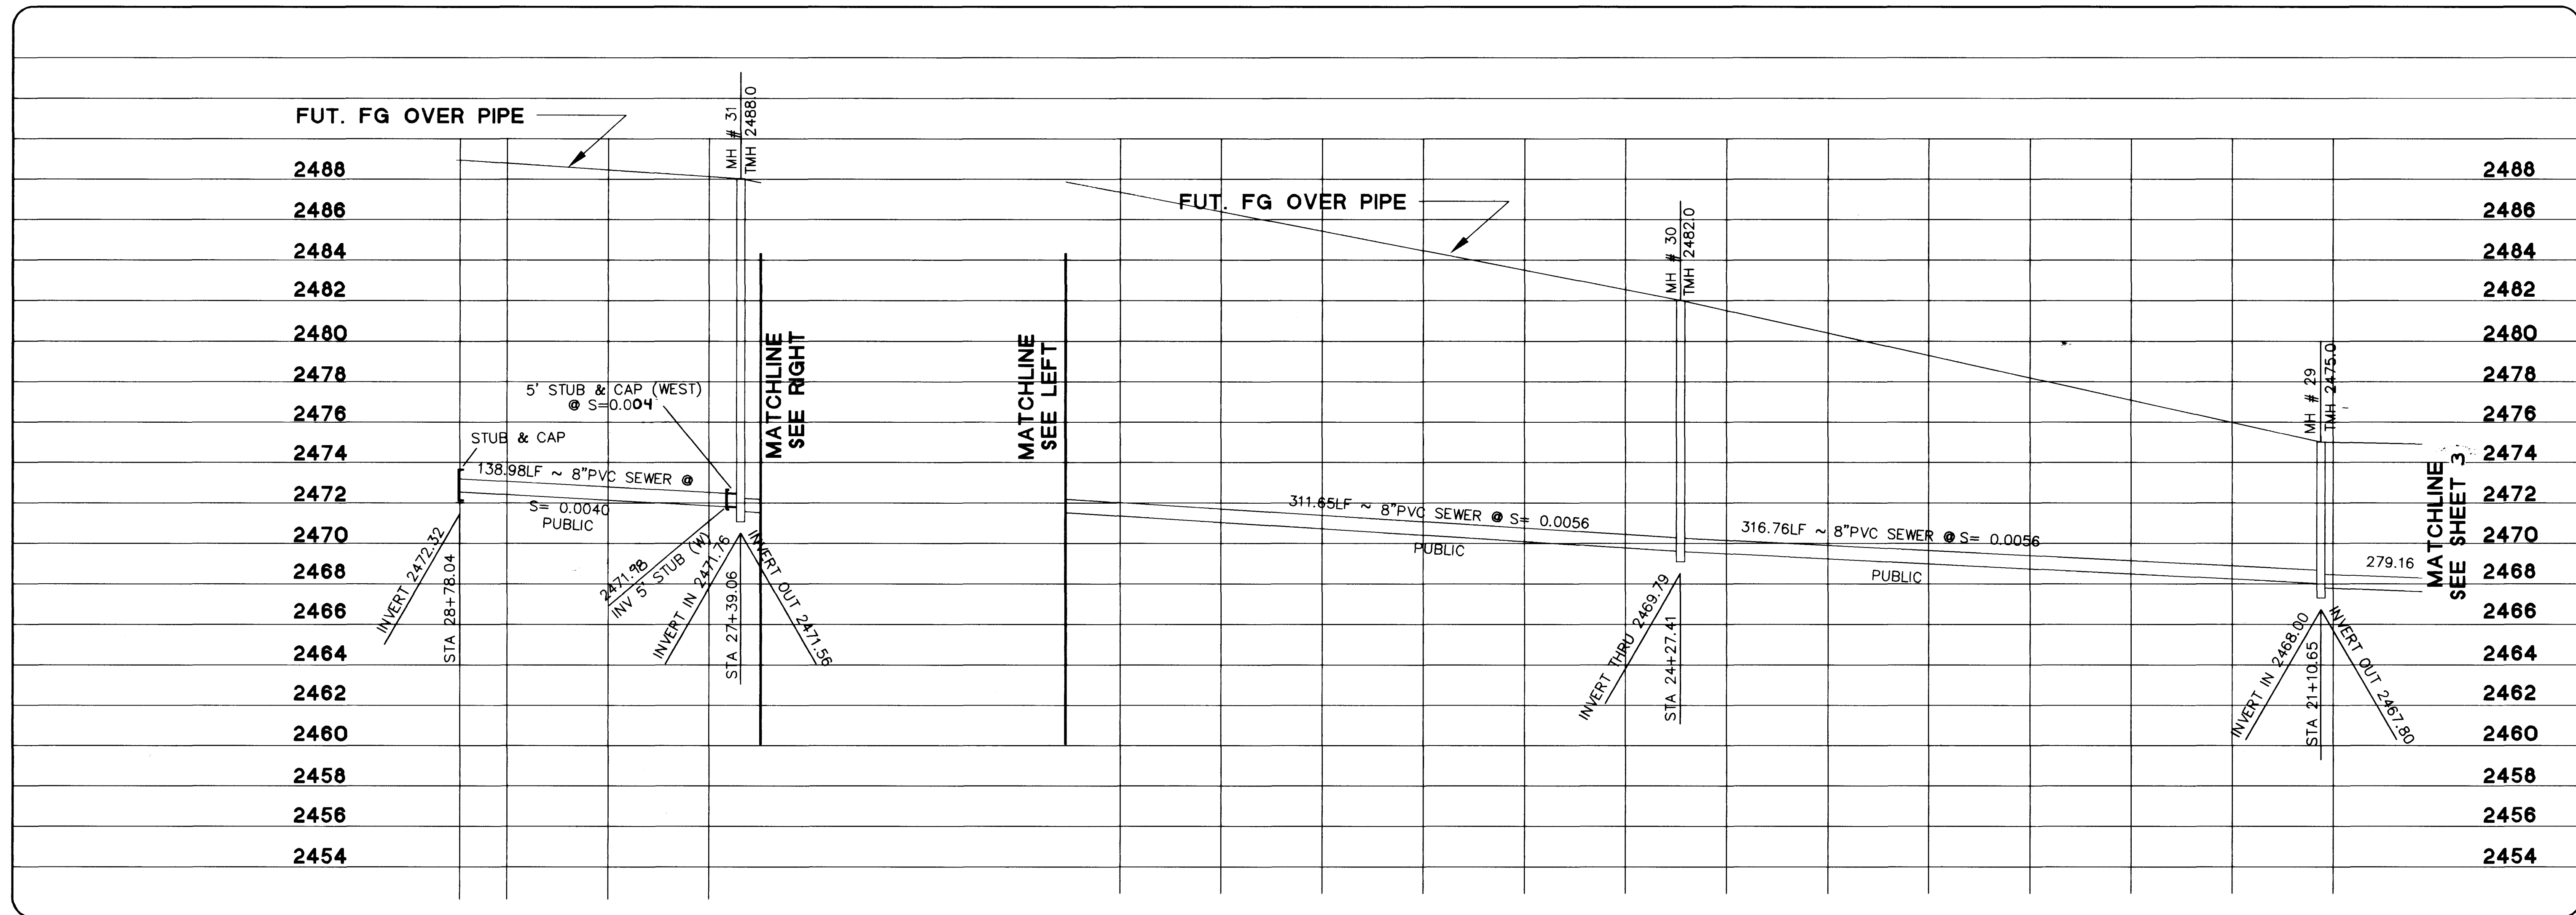

AMERICAN WEST HOMES, INC.	REVISED AS PLACED	DATE	BY	REASON
CITY OF LAS VEGAS	REVISED PER CIVIL CHECKPRINTS	1/7/97	CKH	
	REVISED SEWER STATIONING & M.H. #'S	8/22/96	CKH	
		8/5/96	BY	

CONSULTING ENGINEERS • PLANNERS • LAND SURVEYORS
2727 SOUTH RAINBOW BOULEVARD
LAS VEGAS, NEVADA 89102-5148 PHONE (702) 873-7550 FAX (702) 362-2597

vtm nevada

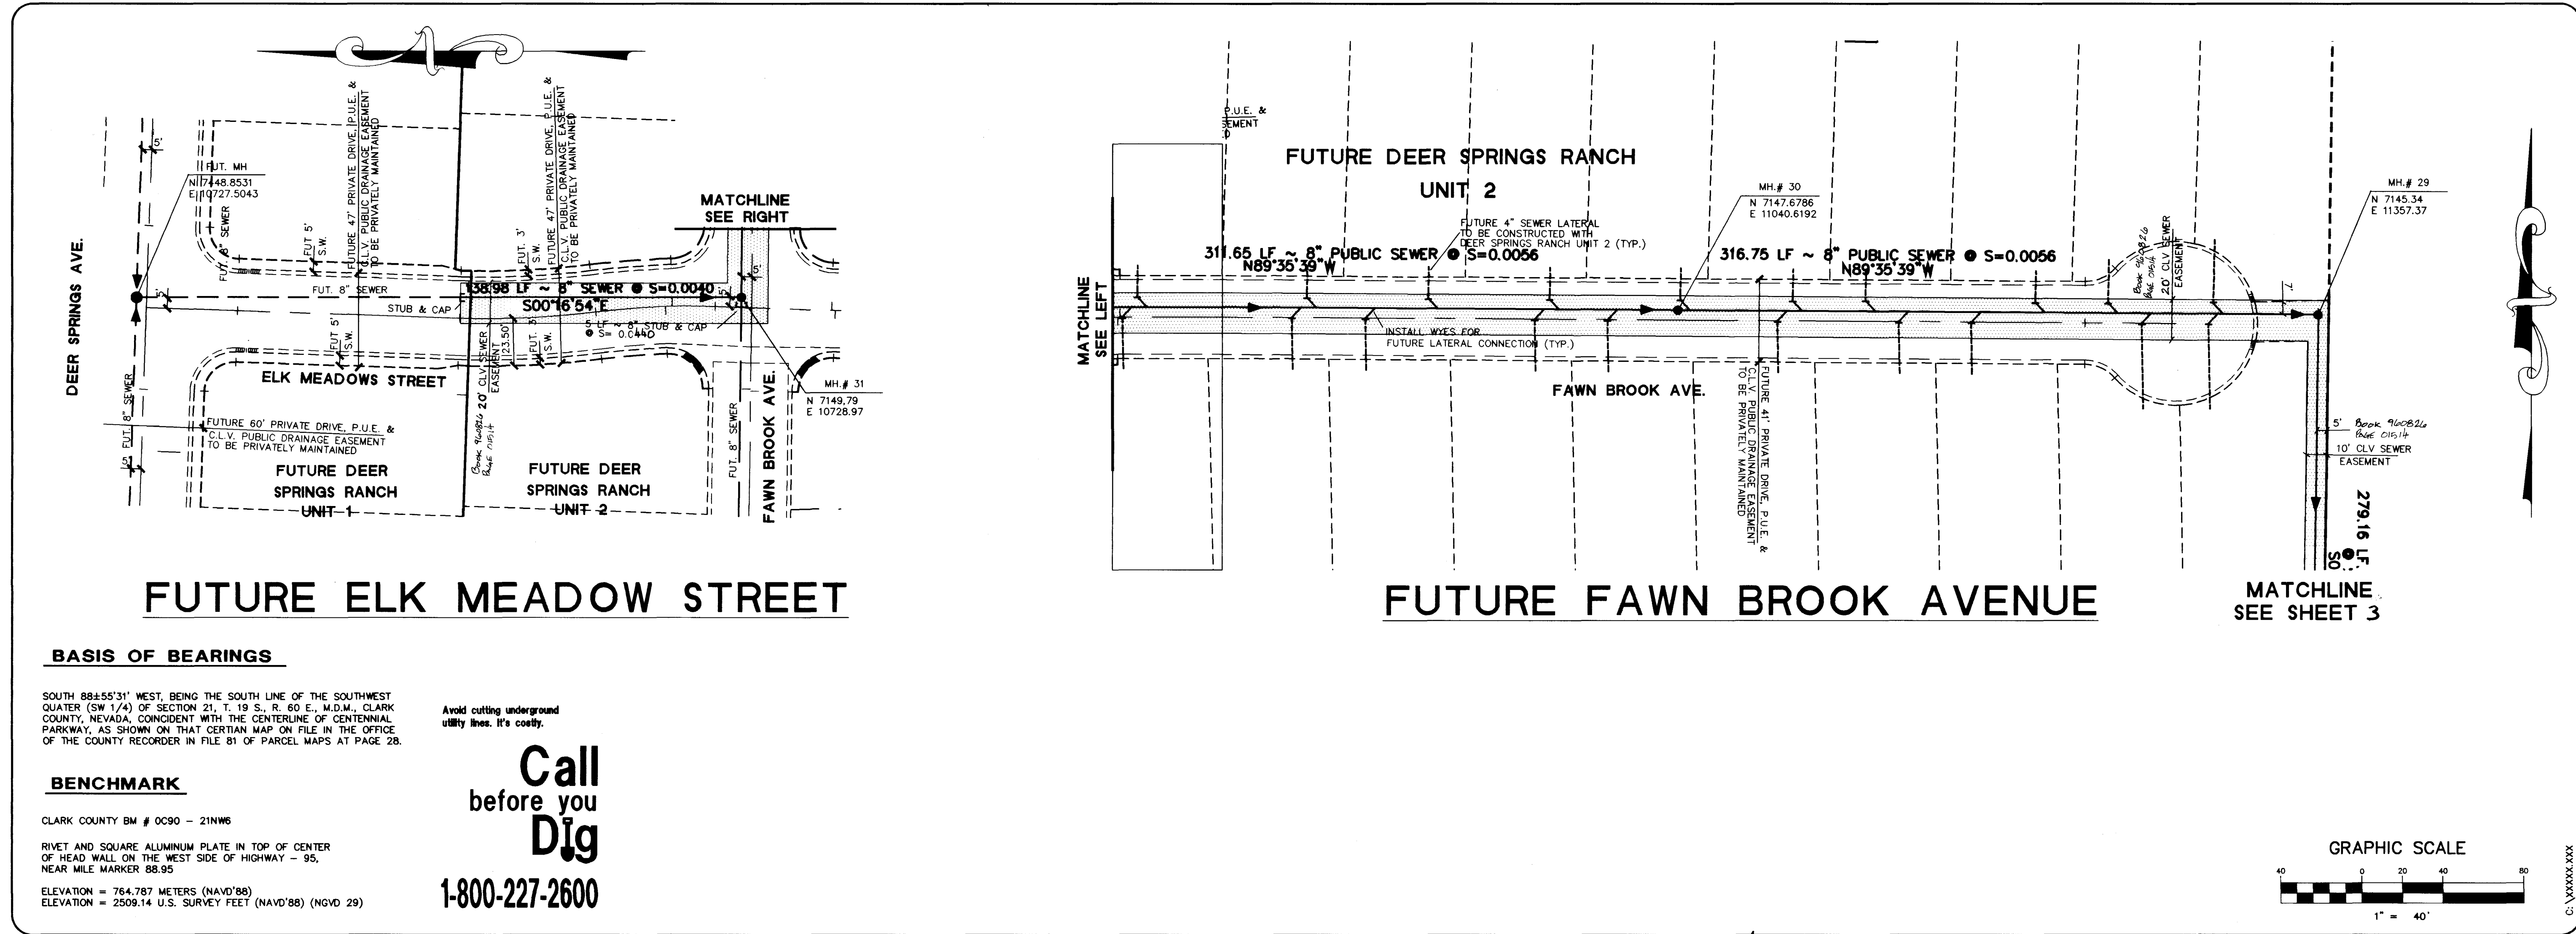

OFF-SITE SANITARY SEWER PLAN & PROFILE
STA. 21+10.65 TO STA. 28+78.04

PROJECT: **DEER SPRINGS RANCH**
PHASE I OFF-SITE SEWER

SEAL
CIVIL
NO. 10651
JANUARY 1996

WO NO. **4884**
BY **CKH**
DATE **5-30-96**
SCALE HORIZ. 1"=40'
SCALE VERT. 1"=4'
SHEET **4** OF 4 SHEETS

307Y-4478-OS

