


2476
2474
2472
2470
2468
2466
2464
2462
2460
2458
2456
2454
2452
2450
2448
2446
2444
2442

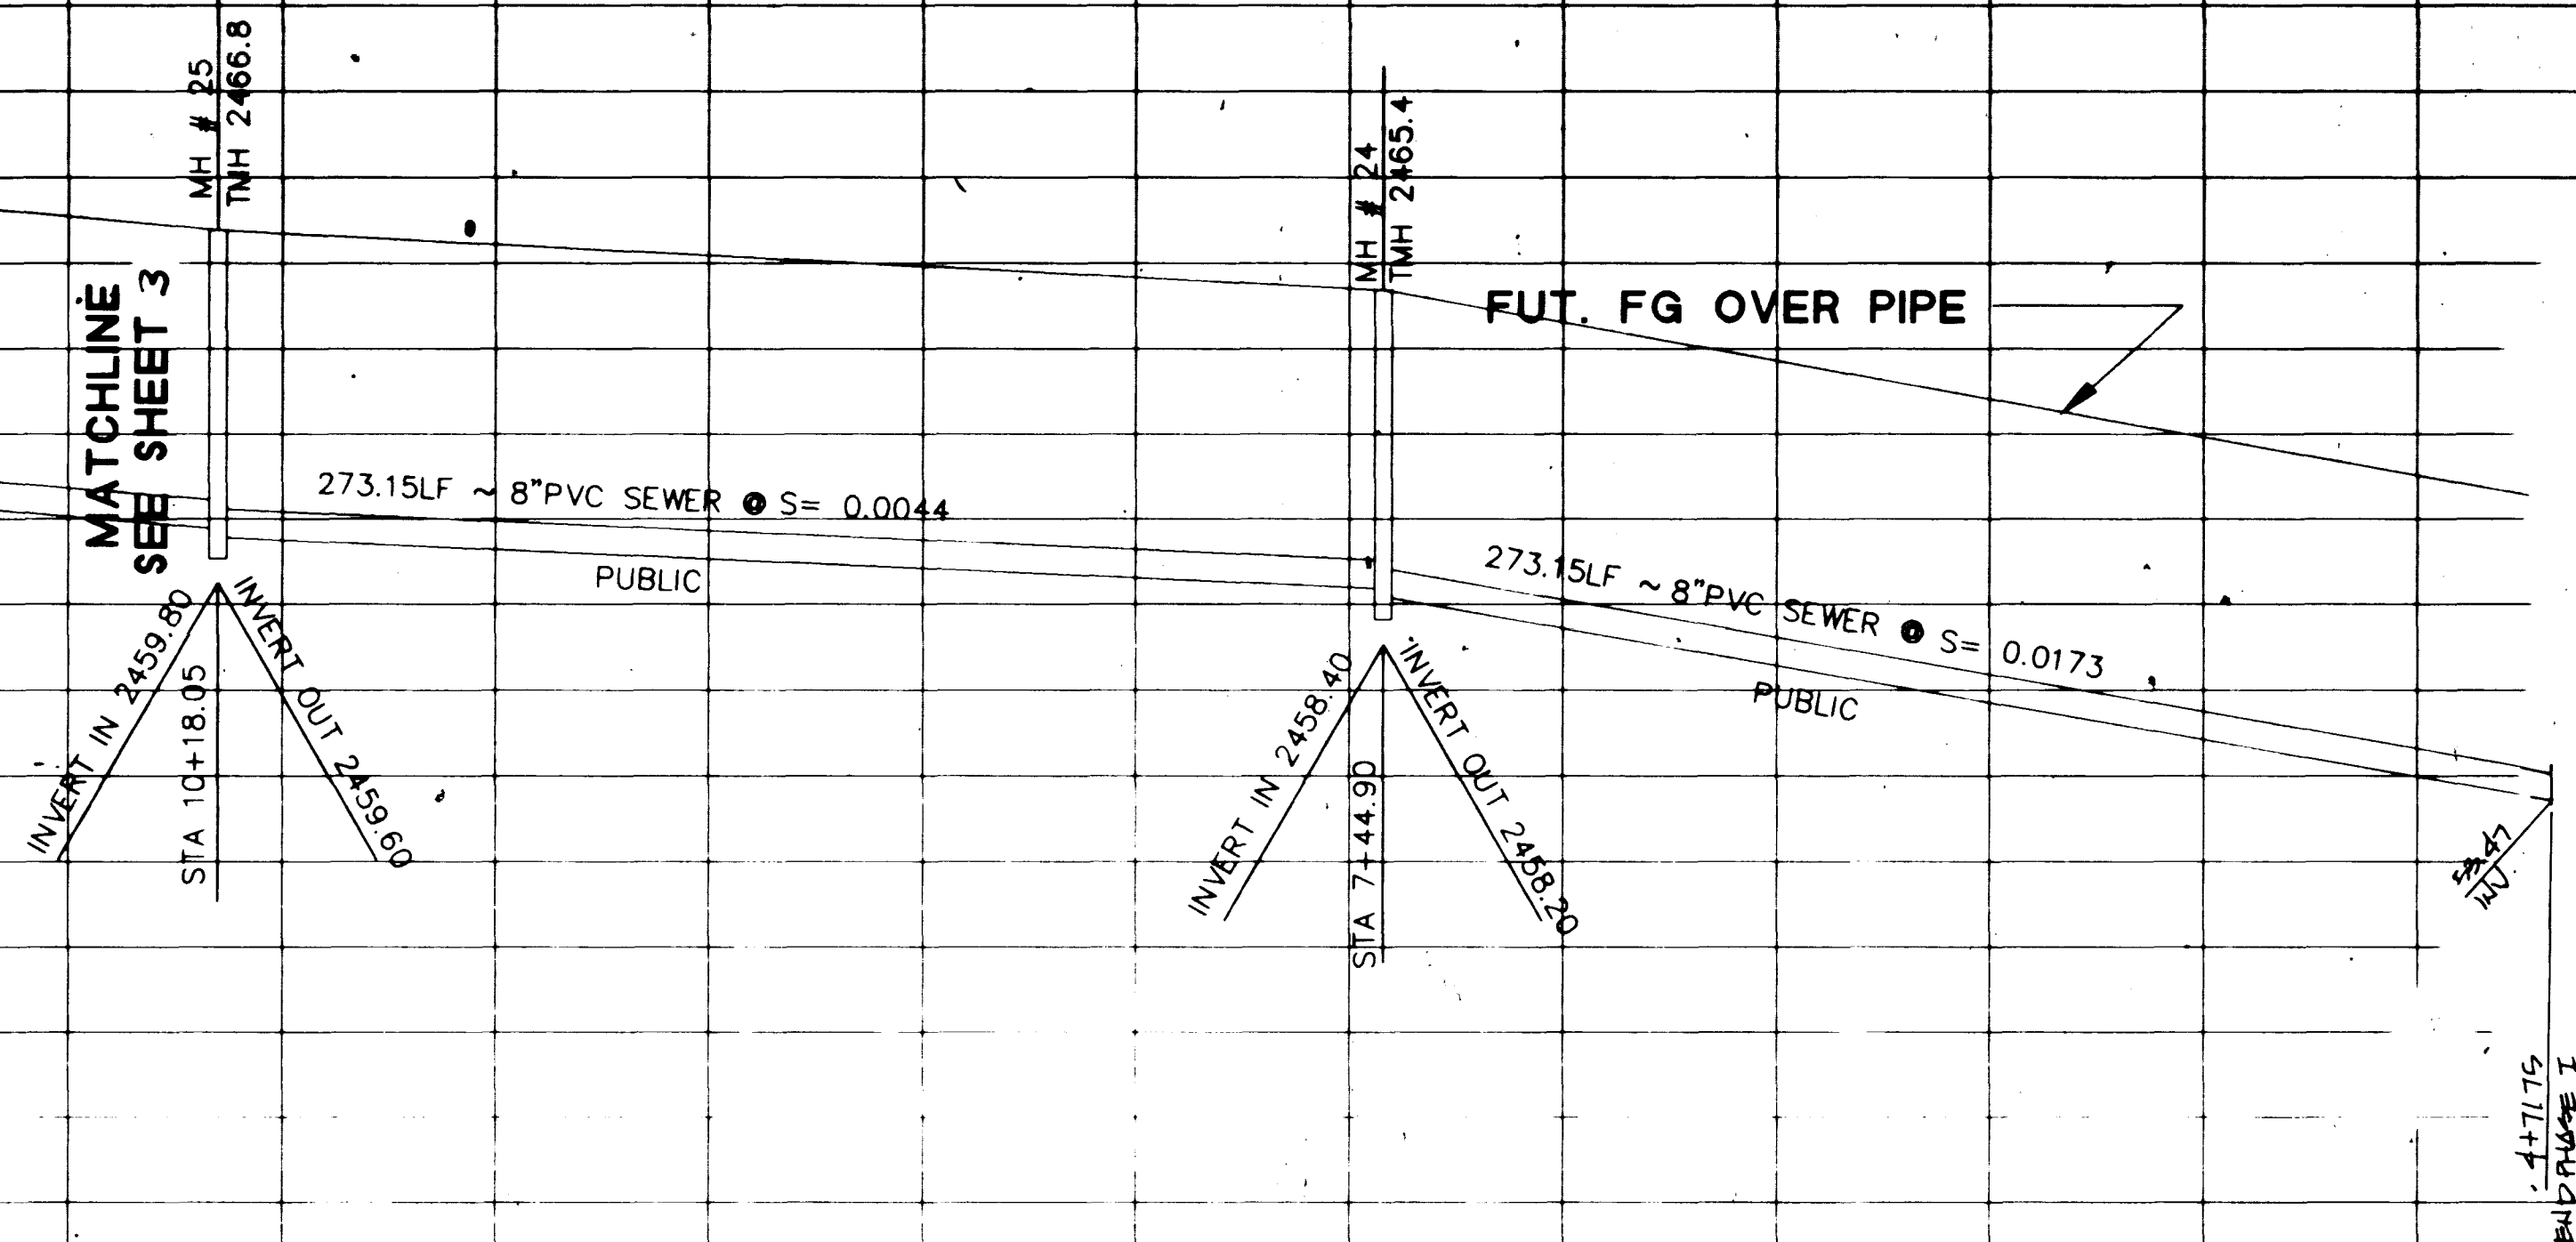

2476
2474
2472
2470
2468
2466
2464
2462
2460
2458
2456
2454
2452
2450
2448
2446
2444
2442


AMERICAN WEST HOMES, INC.
CITY OF LAS VEGAS

DATE	BY	REV	DESCRIPTION
1/28/97	CKH	1	REMOVED SEWER SOUTH OF STA 10+18.05
1/28/97	CKH	2	REMOVED SEWER SOUTH OF STA 10+18.05
CONSULTING ENGINEERS • PLANNERS • LAND SURVEYORS
2727 SOUTH RAINBOW BOULEVARD
LAS VEGAS, NEVADA 89102-5148 PHONE (702) 873-7800 FAX (702) 382-2887

AMERICAN WEST HOMES, INC.
CITY OF LAS VEGAS

OFF-SITE SANITARY SEWER
PLAN & PROFILE
STA. 4+71.75 TO STA. 10+18.05
DEER SPRINGS RANCH
PHASE I OFF-SITE SEWER

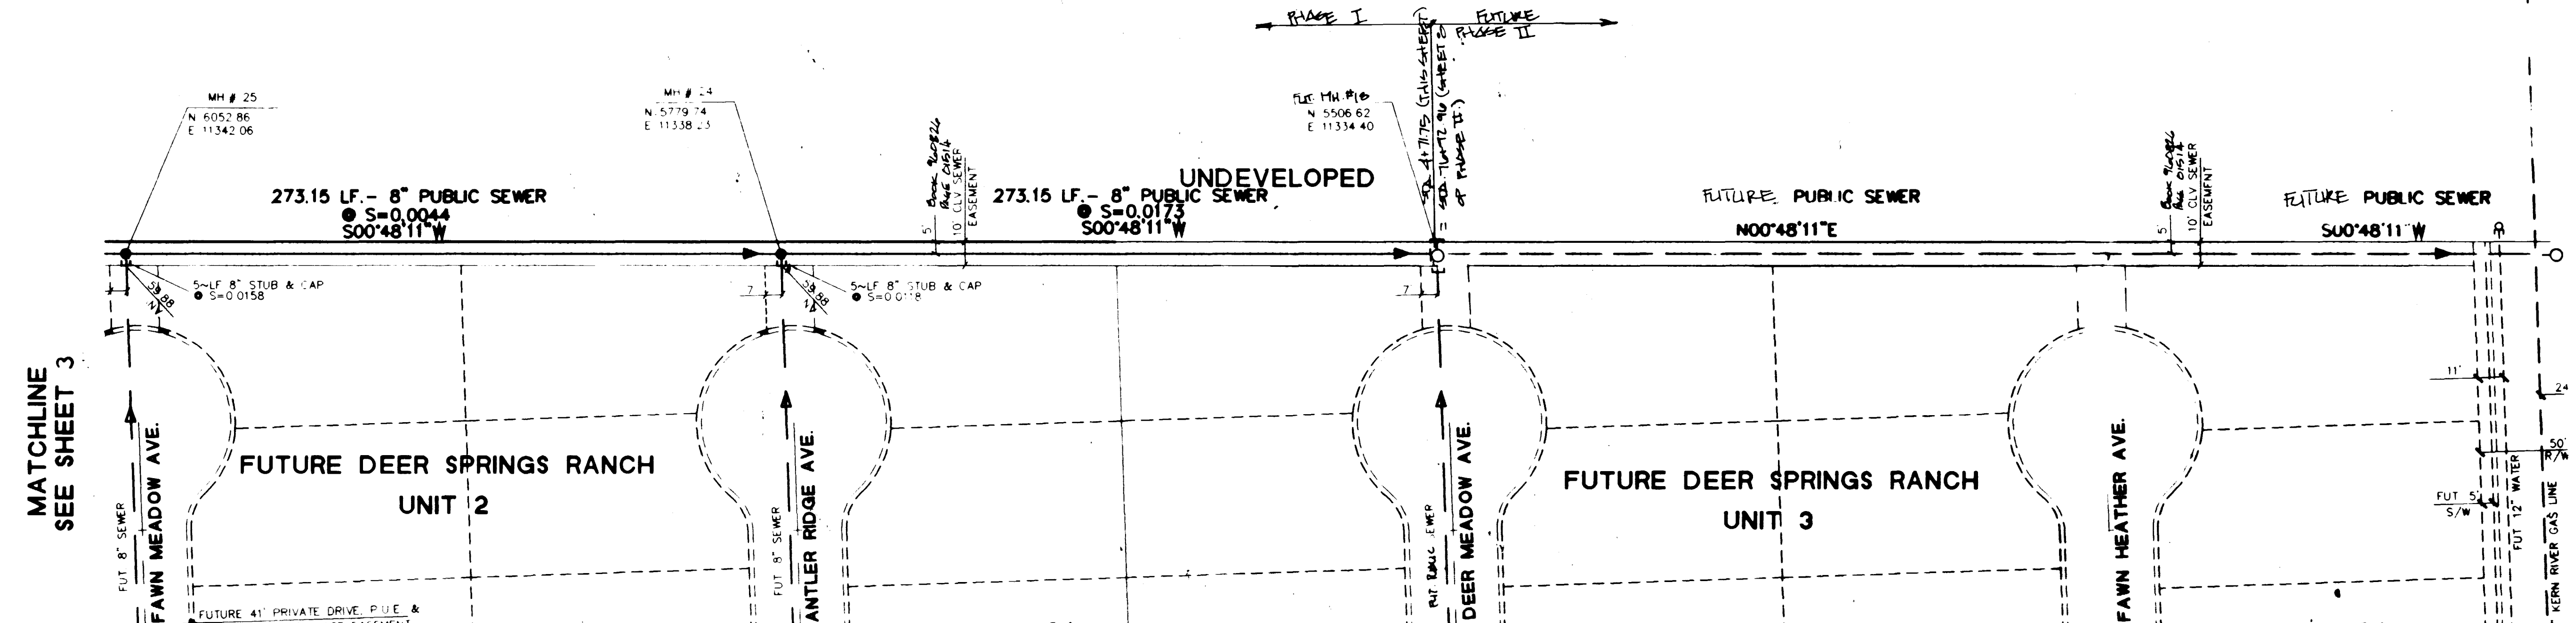



BASIS OF BEARINGS

SOUTH 88°55'31\"/>

BENCHMARK

CLARK COUNTY BM # 0090 - 21N1W8
RIVET AND SQUARE ALUMINUM PLATE IN TOP OF CENTER
OF HEAD WALL ON THE WEST SIDE OF HIGHWAY - 95,
NEAR MILE MARKER 88.95
ELEVATION = 764.787 METERS (NAVD'88)
ELEVATION = 2509.14 U.S. SURVEY FEET (NAVD'88) (NGVD 29)

Call
before you
Dig
1-800-227-2600

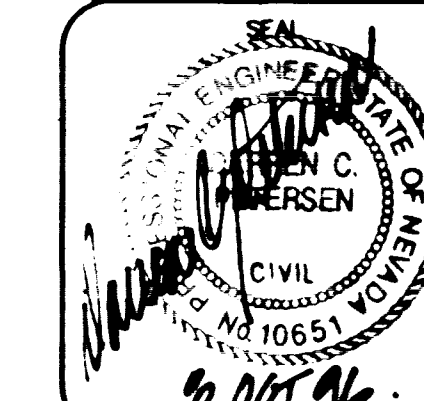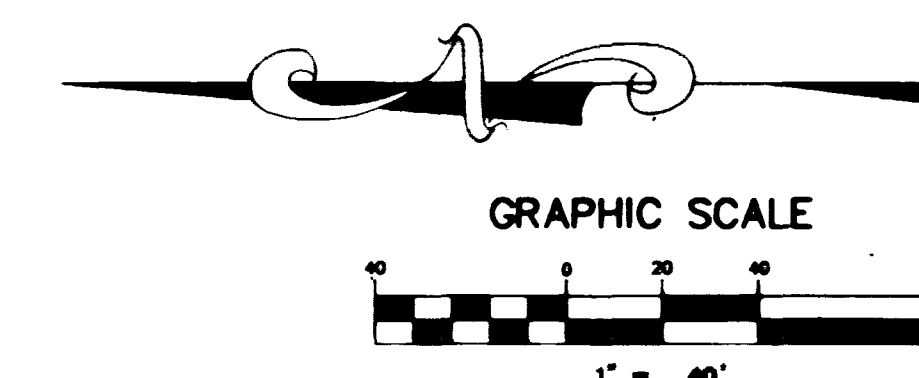

NO. NO.	4884
BY	CKH
DATE	5-30-96
SCALE	HORIZ. 1\"/>
SHEET	2 of 4 SHEETS

8885

For laterals see each unit
307Y-4478-OS

