
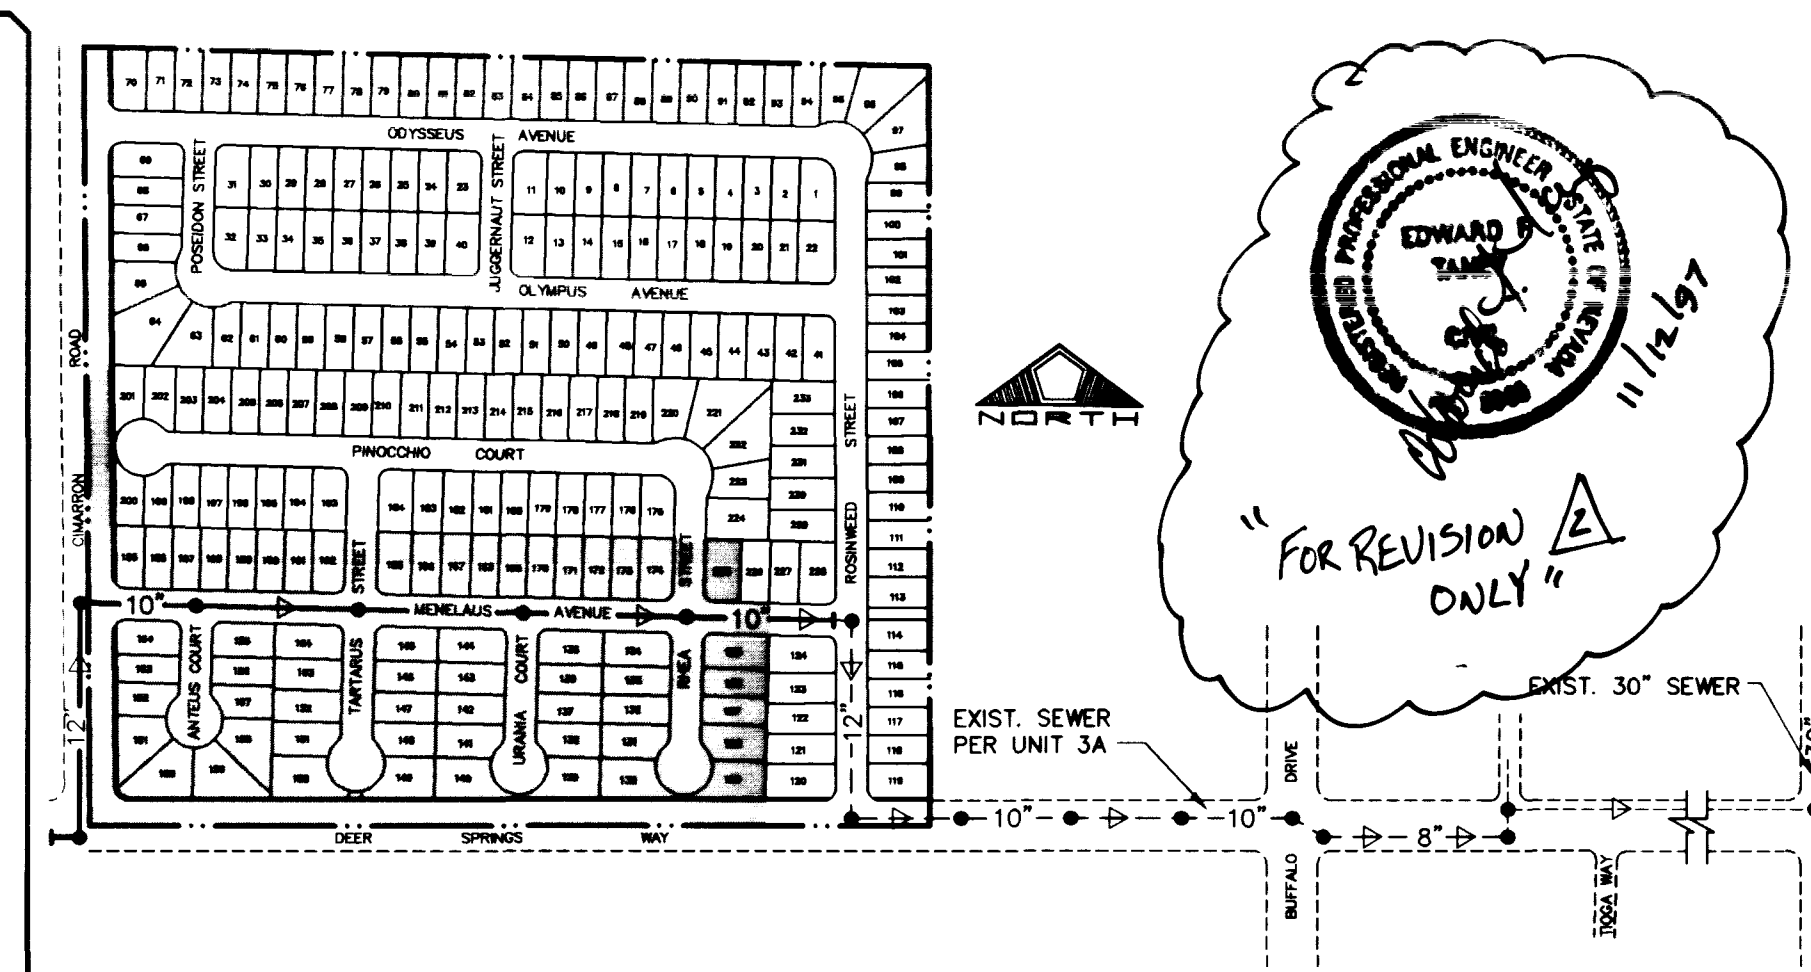
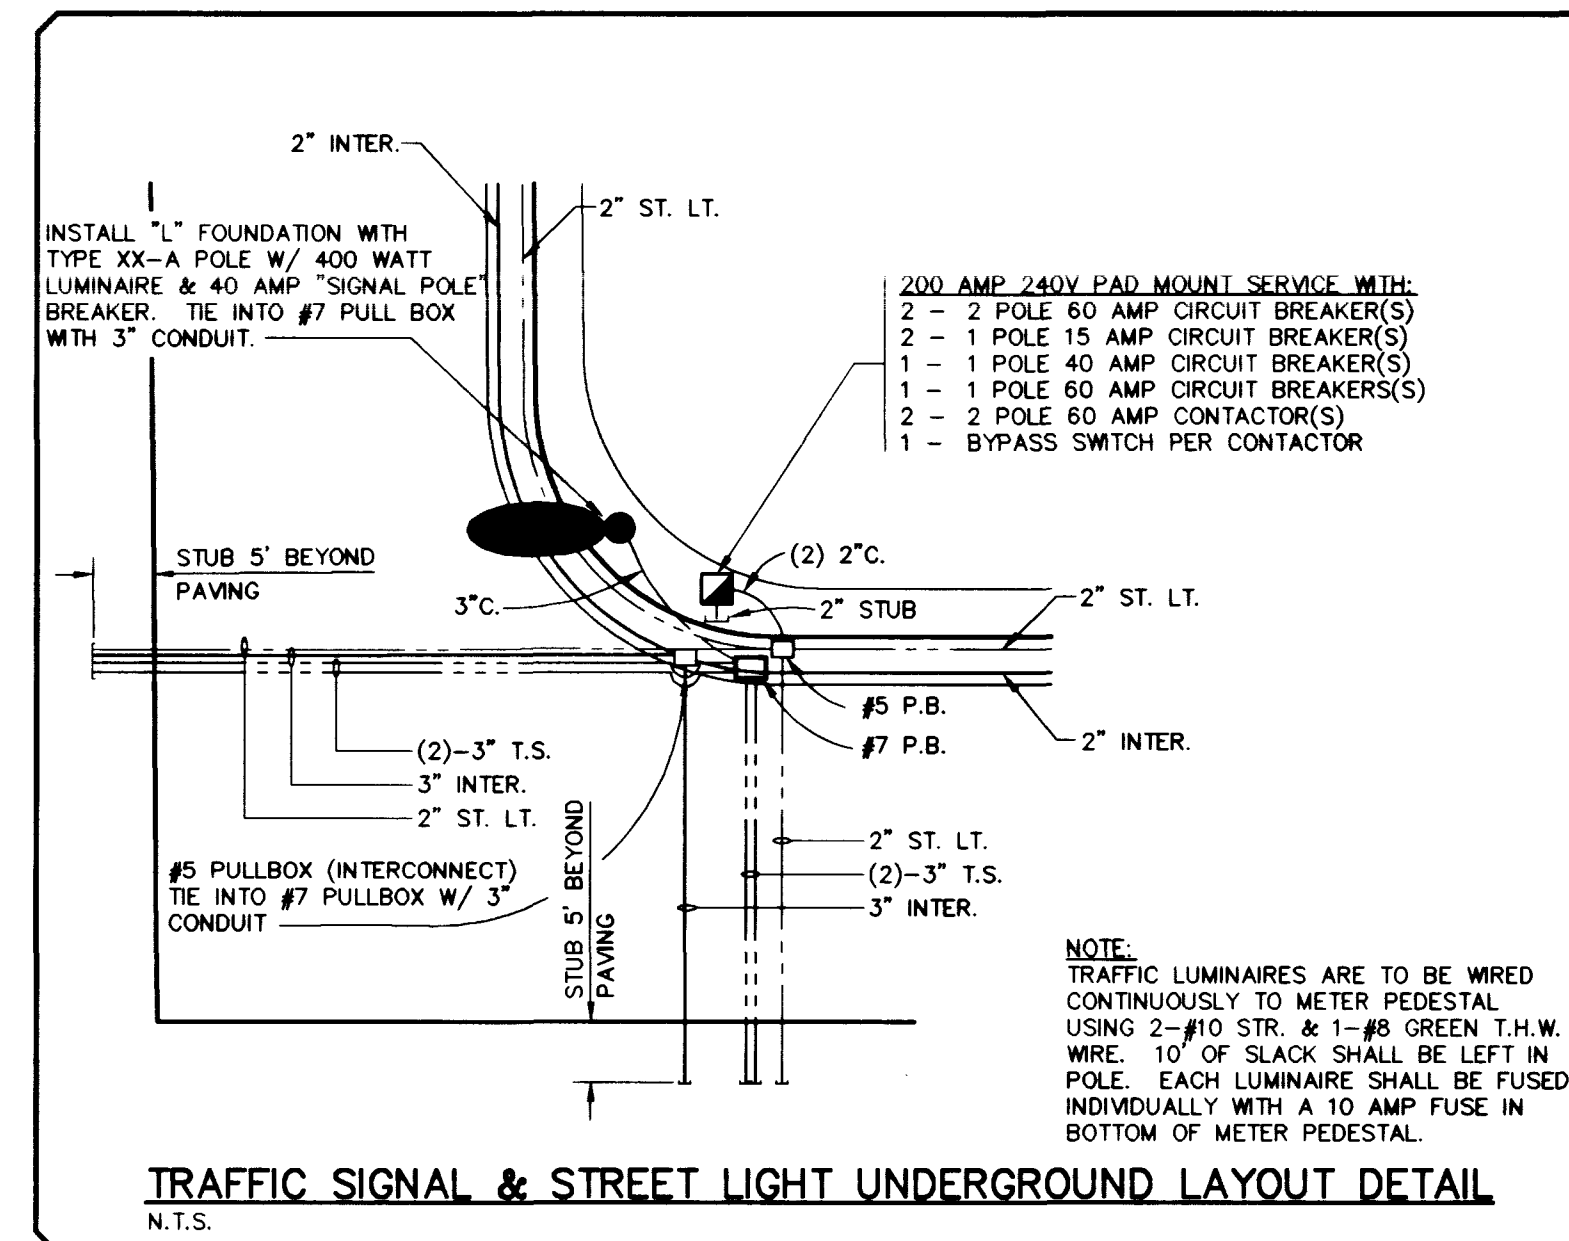
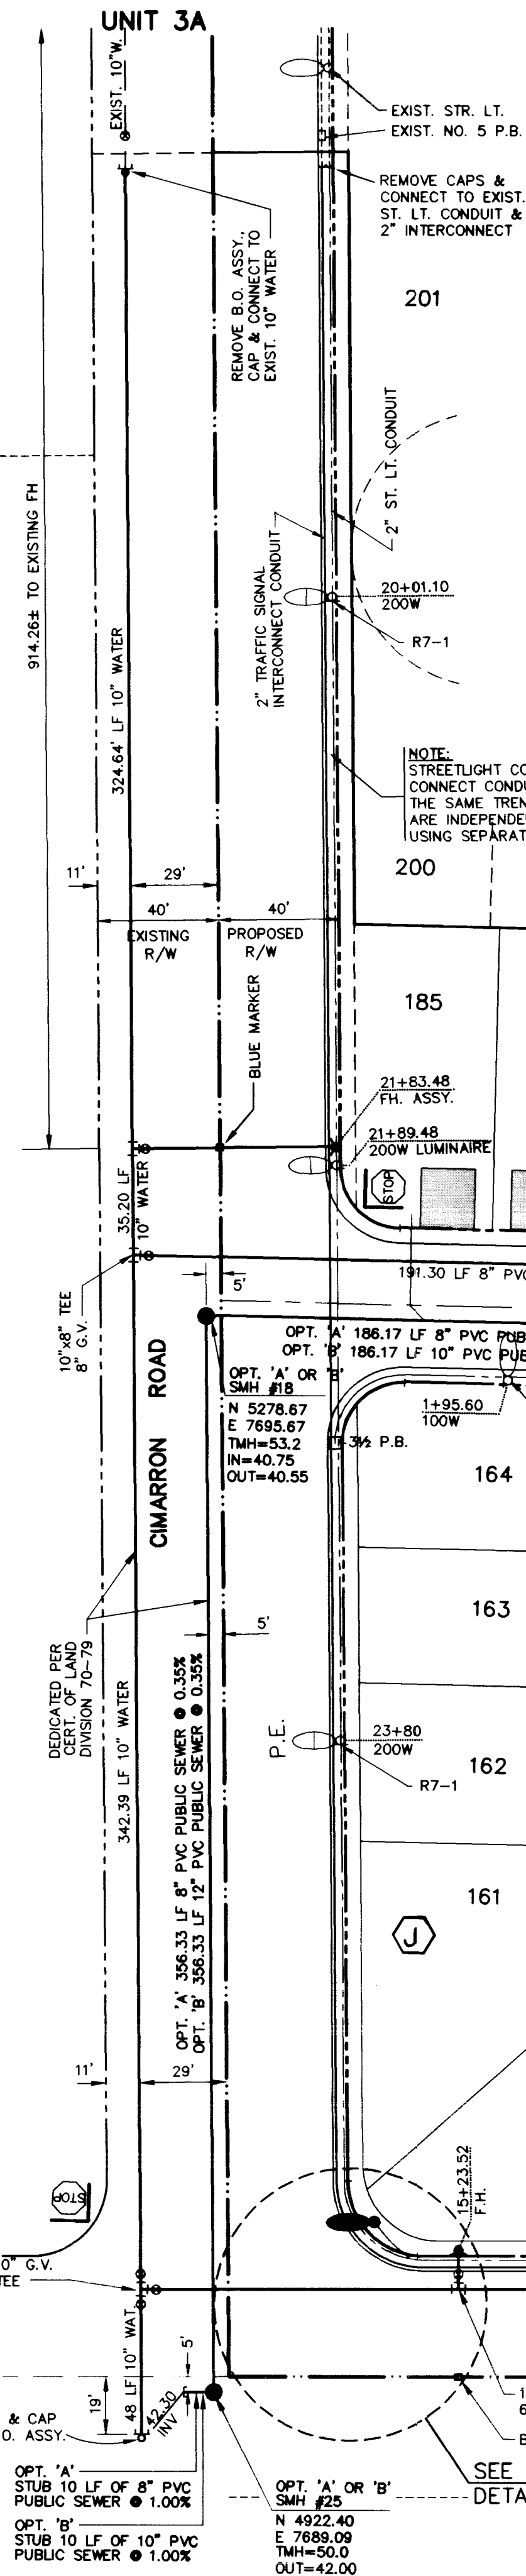
 
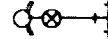
 
 
 




UNIT 3A

 


KEY MAP & SEWER DISCHARGE ROUTE MAP
N.T.S.

UTILITY LEGEND

	EXISTING WATER LINE
	PROPOSED WATER LINE
	EXISTING FIRE HYDRANT
	PROPOSED FIRE HYDRANT
	1/2" GATE VALVE
	REDUCER
	EXISTING SEWER LINE
	PROPOSED SEWER LINE
	PROPOSED SEWER LATERAL
	EXISTING SEWER MANHOLE
	PROPOSED SEWER MANHOLE
	PROPOSED CONDUIT
	EXISTING CONDUIT
	LUMINAIRE W/ 11 GA. POLE
	PROPOSED NO. 3-1/2 CONCRETE PULL BOX W/ METAL COVER
	CONCRETE DRIVEWAY
	1/2" BLOW-OFF ASSEMBLY
	LOT REQUIRES RESIDENTIAL SEWER BACKWATER VALVE (SEE DETAIL, THIS SHEET)

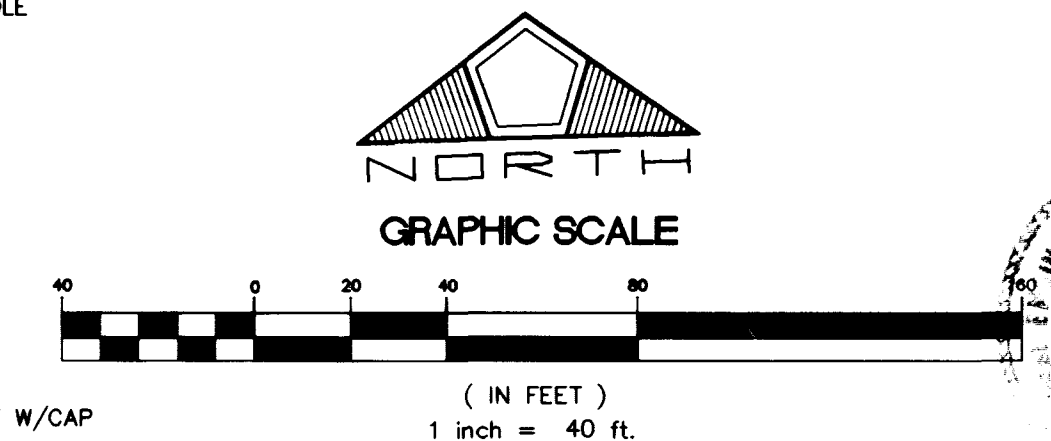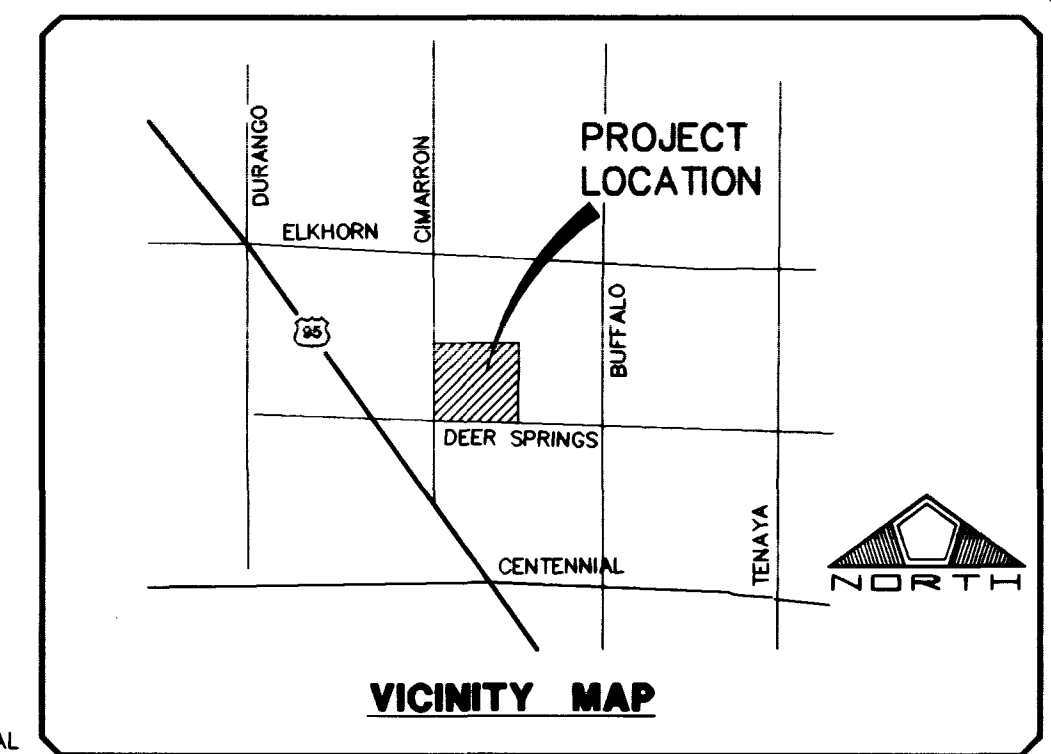


FUTURE ELKHORN - CIMARRON ESTATES UNIT 4B

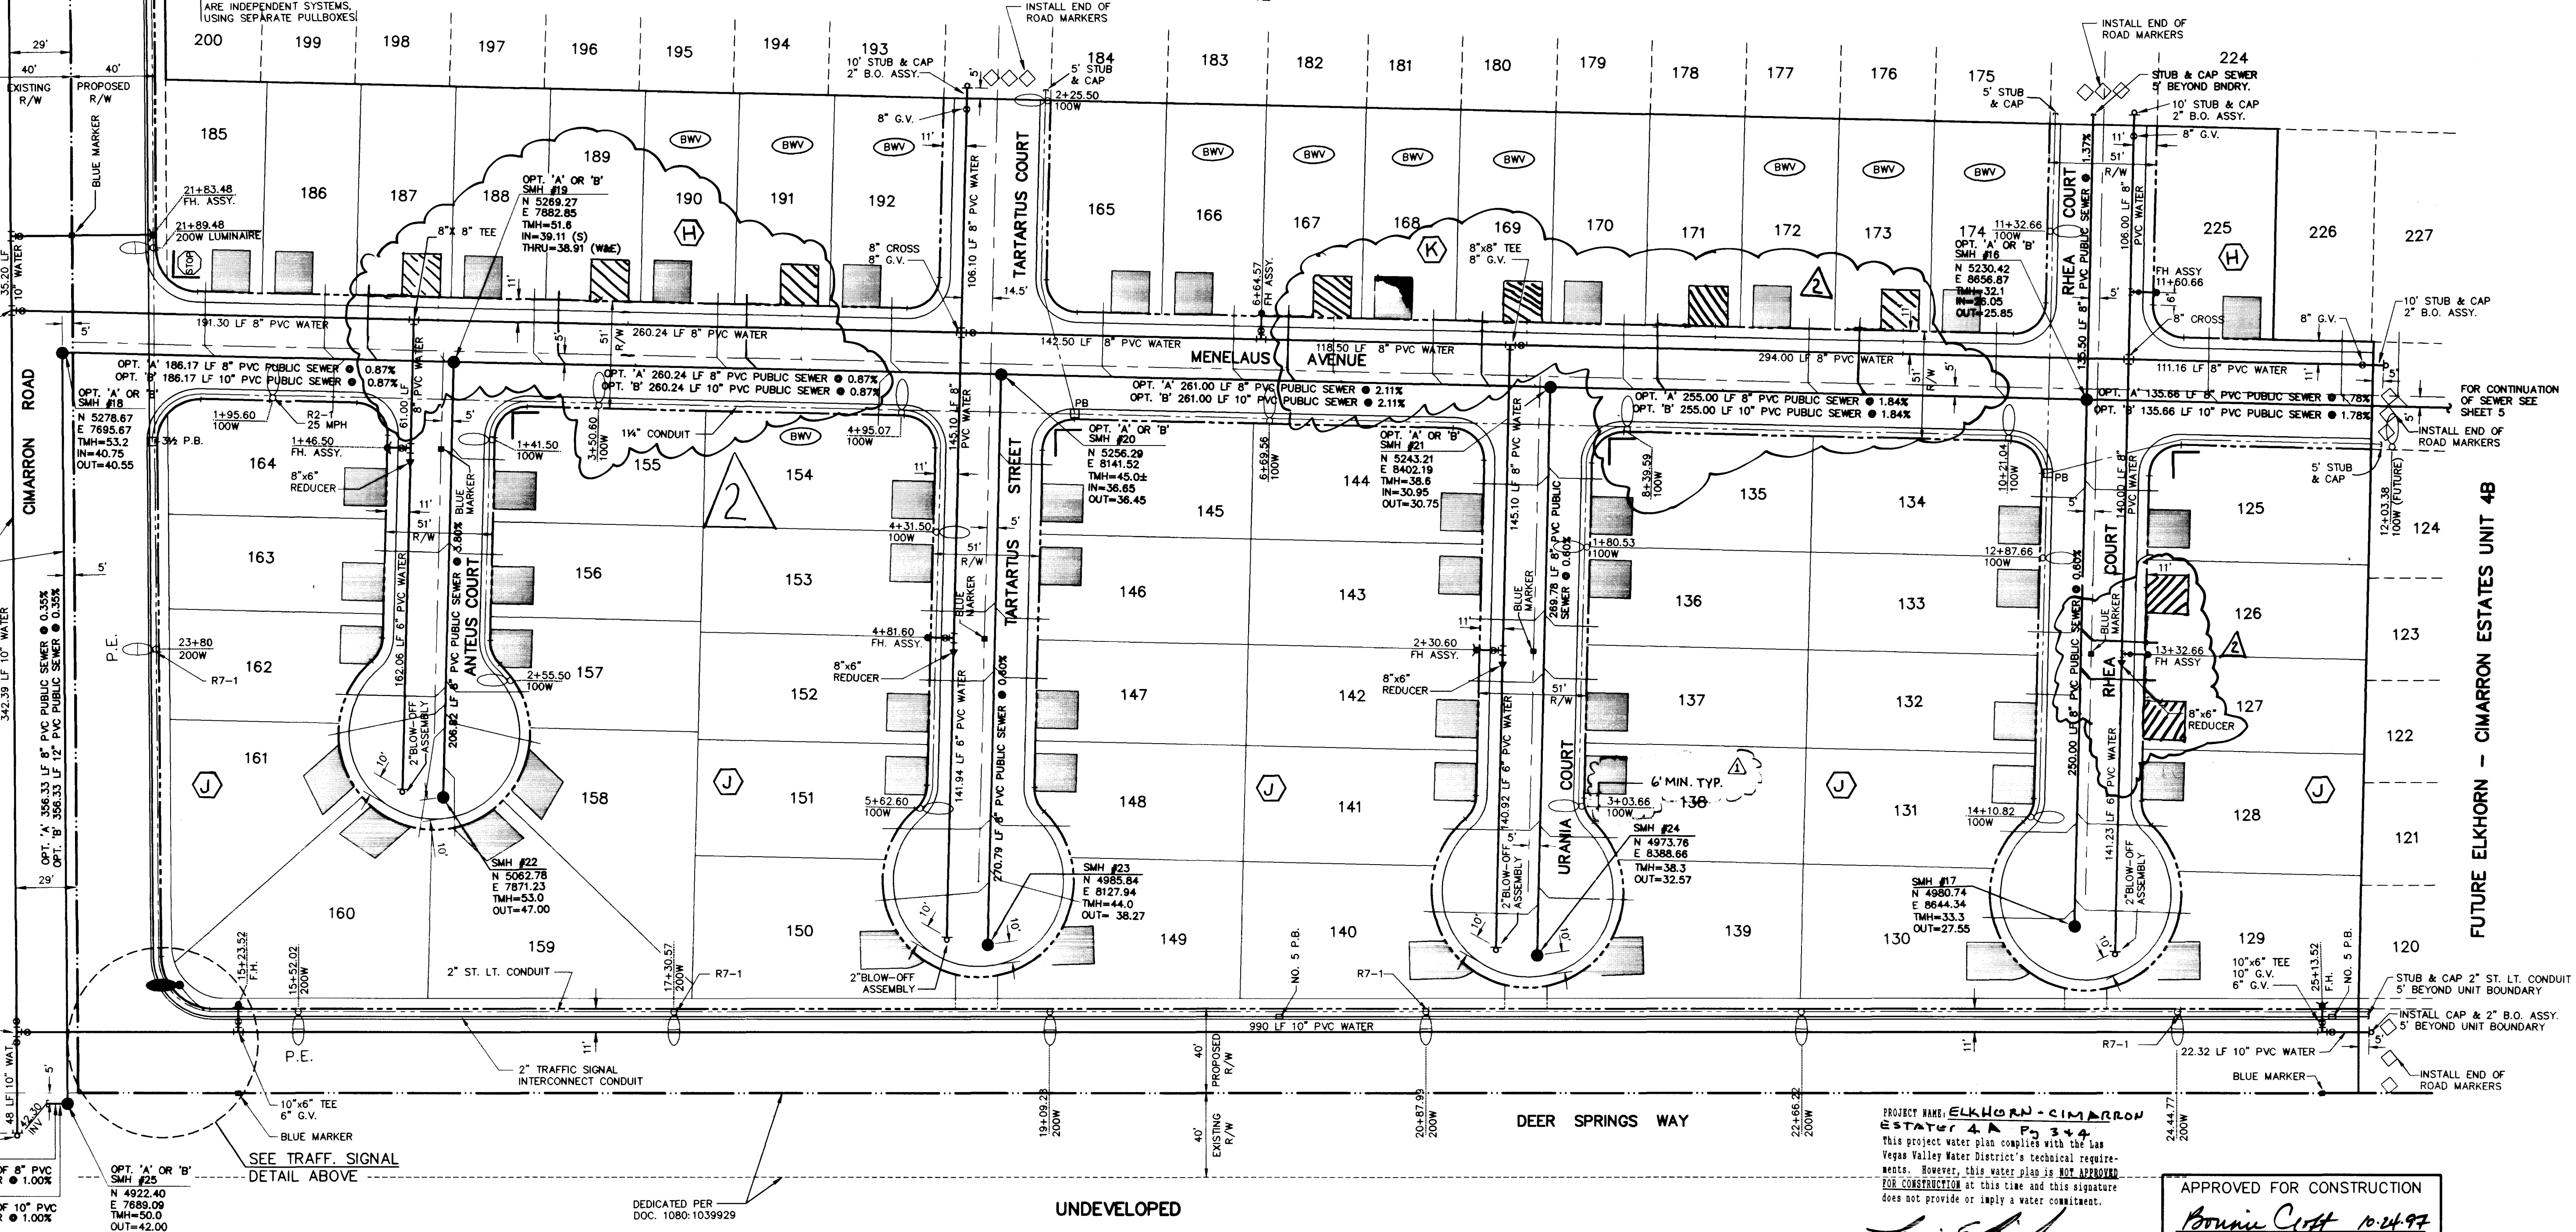

PROJECT NAME: ELKHORN - CIMARRON
ESTATE 4. A Pg 3 & 4
 This project water plan complies with the Las Vegas Valley Water District's technical requirements. However, this water plan is NOT APPROVED
FOR CONSTRUCTION at this time and this signature does not provide or imply a water commitment.

APPROVED FOR CONSTRUCTION
Bonnie Croft 10.24.97
LAS VEGAS VALLEY WATER DISTRICT DATE

PENTACORE

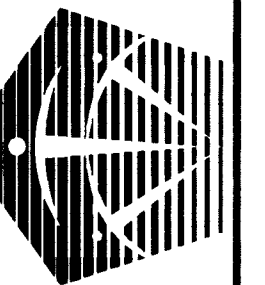


ELKHORN - CIMARRON STATES UNIT 4A

UTILITY PLAN

4
OF 13

307Y-4498-4A

