
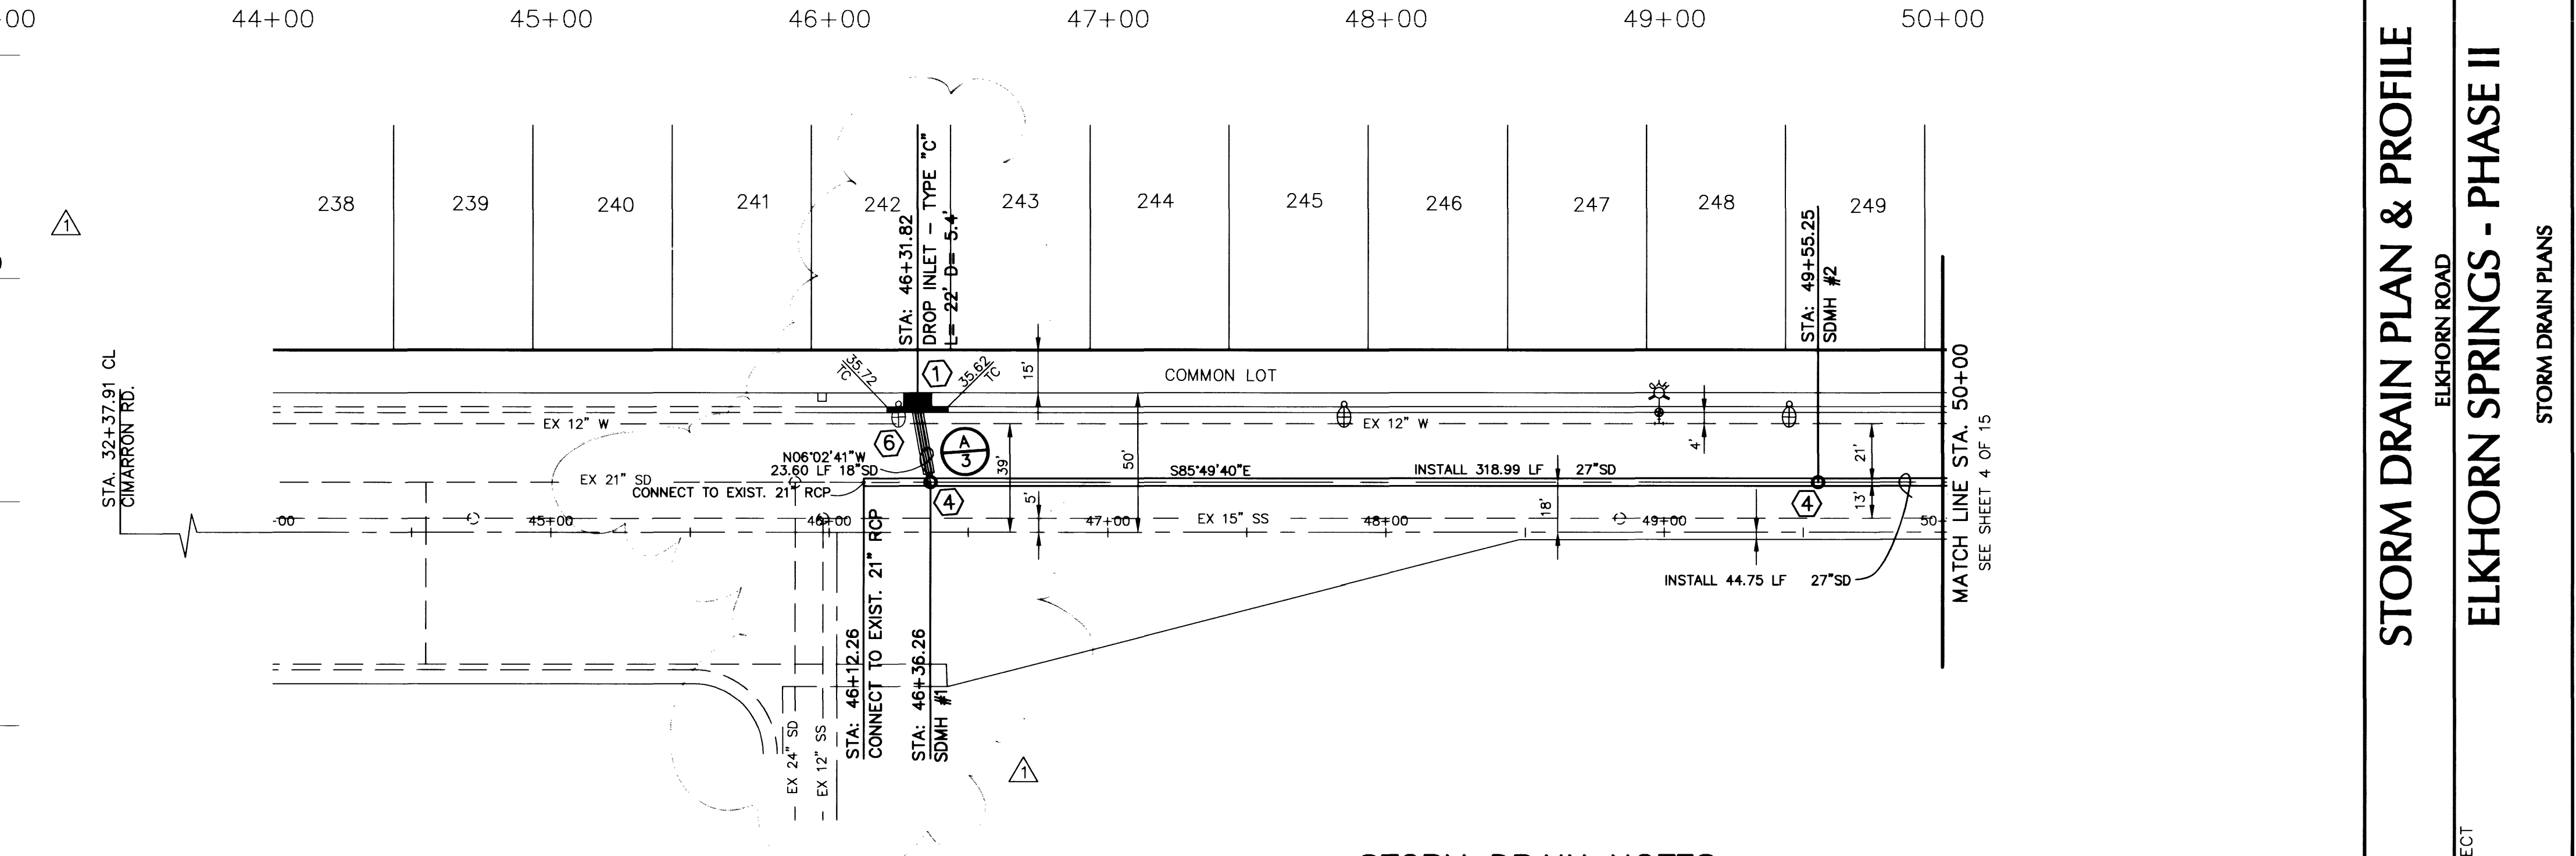
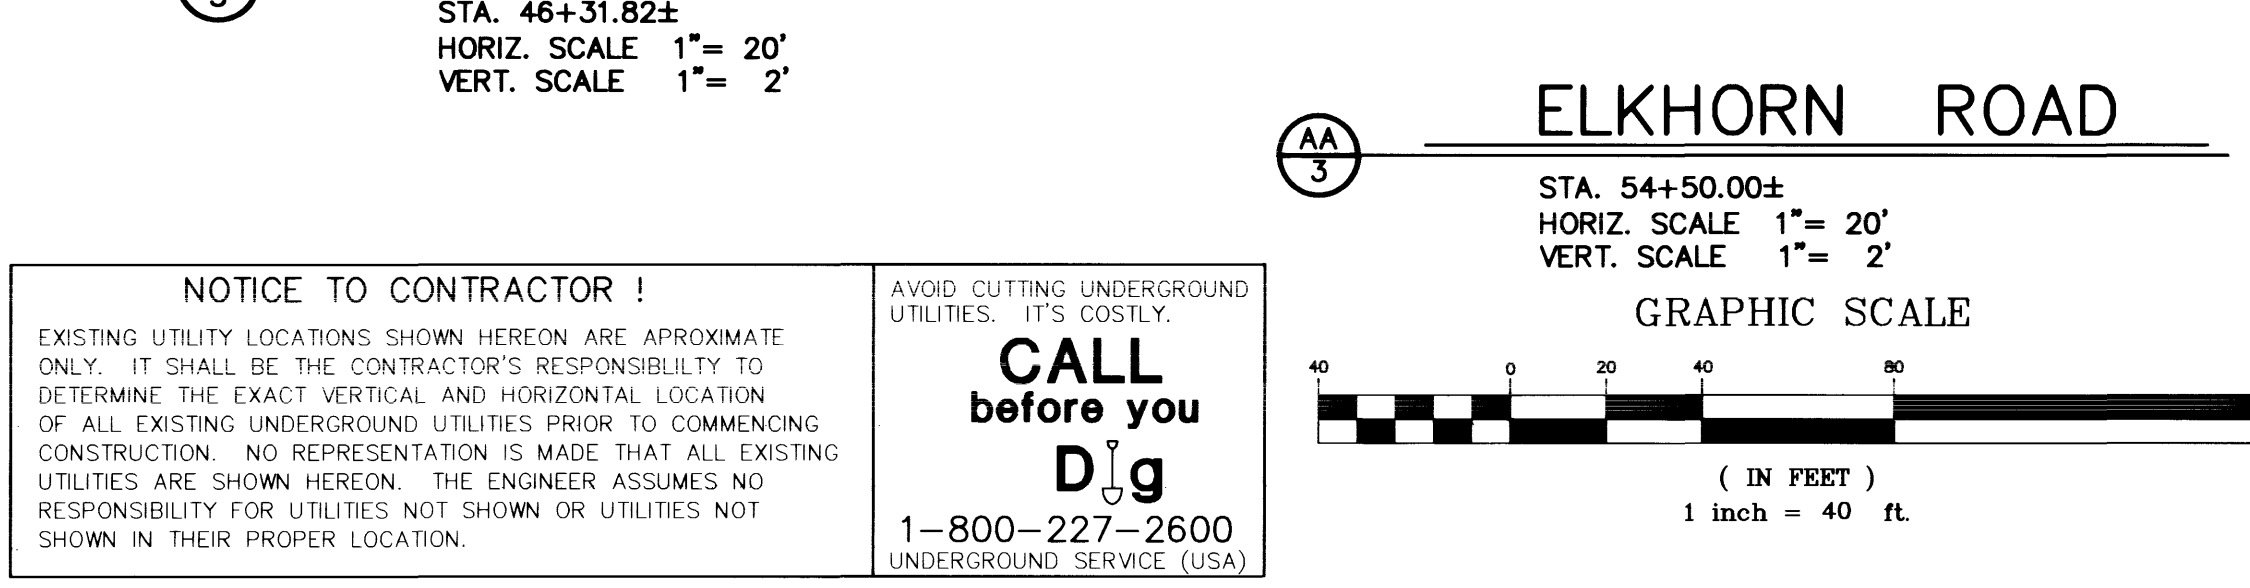
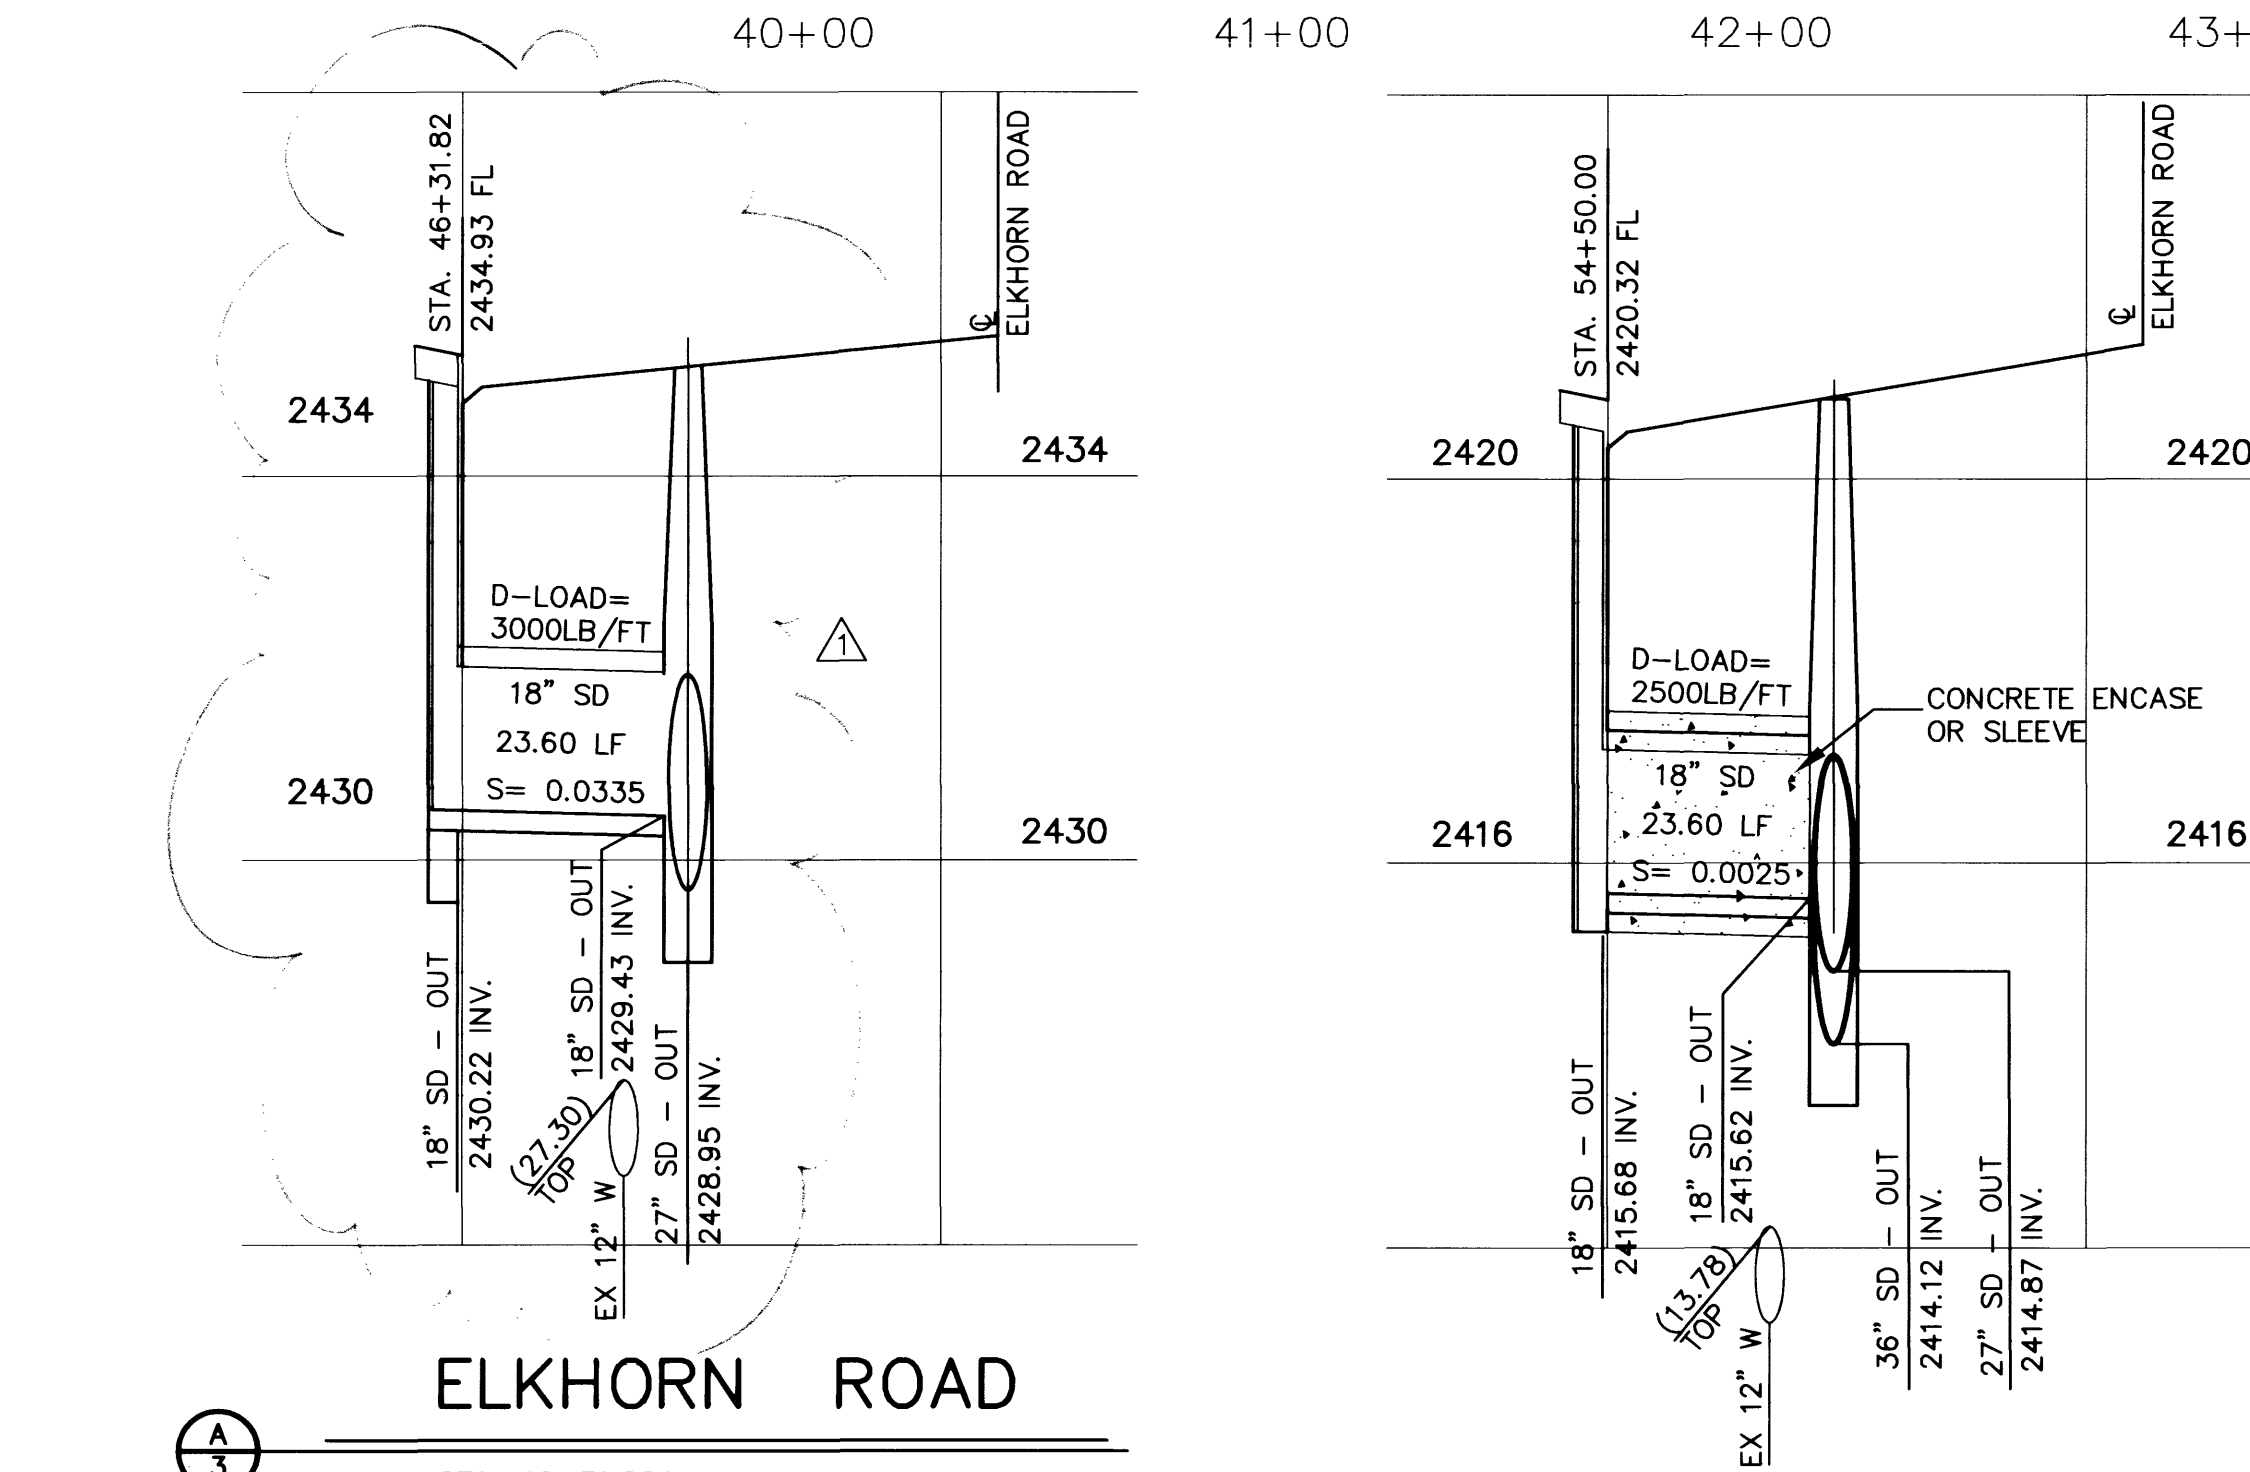


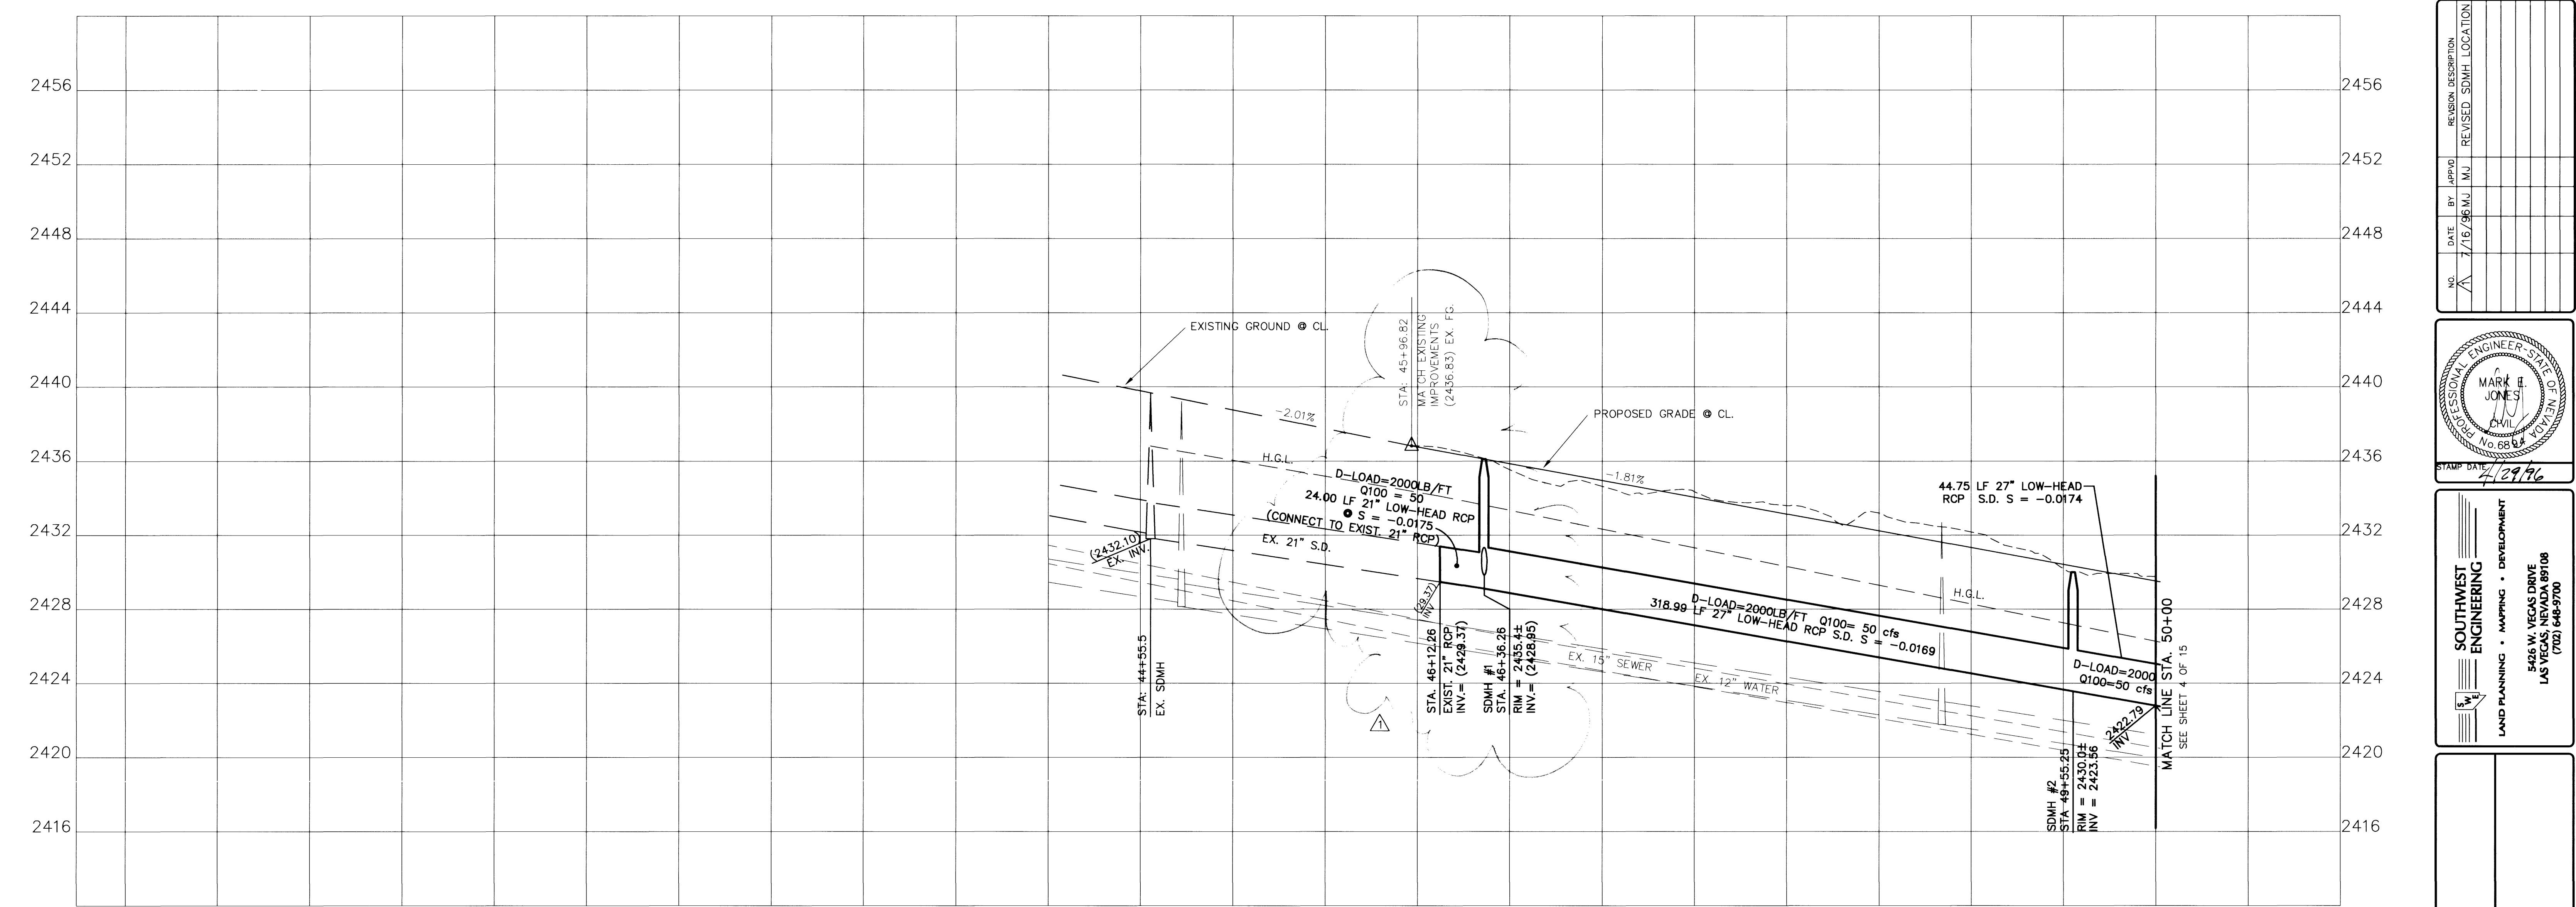

STORM DRAIN NOTES

1. INSTALL DROP INLET TYPE "C" PER STD DWG #413 & DETAILS THIS PROJECT
2. INSTALL TYPE III 60" DIA MANHOLE PER STD DWG #406
3. INSTALL TYPE I 48" DIA MANHOLE PER STD DWG #403
4. INSTALL TYPE I 60" DIA MANHOLE PER STD DWG #403
5. INSTALL TYPE II 60" DIA MANHOLE PER STD DWG #405
6. INSTALL CONCRETE ENCASEMENT PER CLARK COUNTY AREA STD DWG #505

BENCHMARK

PROJECT DATUM=NGVD29
NO.14, STATION 1LV9021N6 3" BRASS CAP USC & GS BM #113 3/4 MILE NORTH OF 1LV9028NNE6, 50' (FT.) EAST OF OLD RAILROAD BED
ELEVATION = 2452.515

EQUATION ELEVATION = 2452.515 + 2.401' = 2454.916 (TO NAVD88) (747.5266m + 0.7318m = 748.2584m)

NOTICE TO CONTRACTOR !

EXISTING UTILITY LOCATIONS SHOWN HEREON ARE APPROXIMATE ONLY. IT SHALL BE THE CONTRACTOR'S RESPONSIBILITY TO DETERMINE THE EXACT VERTICAL AND HORIZONTAL LOCATION OF ALL EXISTING UNDERGROUND UTILITIES PRIOR TO COMMENCING CONSTRUCTION. NO REPRESENTATION IS MADE THAT ALL EXISTING UTILITIES ARE SHOWN HEREON. THE ENGINEER ASSUMES NO RESPONSIBILITY FOR UTILITIES NOT SHOWN OR UTILITIES NOT SHOWN IN THEIR PROPER LOCATION.

AVOID CUTTING UNDERGROUND UTILITIES. IT'S COSTLY.

CALL before you Dig

1-800-227-2600
UNDERGROUND SERVICE (USA)

NO.	DATE	BY	APPROV	REVISION DESCRIPTION
1	7/16/96	MJ		REVISED SDMH LOCATION

STAMP DATE: 7/29/96

SOUTHWEST ENGINEERING

LAND PLANNING • MAPING • DEVELOPMENT

LAS VEGAS, NEVADA 89108
(702) 648-9700

STORM DRAIN PLAN & PROFILE

ELKHORN ROAD

ELKHORN SPRINGS - PHASE II

STORM DRAIN PLANS

TITLE	PROJECT
STORM DRAIN PLAN & PROFILE	ELKHORN ROAD

WORK ORDER NO.	DESIGN BY	DATE	SCALE	CADFILE	SHEET
950925	M. JONES	4/4/96	1" = 40'	SDIF-ELK.DWG	3 OF 15 SHEETS