



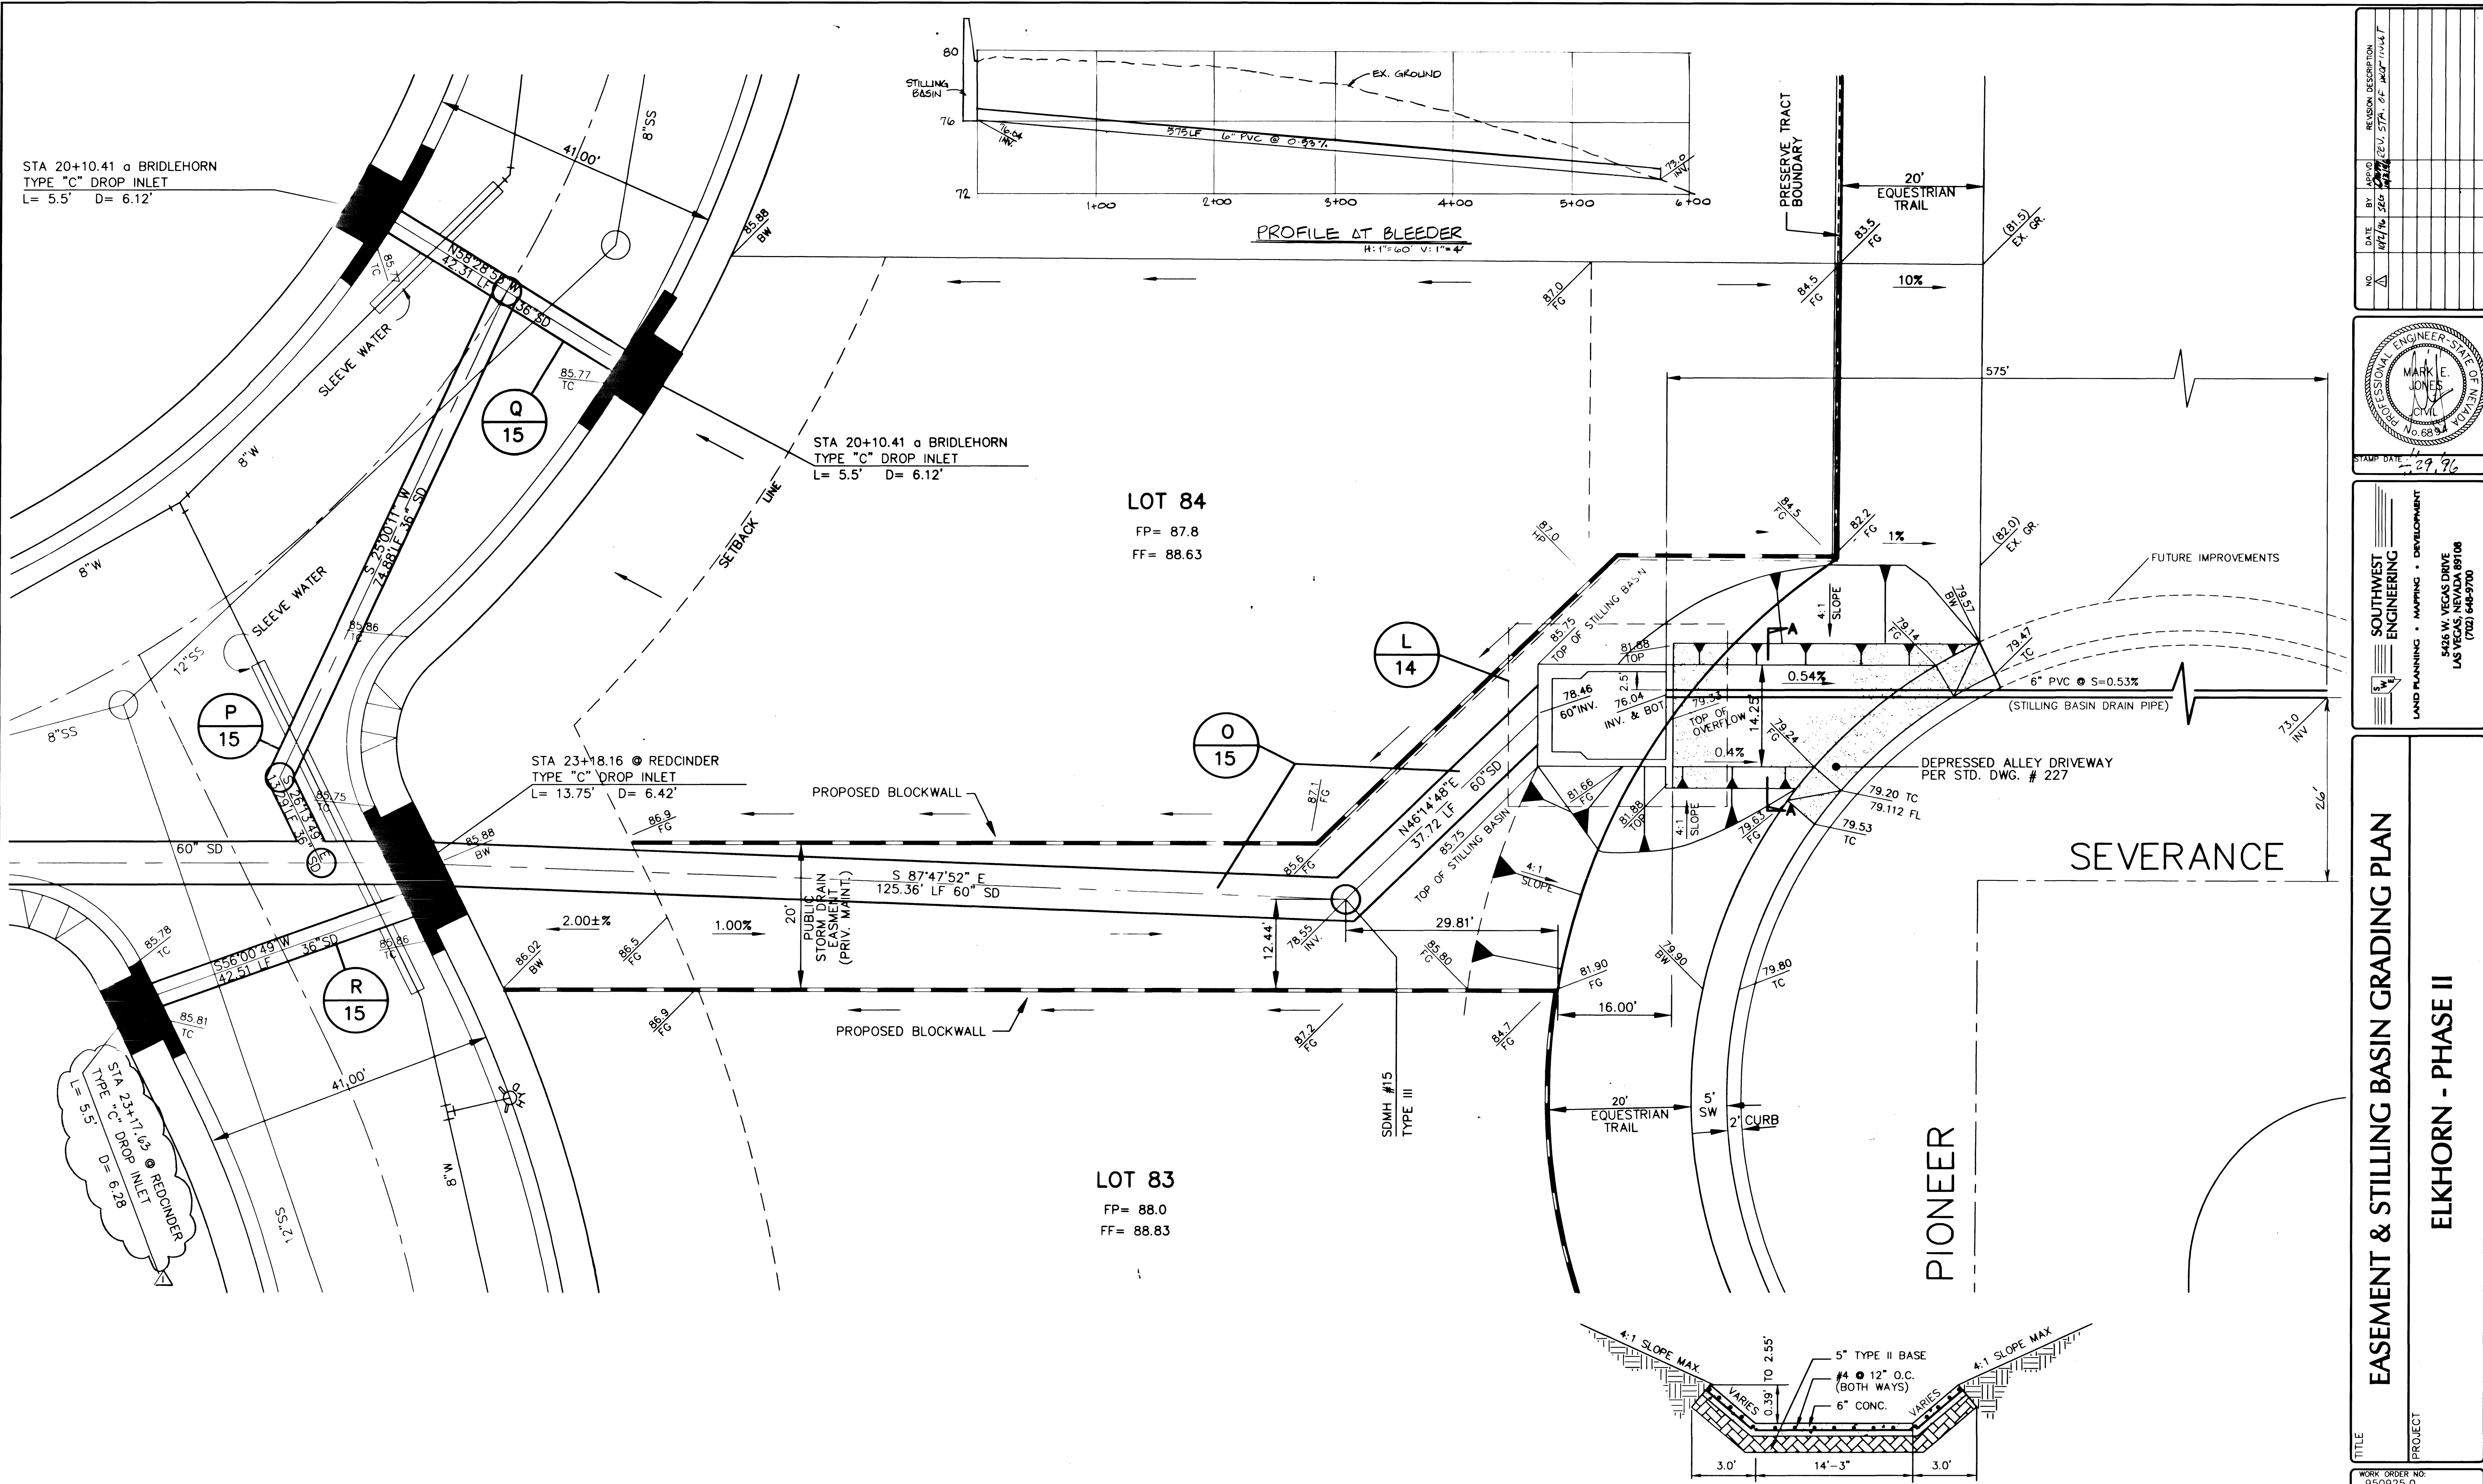

STORM DRAIN EASEMENT AND STILLING BASIN GRADING PLAN

SCALE 1" = 10'

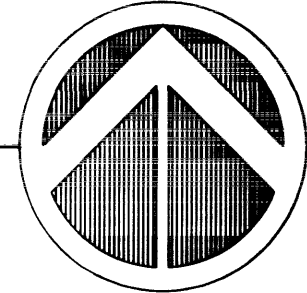

SECTION A-A
N.T.S.

NO.	DATE	BY	APP'D.	REASON DESCRIPTION


SOUTHWEST ENGINEERING
LAND PLANNING • MAPING • DEVELOPMENT
5426 W. VEGAS DRIVE
LAS VEGAS, NEVADA 89108
(702) 646-9700

TITLE	PROJECT
EASEMENT & STILLING BASIN GRADING PLAN	ELKHORN - PHASE II
WORK ORDER NO.	950925.0
DESIGN BY:	M. JONES
DATE:	2/15/96
SCALE:	1" = 10'
CADFILE:	SDIF-OUT
SHEET 10	OF 15 SHEETS

24542

11-8-91

327Y-4299-2