



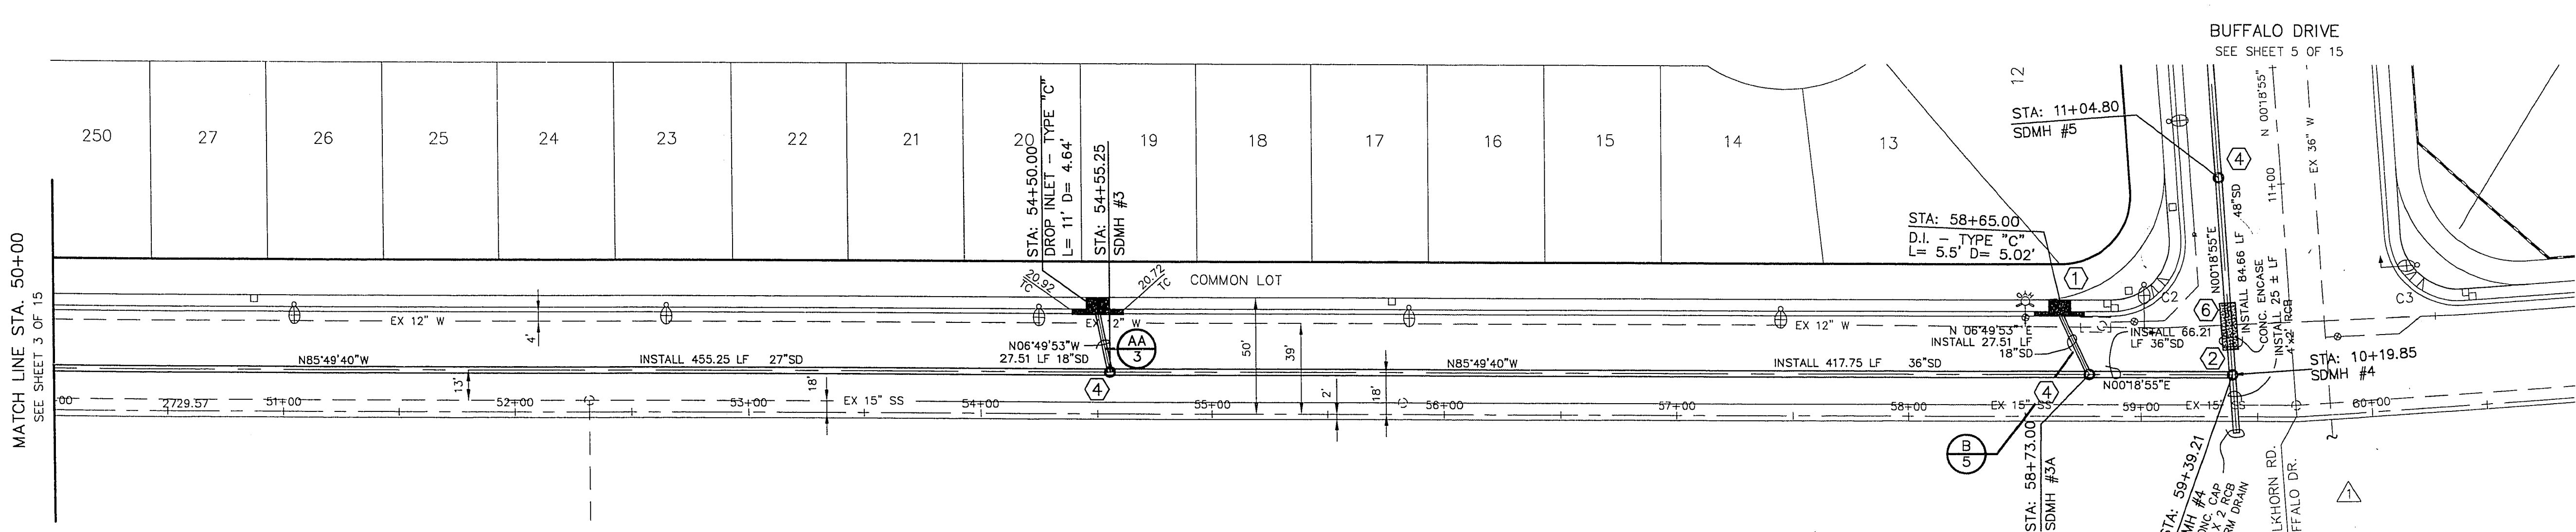

ELKHORN ROAD

NOTICE TO CONTRACTOR !
EXISTING UTILITY LOCATIONS SHOWN HEREON ARE APPROXIMATE ONLY. IT SHALL BE THE CONTRACTOR'S RESPONSIBILITY TO DETERMINE THE EXACT VERTICAL AND HORIZONTAL LOCATION OF ALL EXISTING UTILITIES PRIOR TO COMMENCING CONSTRUCTION. NO REPRESENTATION IS MADE THAT ALL EXISTING UTILITIES ARE SHOWN HEREON. THE ENGINEER ASSUMES NO RESPONSIBILITY FOR UTILITIES NOT SHOWN OR UTILITIES NOT SHOWN IN THE PROPOSED LOCATION.

CALL before you Dig
1-800-227-2600
NATIONAL SERVICE CENTER

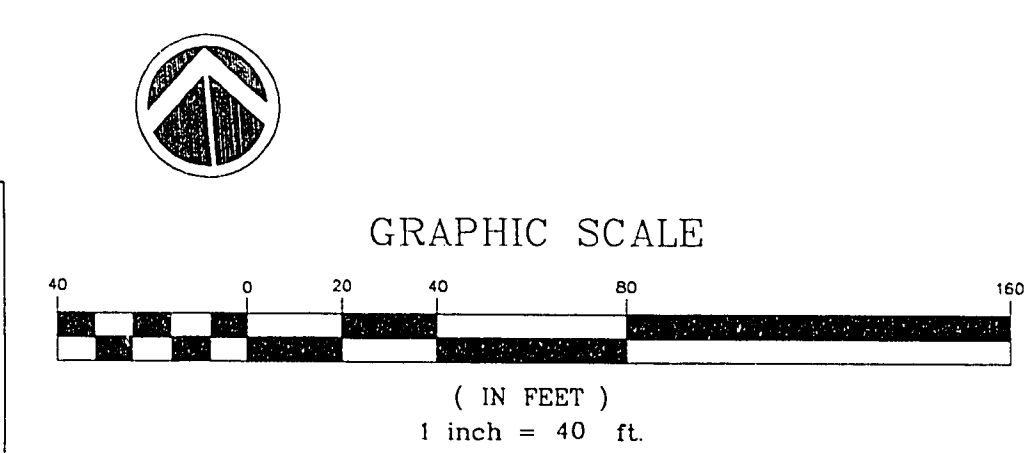

STORM DRAIN NOTES

1. INSTALL DROP INLET TYPE "C" PER STD DWG #413 & DETAILS THIS PROJECT
2. INSTALL TYPE III 60" DIA MANHOLE PER STD DWG #406
3. INSTALL TYPE I 48" DIA MANHOLE PER STD DWG #403
4. INSTALL TYPE I 60" DIA MANHOLE PER STD DWG #403
5. INSTALL TYPE II 60" DIA MANHOLE PER STD DWG #405
6. INSTALL CONCRETE ENCASEMENT PER CLARK COUNTY AREA STD DWG #505

BENCHMARK


PROJECT DATUM=NGVD29
NO.14, STATION 1LV9021N6 3" BRASS CAP USC & GS BM
#113 3/4" MILE NORTH OF 1LV9028NNE6, 50' (FT.) EAST
OF OLD RAILROAD BED
ELEVATION = 2452.515
EQUATION ELEVATION = 2452.515 + 2.401' = 2454.916
(TO NAVD88) (747.526m + 0.7318m = 748.2584m)

STORM DRAIN PLAN & PROFILE

ELKHORN SPRINGS - PHASE II

STORM DRAIN PLANS

NO.	DATE	BY	APP'D	REVISION DESCRIPTION
1	7/16/96	MJ		REVISED FOR 4X2 RCB

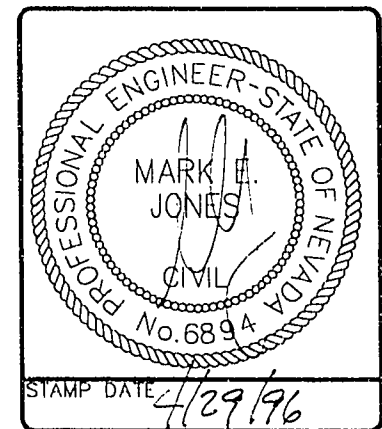

SOUTHWEST ENGINEERING
LAND PLANNING • MAPING • DEVELOPMENT
5426 W. VEGAS DRIVE
LAS VEGAS, NEVADA 89108
(702) 846-9700

TITLE	PROJECT
WORK ORDER NO.	DESIGN BY:
950925	M. JONES
DATE:	SCALE:
4/3/96	1" = 40'
CADFILE:	SHEET 4 OF 15 SHEETS
SDIF-ELK.DWG	