


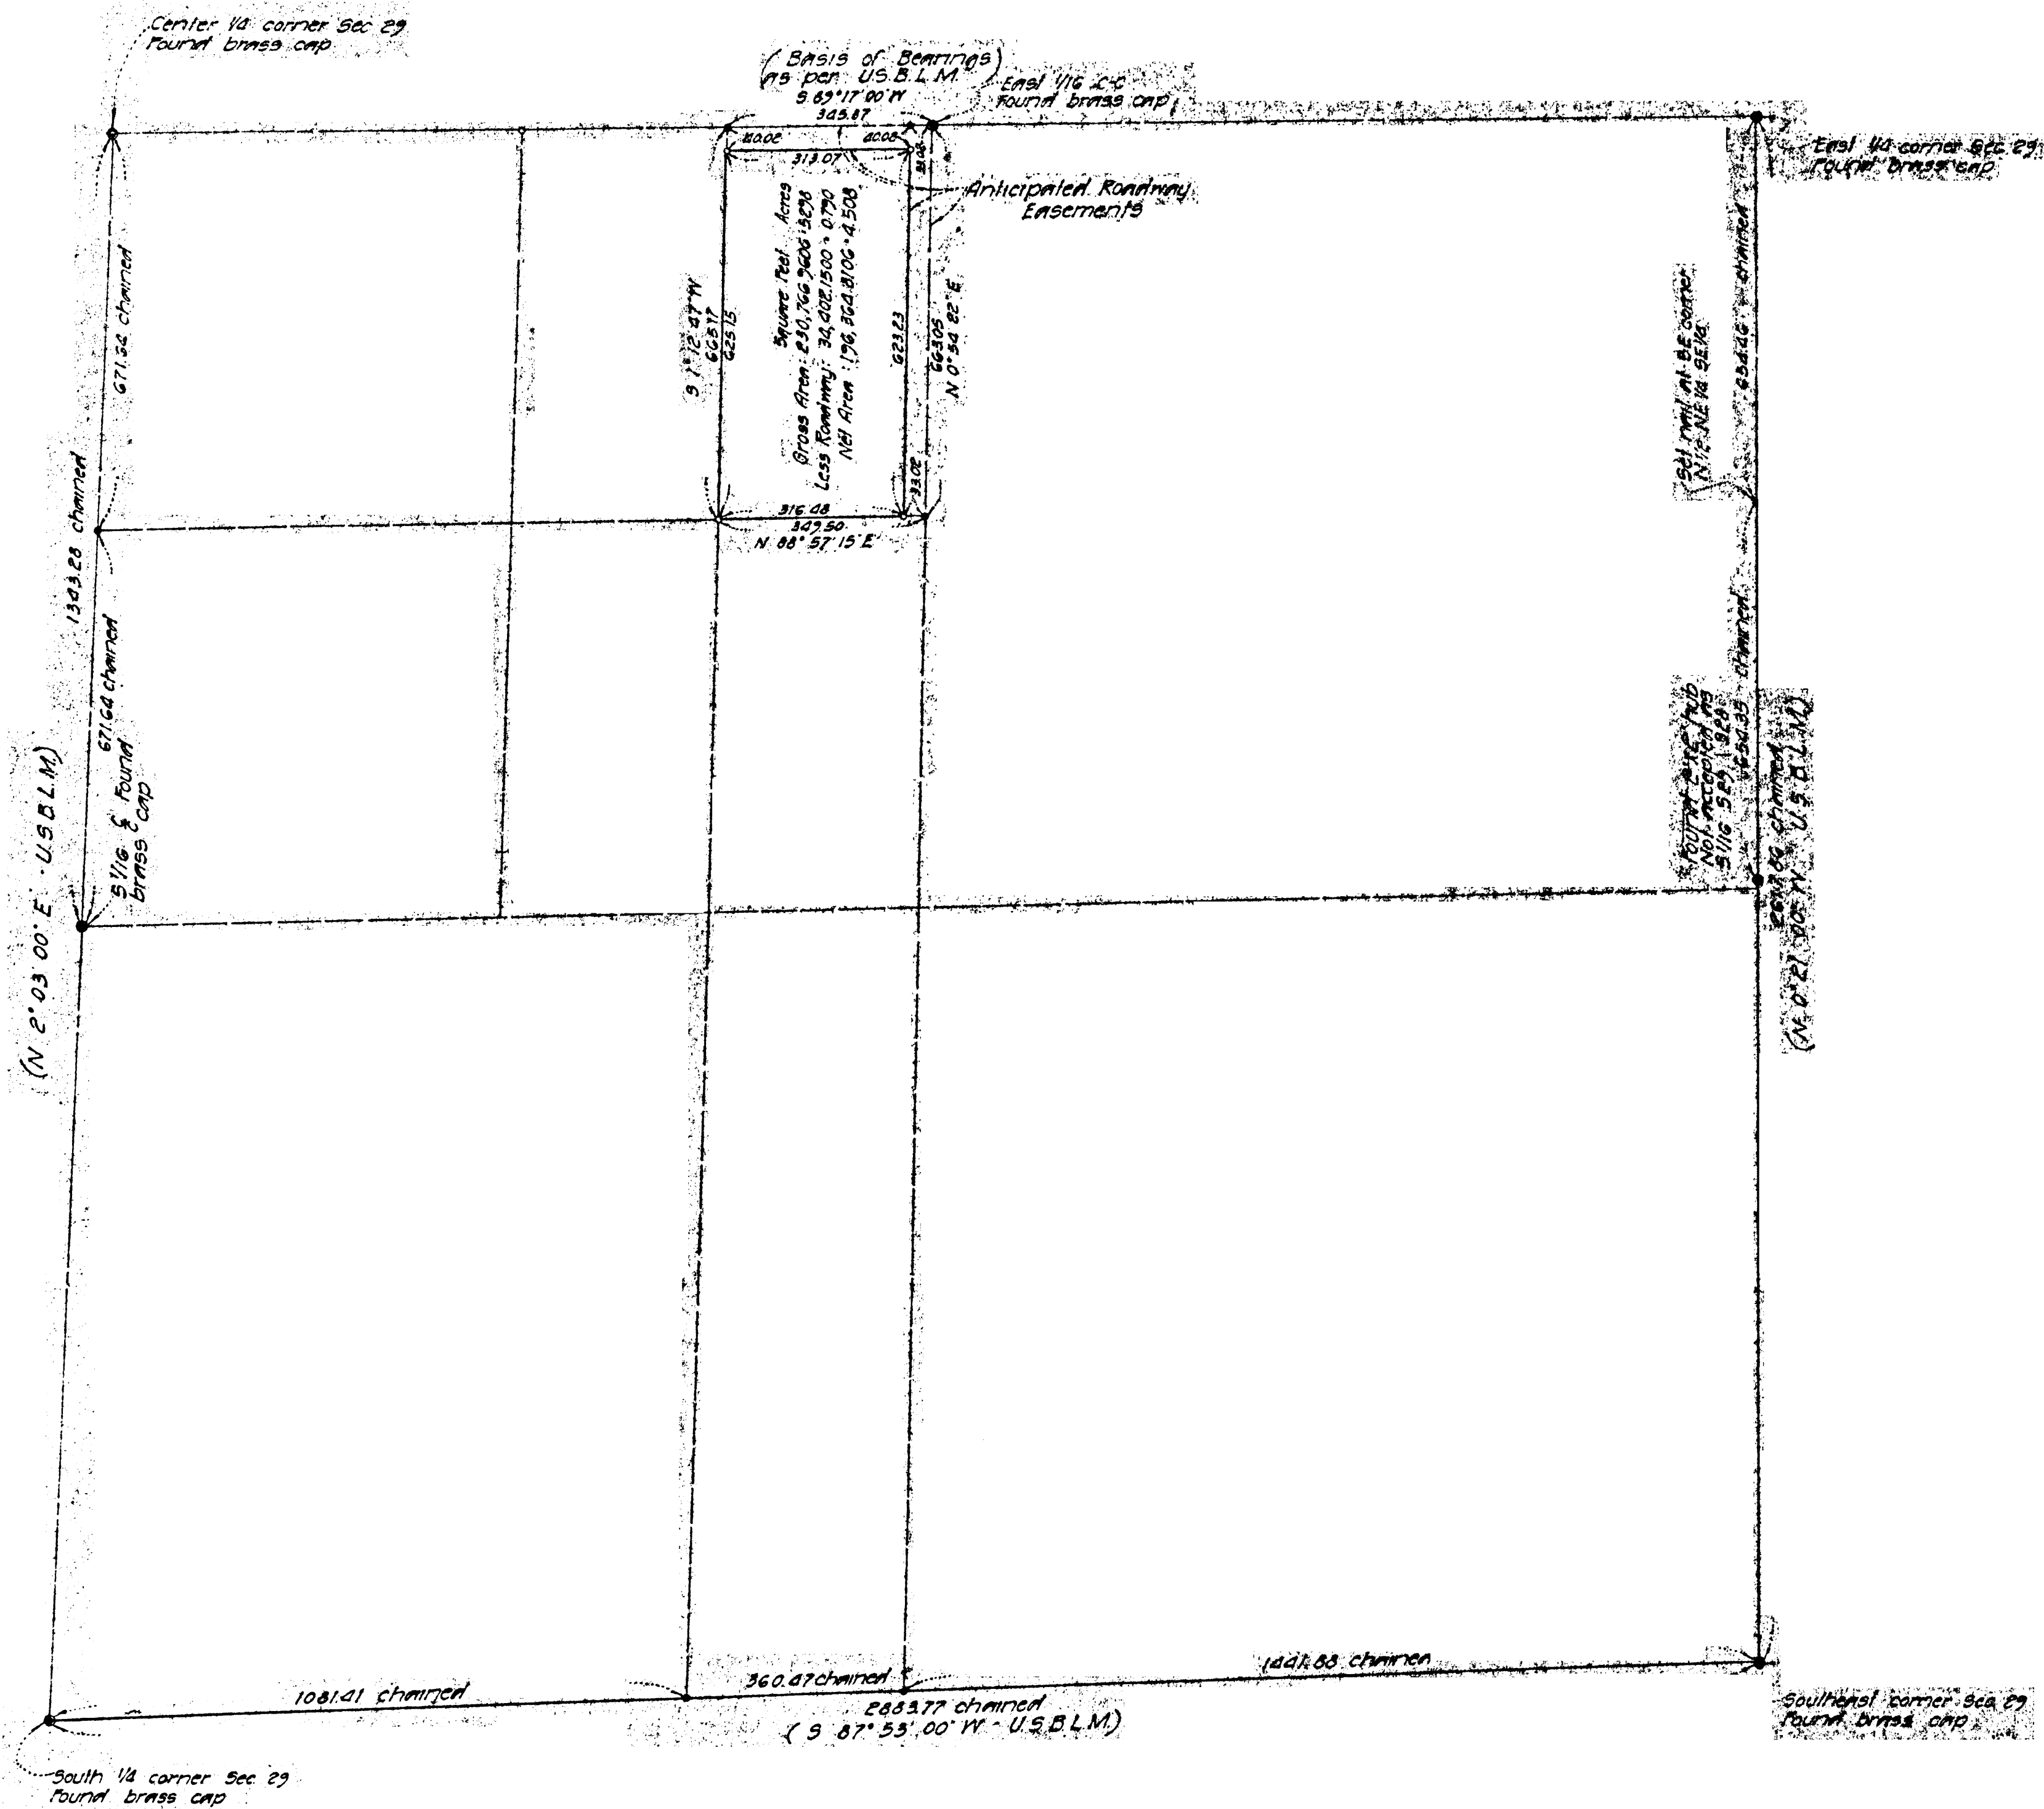

- LEGEND
- Indicates point found as shown
 - Indicates point set 1/4 1.P. & 1/4 R.L.S. 807
 - Indicates point set 2x2 hub, except as shown



CERTIFICATE

I, Jack K. Leavitt, Registered Professional Engineer - Land Surveyor do hereby certify that this map is a true and accurate representation of the lands shown hereon. All points found or set are correctly designated. This survey was completed on the 14th day of April, 1967 at the instance of Harold Riley and does not constitute a subdivision as defined by Nevada State Law.

Jack K. Leavitt
 Registered Professional Engineer
 Land Surveyor RLS 807



SOUTHEAST QUARTER (SE 1/4) SECTION 29
T. 19 S. R. 60 E. M.D.M.

641135
 NO. FILED AT THE REQUEST OF
JACK K. LEAVITT
 Date 5-24-67 at 8:12 AM
 FILED IN BOOK 53
 OFFICIAL RECORDS BOOK NO. 799
 CLARK COUNTY, NEVADA, RECORDS
 PAUL E. HORN, RECORDER
 250

RECORD OF SURVEY
 The E 1/2 NE 1/4 NW 1/4 SE 1/4 of
 Section 29, Township 19, South, Range 60 East,
 M.D.M., Clark County, Nevada

LEAVITT & HOLLER
SURVEYORS LIMITED
 Professional Engineers and Land Surveyors
 536 East Sahara Avenue Las Vegas, Nevada