13-25

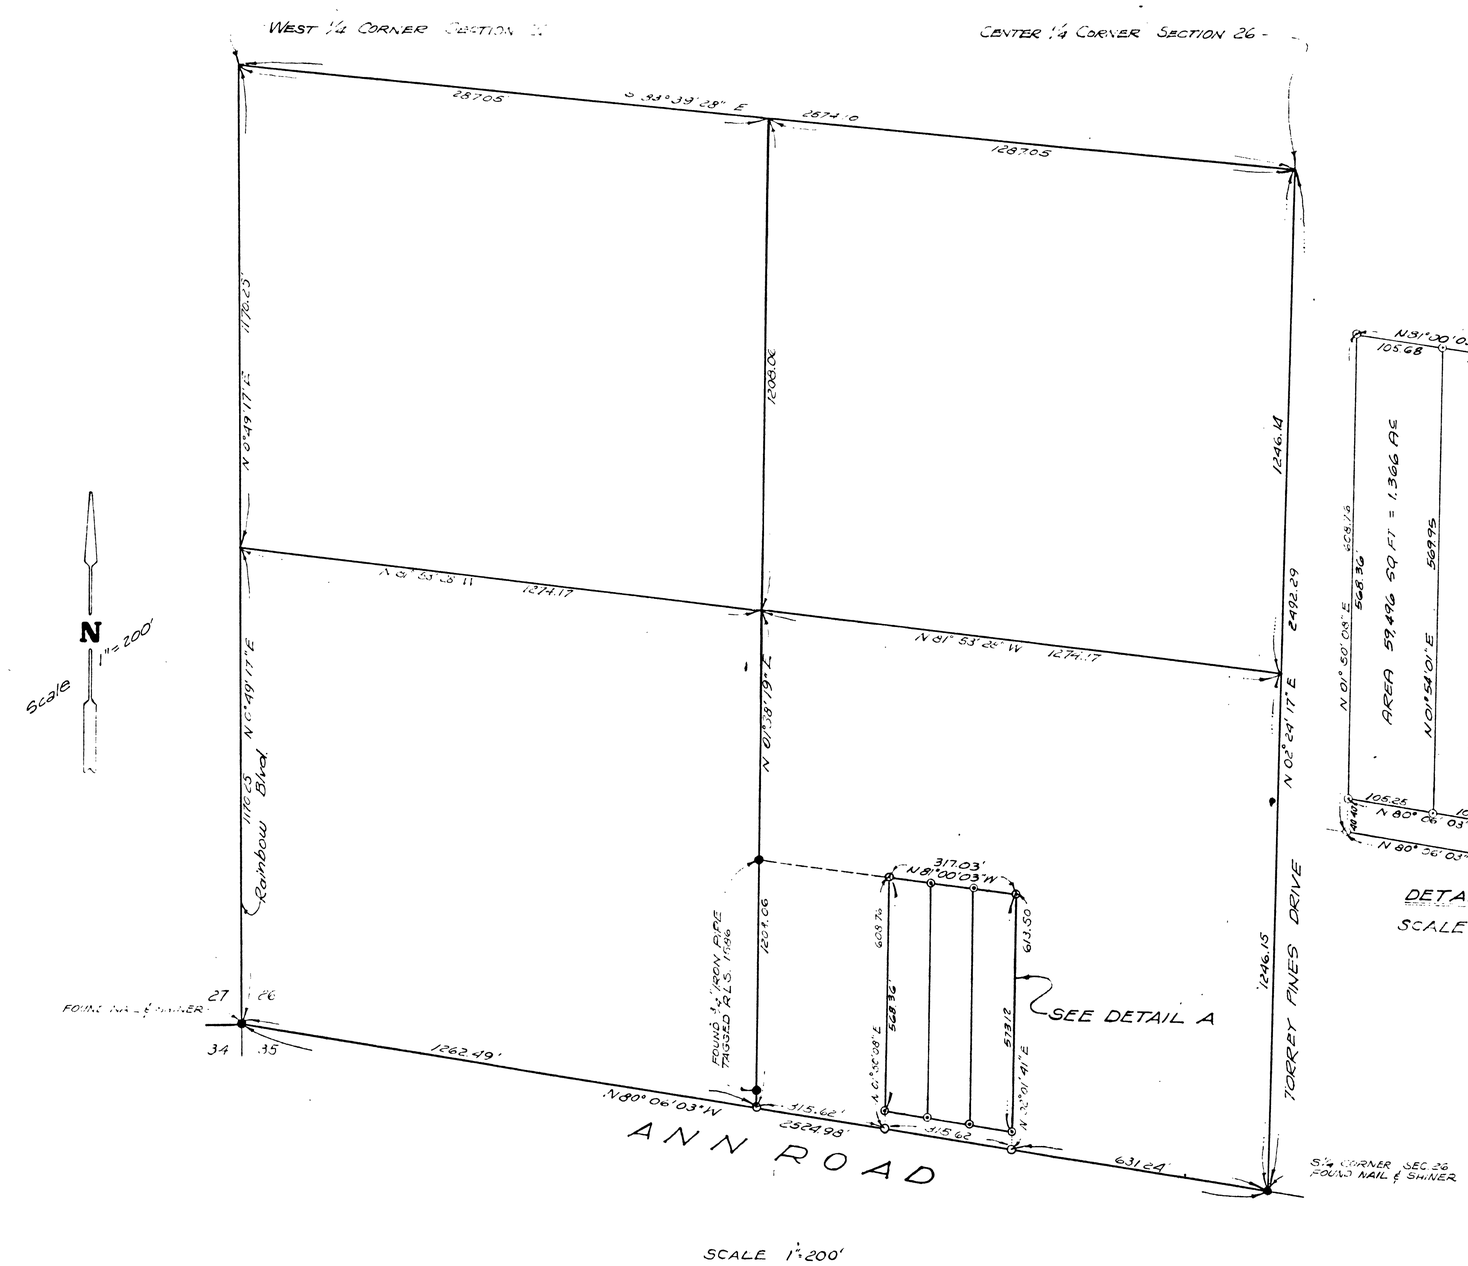

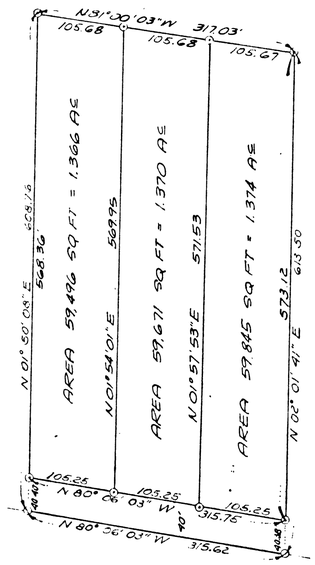

DETAIL A

SCALE 1" = 100'

L E G E N D

- ● Indicates point found - as shown.
- ⊙ Indicates point set - re-bar & alum. cap R.L.S. 6
- ○ Indicates point set - nail and shiner.

C E R T I F I C A T E

I, Jack K. Leavitt, Registered Professional Engineer - Land Surveyor do hereby certify that this map is a true and accurate representation of the lands shown hereon. All points found or set are correctly designated. This survey was completed on the 24th day of September, 1968 at the instance of Neva H. Foster and does not constitute a subdivision as defined by Nevada State Law.

Jack K. Leavitt
Registered Professional Engineer
Land Surveyor RLS 807

BASIS OF BEARING - THE SOUTH LINE SEC. 26 AS PER R.P.E. FILE 14 PAGE 32, CLARK COUNTY NEVADA RECORDS. N 90° 06' 03" W

NO. 736855
FILED AT THE REQUEST OF
LEAVITT & HOLLER
Date 12-16-68 at 2:44 P.M.
FILE 18 PAGE 98
of Surveys
OFFICIAL RECORDS BOOK No. 918
CLARK COUNTY, NEVADA
PAUL E. HORN, RECORDER
Fee $2.50

SURVEY MAP

The E½ of the SW¼ of the SE¼ of the SW¼ of
SECTION 26
T. 19 S. R 60 E. M.D.M.
LAS VEGAS, NEVADA

LEAVITT & HOLLER
SURVEYORS LIMITED
Professional Engineers and Land Surveyors
536 East Sahara Avenue Las Vegas, Neva