


FOUND 4 STRADLERS
N. 1/4 COR. SEC. 35
ACCEPTED

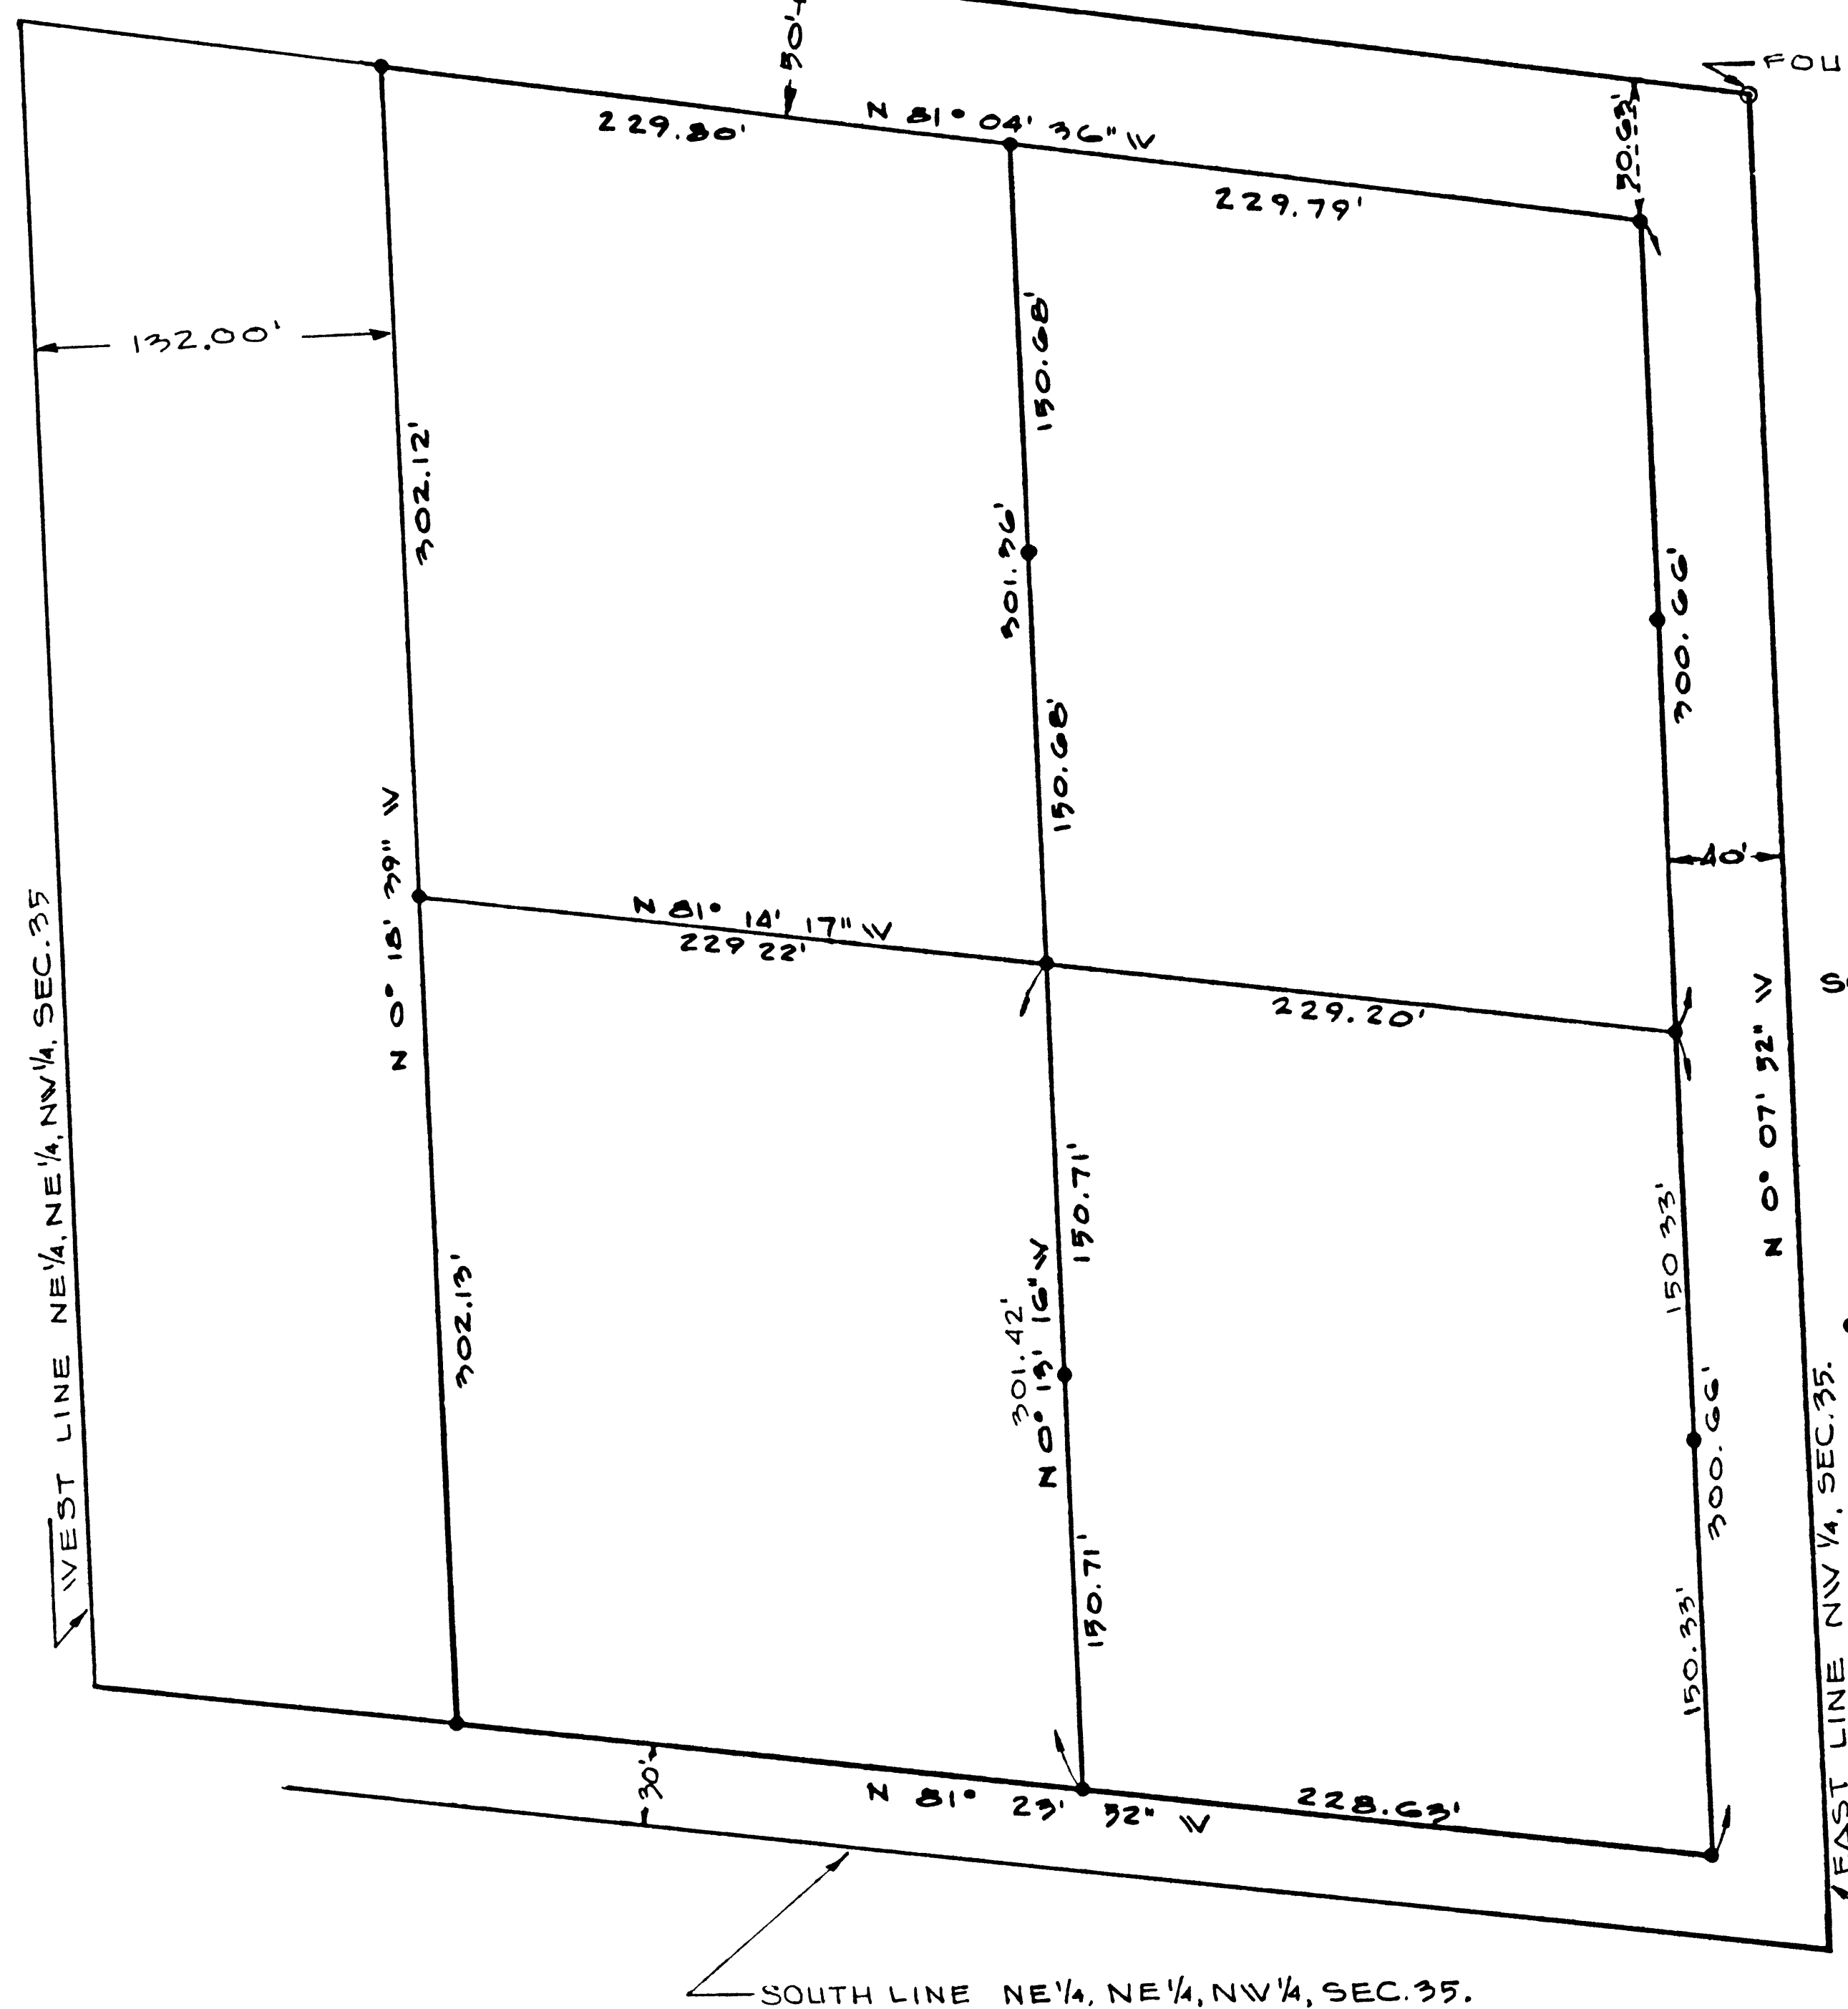

SCALE 1"=50'

LEGEND

- 2x2 SET &
TAGGED RLS.1811

- SOUTH LINE NE 1/4, NE 1/4, NW 1/4, SEC. 35.

SURVEYORS CERTIFICATE

BASIS OF BEARINGS:
N 0° 07' 52" W. EAST LINE OF THE
NW 1/4, SEC. 35, T19S, R60E., MDM,
FILE 7, PAGE 78, RECORDERS
OFFICE, CLARK COUNTY, NEVADA.

I, David F. Causey, a duly Registered Professional Engineer and Land Surveyor in the State of Nevada, No. 1811, as agent for Causey Surveying Associates, do hereby certify that the Survey of land shown hereon was made under my direct supervision at the instance of **ERNEST HAWKINS** ; the survey was completed on 15TH OF OCT., 1971 and that the points found and set are correctly shown hereon. This map does not constitute a subdivision as defined by Nevada State Law.

David F. Causey
David F. Causey
Registered Professional Engineer and
Land Surveyor No. 1811

CSA. 7098-1

RECORD of SURVEY
for
ERNEST HAWKINS

PORTION of the NE 1/4, NE 1/4, NW 1/4,
SEC 35, T 19 S., R 60 E., M. D. M.,
CLARK COUNTY, NEVADA



Causey SURVEYING Associates
Engineers & Planners & Surveyors
913 EAST OGDEN AVENUE • PHONE (702) 382 6421
P.O. BOX 14846 • LAS VEGAS NEVADA 89114

NO 157575
FILED AT REQUEST OF
CAUSEY SURVEYING ASSC
DATE 1-7-72 AT 3.12 P.

FILE 22 PAGE 2
OF SURVEYS, OFFICIAL
RECORDS BOOK NO 197
CLARK COUNTY NEVADA, RECORD

PAUL E HORN, RECORDER
FEE 2.50 DEPUTY 90

055-461

461
FILE 22 PAGE 2