


MONUMENT TIE MAP / RECORD OF SURVEY FOR JAMES R. MARSH

BEING A PORTION OF THE EAST HALF (E 1/2) OF THE NORTHEAST QUARTER (NE 1/4) OF THE NORTHEAST QUARTER (NE 1/4) OF THE SOUTHWEST QUARTER (SW 1/4) OF SECTION 20, TOWNSHIP 19 SOUTH, RANGE 60 EAST, M.D.M., CITY LAS VEGAS, CLARK COUNTY, NEVADA

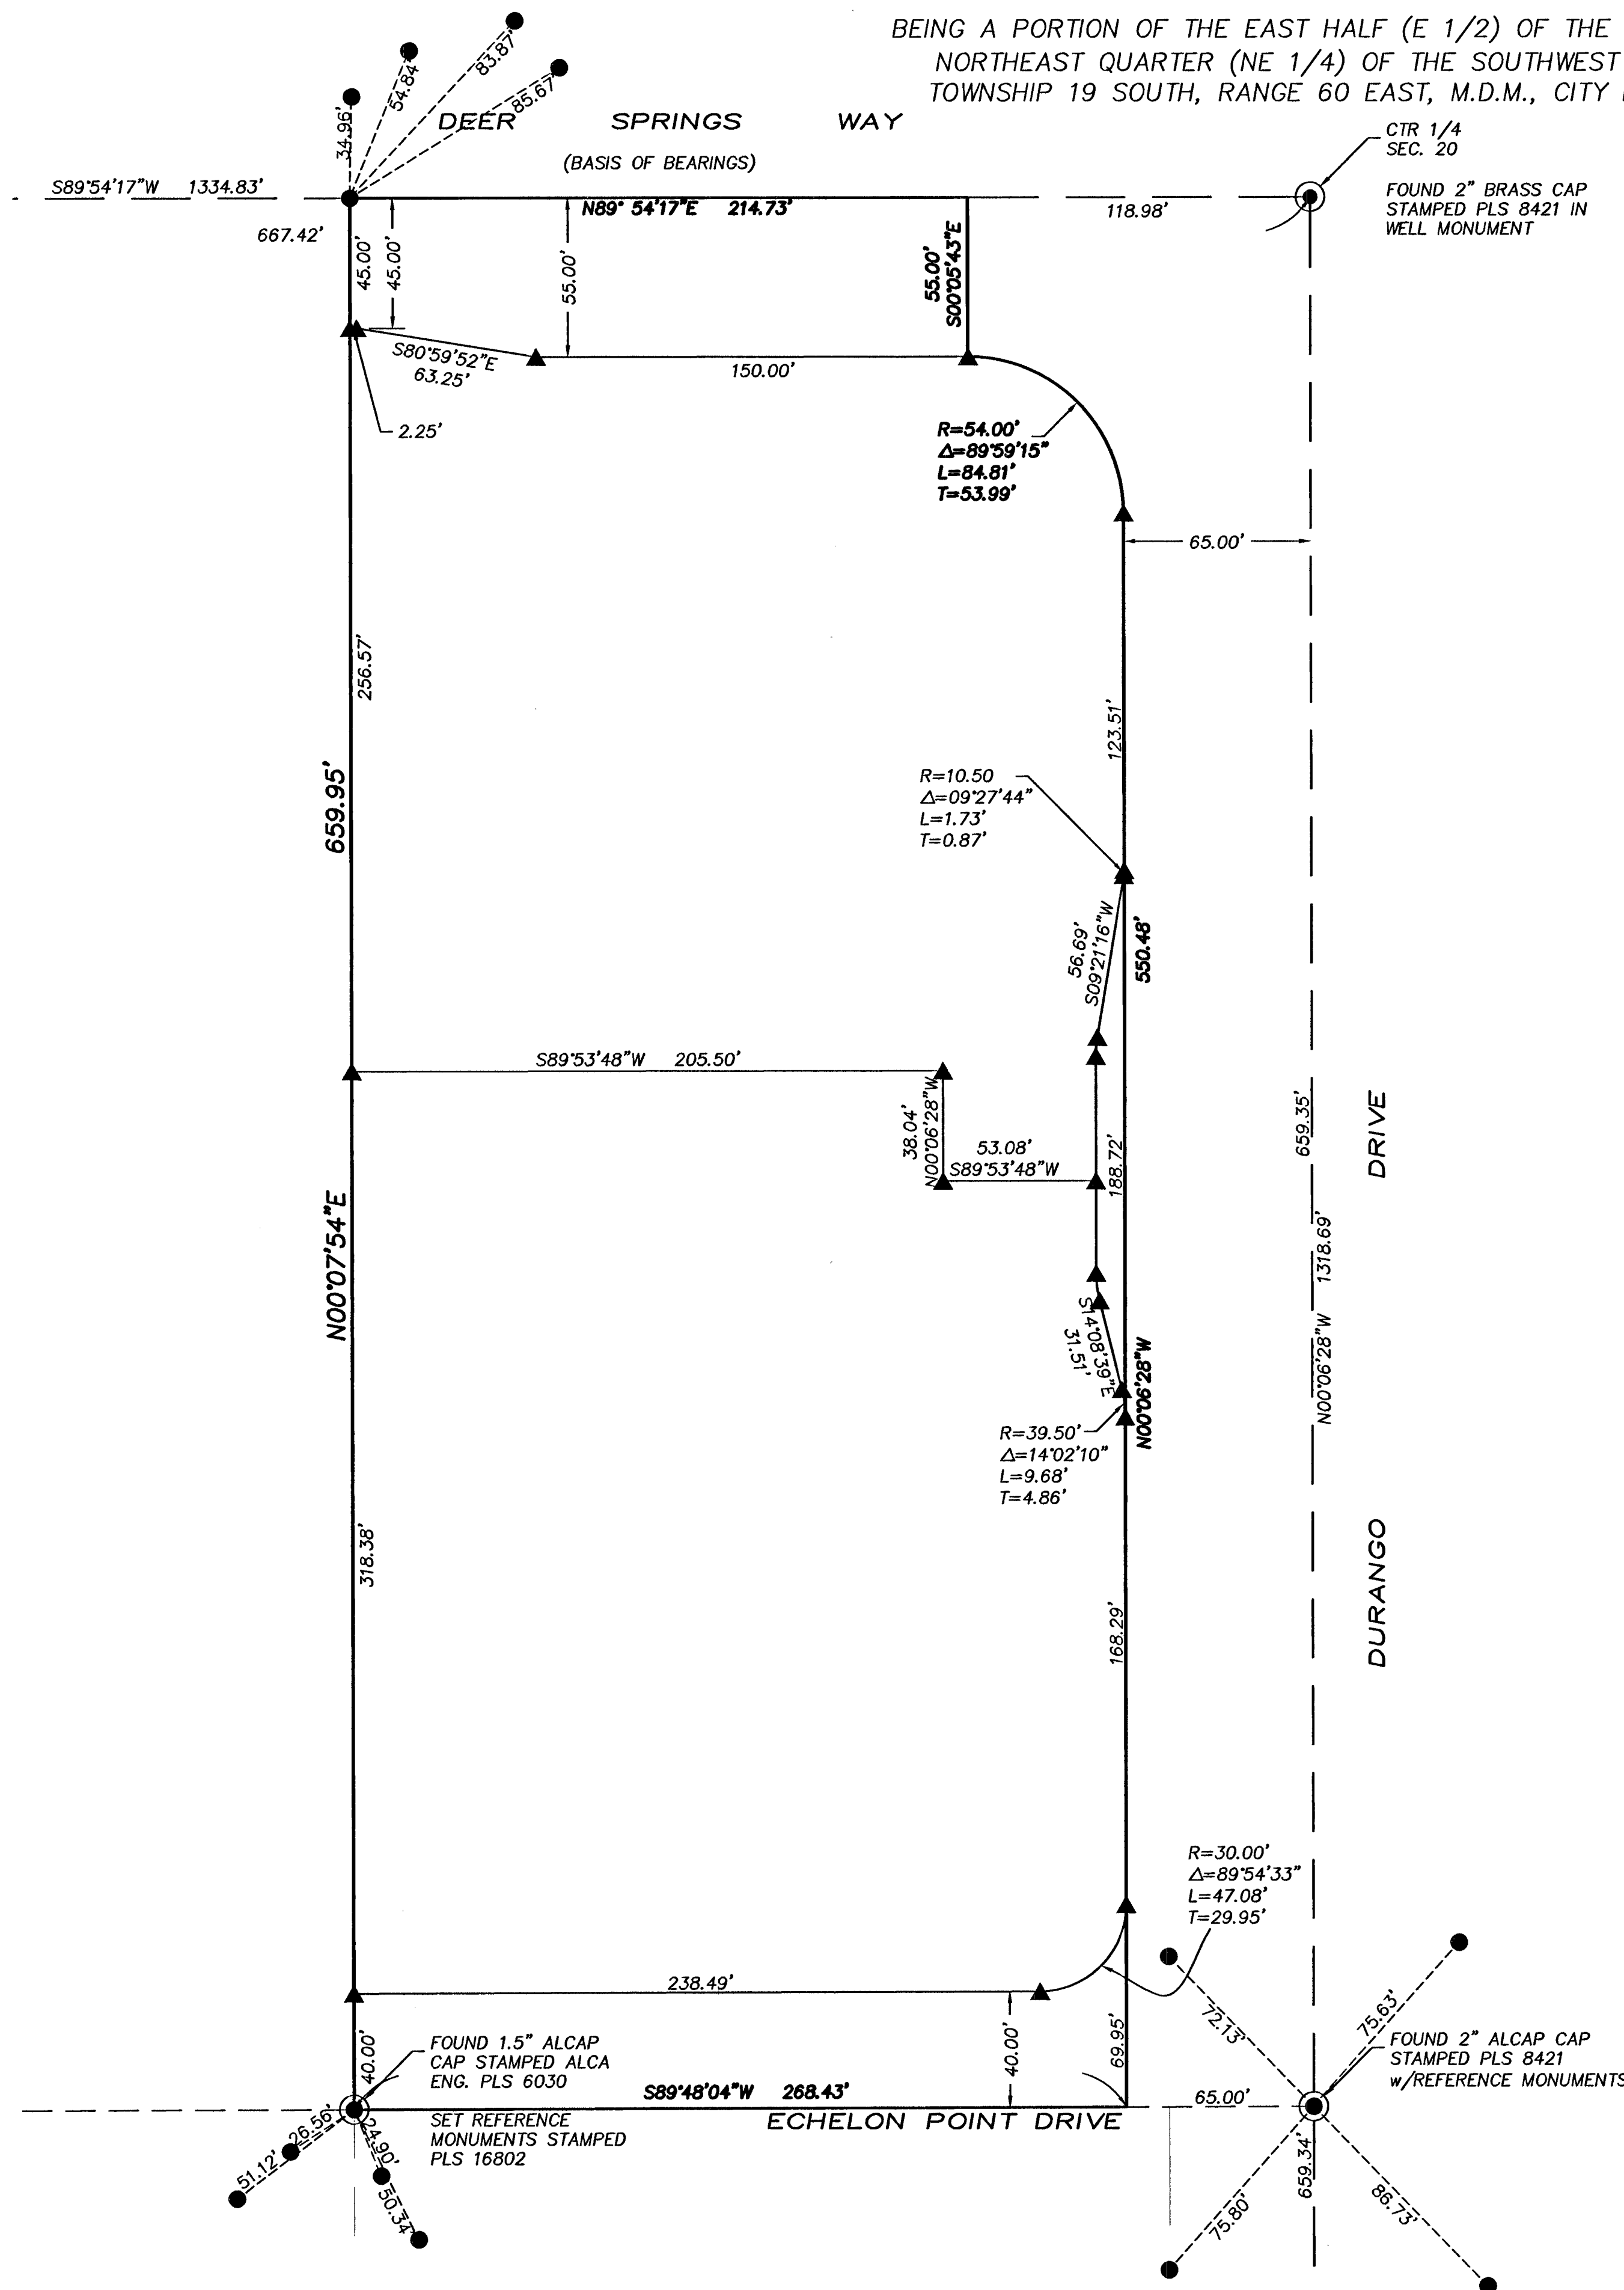


SURVEYOR'S CERTIFICATE:

I, TRENT J. KEENAN, A PROFESSIONAL LAND SURVEYOR, LICENSED IN THE STATE OF NEVADA, CERTIFY THAT:

- 1) THIS PLAT REPRESENTS THE RESULT OF A SURVEY CONDUCTED UNDER MY DIRECT SUPERVISION AT THE INSTANCE OF THE JIM MARSH AND THE CITY OF LAS VEGAS.
- 2) THE LANDS SURVEYED LIE WITHIN THE A PORTION OF THE EAST HALF (E 1/2) OF THE NORTHEAST QUARTER (NE 1/4) OF THE NORTHEAST QUARTER (NE 1/4) OF THE SOUTHWEST QUARTER (SW 1/4) OF SECTION 20, TOWNSHIP 19 SOUTH, RANGE 60 EAST, M.D.M., CITY LAS VEGAS, CLARK COUNTY, NEVADA AND THAT THE SURVEY WAS COMPLETED ON APRIL 4, 2014.
- 3) THIS SURVEY COMPLIES WITH THE APPLICABLE STATE STATUTES AND LOCAL ORDINANCES IN EFFECT ON THE DATE THAT THE SURVEY WAS COMPLETED AND WAS PERFORMED IN ACCORDANCE WITH THE NEVADA ADMINISTRATIVE CODE, STANDARDS OF PRACTICE FOR PROFESSIONAL LAND SURVEYORS.
- 4) THE MONUMENTS DEPICTED ON THE PLAT ARE OF THE CHARACTER SHOWN AND OCCUPY THE POSITIONS INDICATED.

TRENT J. KEENAN, PLS
PROFESSIONAL LAND SURVEYOR
NEVADA LICENSE NO. 16802

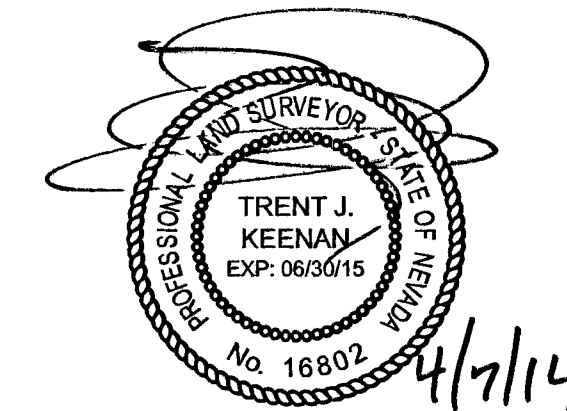


BASIS OF BEARINGS

SOUTH 89°54'17" WEST, BEING THE BEARING OF THE NORTH LINE OF THE NORTHEAST QUARTER (NE 1/4) OF THE SOUTHWEST QUARTER (SW 1/4) OF SECTION 20, TOWNSHIP 19 SOUTH, RANGE 60 EAST, M.D.M., CITY OF LAS VEGAS, CLARK COUNTY, NEVADA AS SHOWN BY FINAL MAP OF "THE VILLAGE AT CENTENNIAL HILLS, A ONE LOT COMMERCIAL SUBDIVISION" THEREOF ON FILE RECORDED AUGUST 5, 2009 IN BOOK 20090805 OF OFFICIAL RECORDS AS INSTRUMENT NO. 0003129, BOOK 142 OF PLATS, PAGE 9 IN THE CLARK COUNTY RECORDER'S OFFICE, CLARK COUNTY, NEVADA.

LEGEND

- SUBJECT PROPERTY
- SECTION LINE
- QUARTER SECTION LINE
- ONE SIXTEENTH OR LESS SECTION LINE
- RIGHT-OF-WAY LINE (TO BE DEDICATED)
- RIGHT-OF-WAY LINE (EXISTING)
- FOUND MONUMENT AS NOTED
- ▲ MONUMENTS TO BE SET AFTER CONSTRUCTION
- SET 5/8" REBAR AND 1.5" ALUMINUM CAP STAMPED PLS 16802 WITH REFERENCE MONUMENTS SET IN ADJACENT TOP OF CURB
- PLS PROFESSIONAL LAND SURVEYOR

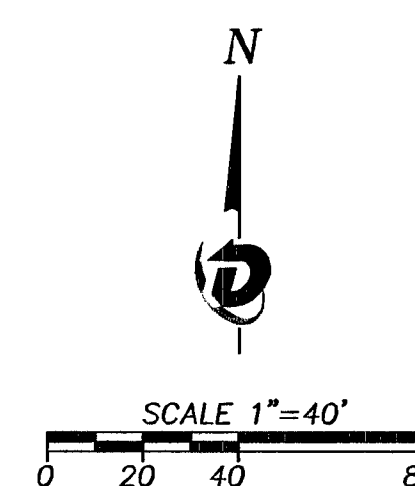

Diamondback Land Surveying		No. _____	
5506 S. FORT APACHE RD., SUITE 110 LAS VEGAS, NEVADA 89148 (o) 702.823.DBLS (f) 702.933.9030 www.diamondbacklandsurveying.com		FILED AT THE REQUEST OF: DIAMONDBACK LAND SURVEYING, LLC	
DRAWN BY: TJK 04/07/2013		DATE: _____ AT: _____	
CHECKED BY: TJK 04/07/2013		FILE _____ PAGE _____	
JOB NUMBER: 130563		OF SURVEYS	
SCALE: 1" = 40'		OFFICIAL RECORDS BOOK No.	
PAGE 1 OF 1		CLARK COUNTY, NEVADA RECORDS	
		DEBBIE CONWAY, RECORDER	
		FEE: _____ DEPUTY _____	