

# EXPRESSIONS


## MONUMENT TIE MAP

A SUBDIVISION OF PARCEL 2 ON FILE IN FILE 61, PAGE 86 OF PARCEL MAPS  
IN THE CLARK COUNTY RECORDER'S OFFICE, CLARK COUNTY, NEVADA

LYING WITHIN THE NW1/4 OF SECTION 22, T. 20 S., R. 60 E., M.D.M.,  
CITY OF LAS VEGAS, CLARK COUNTY, NEVADA

SECTION 16 | 15  
CORNER 27 | 22  
NAIL & TIN  
FOUND

1/4 15  
FOUND  
BRASS CAP

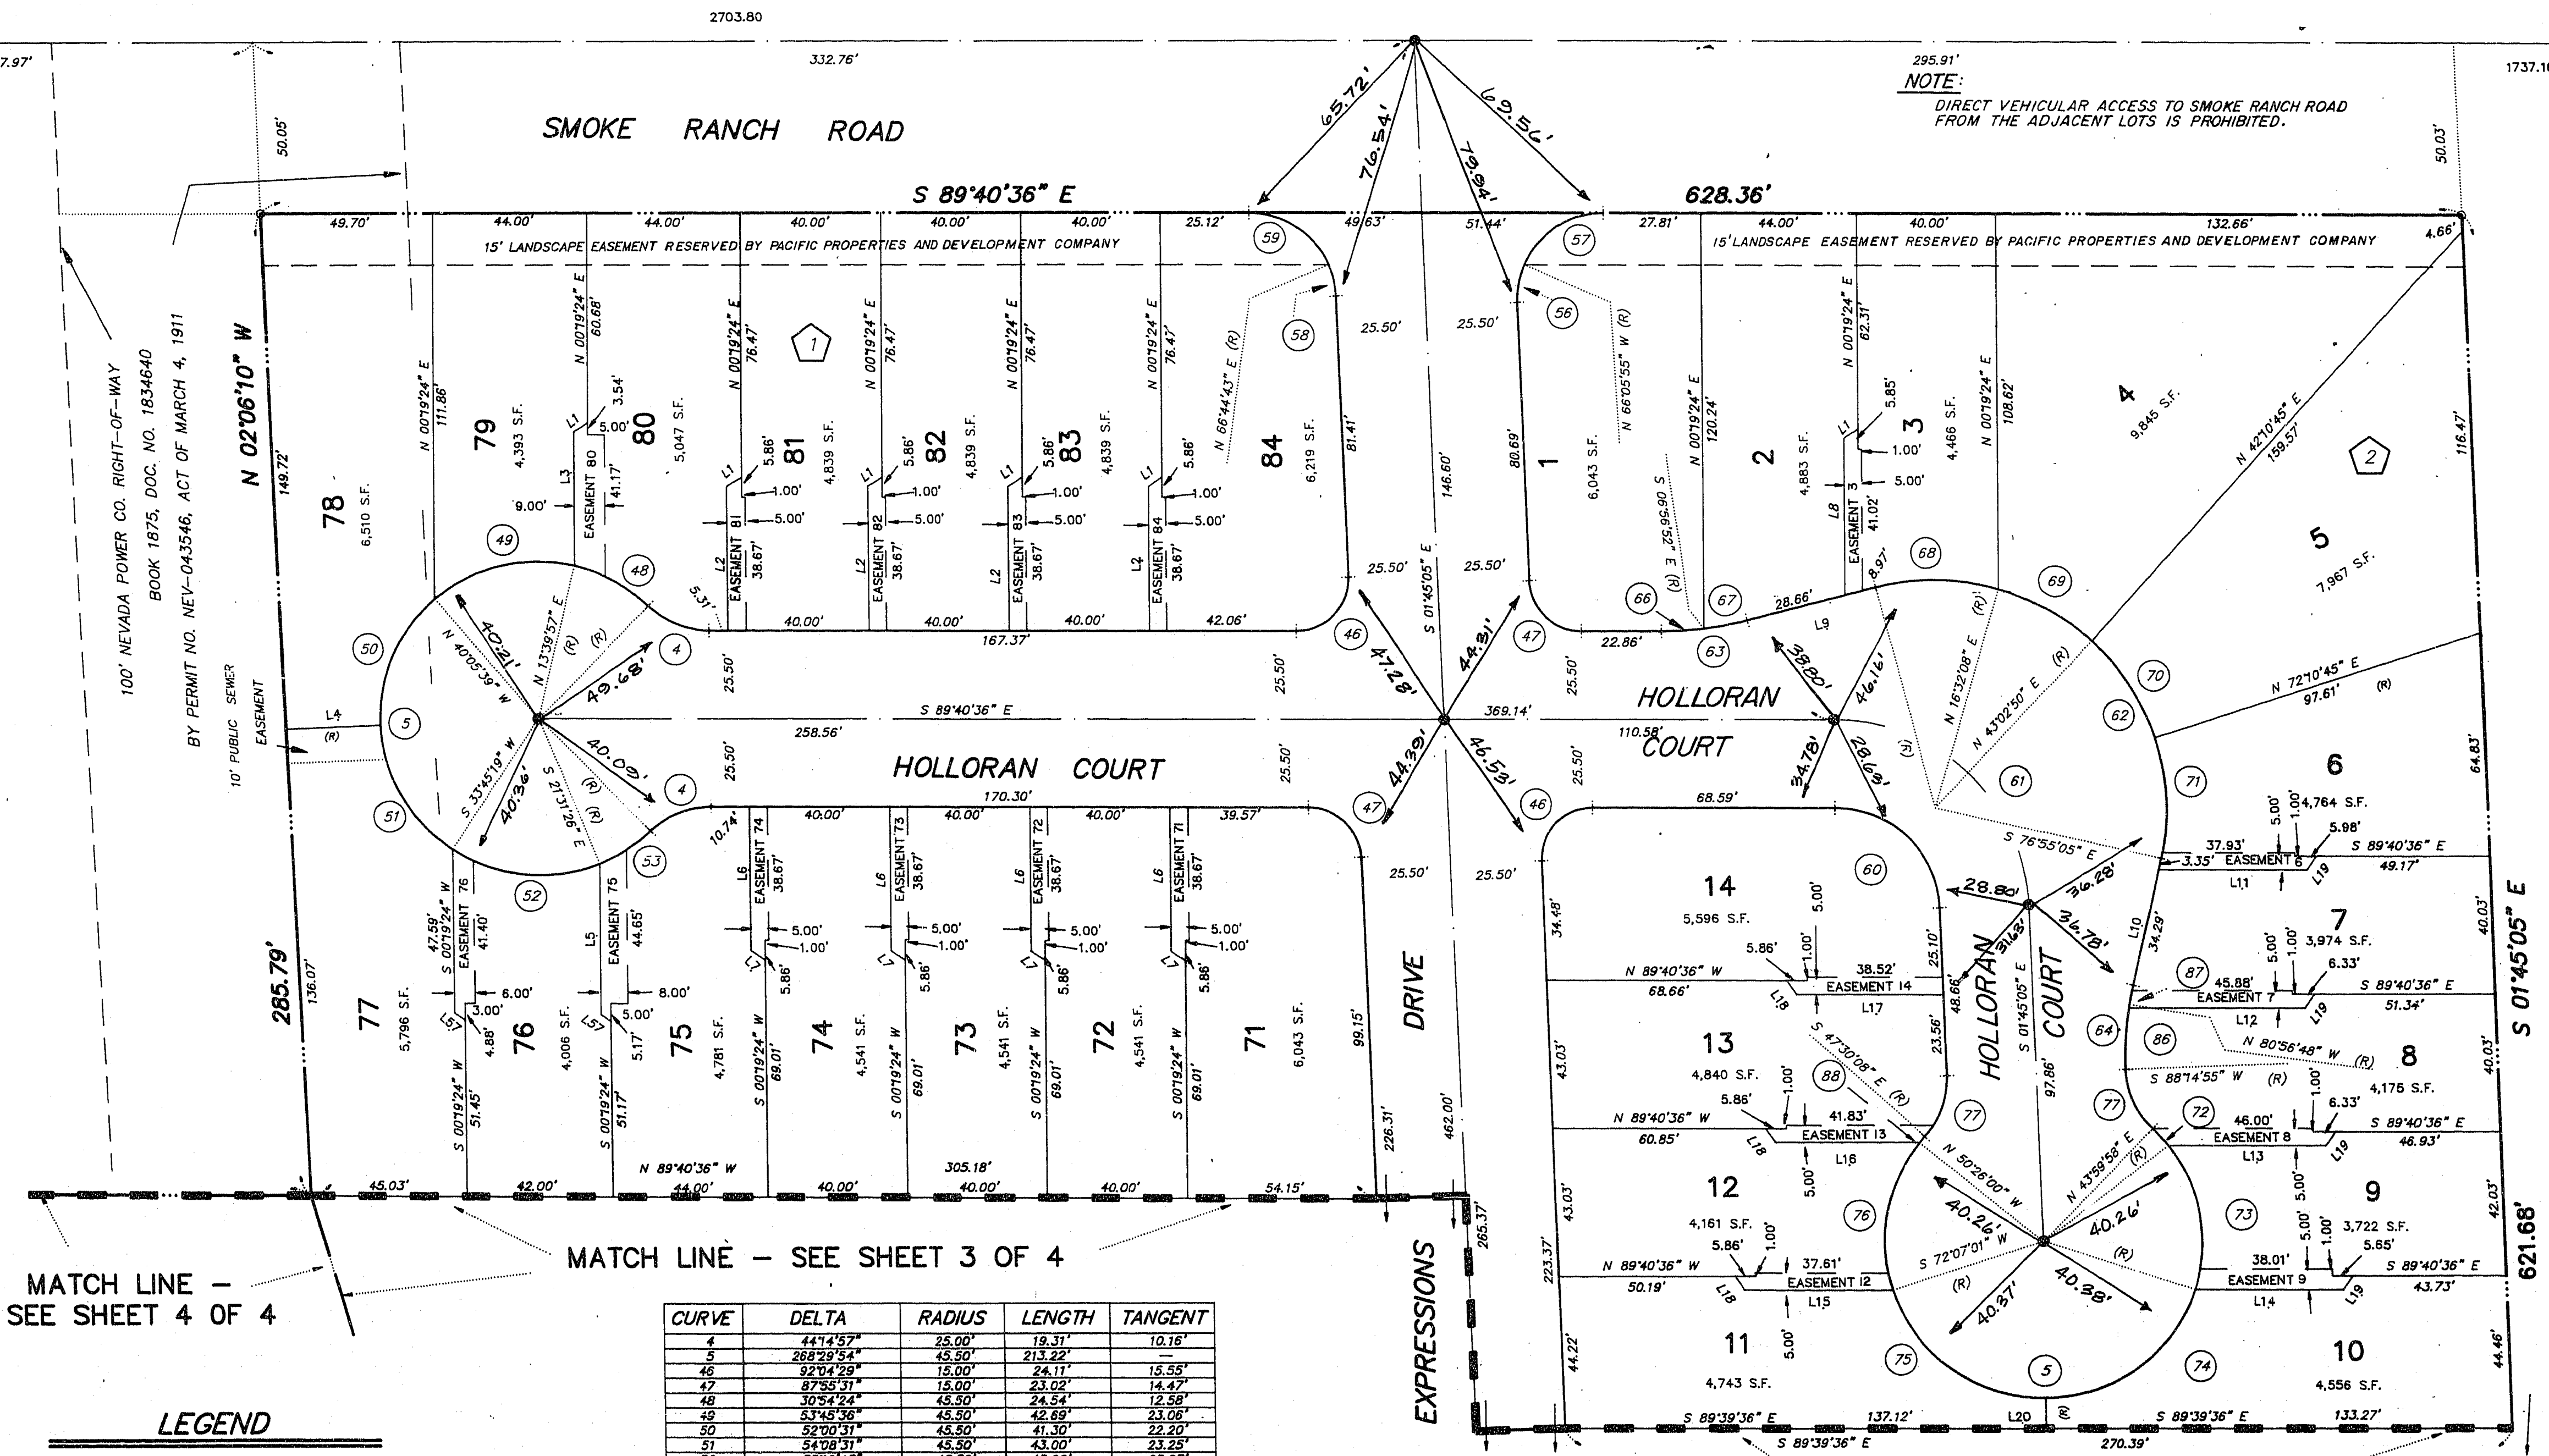

MATCH LINE - SEE SHEET 4 OF 4

MATCH LINE - SEE SHEET 3 OF 4

MATCH LINE - SEE SHEET 3 OF 4


- LEGEND**
- SET 5/8" REBAR AND ALLUM. CAP STAMPED R.L.S. 2050 W/ BRASS CAP TIES IN TOP OF CURB (UNLESS OTHERWISE NOTED)
  - ⊙ FOUND MONUMENTATION AS SHOWN AND DESCRIBED
  - POINT NOT FOUND OR SET
  - 15 LOT NUMBER  
TOTAL LOTS IN SUBDIVISION = 84
  - A BLOCK NUMBER
  - 59 CURVE NUMBER
  - L1 LINE SEGMENT NUMBER
  - SUBDIVISION BOUNDARY LINE
- NOTE:**  
FRONT SETBACK: 10' MINIMUM TO BUILDING  
16' MINIMUM TO GARAGE  
SIDE SETBACK ON CORNER 10' MINIMUM
- (TYP) EASEMENT 75 = PRIVATE EASEMENT

CURVE	DELTA	RADIUS	LENGTH	TANGENT

**SURVEYOR'S CERTIFICATE**

I, KAY L. ADAMS, A PROFESSIONAL LAND SURVEYOR, REGISTERED IN THE STATE OF NEVADA, DO HEREBY CERTIFY THAT THE MONUMENTS HAVE BEEN SET AND TIES ESTABLISHED AS SHOWN HEREON.

*Kay L. Adams*  
KAY L. ADAMS  
PROFESSIONAL LAND SURVEYOR  
NEVADA CERTIFICATE NO. 2050

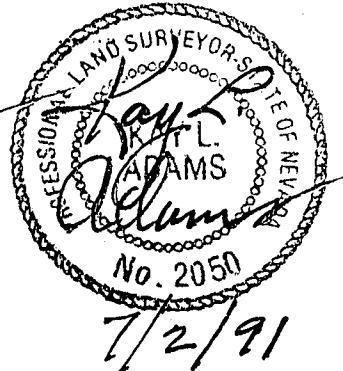

LINE	DIRECTION	DISTANCE
L1	N 56°19'24" E	4.82'
L2	N 00°19'24" E	41.83'
L3	N 00°19'24" E	38.82'
L4	S 87°33'50" W	27.43'
L5	S 00°19'24" W	43.63'
L6	S 00°19'24" W	43.63'
L7	S 55°40'36" E	4.82'
L8	N 00°19'24" E	45.49'
L9	N 75°29'31" E	37.63'
L10	N 13°04'55" E	37.63'
L11	S 89°40'36" E	42.32'
L12	S 89°40'36" E	42.32'
L13	S 89°40'36" E	42.32'
L14	S 89°40'36" E	42.32'
L15	N 89°40'36" W	42.32'
L16	N 89°40'36" W	42.32'
L17	N 89°40'36" W	42.32'
L18	N 33°40'36" W	4.82'
L19	N 34°20'24" E	4.82'
L20	S 00°19'24" E	8.65'
L21	S 55°40'36" E	3.62'