


Book 900514

00605

# DAVE BROWN WEST UNIT 1

MONUMENT TIE MAP

PORTION OF THE SOUTH HALF (S 1/2) OF THE SOUTHEAST QUARTER (SE 1/4) OF SECTION 4, T. 20 S., R. 60 E. M.D.M.  
CITY OF LAS VEGAS, CLARK COUNTY, NEVADA

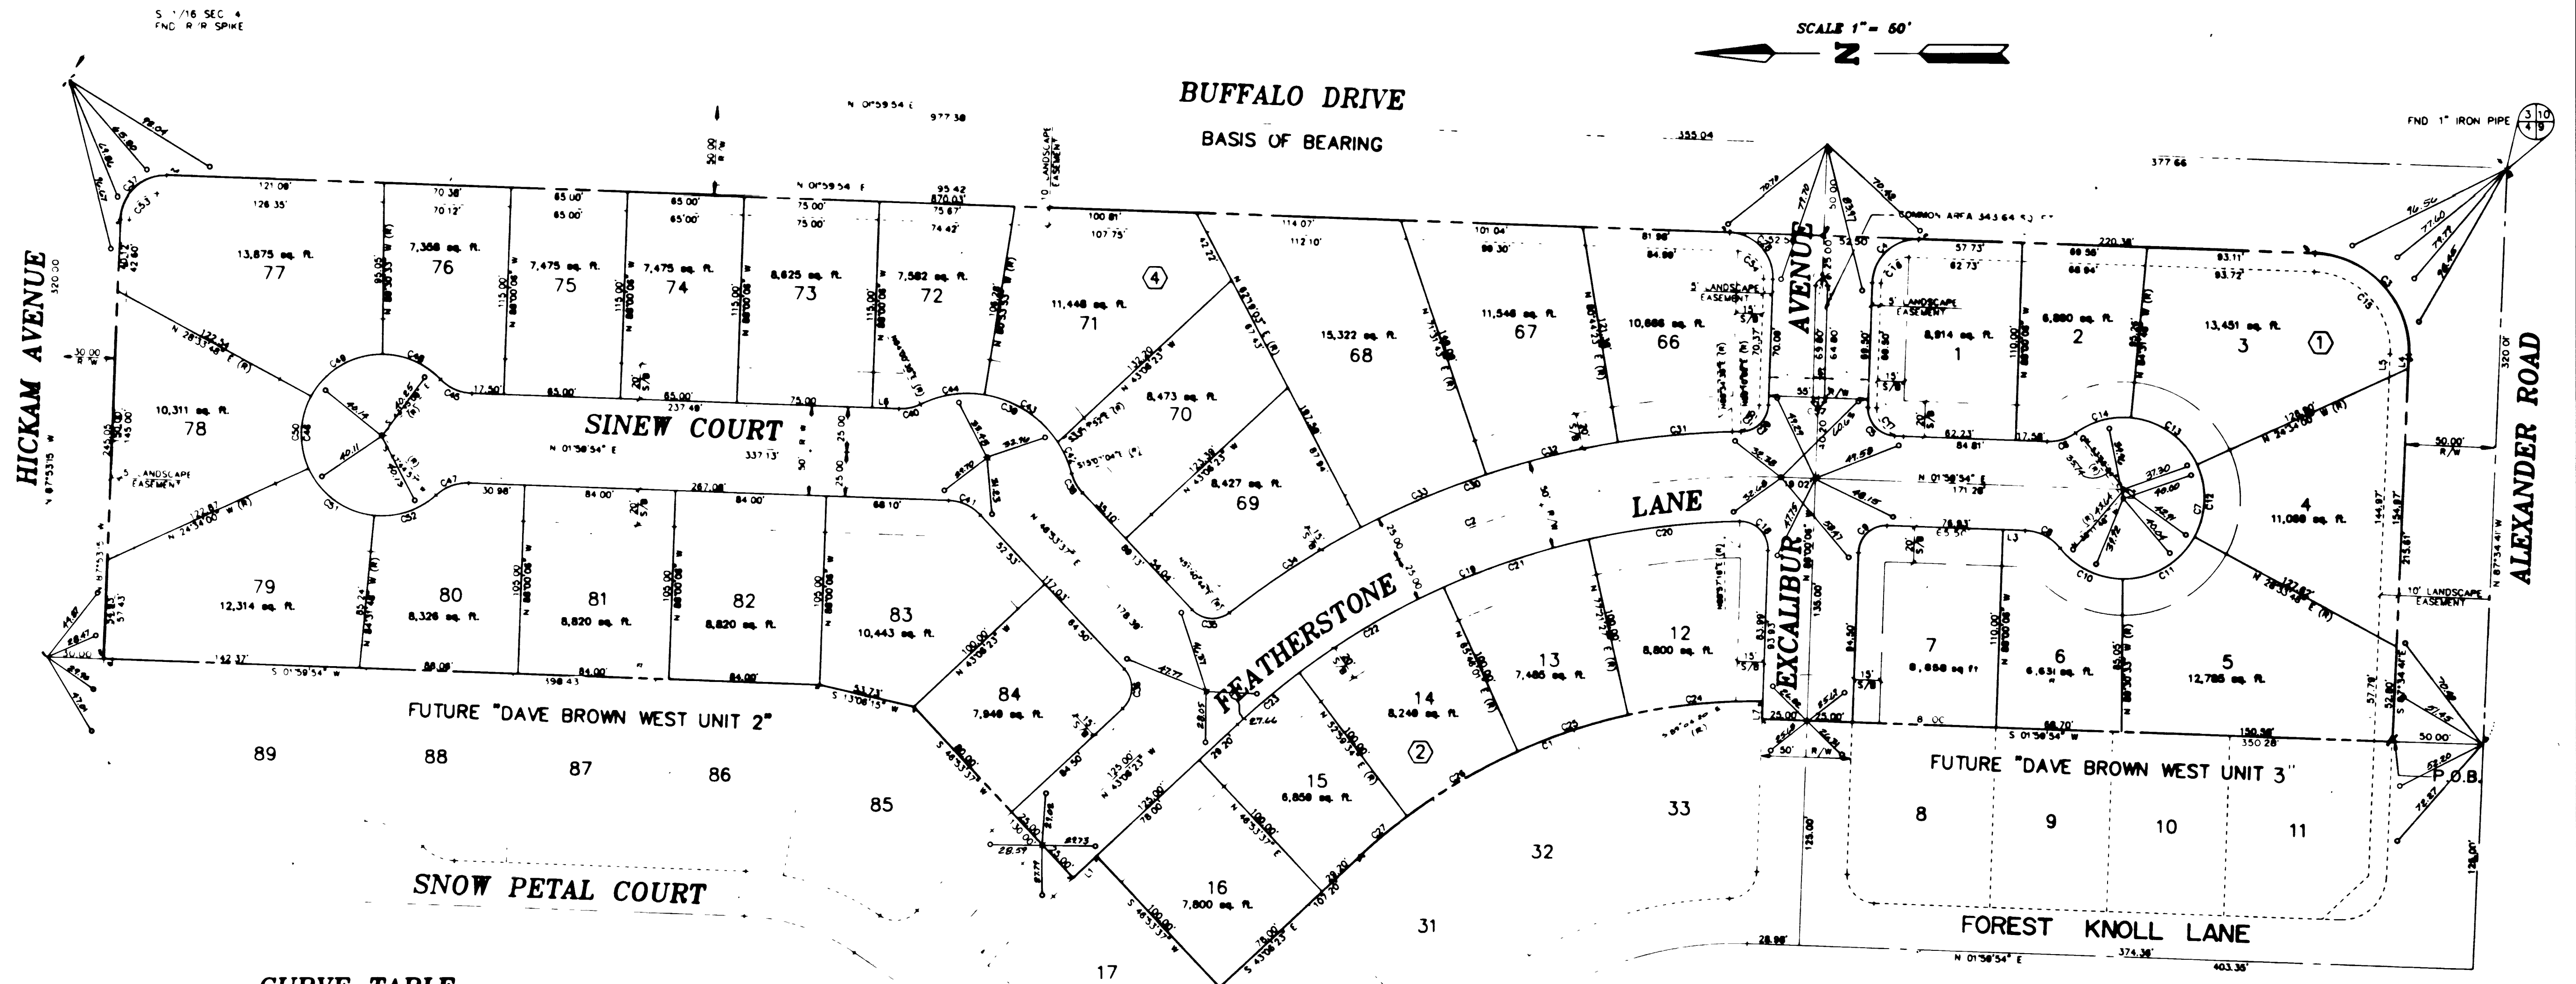

CURVE TABLE

CURVE	RADIUS	LENGTH	TANGENT	DELTA
LINE TABLE


LINE	DIRECTION	DISTANCE
L1	S 43°58'33" E	17.80
L2	N 88°00'00" E	5.00
L3	N 01°58'54" E	11.43
L4	N 87°34'41" E	7.63
L5	N 87°34'41" W	12.82
L6	N 01°58'54" E	14.88
L7	N 88°00'00" E	9.94

NOTE: DIRECT VEHICULAR ACCESS TO BUFFALO DRIVE & ALEXANDER ROAD FROM ABUTTING LOTS IS PROHIBITED.

## LEGEND

- SET 1-3/8" BRASS CAP STAMPED RM (DISTANCE NOTED)
- ▲ FOUND MONUMENT AS INDICATED
- FND 5/8" REBAR W/ALUM. CAP RLS 6305
- SET 5/8" REBAR W/ALUM. CAP RLS 6305
- C5 CURVE DATA
- LS LINE DATA
- 27 LOT NUMBER
- ① BLOCK NUMBER
- LANDSCAPE EASEMENT LINE
- SETBACK LINE (20' FRONT, 15' SIDE)
- PROPERTY LINE
- BOUNDARY LINE
- TOTAL NUMBER OF LOTS - 31

I, DENE E. KRAMEBAUER, A PROFESSIONAL LAND SURVEYOR IN THE STATE OF NEVADA, DO HEREBY CERTIFY THAT THE MONUMENTS HAVE BEEN SET AND THE TIES ESTABLISHED AS SHOWN HEREON.

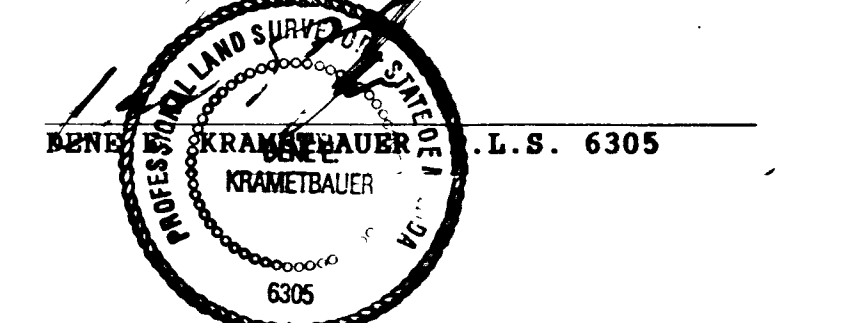

11/5/64

2951

9-6-60 Book 46 PAGE 5

