


Book 900514

20606

DAVE BROWN WEST UNIT 2

PORTION OF THE SOUTH HALF (S 1/2) OF THE SOUTHEAST QUARTER (SE 1/4) OF SECTION 4, T. 20 S., R. 60 E. M.D.M.
CITY OF LAS VEGAS, CLARK COUNTY, NEVADA

MONUMENT TIE MAP

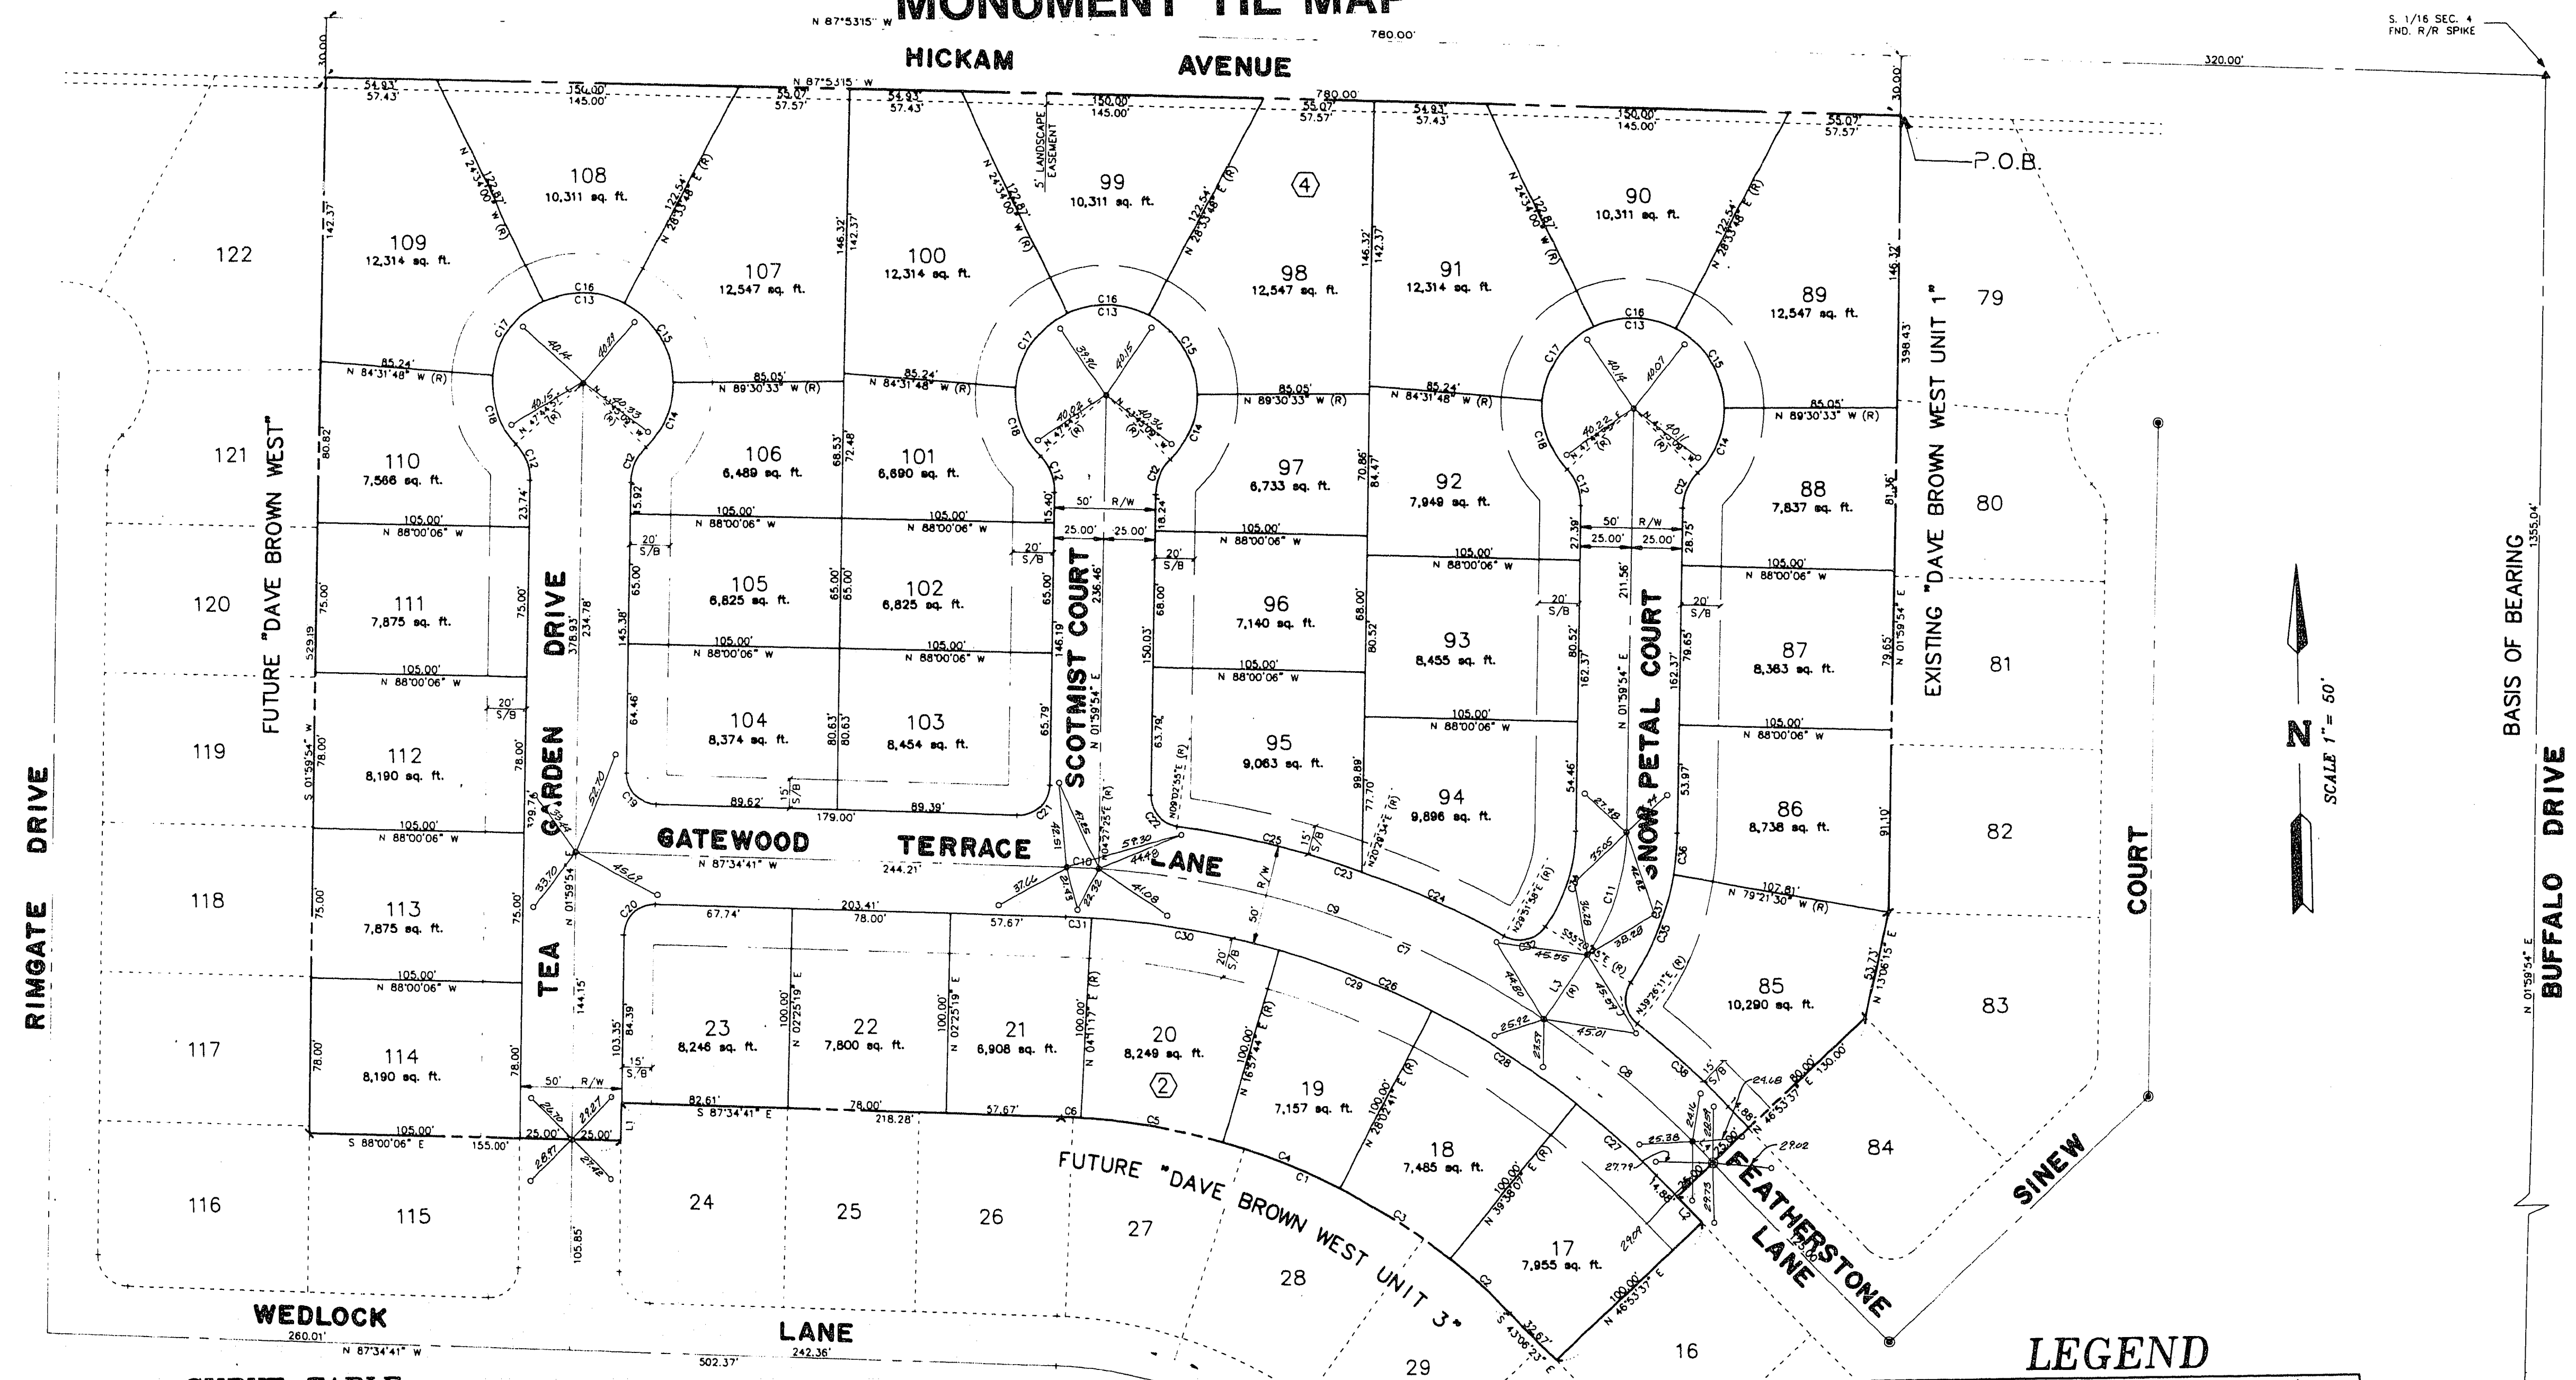


CURVE TABLE

CURVE	RADIUS	LENGTH	TANGENT	DELTA
C1	320.00	248.38	130.87	44.971°
C2	320.00	60.34	30.30	07.133°
C3	320.00	64.73	32.48	11.352°
C4	320.00	61.90	31.28	11.347°
C5	320.00	71.34	35.82	12.482°
C6	320.00	9.88	4.93	01.453°
C7	445.00	345.40	181.83	44.781°
C8	445.00	95.08	47.72	12.433°
C9	445.00	234.51	120.28	30.110°
C10	445.00	15.81	7.80	02.023°
C11	114.21	65.09	33.48	32.391°
C12	25.50	19.88	10.37	44.127°
C13	45.00	210.88	108.88	268.295°
C14	45.00	35.84	18.07	14.574°
C15	45.00	48.84	27.00	21.353°
C16	45.00	41.73	22.50	15.074°
C17	45.00	47.10	25.50	18.353°
C18	45.00	37.48	19.80	12.433°
C19	15.50	24.23	12.12	04.574°
C20	15.50	24.46	12.23	04.625°
C21	15.50	24.46	12.23	04.625°
C22	15.50	22.44	11.22	04.127°
C23	470.00	170.77	86.34	20.490°
C24	470.00	78.89	38.53	09.225°
C25	470.00	24.85	12.43	04.127°
C26	420.00	325.99	171.71	44.781°
C27	420.00	84.84	42.83	11.352°
C28	420.00	81.24	40.75	11.352°
C29	420.00	83.44	42.01	12.482°
C30	420.00	12.50	6.25	01.453°
C31	420.00	12.50	6.25	01.453°
C32	11.50	23.05	11.53	04.574°
C33	11.50	23.05	11.53	04.574°
C34	88.21	50.84	26.13	12.433°
C35	138.21	28.00	14.00	04.574°
C36	138.21	21.00	10.50	03.391°
C37	470.00	21.17	10.59	02.023°
C38	470.00	21.17	10.59	02.023°

LINE TABLE

LINE	DIRECTION	DISTANCE
L1	N 01°39'54" E	18.37
L2	N 43°08'23" W	17.80
L3	N 34°39'05" E	38.81
L4	N 43°08'23" W	14.98

I, DENE E. KRAMETBAUER, A PROFESSIONAL LAND SURVEYOR IN THE STATE OF NEVADA, DO HEREBY CERTIFY THAT THE MONUMENTS HAVE BEEN CORRECTLY TIED ESTABLISHED AS SHOWN HEREON.

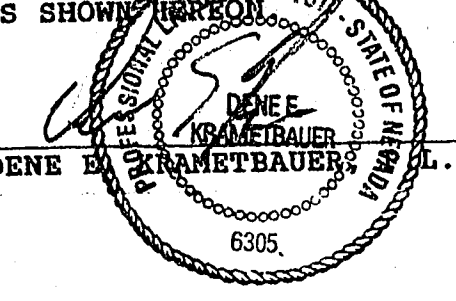

12/9/11

LEGEND

- SET 1/2" BRASS CAP STAKED RM. IN PL. (DARK NUTS)
- ▲ FOUND MONUMENT AS INDICATED
- FND. 5/8" REBAR W/ALUM. CAP RLS 6305
- SET 5/8" REBAR W/ALUM. CAP R.L.S. 6305
- CS CURVE DATA
- LS LINE DATA
- 27 LOT NUMBER
- ① BLOCK NUMBER
- LANDSCAPE EASEMENT LINE
- SETBACK LINE (20' FRONT, 15' SIDE)
- PROPERTY LINE
- BOUNDARY LINE
- TOTAL NUMBER OF LOTS-37



9-6-59 Book 46 PAGE 6 058-4077-2