DAVE BROWN WEST
UNIT 6
MONUMENTATION TIE MAP

N
SCALE: 1" = 60'

SURVEYOR'S CERTIFICATE

I, J EDWARD LEAVITT, A PROFESSIONAL LAND SURVEYOR IN THE STATE OF NEVADA, DO HEREBY CERTIFY THAT THE MONUMENTS HAVE BEEN SET AND THE TIE DISTANCES WERE ESTABLISHED AS SHOWN HEREON.
THIS SURVEY WAS COMPLETED ON SEPT 18, 1995

PROFESSIONAL LAND SURVEYOR - STATE OF NEVADA
J. EDWARD LEAVITT
5878

10-18-95

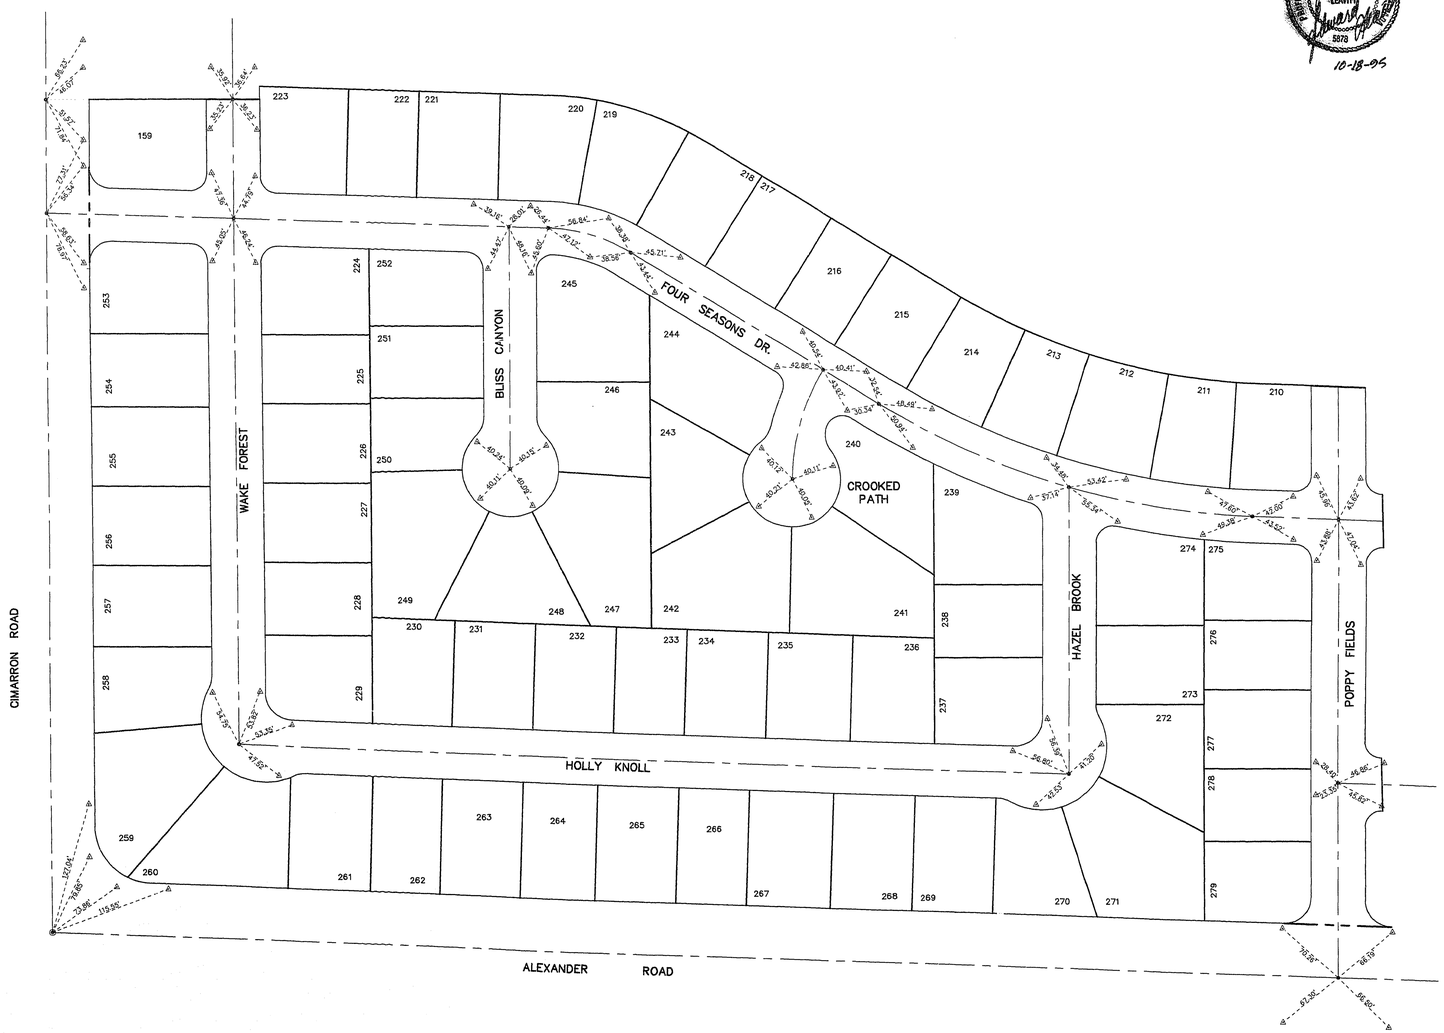

LEGEND

- SET TYPE I MONUMENT P.L.S. 5878
- SET 5/8" REBAR W/ALUM. CAP P.L.S. 5878
- SET 1 3/8" DIA. BRASS CAP TIE MONUMENT IN TOP OF CURB
- 27 LOT NUMBER
- PROPERTY LINE
- UNIT LINE

REVISION	DATE	BY	APPROVED

SUBMITTED BY:

ALPHA & ENGINEERING COMPANY
50 So. Jones #204, Las Vegas, NV. 89107
Telephone: (702) 877-1300

TITLE: MONUMENTATION TIE MAP

PROJECT: DAVE BROWN WEST - UNIT 6

JOB #	N2-76-02
NAME	SMD
DATE	9 / 18 / 95
SCALE	1" = 60'

PAGE 1 OF 1

9-6-55

058-4077-6