
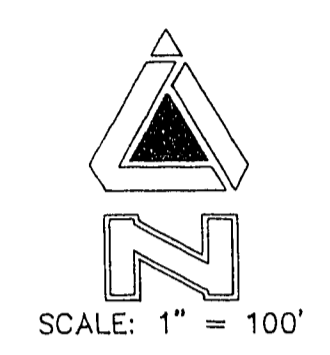


**MONUMENTATION MAP FOR
DEL WEBB, SUN CITY
UNIT 24**

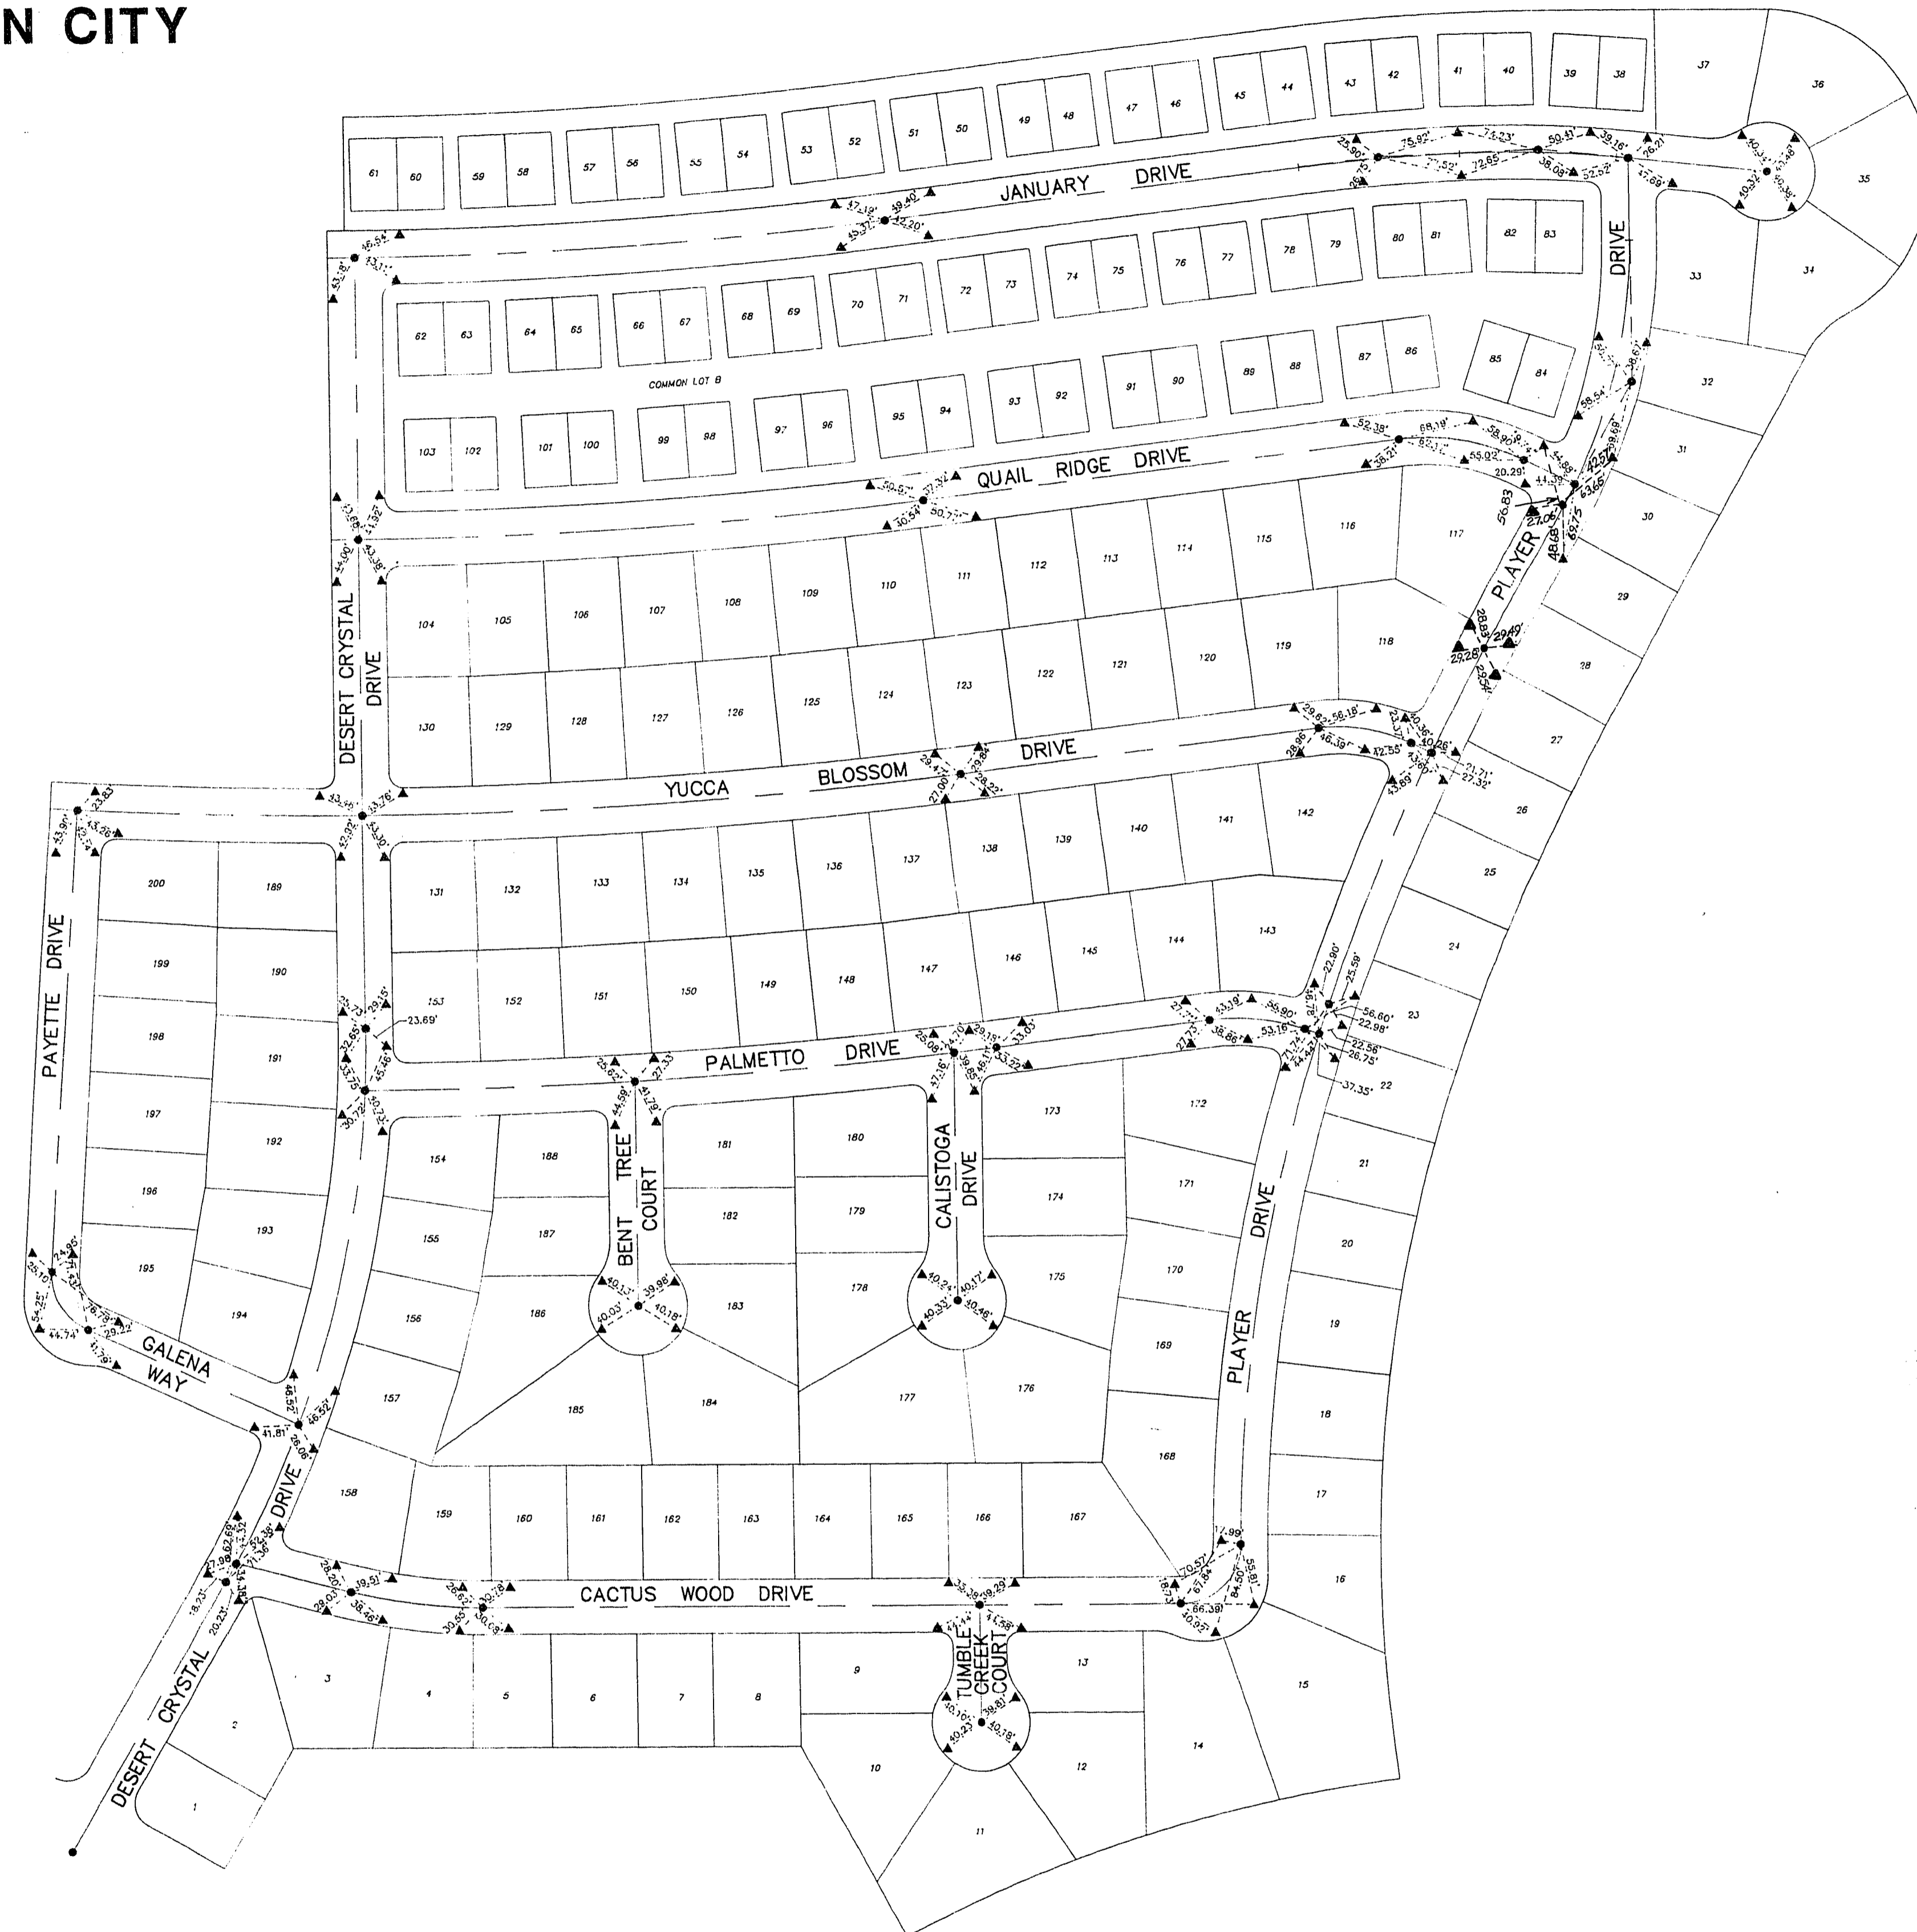

- LEGEND**
- CENTERLINE ROADWAY
 - TANGENT LINES
 - 5/8" REBAR WITH AL. CAP P.L.S. 6030
 - 2" AL. CAP STAMPED P.L.S. 6030 WITH TIE DISTANCES

I, JERRY SLIGAR, A PROFESSIONAL LAND SURVEYOR IN THE STATE OF NEVADA, DO HEREBY CERTIFY THAT THE MONUMENTS HAVE BEEN SET AND THE TIE DISTANCES ESTABLISHED AS SHOWN HEREON.

JERRY SLIGAR
PROFESSIONAL LAND SURVEYOR
NEVADA CERTIFICATE NO. 6030



REV. NO.	DESCRIPTION	BY	DATE

SCALE (H)	SCALE (V)
1" = 100'	
DES.	T. S. R. E.
DR.	
SECTION	

ALCA
ENGINEERING & SURVEYING, INC.
820 S. VALLEY VIEW BOULEVARD
LAS VEGAS, NEVADA 89107-4411
(702) 878-3358 FAX: 878-1092

JOB TITLE
**UNIT 24
DEL WEBB, SUN CITY
CENTERLINE TIE SHEET**

.DWG NAME	UNIT24CL
.DWG DATE	8/20/91
JOB NO.	91020101
SHEET	1 OF 1

CENTERLINE TIE SHEET

10-6-147

058-4141-24