

960531

01350




# DIAMOND POINTE UNIT 2

BEING A PORTION OF PARCEL 1 OF PARCEL MAP; FILE 82, PAGE 74  
A PORTION OF THE SOUTHWEST QUARTER (SW 1/4) OF THE SOUTHWEST QUARTER (SW 1/4) OF  
OF SECTION 21, TOWNSHIP 20 SOUTH, RANGE 61 EAST, M.D.M., CITY OF LAS VEGAS, CLARK COUNTY, NEVADA.  
MONUMENTATION TIE MAP

I, STEPHEN P. GURLIDES, A PROFESSIONAL LAND SURVEYOR IN THE STATE OF NEVADA, DO HEREBY CERTIFY THAT THE MONUMENTS HAVE BEEN SET AND THE TIE DISTANCE ESTABLISHED AS SHOWN HEREON. THIS SURVEY WAS COMPLETED ON 3-25-98


STEPHEN P. GURLIDES  
NEVADA CERTIFICATION NO. 5105

DIAMOND POINTE - UNIT 1 BOOK 68 OF PLATS, PAGE 64

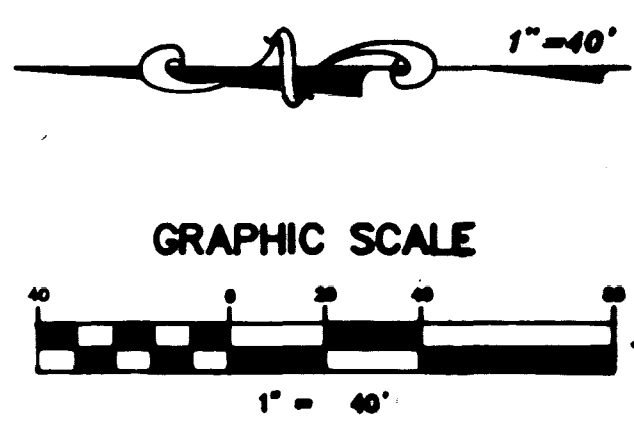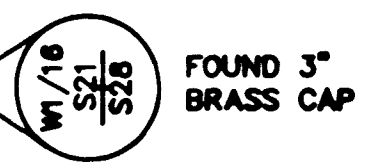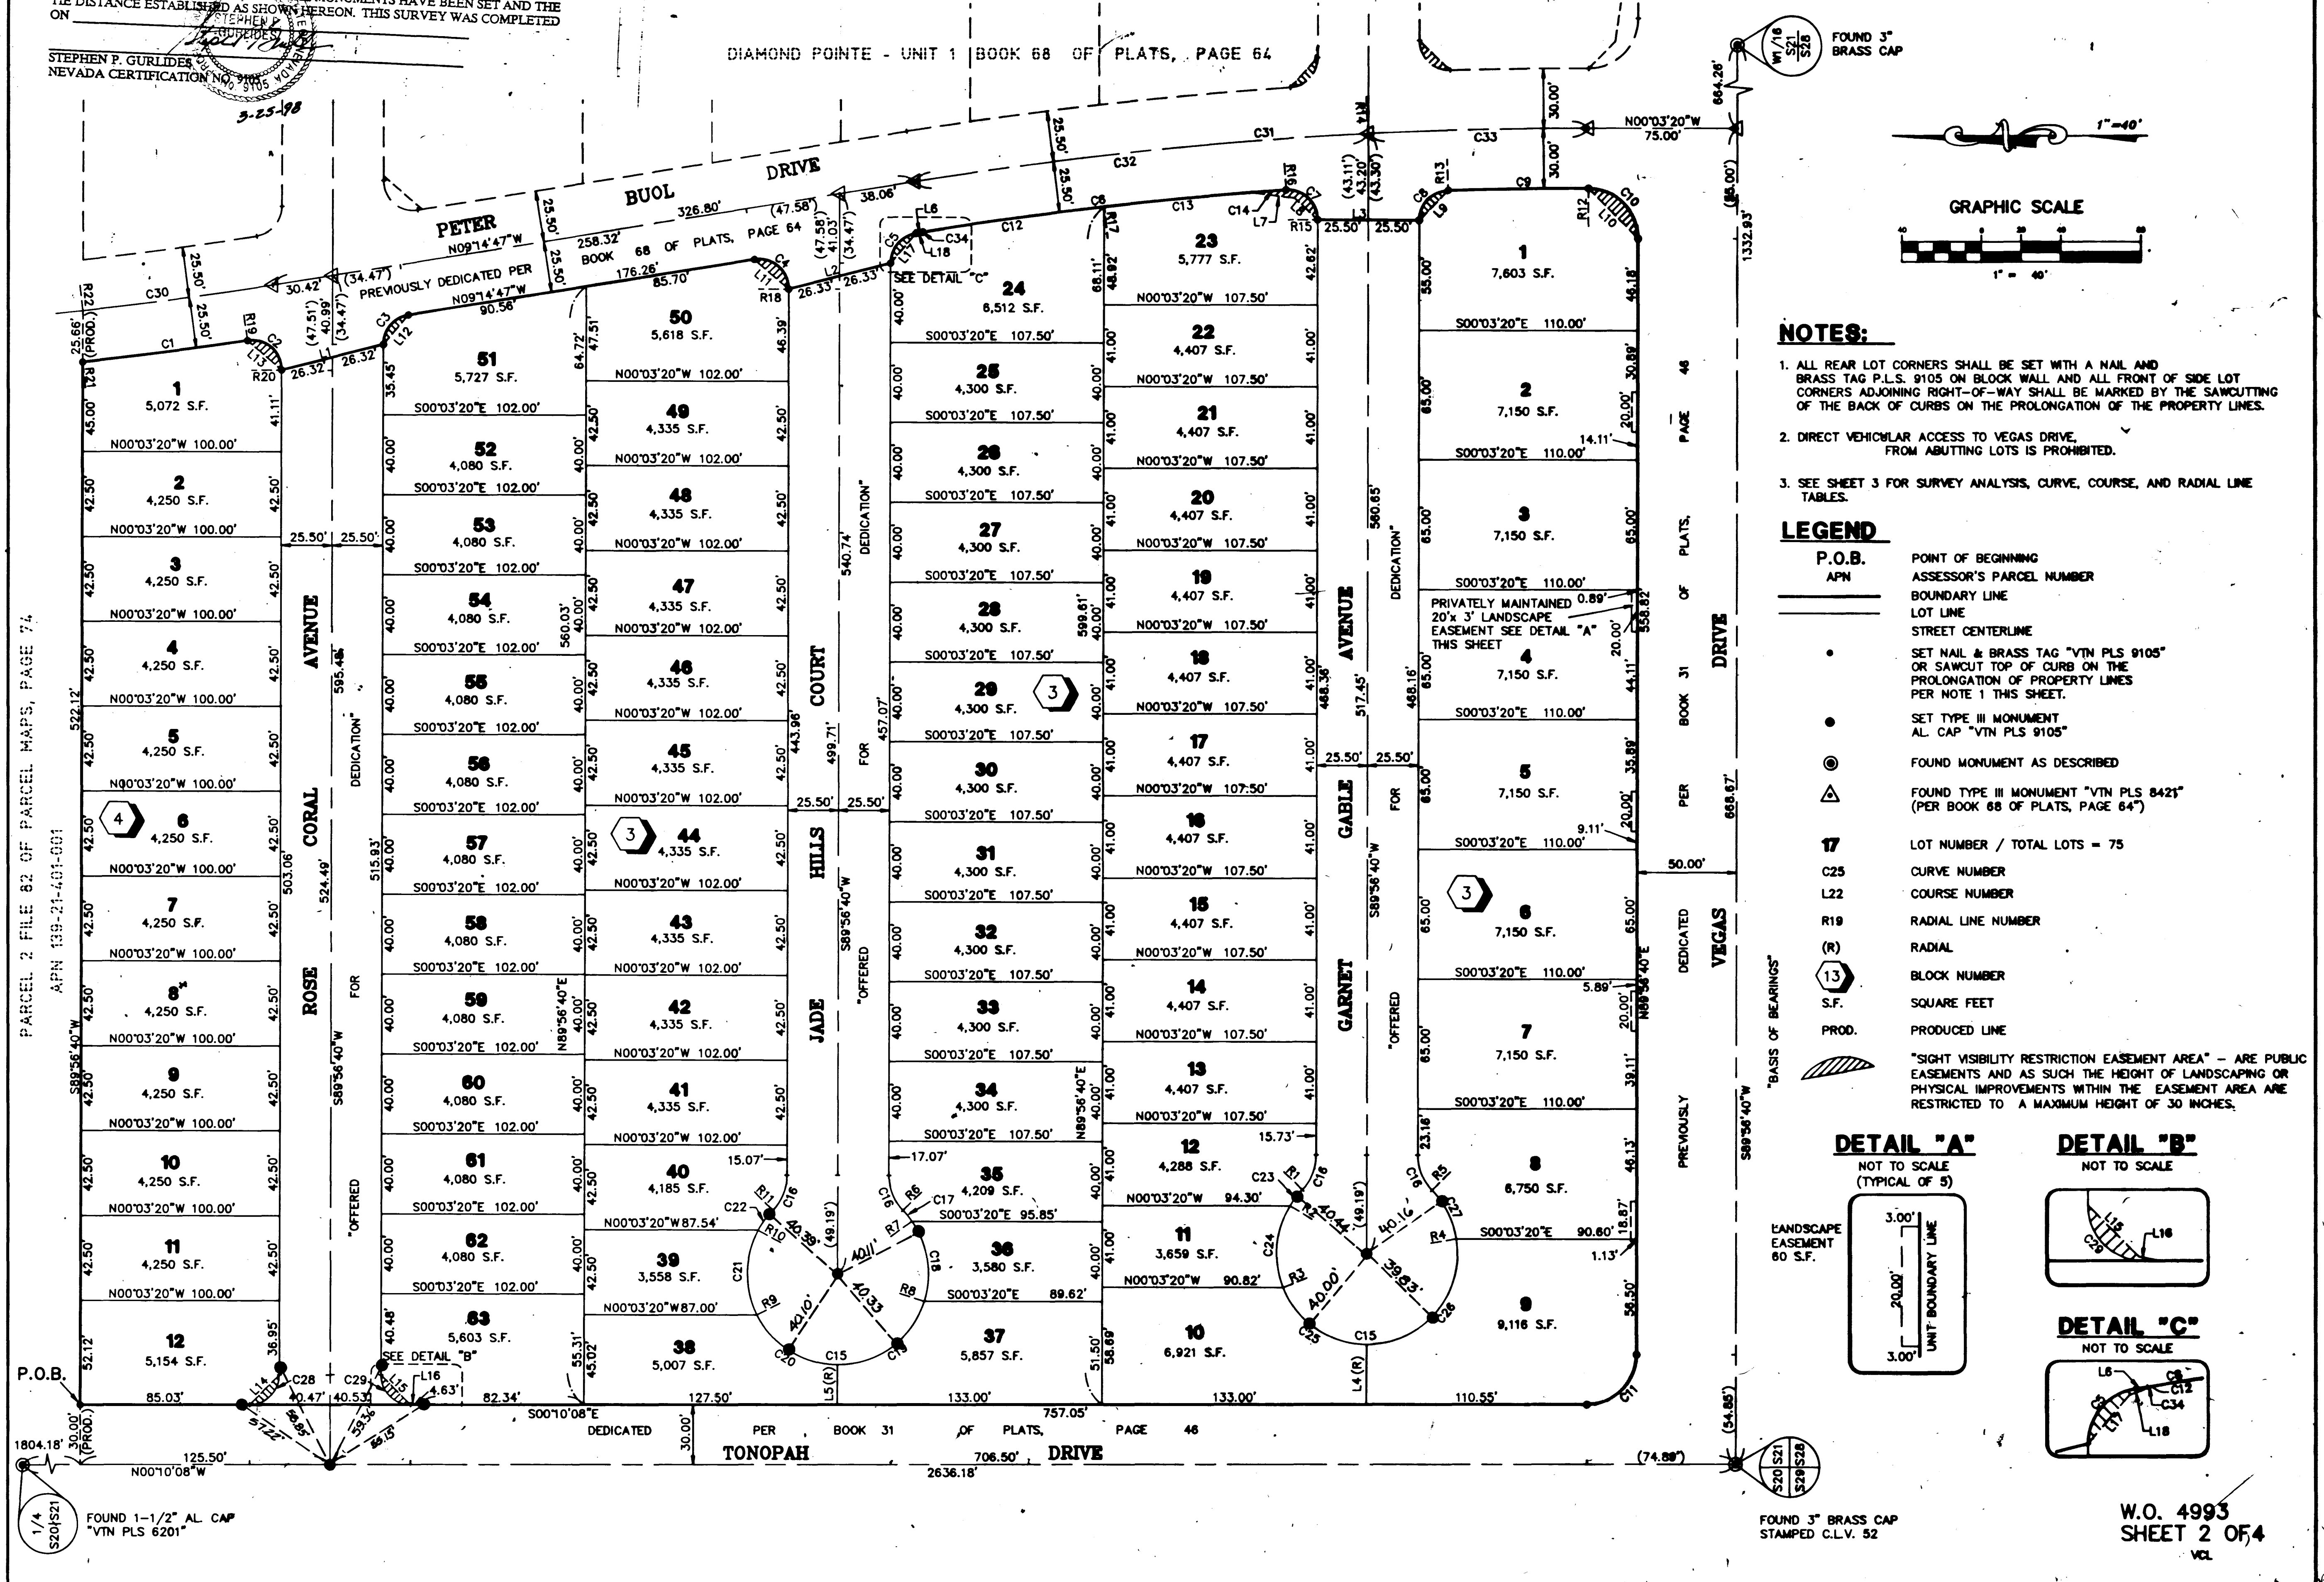

- NOTES:**
- ALL REAR LOT CORNERS SHALL BE SET WITH A NAIL AND BRASS TAG P.L.S. 9105 ON BLOCK WALL AND ALL FRONT OF SIDE LOT CORNERS ADJOINING RIGHT-OF-WAY SHALL BE MARKED BY THE SAWCUTTING OF THE BACK OF CURBS ON THE PROLONGATION OF THE PROPERTY LINES.
  - DIRECT VEHICULAR ACCESS TO VEGAS DRIVE FROM ADJUTING LOTS IS PROHIBITED.
  - SEE SHEET 3 FOR SURVEY ANALYSIS, CURVE, COURSE, AND RADIAL LINE TABLES.

- LEGEND**
- |        |  |
|--------|--|
| P.O.B. | POINT OF BEGINNING   |
| APN    | ASSESSOR'S PARCEL NUMBER   |
| —      | BOUNDARY LINE  |
| —      | LOT LINE   |
| —      | STREET CENTERLINE  |
| •      | SET NAIL & BRASS TAG "VTN PLS 9105" OR SAWCUT TOP OF CURB ON THE PROLONGATION OF PROPERTY LINES PER NOTE 1 THIS SHEET.   |
| •      | SET TYPE III MONUMENT AL CAP "VTN PLS 9105"  |
| ⊙      | FOUND MONUMENT AS DESCRIBED  |
| ⊙      | FOUND TYPE III MONUMENT "VTN PLS 8421" (PER BOOK 68 OF PLATS, PAGE 64)   |
| 17     | LOT NUMBER / TOTAL LOTS = 75   |
| C25    | CURVE NUMBER   |
| L22    | COURSE NUMBER  |
| R19    | RADIAL LINE NUMBER   |
| (R)    | RADIAL   |
| 13     | BLOCK NUMBER   |
| S.F.   | SQUARE FEET  |
| PROD.  | PRODUCED LINE  |
| ▨      | "SIGHT VISIBILITY RESTRICTION EASEMENT AREA" - ARE PUBLIC EASEMENTS AND AS SUCH THE HEIGHT OF LANDSCAPING OR PHYSICAL IMPROVEMENTS WITHIN THE EASEMENT AREA ARE RESTRICTED TO A MAXIMUM HEIGHT OF 30 INCHES. |

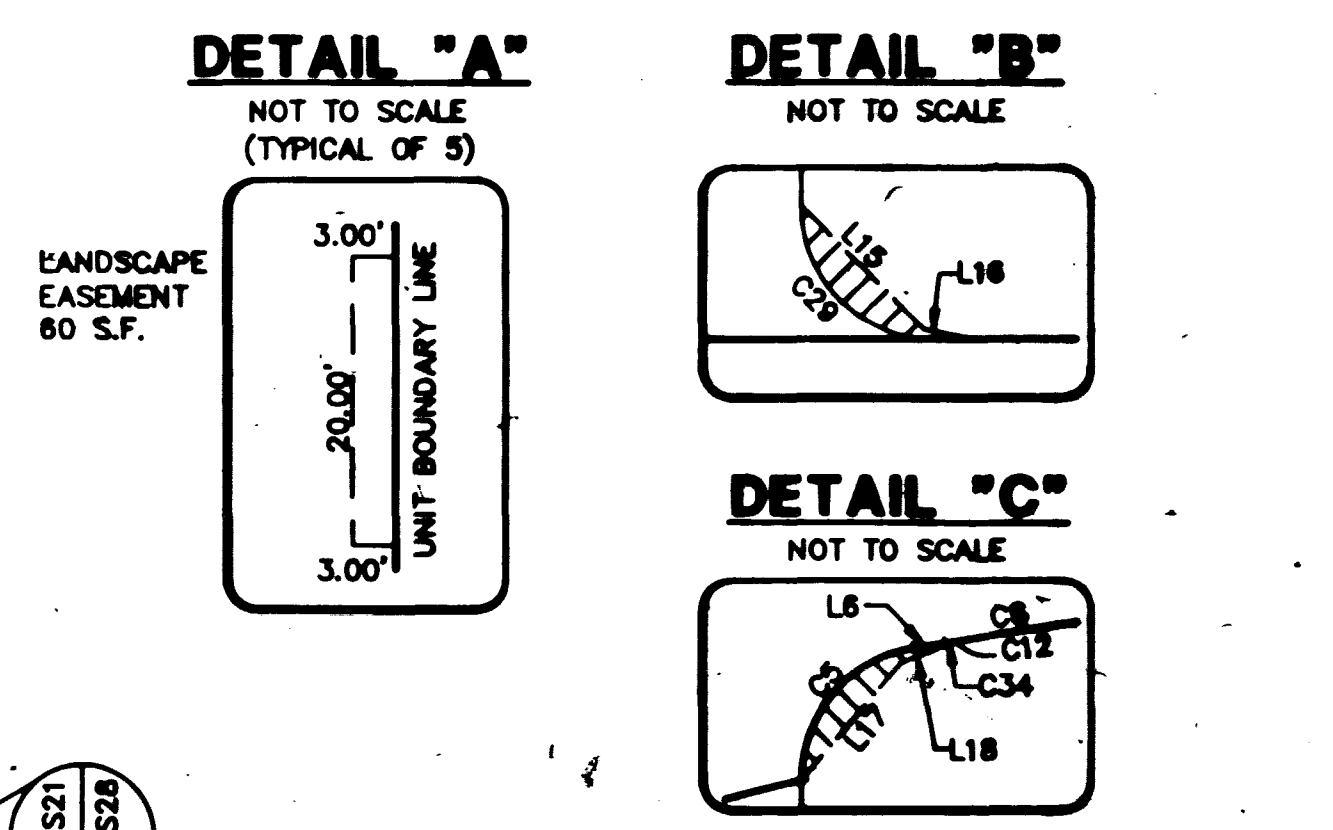

PARCEL 2 FILE 82 OF PARCEL MAPS, PAGE 74  
APN 139-21-401-001

PAGE 48 OF PLATS PER BOOK 31 OF PLATS DEDICATED VEGAS DRIVE PREVIOUSLY DEDICATED

FOUND 1-1/2" AL CAP "VTN PLS 6201"

FOUND 3" BRASS CAP STAMPED C.L.V. 52

W.O. 4993 SHEET 2 OF 4

Book 74 Page 16 058-4378-2

5236


960631

01390




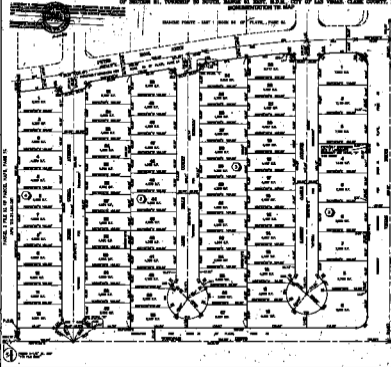





**NOTES:**  

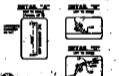

1/4


