
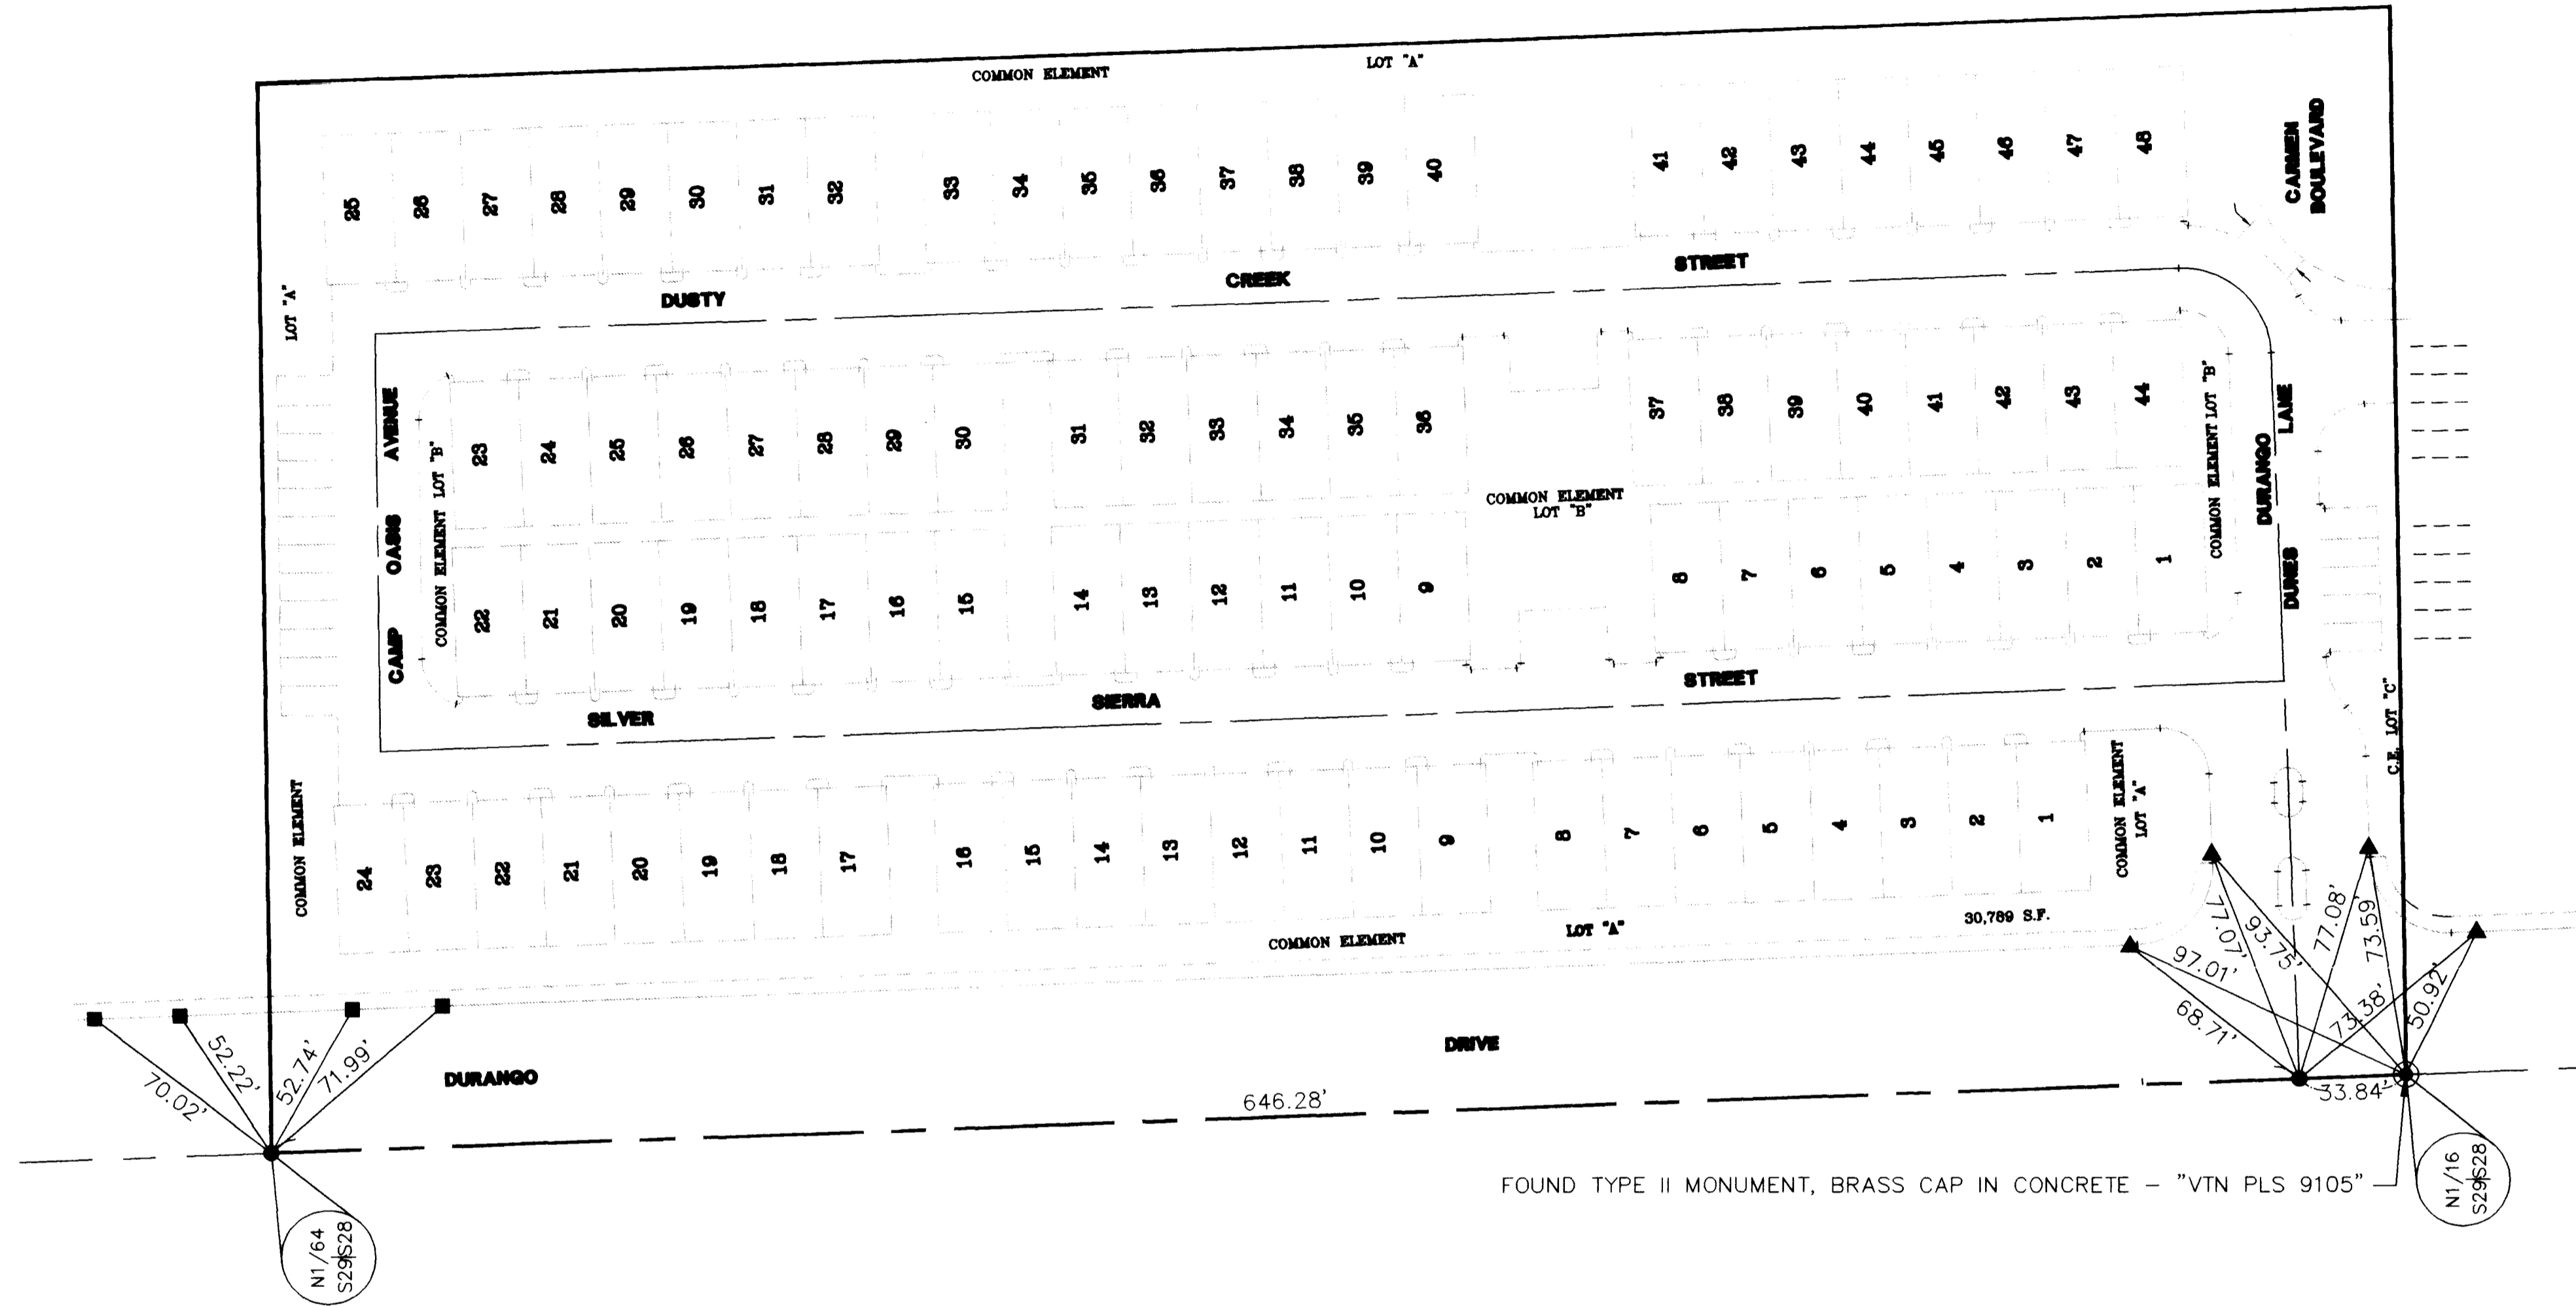


# MONUMENTATION TIE MAP

## DURANGO TRIALS TOWNHOMES - UNIT 3 (BOOK 80, PAGE 78)

THE WEST HALF (W 1/2) OF THE SOUTHWEST QUARTER (SW 1/4) OF THE NORTHWEST QUARTER (NW 1/4) OF THE NORTHWEST QUARTER (NW 1/4) OF SECTION 28, TOWNSHIP 20 SOUTH, RANGE 60 EAST, M.D.M., CITY OF LAS VEGAS, CLARK COUNTY, NEVADA  
(A COMMON INTEREST COMMUNITY)

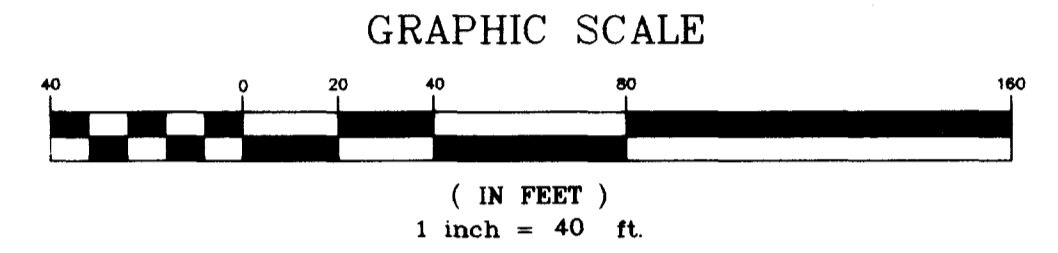

### LEGEND

- 2 LOT NUMBER
- 2 BLOCK NUMBER
- BOUNDARY
- RIGHT OF WAY
- LOT LINES
- STREET CENTERLINE
- BACK OF CURB LINE
- MONUMENTS AS DESCRIBED
- SET TYPE III MONUMENT - "VTN PLS 9105"
- SET TYPE IV-A REFERENCE MONUMENTS "VTN PLS 9105" IN TOP OF CURB
- FOUND TYPE IV-A REFERENCE MONUMENT - "VTN PLS 9105" IN TOP OF CURB

### NOTES

SEE FINAL MAP FOR BEARINGS AND DISTANCES.

I, STEPHEN P. GURLIDES, A PROFESSIONAL LAND SURVEYOR LICENSED IN THE STATE OF NEVADA, DO HEREBY CERTIFY THAT THE MONUMENTS HAVE BEEN SET AND THE TIE DISTANCES ESTABLISHED AS SHOWN HEREON. THIS SURVEY WAS COMPLETED ON 2-25-99.

*Stephen P. Gurlides*  
3-1-99

STEPHEN P. GURLIDES, P.L.S.  
NEVADA LICENSE NO. 9105

ACT	DATE	BY	REVISION
1			
2			
3			
4			

14149


<b>vtm</b> CONSULTING ENGINEERS • PLANNERS • LAND SURVEYORS			
2727 SOUTH RAINBOW BOULEVARD LAS VEGAS, NEVADA 89102-5148 (702) 873-7550 FAX (702) 362-2597			
SCALE: 1" = 40'	W.O.# 4706-3	DATE: 2-17-99	SHEET OF
FILE: 4706MTM3	DRN. BY: CZ	REV.:	1 1
	CKD. BY:		

058-4392-3

G:\CAD\Survey\4706\Mtm\4706MTM3.dwg Mon Mar 01 07:27:46 1999 Chris Z.

**MONUMENTATION TIE MAP**  
**DURANGO TRIALS TOWNHOMES - UNIT 3 (BOOK 80, PAGE 78)**


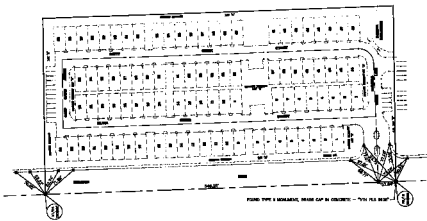

**LEGEND**


**NOTES**



  



