

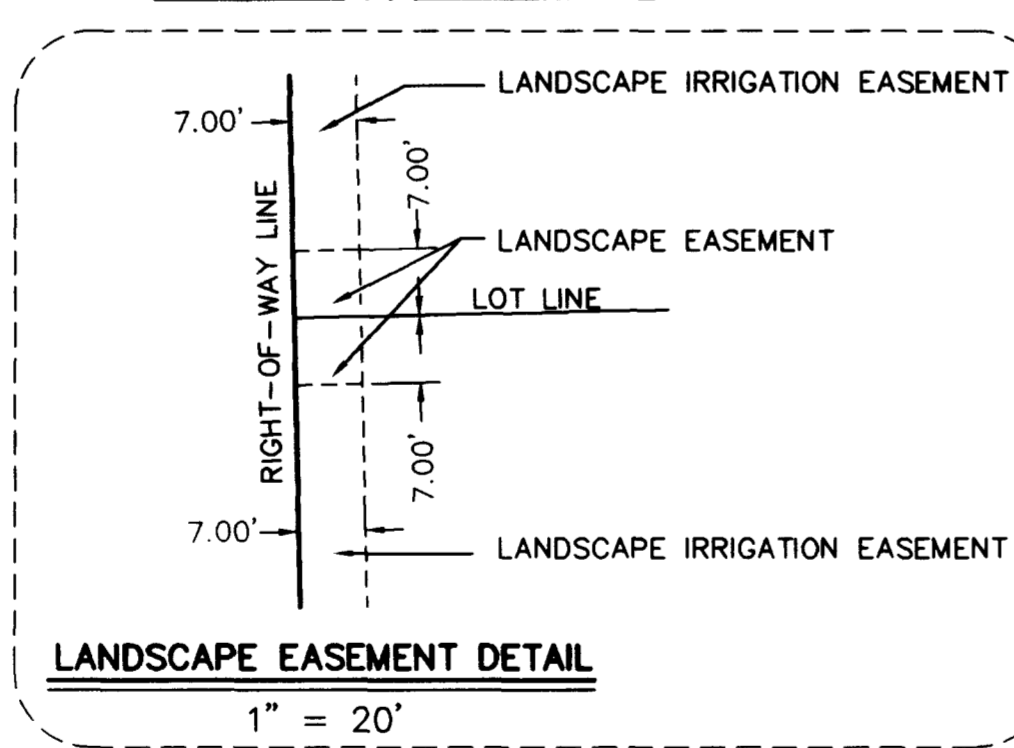
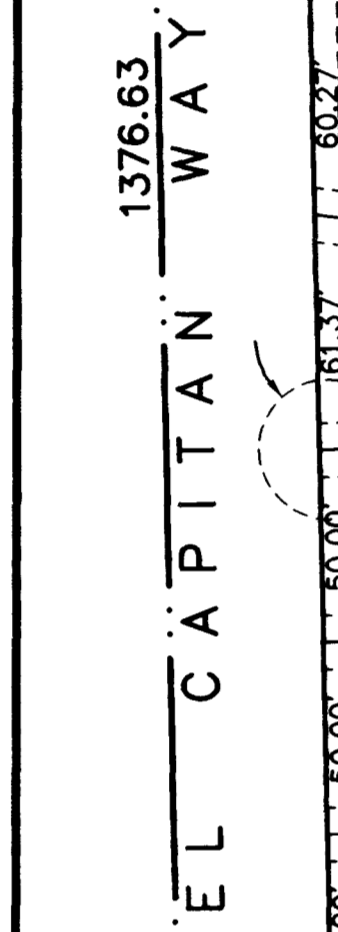
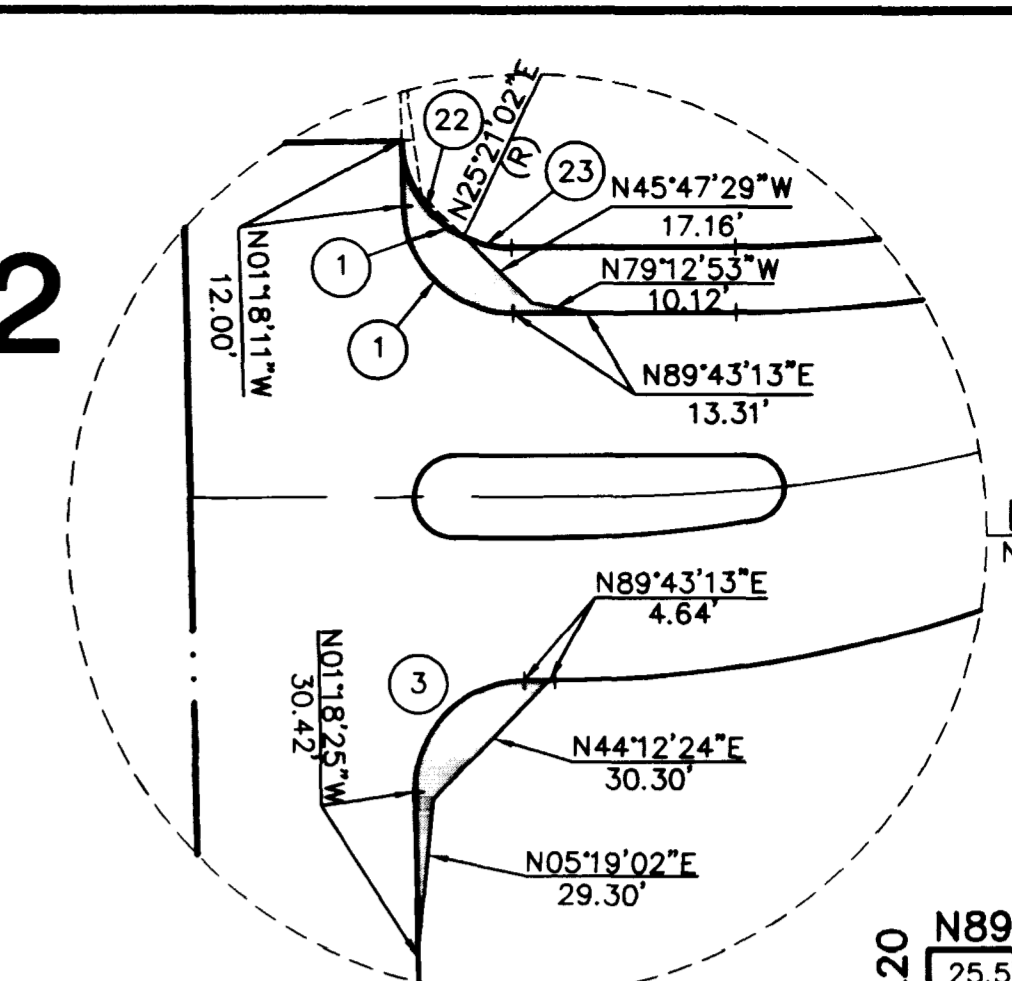
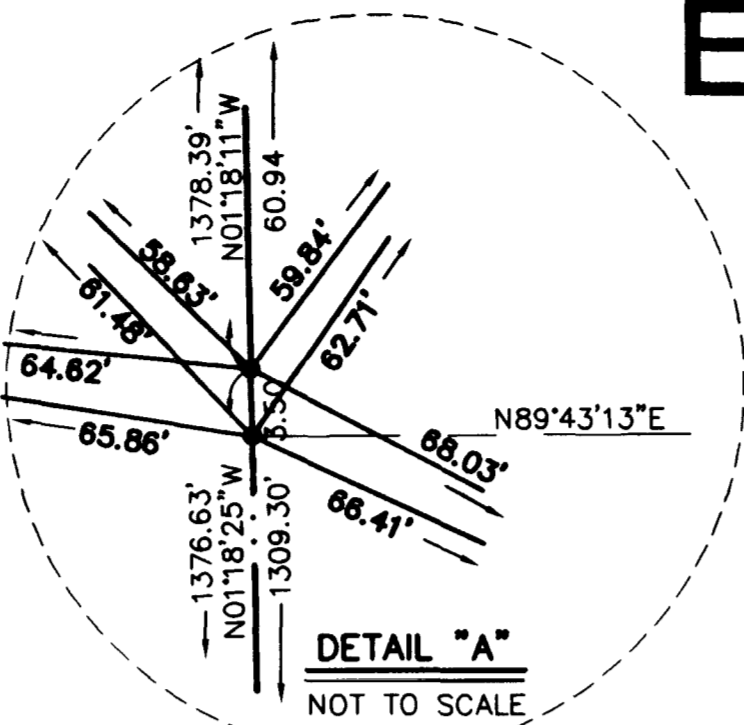


MONUMENT TIE MAP EL CAPITAN RANCH - UNIT NO. 2

BEING A PROTION OF THE NORTHEAST QUARTER (NE 1/4)
OF SECTION 8, TOWNSHIP 20 SOUTH, RANGE 60 EAST, M.D.M.,
CITY OF LAS VEGAS, CLARK COUNTY, NEVADA.

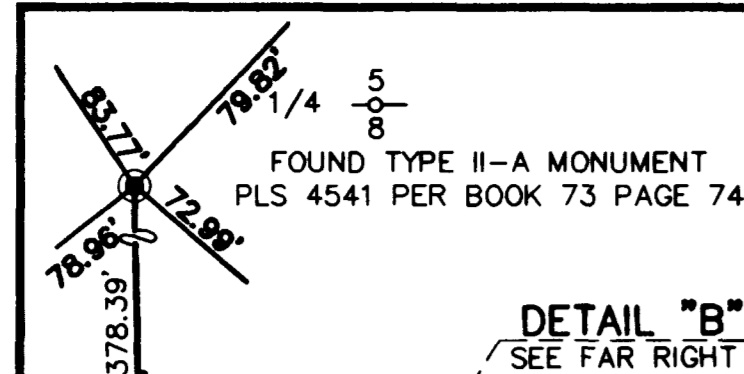




FUTURE DEVELOPMENT

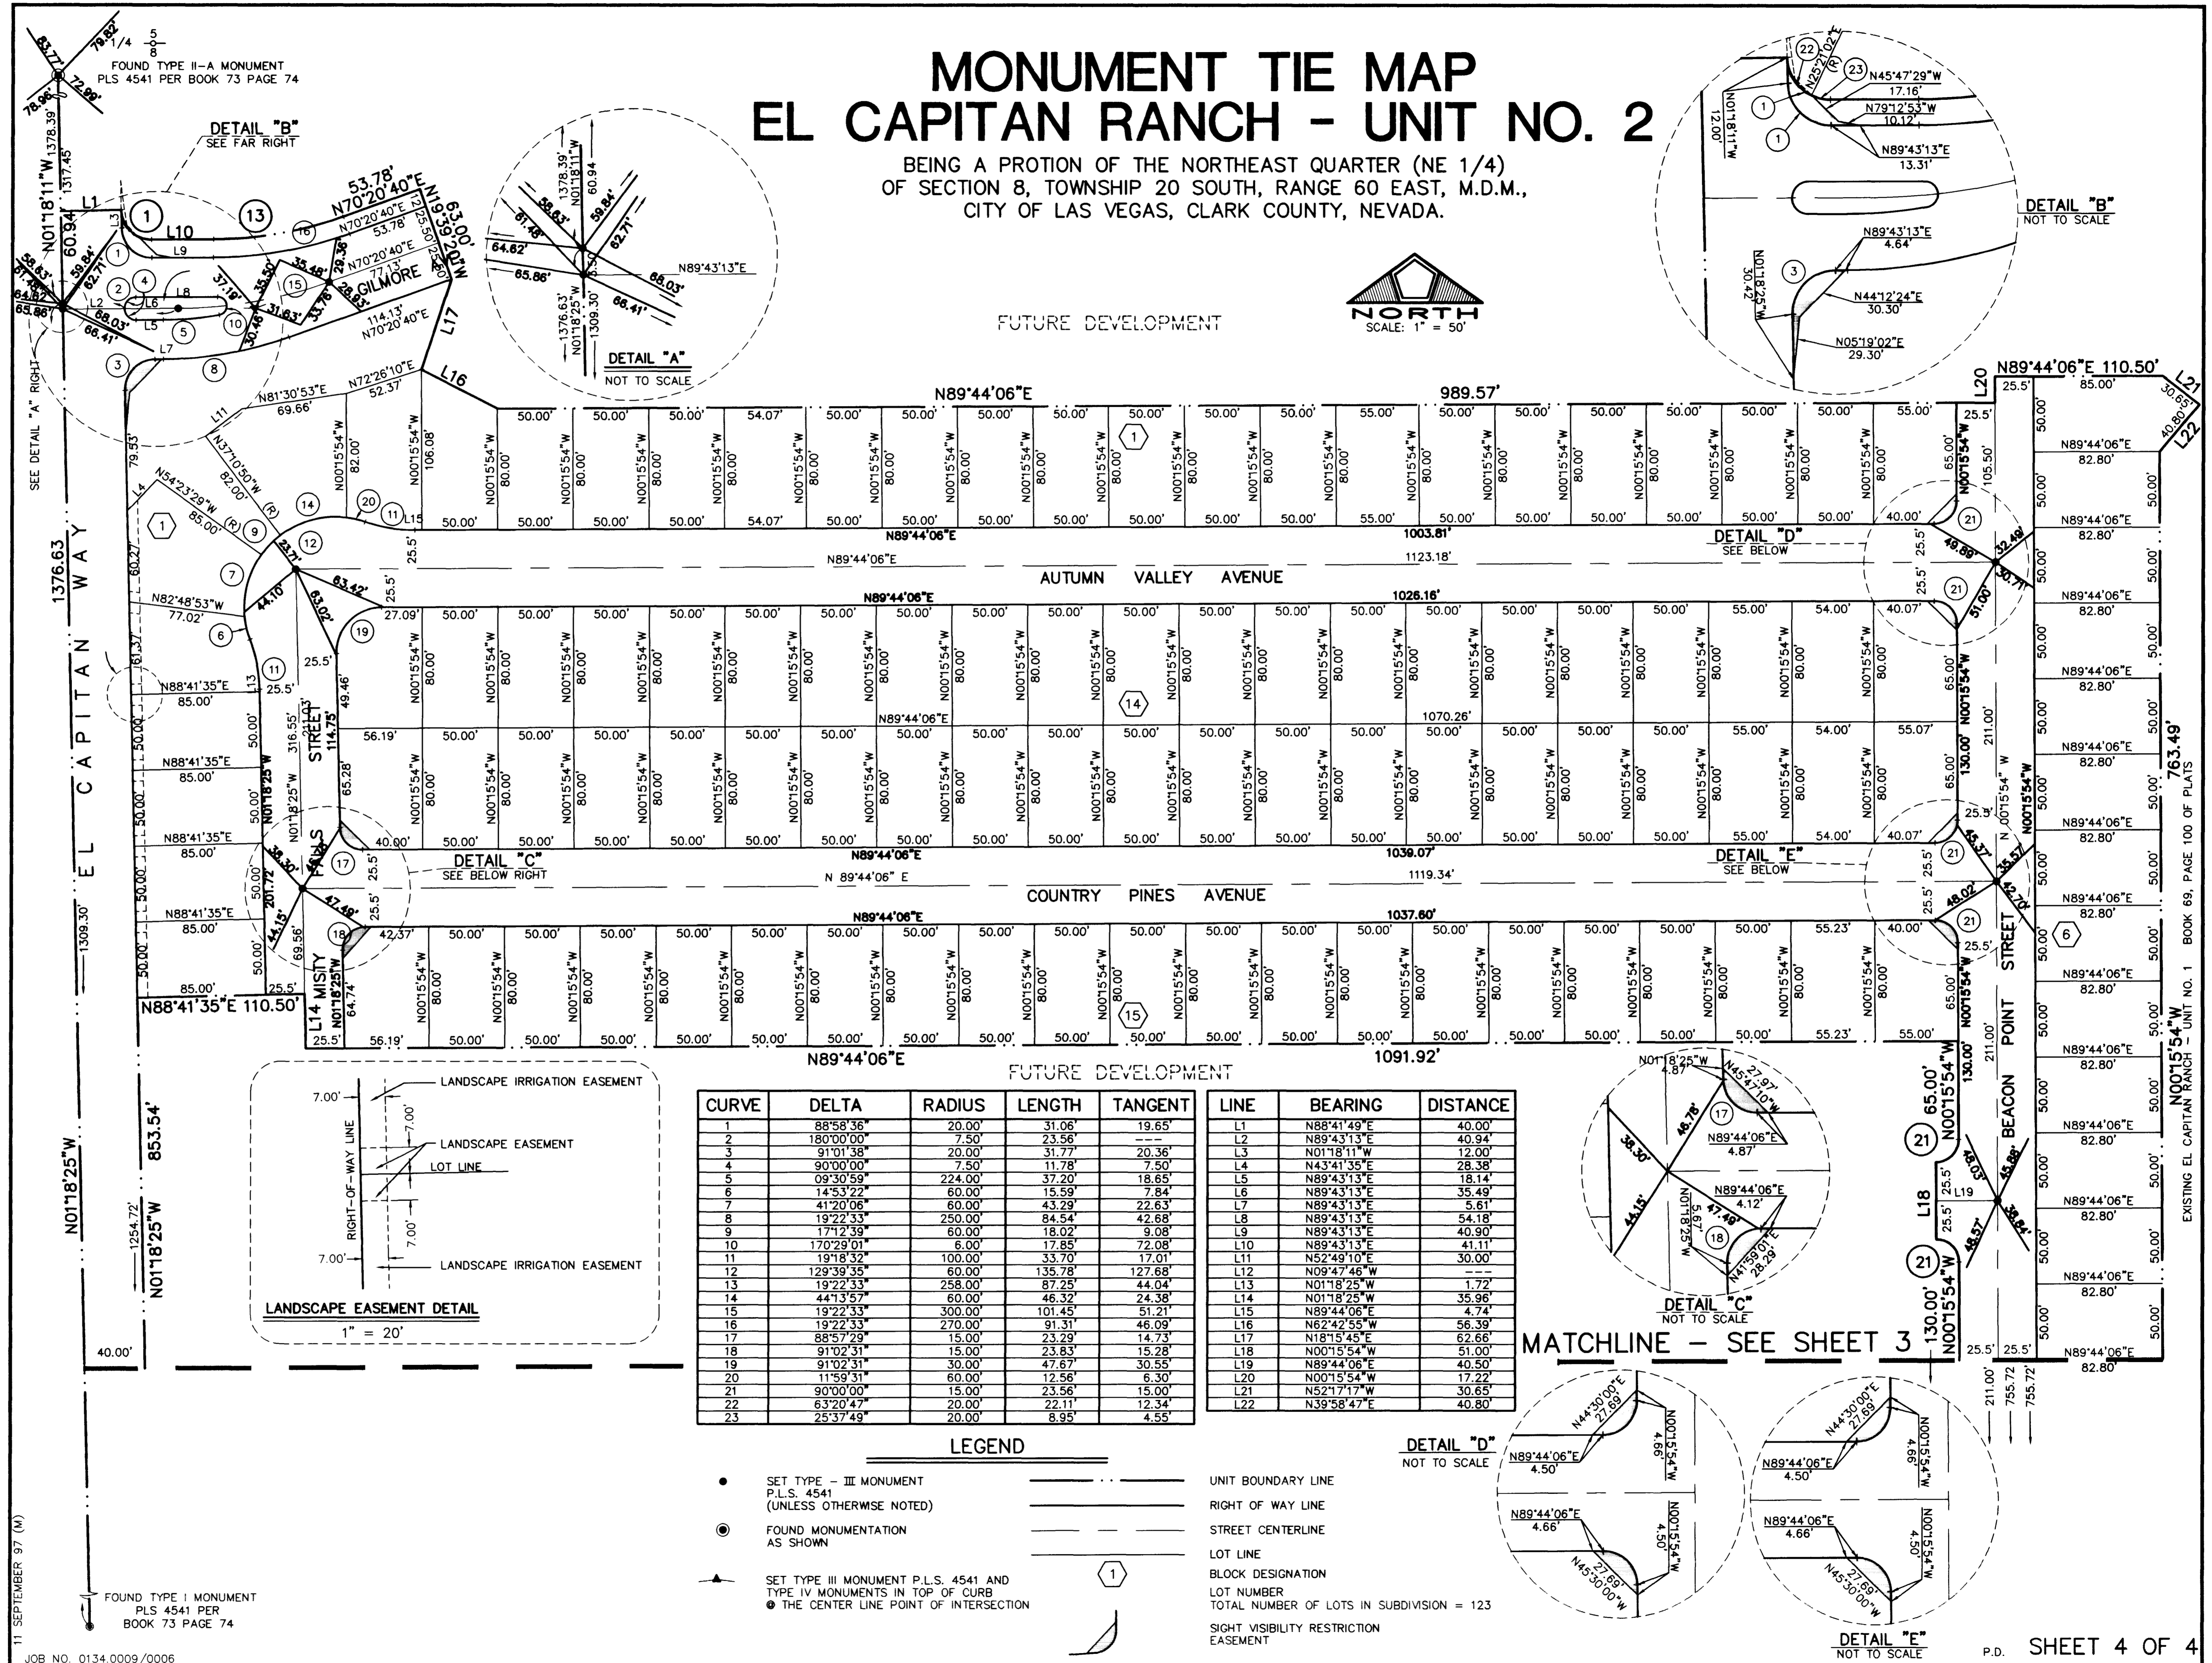

CURVE	DELTA	RADIUS	LENGTH	TANGENT
1	88°58'36"	20.00'	31.06'	19.65'
2	180°00'00"	7.50'	23.56'	---
3	91°01'38"	20.00'	31.77'	20.36'
4	90°00'00"	7.50'	11.78'	7.50'
5	09°30'59"	224.00'	37.20'	18.65'
6	14°53'22"	60.00'	15.59'	7.84'
7	41°20'06"	60.00'	43.29'	22.63'
8	19°22'33"	250.00'	84.54'	42.68'
9	17°12'39"	60.00'	18.02'	9.08'
10	170°29'01"	8.00'	17.65'	72.08'
11	19°18'32"	100.00'	33.70'	17.01'
12	128°39'35"	60.00'	135.78'	127.68'
13	19°22'33"	258.00'	87.25'	44.04'
14	44°13'57"	60.00'	46.32'	24.38'
15	19°22'33"	300.00'	101.45'	51.21'
16	19°22'33"	270.00'	91.31'	46.09'
17	88°57'29"	15.00'	23.29'	14.73'
18	91°02'31"	15.00'	23.83'	15.28'
19	91°02'31"	30.00'	47.67'	30.55'
20	11°59'31"	60.00'	12.56'	6.30'
21	90°00'00"	15.00'	23.56'	15.00'
22	63°20'47"	20.00'	22.11'	12.34'
23	25°37'49"	20.00'	8.95'	4.55'

LINE	BEARING	DISTANCE
L1	N88°41'49"E	40.00'
L2	N89°43'13"E	40.94'
L3	N01°18'11"W	12.00'
L4	N43°41'35"E	28.38'
L5	N89°43'13"E	18.14'
L6	N89°43'13"E	35.49'
L7	N89°43'13"E	5.61'
L8	N89°43'13"E	54.18'
L9	N89°43'13"E	40.90'
L10	N89°43'13"E	41.11'
L11	N52°49'10"E	30.00'
L12	N08°47'46"W	---
L13	N01°18'25"W	1.72'
L14	N01°18'25"W	35.96'
L15	N89°44'06"E	4.74'
L16	N62°42'55"W	56.39'
L17	N18°15'45"E	62.66'
L18	N00°15'54"W	51.00'
L19	N89°44'06"E	40.50'
L20	N00°15'54"W	17.22'
L21	N52°17'17"W	30.65'
L22	N39°58'47"E	40.80'

- LEGEND**
- SET TYPE - III MONUMENT P.L.S. 4541 (UNLESS OTHERWISE NOTED)
 - ⊙ FOUND MONUMENTATION AS SHOWN
 - ▲ SET TYPE III MONUMENT P.L.S. 4541 AND TYPE IV MONUMENTS IN TOP OF CURB
 - ⊙ THE CENTER LINE POINT OF INTERSECTION
- UNIT BOUNDARY LINE
 - RIGHT OF WAY LINE
 - STREET CENTERLINE
 - LOT LINE
 - BLOCK DESIGNATION
 - LOT NUMBER
 - TOTAL NUMBER OF LOTS IN SUBDIVISION = 123
 - SIGHT VISIBILITY RESTRICTION EASEMENT

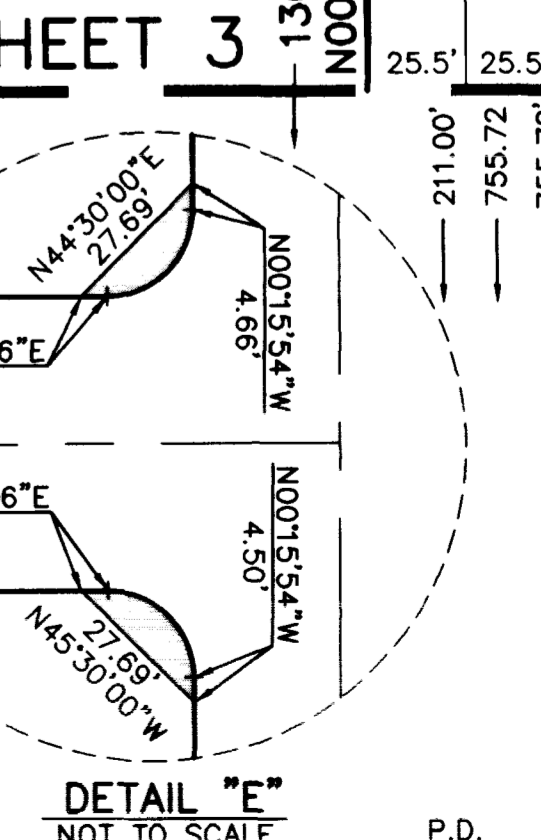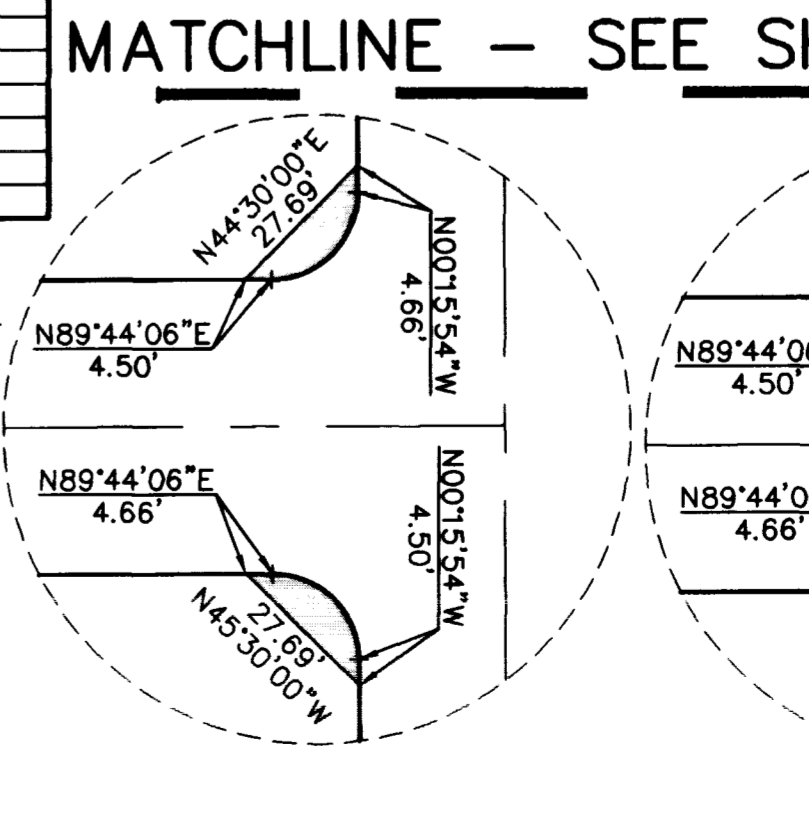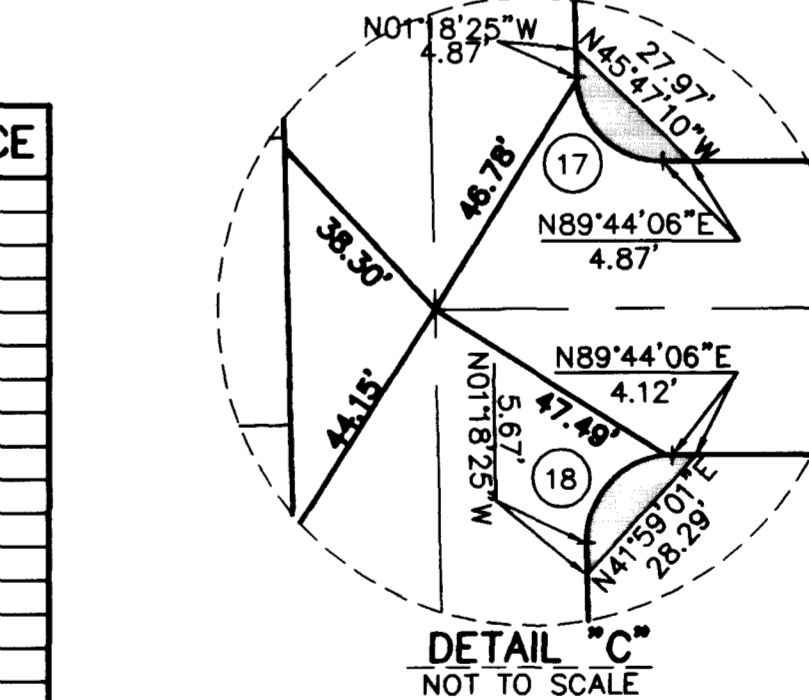

11 SEPTEMBER 97 (M)

FOUND TYPE I MONUMENT
PLS 4541 PER
BOOK 73 PAGE 74

JOB NO. 0134.0009/0006

EXISTING EL CAPITAN RANCH - UNIT NO. 1 BOOK 69, PAGE 100 OF PLATS

MONUMENT TIE MAP EL CAPITAN RANCH - UNIT NO. 2

BEING A PORTION OF THE NORTHEAST QUARTER (NE 1/4)
CITY OF LAS VEGAS, CLARK COUNTY, NEVADA.

FUTURE DEVELOPMENT

