


# MONUMENT TIE MAP EL CAPITAN RANCH - UNIT NO. 2

BEING A PORTION OF THE NORTHEAST QUARTER (NE 1/4)  
OF SECTION 8, TOWNSHIP 20 SOUTH, RANGE 60 EAST, M.D.M.,  
CITY OF LAS VEGAS, CLARK COUNTY, NEVADA.

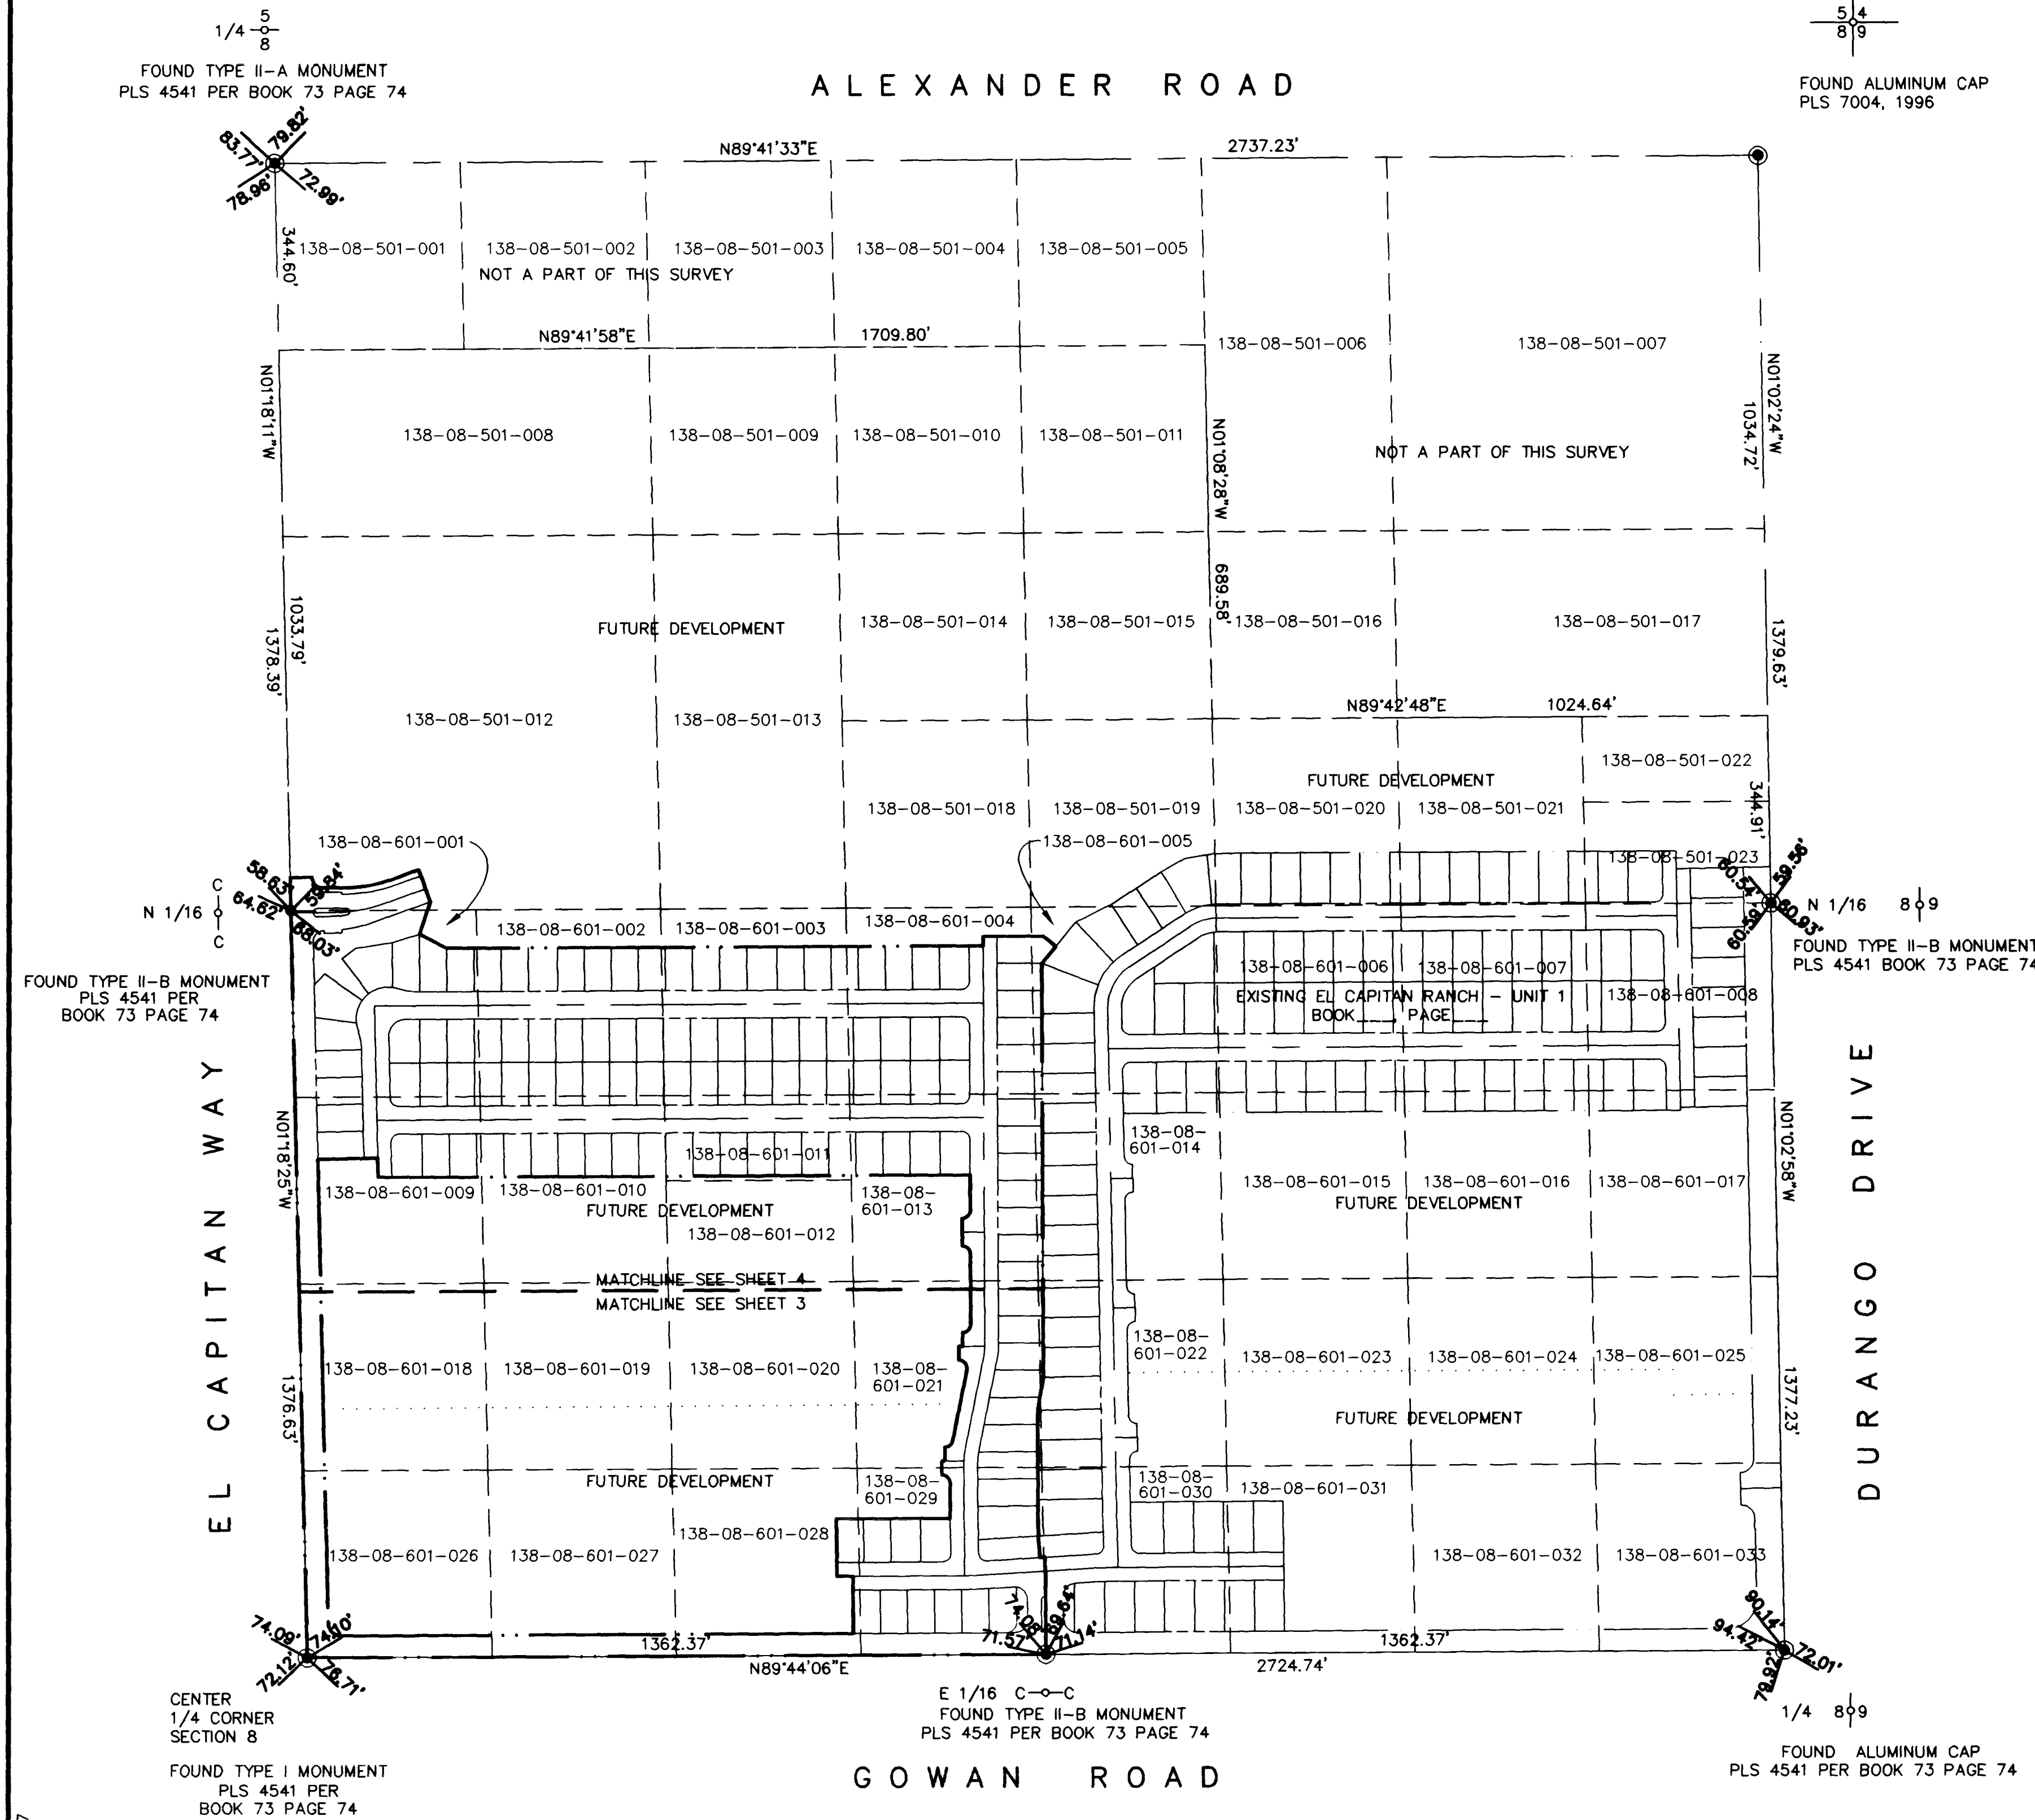

### SURVEYOR'S CERTIFICATE

I, FREDERICK W. ORBAN, A PROFESSIONAL LAND SURVEYOR REGISTERED IN THE STATE OF NEVADA, DO HEREBY CERTIFY THAT THE MONUMENTS HAVE BEEN SET AND THE TIE DISTANCES ESTABLISHED AS SHOWN HEREON. THIS SURVEY WAS COMPLETED ON JULY 31, 1998.



FREDERICK W. ORBAN  
PROFESSIONAL LAND SURVEYOR  
NEVADA CERTIFICATE NO. 4541

### REFERENCES

- RECORD OF SURVEY FILE 42, PAGE 15
- RECORD OF SURVEY FILE 63, PAGE 60
- RECORD OF SURVEY FILE 67, PAGE 80
- RECORD OF SURVEY FILE 69, PAGE 73
- RECORD OF SURVEY FILE 73, PAGE 4
- RECORD OF SURVEY FILE 73, PAGE 46
- PARCEL MAP FILE 5, PAGE 25
- PARCEL MAP FILE 39, PAGE 87

### LEGEND

- FOUND TYPE II MONUMENT  
P.L.S. 4541  
(UNLESS OTHERWISE NOTED)  
PER BOOK 69, PAGE 100  
OF PLATS
- FOUND MONUMENTATION  
AS SHOWN AND DESCRIBED
- UNIT BOUNDARY

15 JULY 1997

JOB NO. 0134.0009/0006

S:\0134\0009\0006\UNIT2\11.E\009me2-2.dwg Mon Aug 03 07:57:01 1998 Mick J

