MONUMENT TIE MAP
EL CAPITAN RANCH – UNIT NO. 5

**BEING A PORTION OF THE NORTHEAST QUARTER (NE 1/4)
OF SECTION 8, TOWNSHIP 20 SOUTH, RANGE 60 EAST, M.D.M.,
CITY OF LAS VEGAS, CLARK COUNTY, NEVADA.**

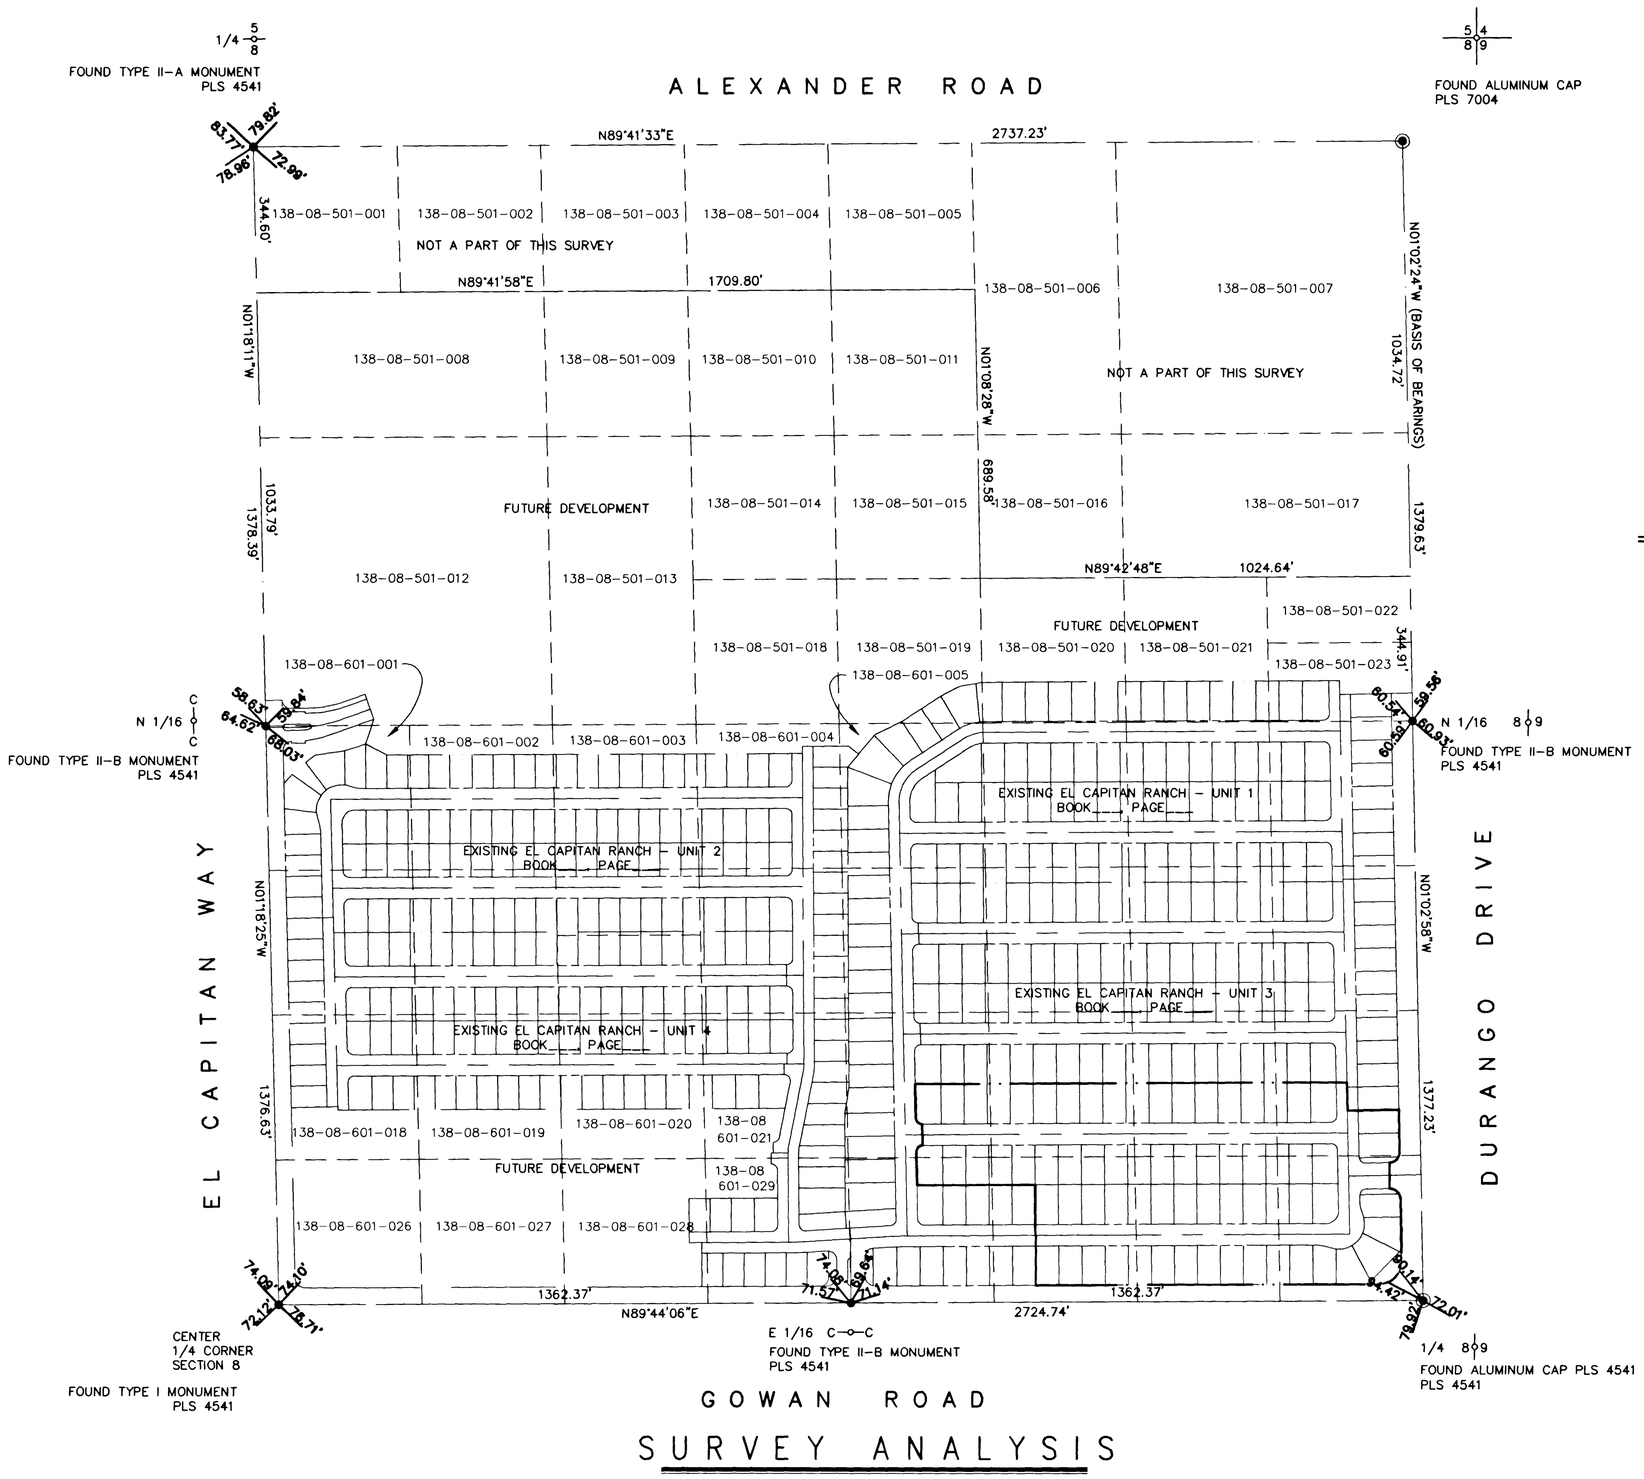

SURVEYOR'S CERTIFICATE

I, FREDERICK W. ORBAN, A PROFESSIONAL LAND SURVEYOR REGISTERED IN THE STATE OF NEVADA, DO HEREBY CERTIFY THAT THE MONUMENTS HAVE BEEN SET AND THE TIE DISTANCES ESTABLISHED AS SHOWN HEREON. THIS SURVEY WAS COMPLETED ON FEBRUARY 03, 1999.

PROFESSIONAL LAND SURVEYOR
FREDERICK W. ORBAN
No. 4541
STATE OF NEVADA

2/12/99

FREDERICK W. ORBAN
PROFESSIONAL LAND SURVEYOR
NEVADA CERTIFICATE NO. 4541

REFERENCES

RECORD OF SURVEY FILE 42 ,PAGE 15
RECORD OF SURVEY FILE 63 ,PAGE 60
RECORD OF SURVEY FILE 67 ,PAGE 80
RECORD OF SURVEY FILE 69 ,PAGE 73
RECORD OF SURVEY FILE 73 ,PAGE 4
RECORD OF SURVEY FILE 73 ,PAGE 46

PARCEL MAP FILE 5 ,PAGE 25
PARCEL MAP FILE 39 ,PAGE 87

LEGEND

- FOUND TYPE II–B MONUMENT P.L.S. 4541 (UNLESS OTHERWISE NOTED) PER BOOK 69, PAGE 100, OF PLATS
- FOUND MONUMENTATION AS SHOWN PER FILE 73, PAGE 4 OF SURVEYS
- UNIT BOUNDARY

SURVEY ANALYSIS

03 FEBRUARY 99 (M)

JOB NO. 0134.0009

A.W. SHEET 2 OF 3

13855

058-4396-5

BOOK 73 PAGE 01

MONUMENT TIE MAP
EL CAPITAN RANCH – UNIT NO. 5

BEING A PORTION OF THE NORTHEAST QUARTER (NE 1/4)
OF SECTION 8, TOWNSHIP 20 SOUTH, RANGE 60 EAST, M.D.M.,
CITY OF LAS VEGAS, CLARK COUNTY, NEVADA.

NORTH
SCALE: 1" = 300'

 

SURVEY ANALYSIS

SURVEYOR'S CERTIFICATE

I, FREDERICK W. DRIMAN, A PROFESSIONAL LAND SURVEYOR REGISTERED IN THE STATE OF NEVADA, DO HEREBY CERTIFY THAT THE MONUMENTS HAVE BEEN SET AND THE TIE DISTANCES ESTABLISHED AS SHOWN HEREON. THIS SURVEY WAS COMPLETED ON FEBRUARY 23, 1998.

2/11/99

FREDERICK W. DRIMAN
PROFESSIONAL LAND SURVEYOR
NEVADA CERTIFICATE NO. 6541

REFERENCES

RECORD OF SURVEY FILE 44 PAGE 13
RECORD OF SURVEY FILE 65 PAGE 68
RECORD OF SURVEY FILE 67 PAGE 68
RECORD OF SURVEY FILE 68 PAGE 73
RECORD OF SURVEY FILE 73 PAGE 4
RECORD OF SURVEY FILE 73 PAGE 46

PARCEL MAP FILE 6 PAGE 38
PARCEL MAP FILE 6 PAGE 37

LEGEND

- FOUND MONUMENTATION AS SHOWN PER THIS MAP, PAGE 2 OF SURVEY
- UNIT BOUNDARY

SHEET 2 OF 3