

961009

01239




DIAMOND RIDGE - UNIT 7

BEING A PORTION OF THE NORTHWEST QUARTER (NW 1/4) OF THE NORTHWEST QUARTER (NW 1/4) OF SECTION 8, TOWNSHIP 20 SOUTH, RANGE 60 EAST, M.D.M., CITY OF LAS VEGAS, CLARK COUNTY, NEVADA

MONUMENTATION TIE MAP

SEE SHEET 3 OF 4

FOUND 1-1/2" AL. CAP
"VTN PLS 8421"

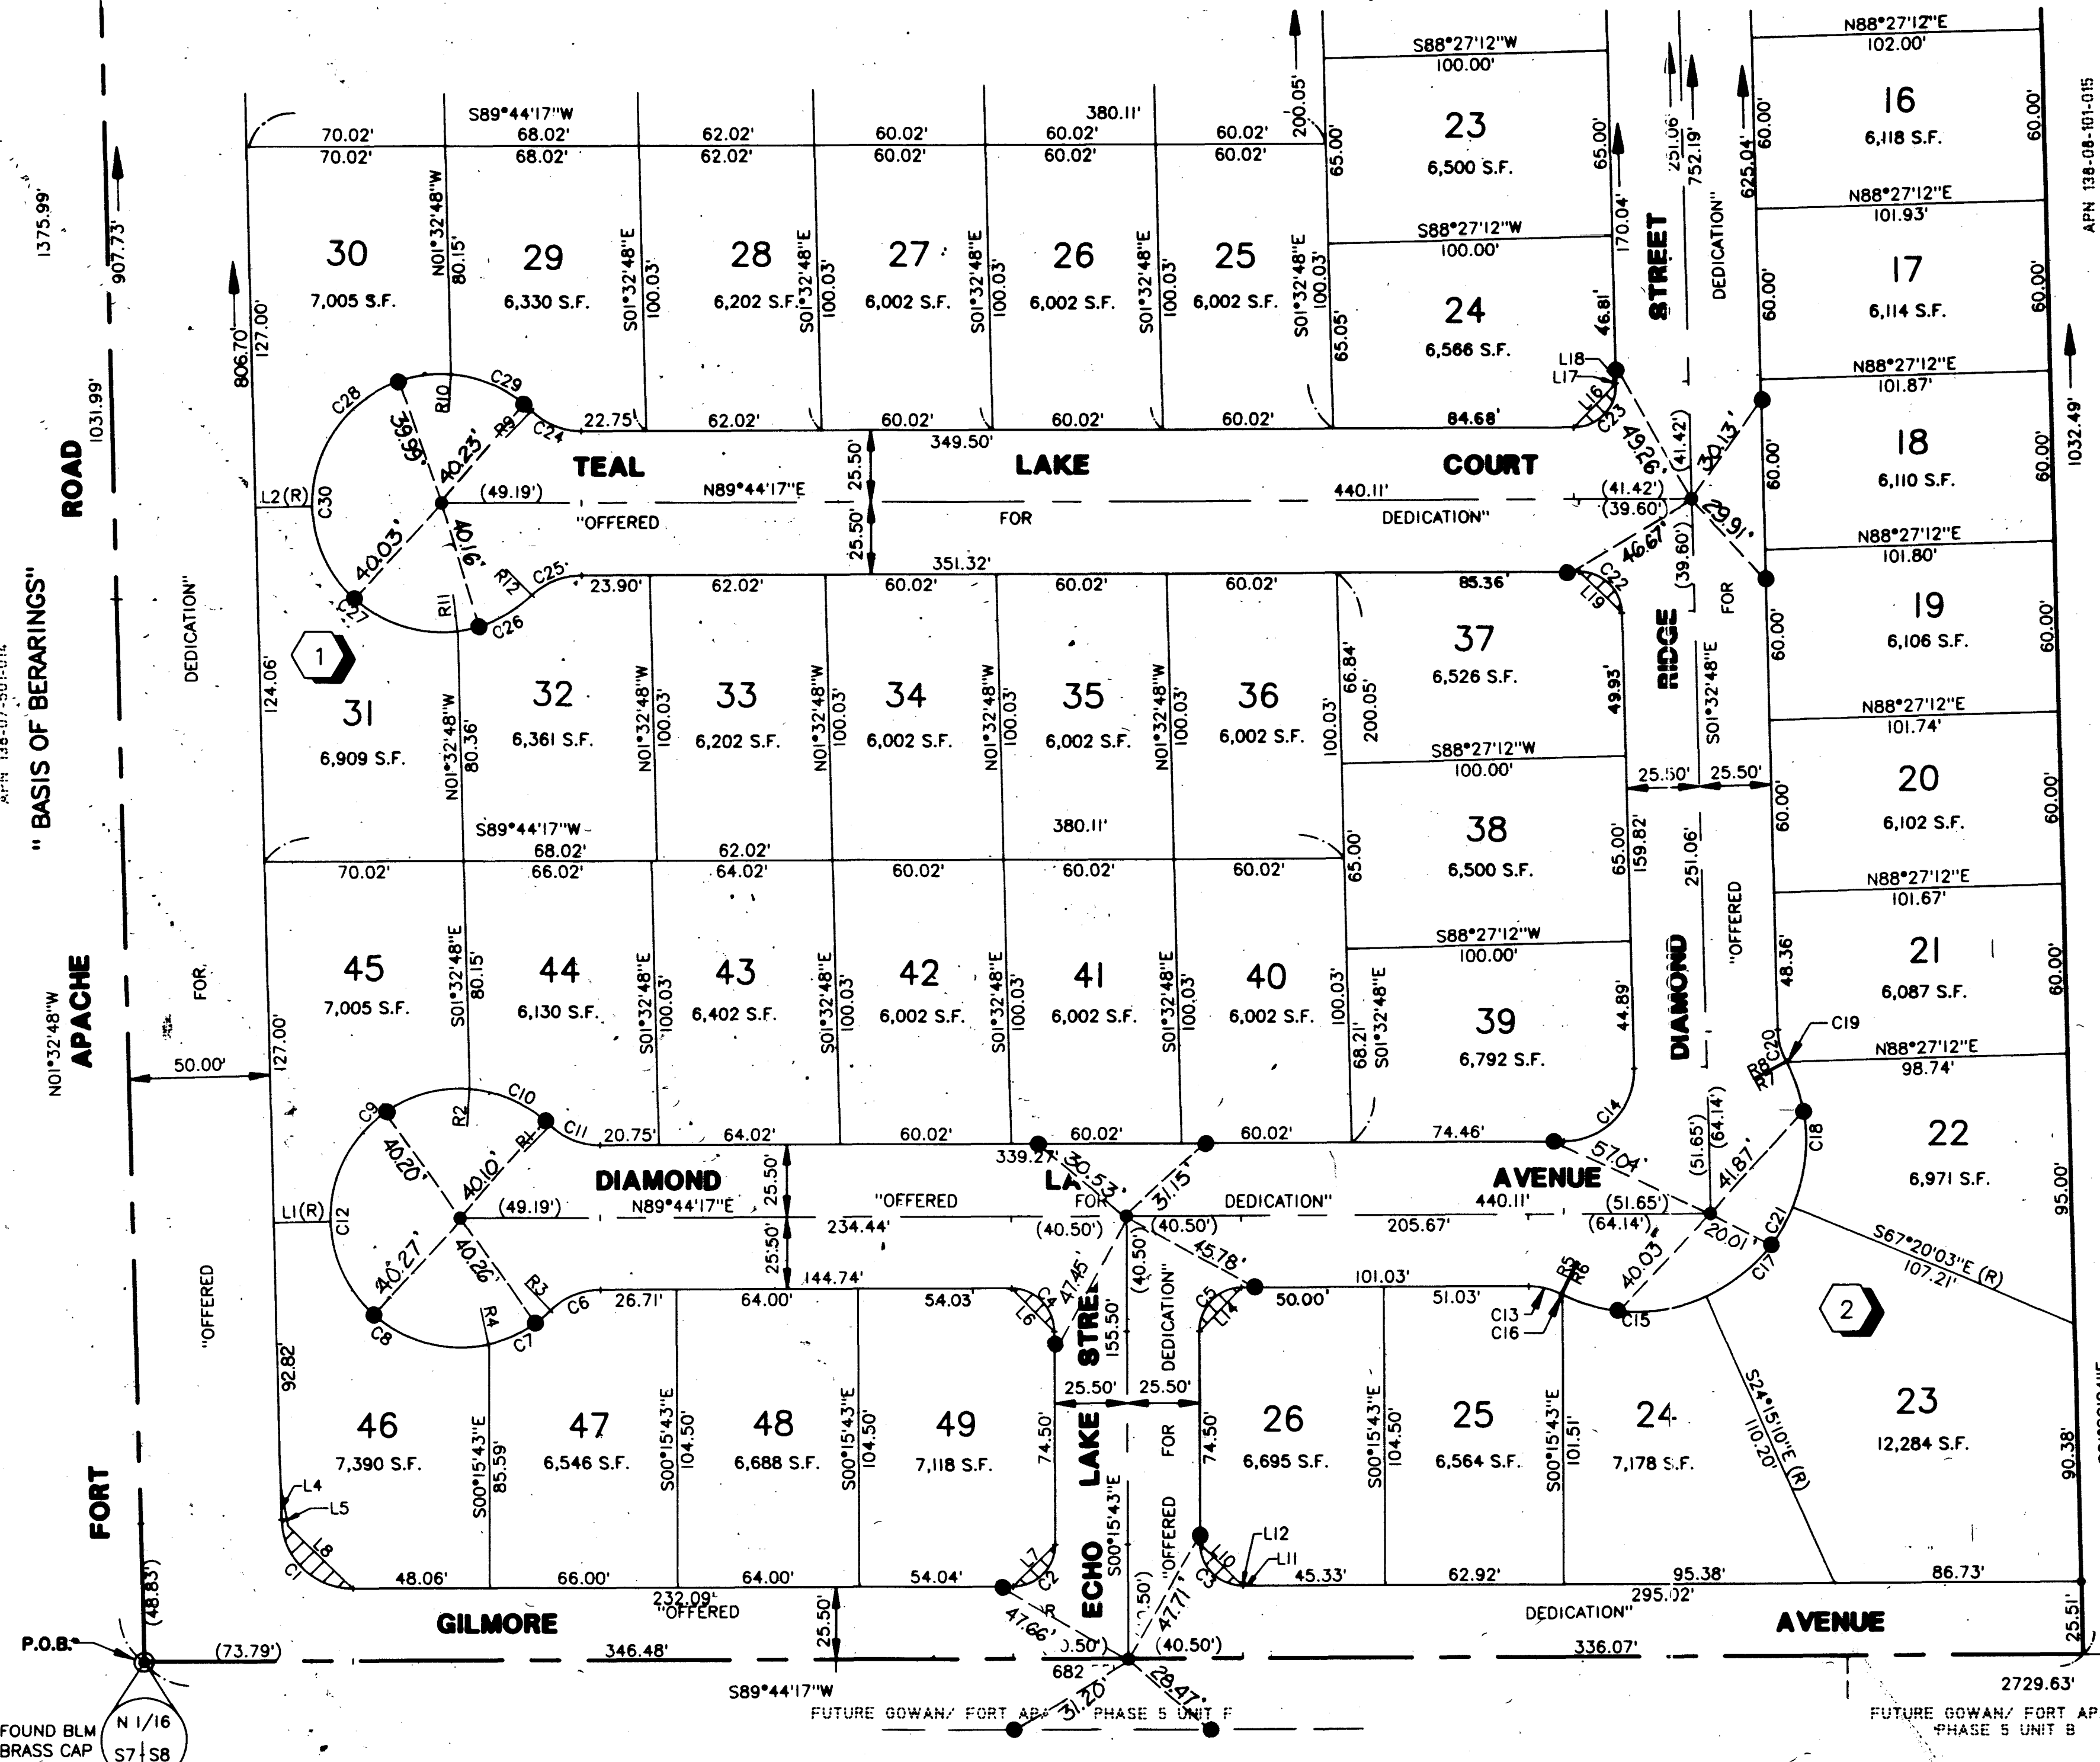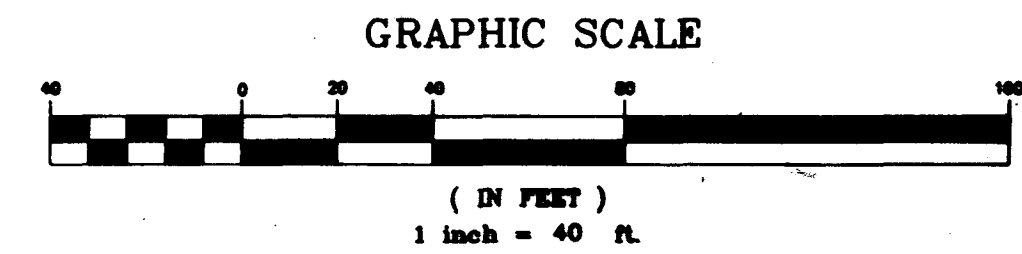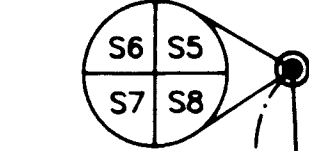

LEGEND

- P.O.B. POINT OF BEGINNING
- 15 LOT NUMBER / RESIDENTIAL = 75
- 2 BLOCK NUMBER
- R1 RADIAL LINE NUMBER (SEE SHEET 4 OF 4)
- L3 COURSE NUMBER (SEE SHEET 4 OF 4)
- C2 CURVE NUMBER (SEE SHEET 4 OF 4)
- FOUND MONUMENT AS DESCRIBED
- TYPE III MONUMENT - "VTN PLS 9105"
- SET NAIL & BRASS TAG "PLS 9105" OR SAWCUT TOP OF CURB ON PROLONGATION OF PROPERTY LINES, PER NOTE 1
- S.F. SQUARE FEET
- CENTERLINE
- LOT LINE
- BOUNDARY LINE
- ⌒ SIGHT VISIBILITY RESTRICTION EASEMENT PER C.L.V. STANDARD DRAWING #404.1600

I, STEPHEN P. GURLIDES, A PROFESSIONAL LAND SURVEYOR IN THE STATE OF NEVADA, DO HEREBY CERTIFY THAT THE MONUMENTS HAVE BEEN SET AND THE TIE DISTANCE ESTABLISHED AS SHOWN HEREON. THIS SURVEY WAS COMPLETED ON

STEPHEN P. GURLIDES
NEVADA CERTIFICATION No. 9105
12-29-97

NOTES

1. ALL REAR LOT CORNERS SHALL BE SET WITH A NAIL AND TAG "P.L.S. 9105" ON BLOCK WALL AND ALL FRONT OR SIDE LOT CORNERS ADJOINING RIGHT-OF-WAY SHALL BE MARKED BY THE SAWCUTTING OF THE BACK OF CURBS ON THE PROLONGATION OF THE PROPERTY LINES.
2. DIRECT VEHICULAR ACCESS TO FORT APACHE ROAD AND GILMORE AVENUE FROM ADJUTING LOTS IS PROHIBITED.

ACT	DATE	BY	REVISION
1	4/14/95	VCL	REVISE SVRE & GILMORE ROW TO 51' WIDE

12822

W.O. 4734
SHEET 2 OF 4
VCL

058-4455-7

Book 76 Page 52


961009

01039

DIAMOND RIDGE - UNIT 7


SEE SHEET 3 OF 4

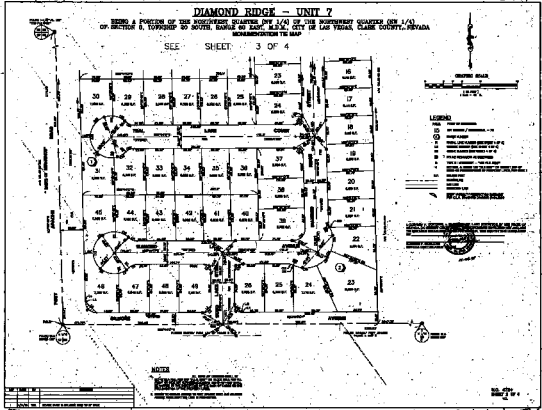

- LEGEND**
