


ESTIMATED QUANTITIES
 CONCRETE SIDEWALK 1,500 SQ. FT.
 CONCRETE 'L' TYPE CURB & GUTTER 300 LIN. FT.

NOTE: ALL CONSTRUCTION TO CONFORM TO UNIFORM STANDARD SPECIFICATIONS FOR PUBLIC WORKS CONSTRUCTION FOR CLARK COUNTY AREA AND UNIFORM STANDARD DRAWINGS.

BENCH MARK: C.L.V. 06130C1 LOCATED NEAR THE SOUTHEAST CORNER OF THE INTERSECTION OF DECATUR BLVD. AND WASHINGTON AVENUE. ELEVATION: 2199.38

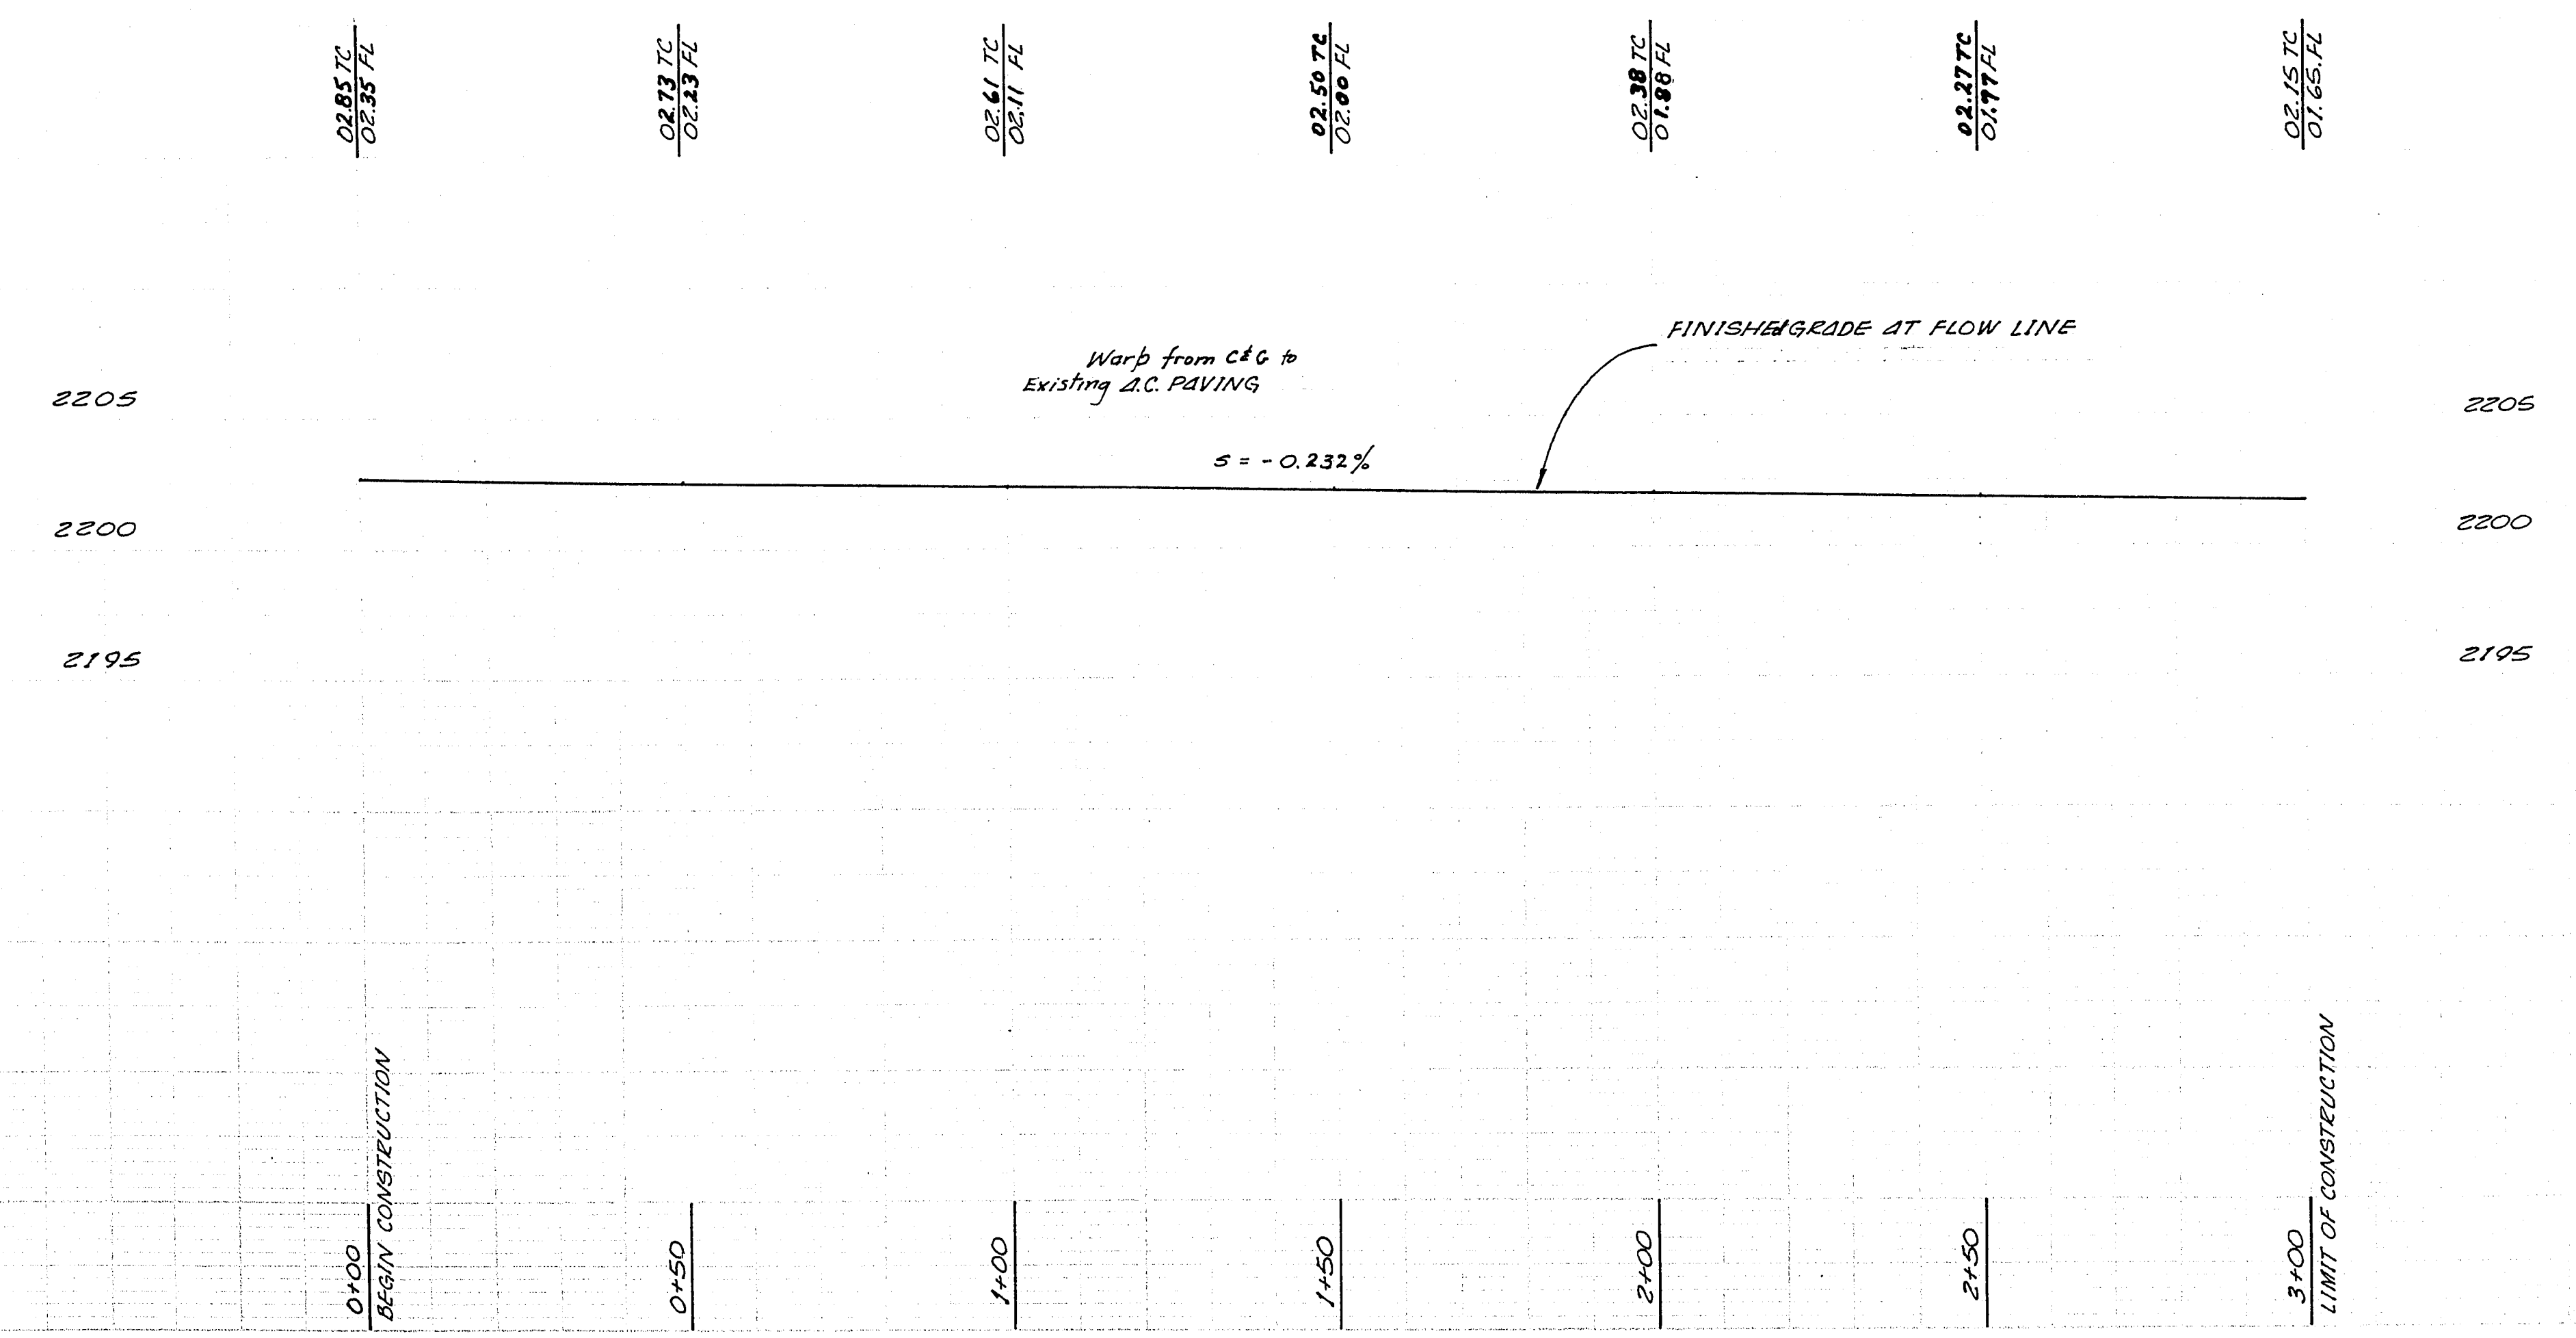

BAUGHMAN DESIGN - RICHARD J. BAUGHMAN - RE 2162 - DATE 9-30-06	LAND SURVEYORS LAS VEGAS, NEVADA SCALE HORIZ 1" = 20' VERT 1" = 5'	APPROVALS U.S. Sullivan CITY ENGINEER J.D. Sullivan FIELD ENGINEER	REVISIONS Changed Grade and Elevation on Decatur 7/10/11 12-24-60 DATE DATE
	CHECKED DATE	SHEET 1 OF 2 SHEETS 107-1807	15-4-09	