

950511

21-17-192

01102


DURANGO TRAILS TOWNHOMES - UNIT 1

(A COMMON INTEREST OWNERSHIP COMMUNITY)

A PORTION OF THE WEST HALF (W 1/2) OF THE SOUTHWEST QUARTER (SW 1/4) OF THE SOUTHWEST QUARTER (SW 1/4)
OF THE NORTHWEST QUARTER (NW 1/4) OF SECTION 28, TOWNSHIP 20 SOUTH, RANGE 60 EAST,
M.D.M., CITY OF LAS VEGAS, CLARK COUNTY, NEVADA

RIDGEVIEW WEST II-UNIT 9
PLAT: BOOK 56, PAGE 28

RIDGEVIEW WEST II-UNIT 10
PLAT: BOOK 57, PAGE 6

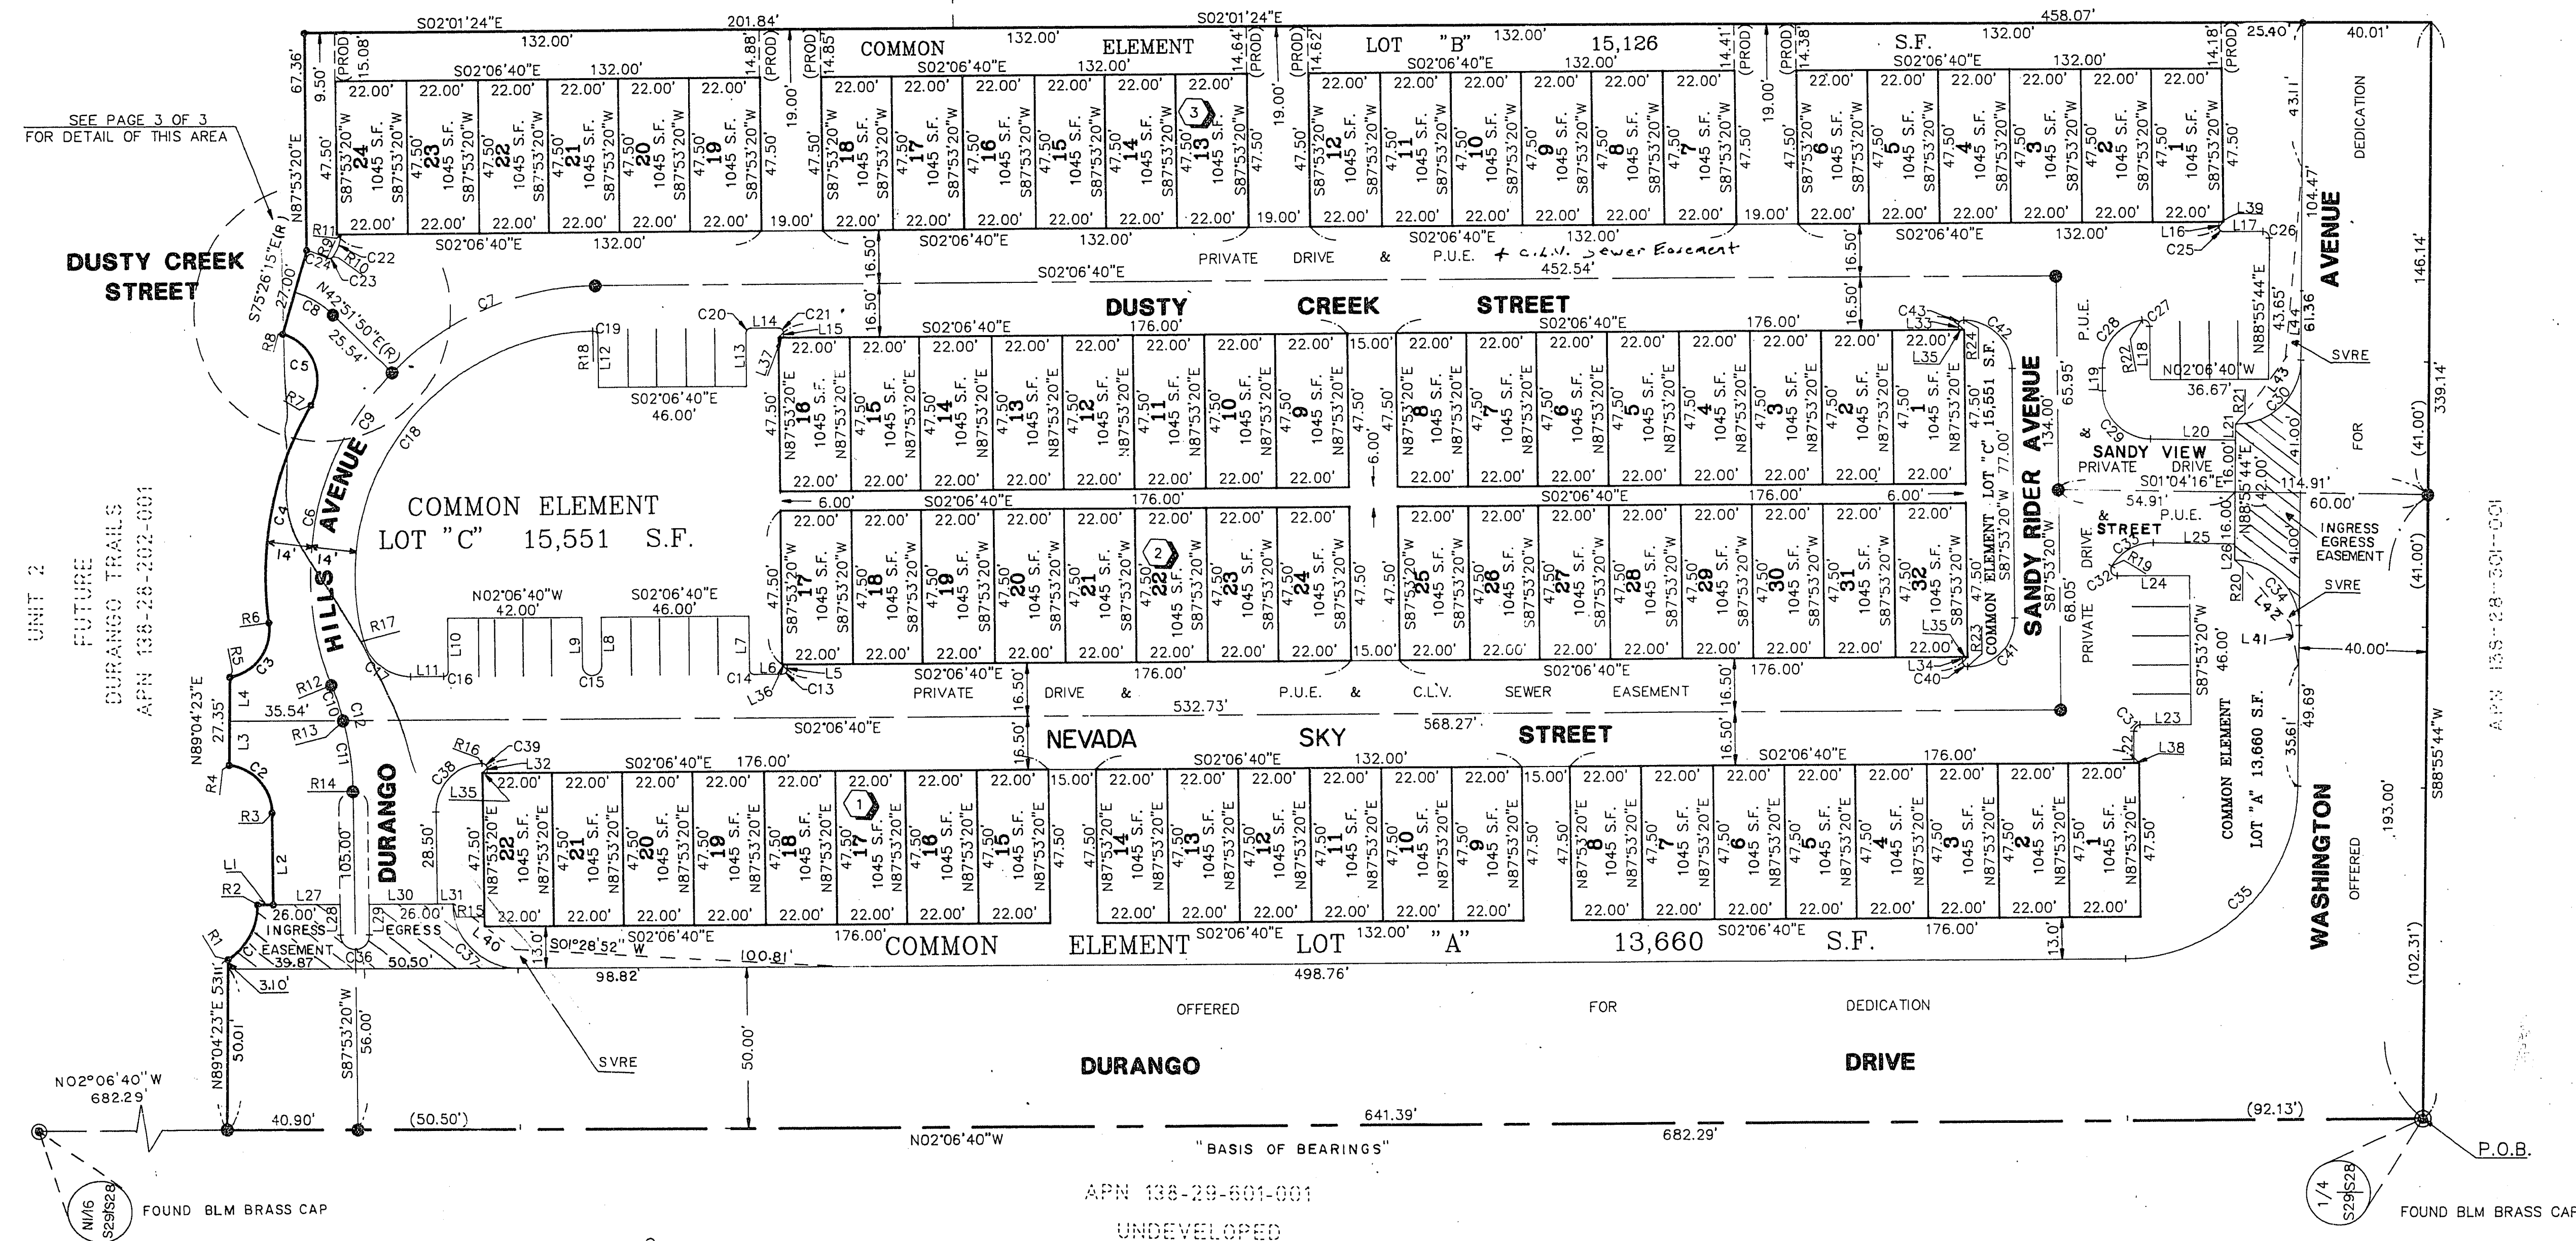

BOOK 67, Page 80