


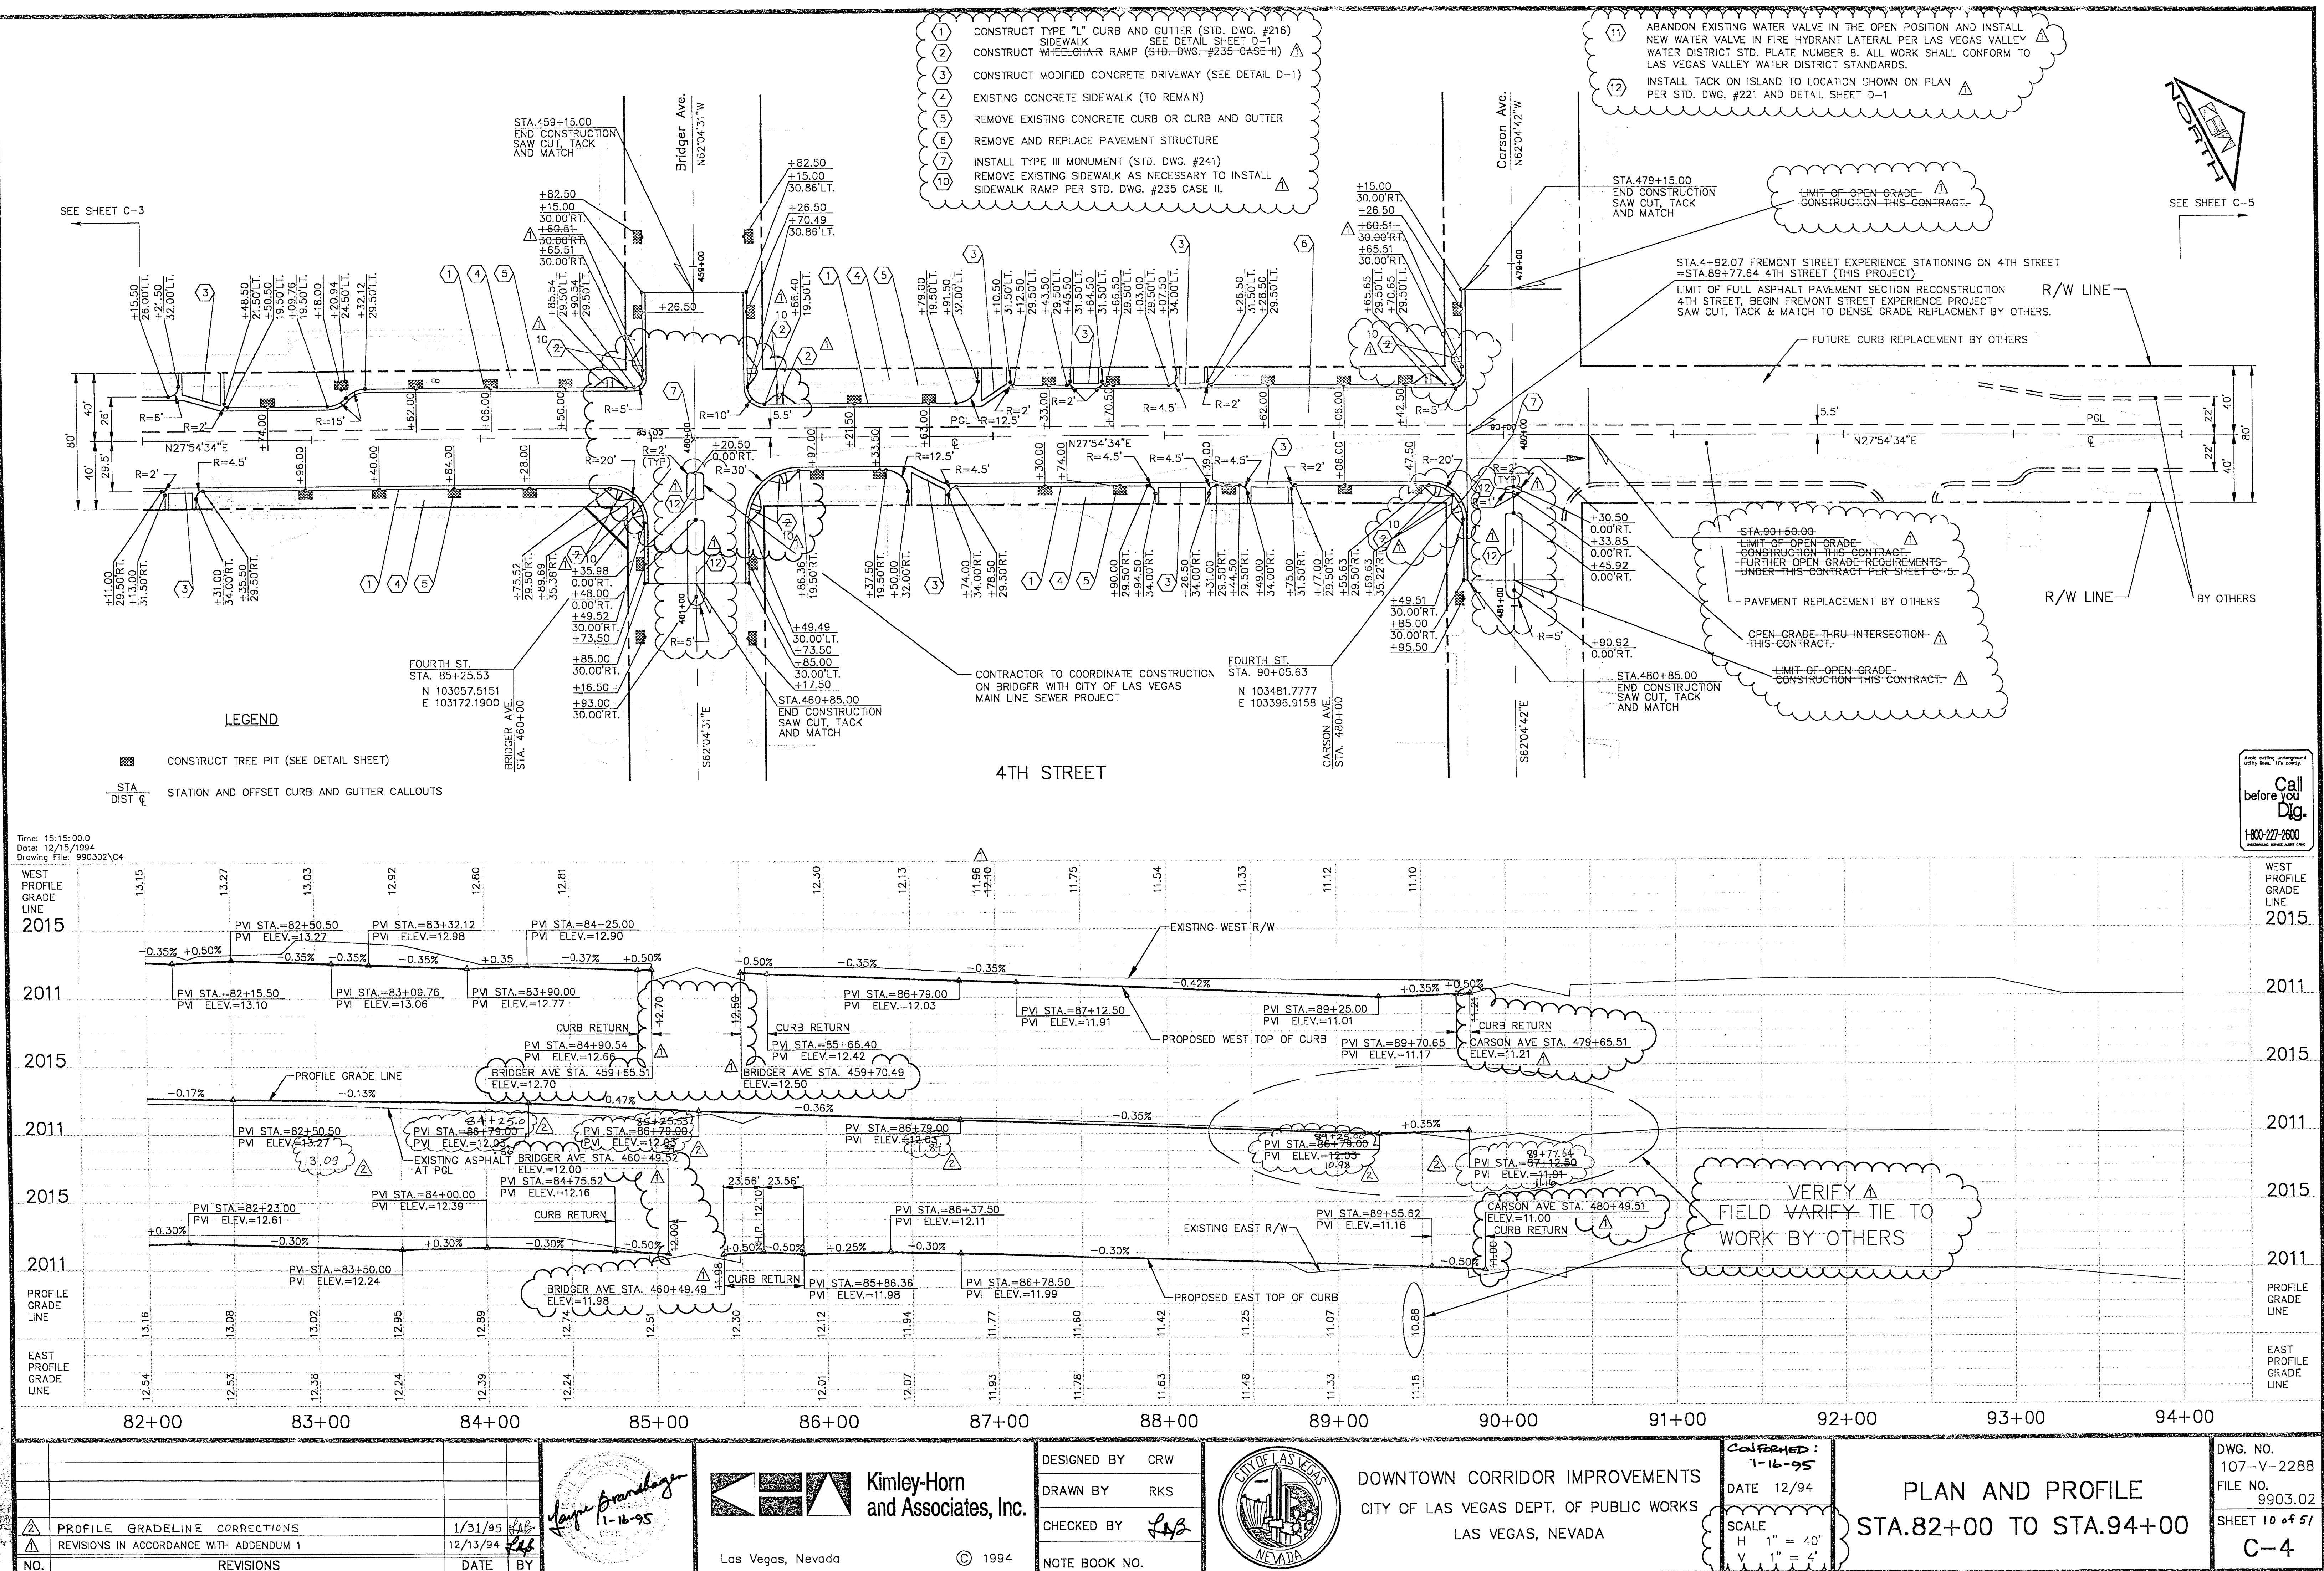

21-2-59