
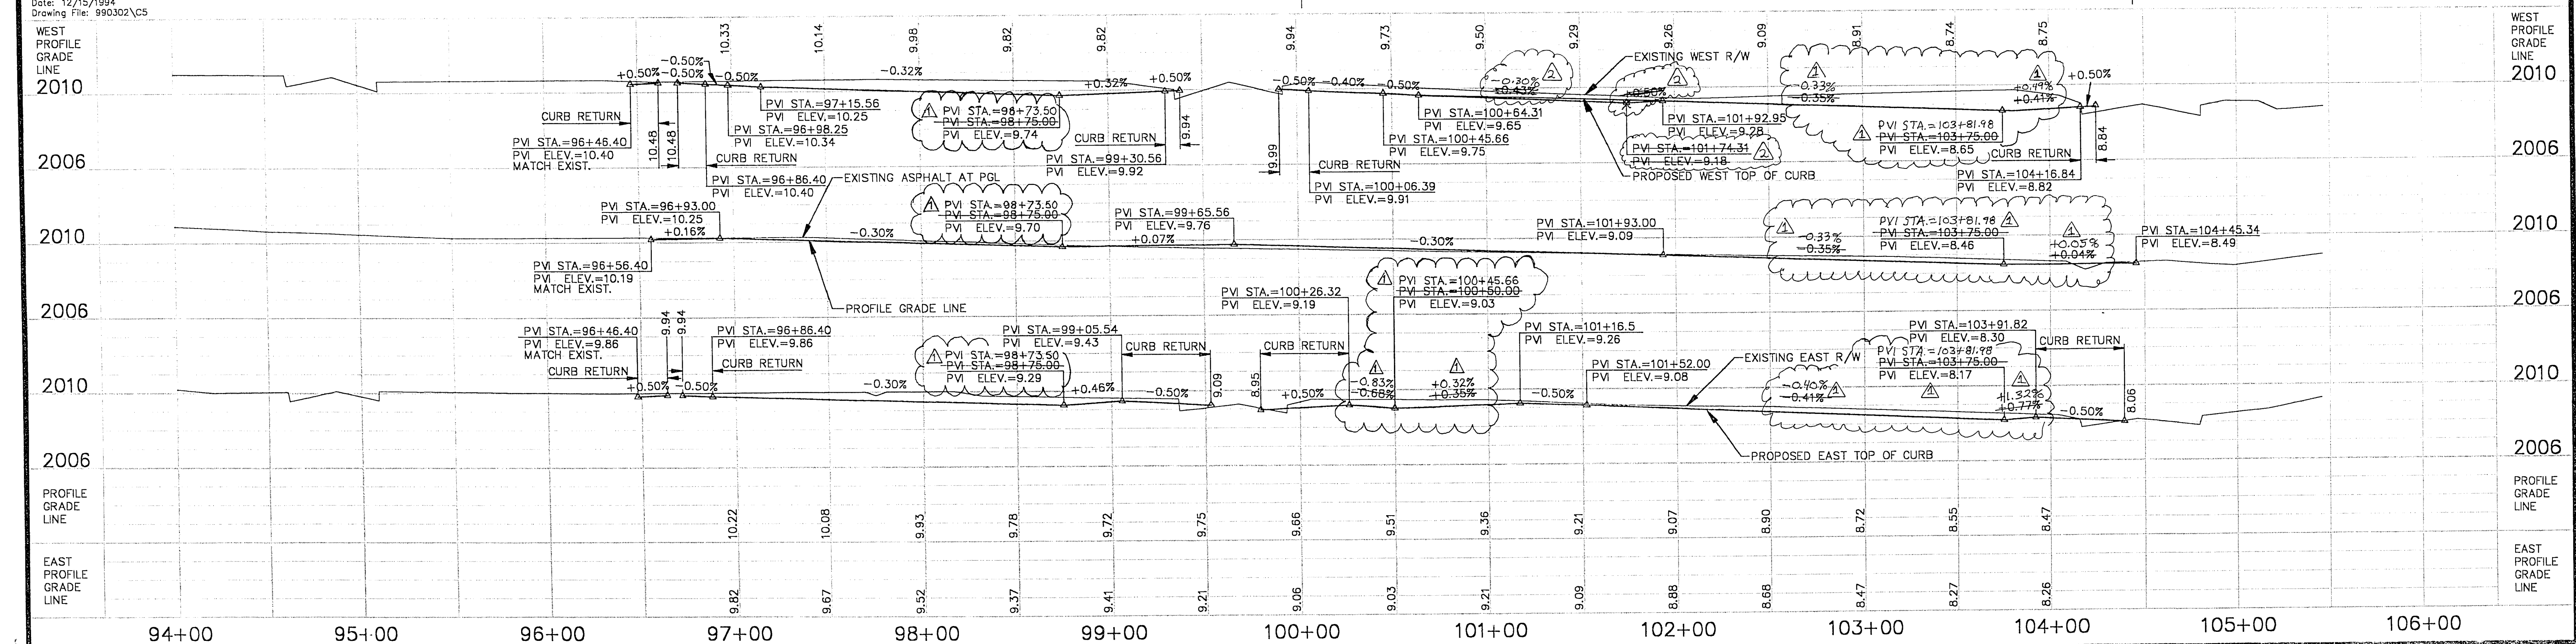


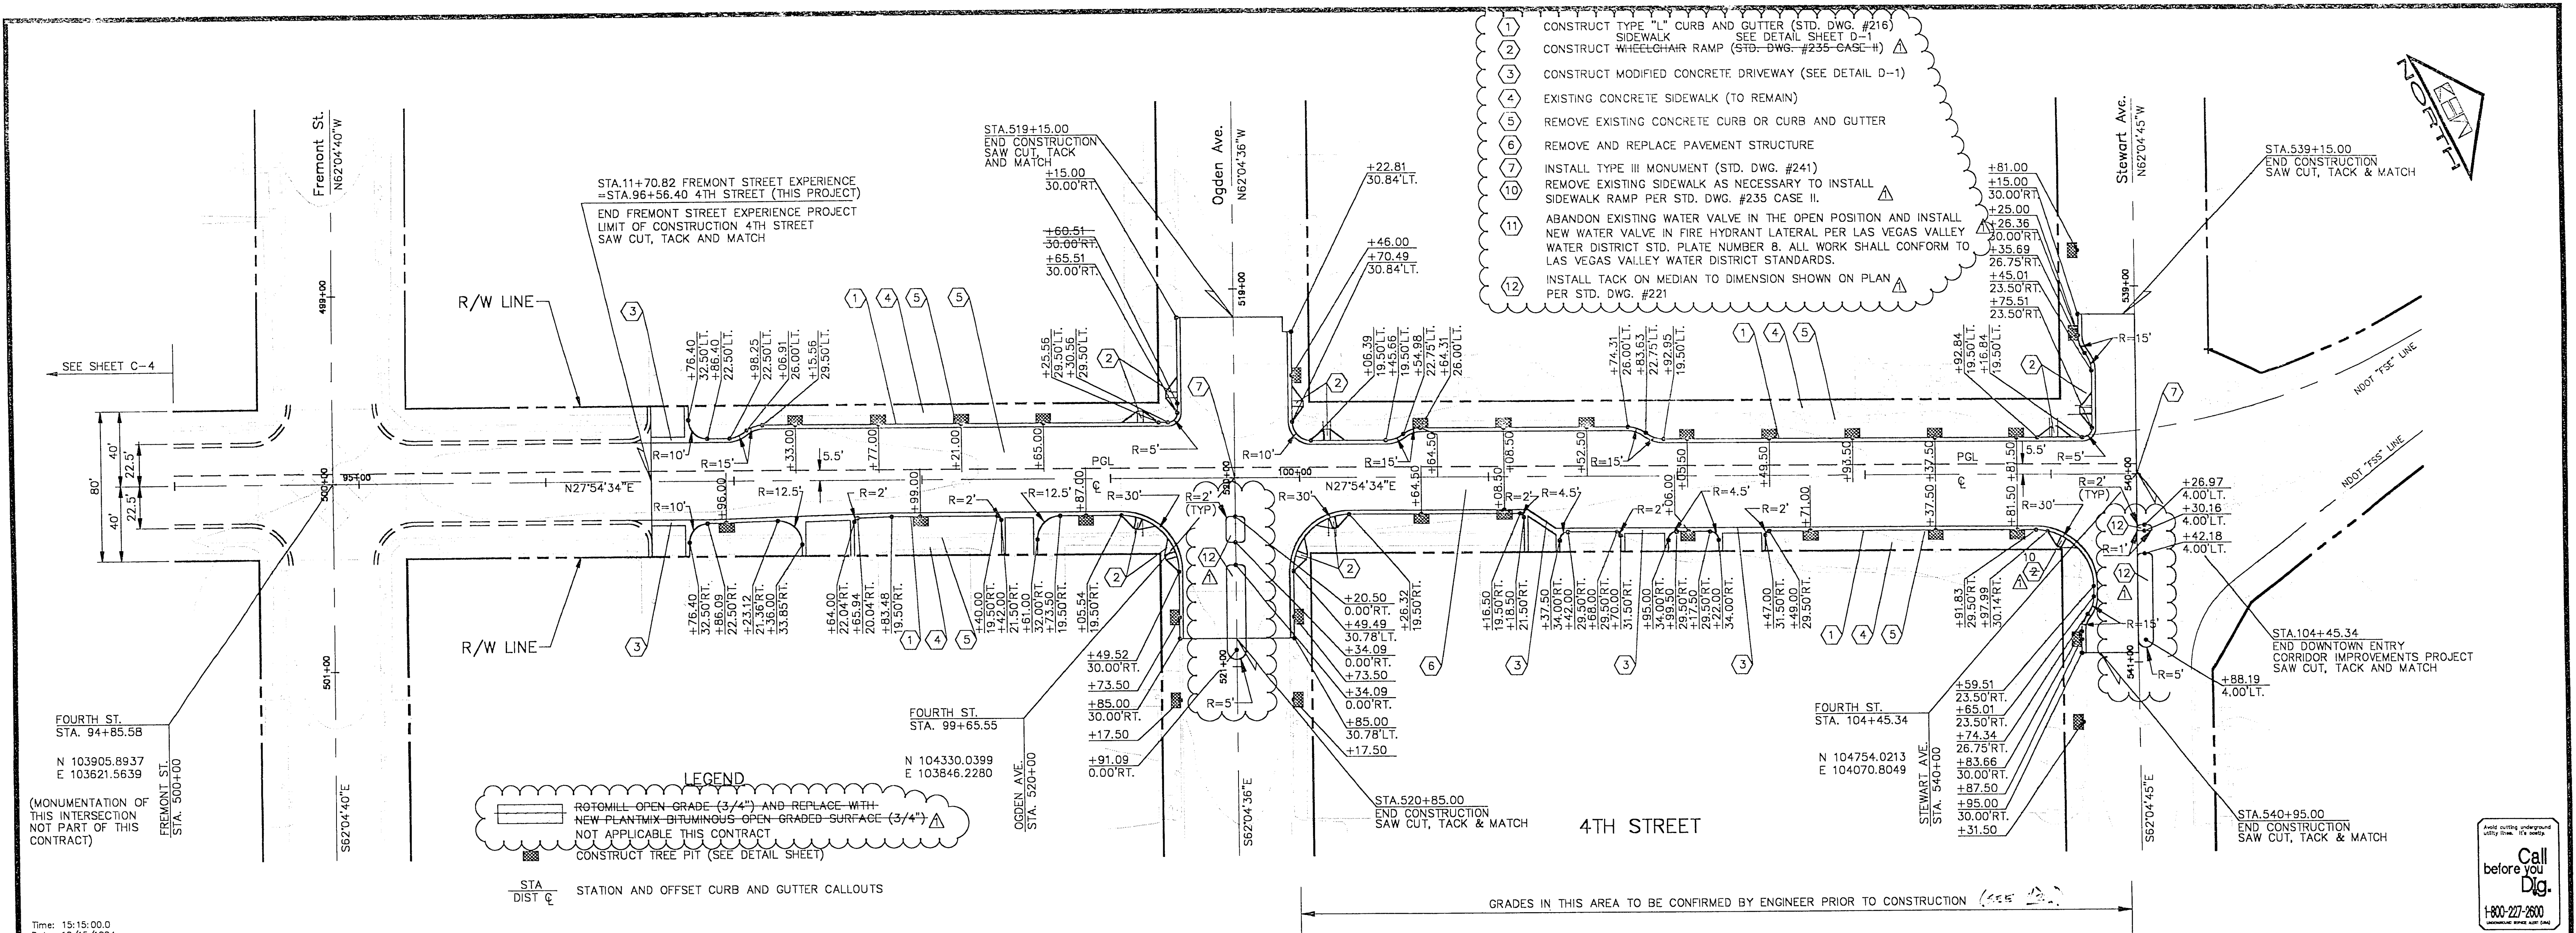

NO.

REVISIONS

DATE

BY

1/31/95

12/13/94

1-16-95

1-16-95

Kimley-Horn
and Associates, Inc.

Las Vegas, Nevada

© 1994

DESIGNED BY

CRW

DRAWN BY

RKS

CHECKED BY

[Signature]

NOTE BOOK NO.

DOWNTOWN CORRIDOR IMPROVEMENTS

CITY OF LAS VEGAS DEPT. OF PUBLIC WORKS

LAS VEGAS, NEVADA

CONFIRMED

1-16-95

DATE

12/94

SCALE

H 1" = 40'

V 1" = 4'

DWG. NO.

107-V-2288

FILE NO.

9903.02

SHEET 11 of 51

C-5

20-A-60