


- NOTES
- 1 REMOVE EXISTING 4" x 10" OVAL STORM DRAIN AND PLUG REMAINING PIPE OPENINGS WITH CONCRETE.
 - 2 REMOVE EXISTING GRATE BASIN AND PLUG REMAINING CONNECTOR PIPE OPENINGS WITH CONCRETE.
 - 3 REMOVE AND RECONNECT EXISTING BUBBLER CATCH BASINS AND PLUG CONNECTOR PIPE OPENINGS WITH CONCRETE, AS DIRECTED BY ENGINEER.
 - 4 CONSTRUCT STORM DRAIN MANHOLE TYPE 1A PER C.L.V. STD. DWG. No. 404. SIZE - 4'.
 - 5 CONSTRUCT DROP INLET TYPE "A" PER C.L.V. STD. DWG. No. 411. SIZE-4' TRUNCATE LOCAL DEPRESSION AT HANDICAP RAMP, AS DIRECTED BY ENGINEER.
 - 6 EXISTING UNDERSIDEWALK DRAIN. CLEAR OBSTRUCTIONS TO DRAIN, AS DIRECTED BY THE ENGINEER.
 - 7 SEE SHEETS SD-6 AND SD-7 FOR CONNECTOR PIPE PROFILES.
 - 8 CONSTRUCT NDOT TYPE 3 INLET PER NDOT STD #R-4.3.1-(609), SIZE-4'.
 - 9 WATER MAIN RELOCATION, SEE SHEET SD-1 FOR DETAIL.
 - 10 CONCRETE ENCASEMENT, SEE SHEET SD-1 FOR DETAIL.
 - 11 REMOVE EXISTING CONCRETE OR BRICKWORK SEAL; CONNECT 18" STORM DRAIN TO EXISTING 18" STUB.
 - 12 ADJUST TO GRADE PER L.V.W.D. STD. PLATE #8

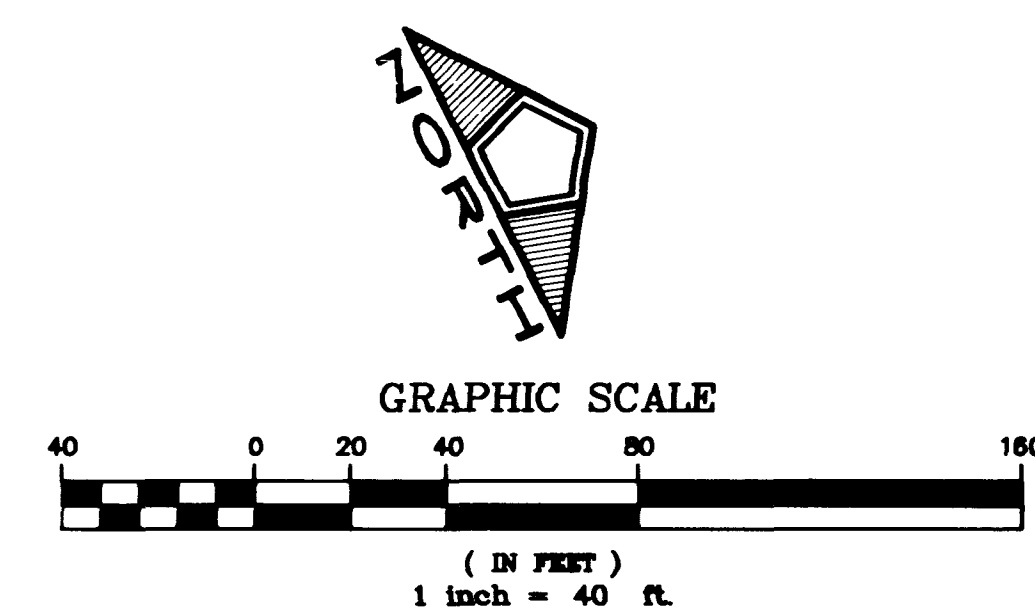

CAUTION



4TH STREET CONTAINS FIBER OPTIC TELEPHONE AND TELEVISION CABLES.

Avoid cutting underground utility lines. It's costly.

Call before you Dig.

1-800-227-2600

UNDERGROUND SERVICE ALERT (USA)

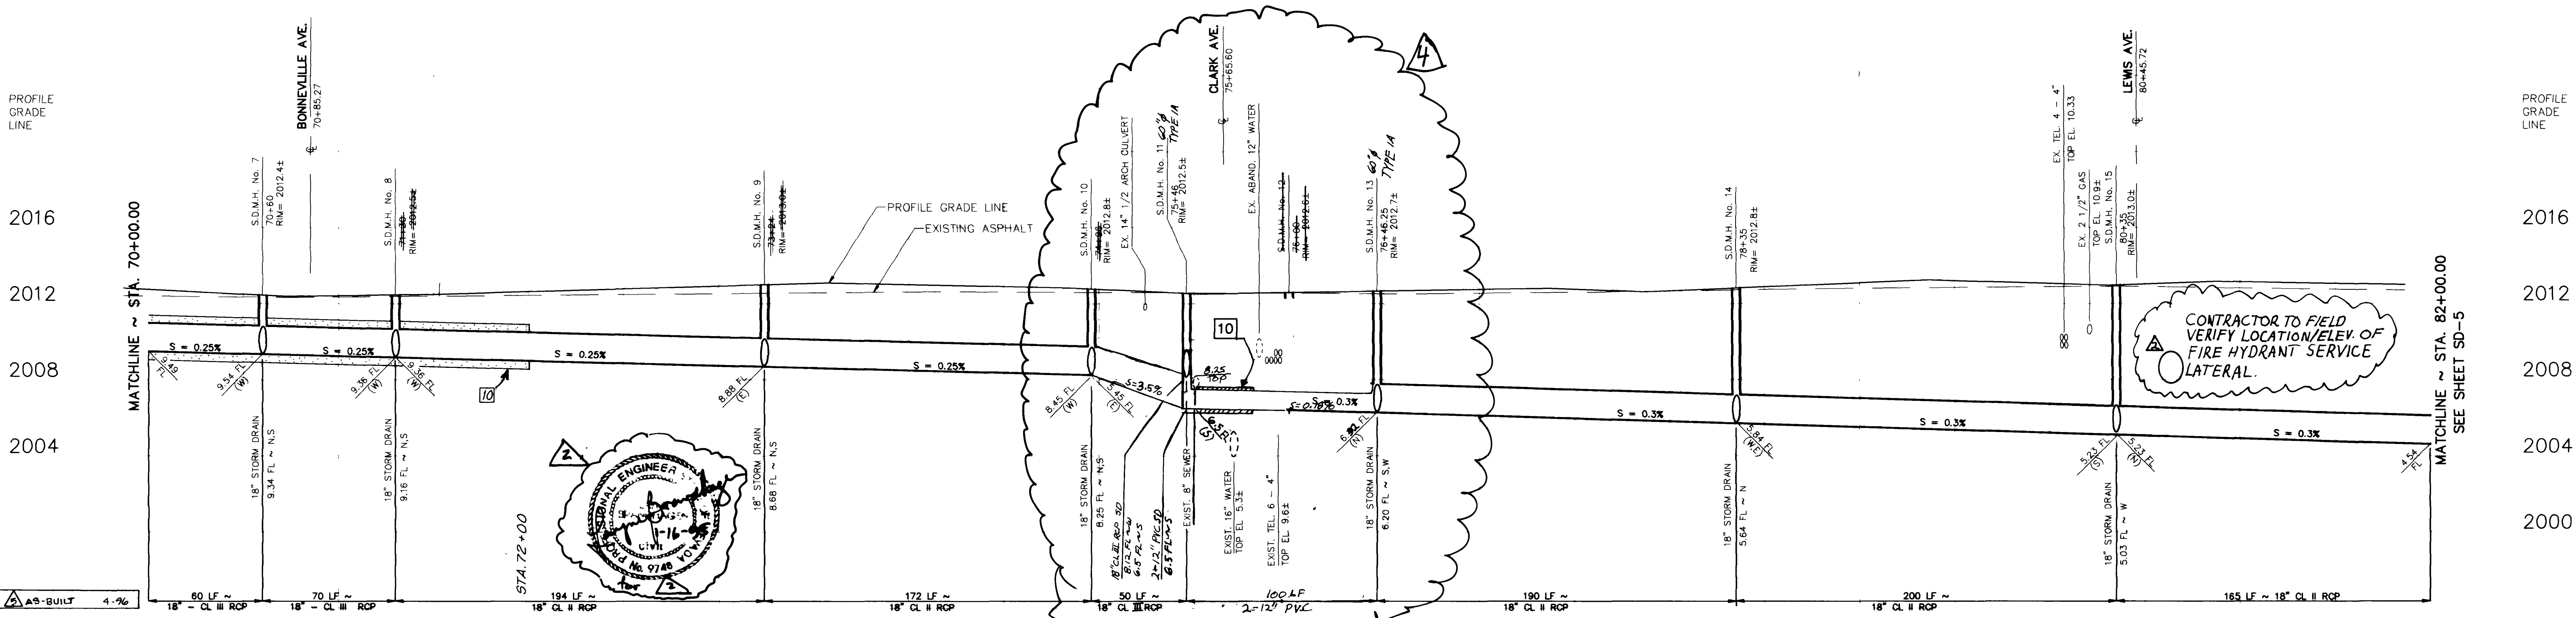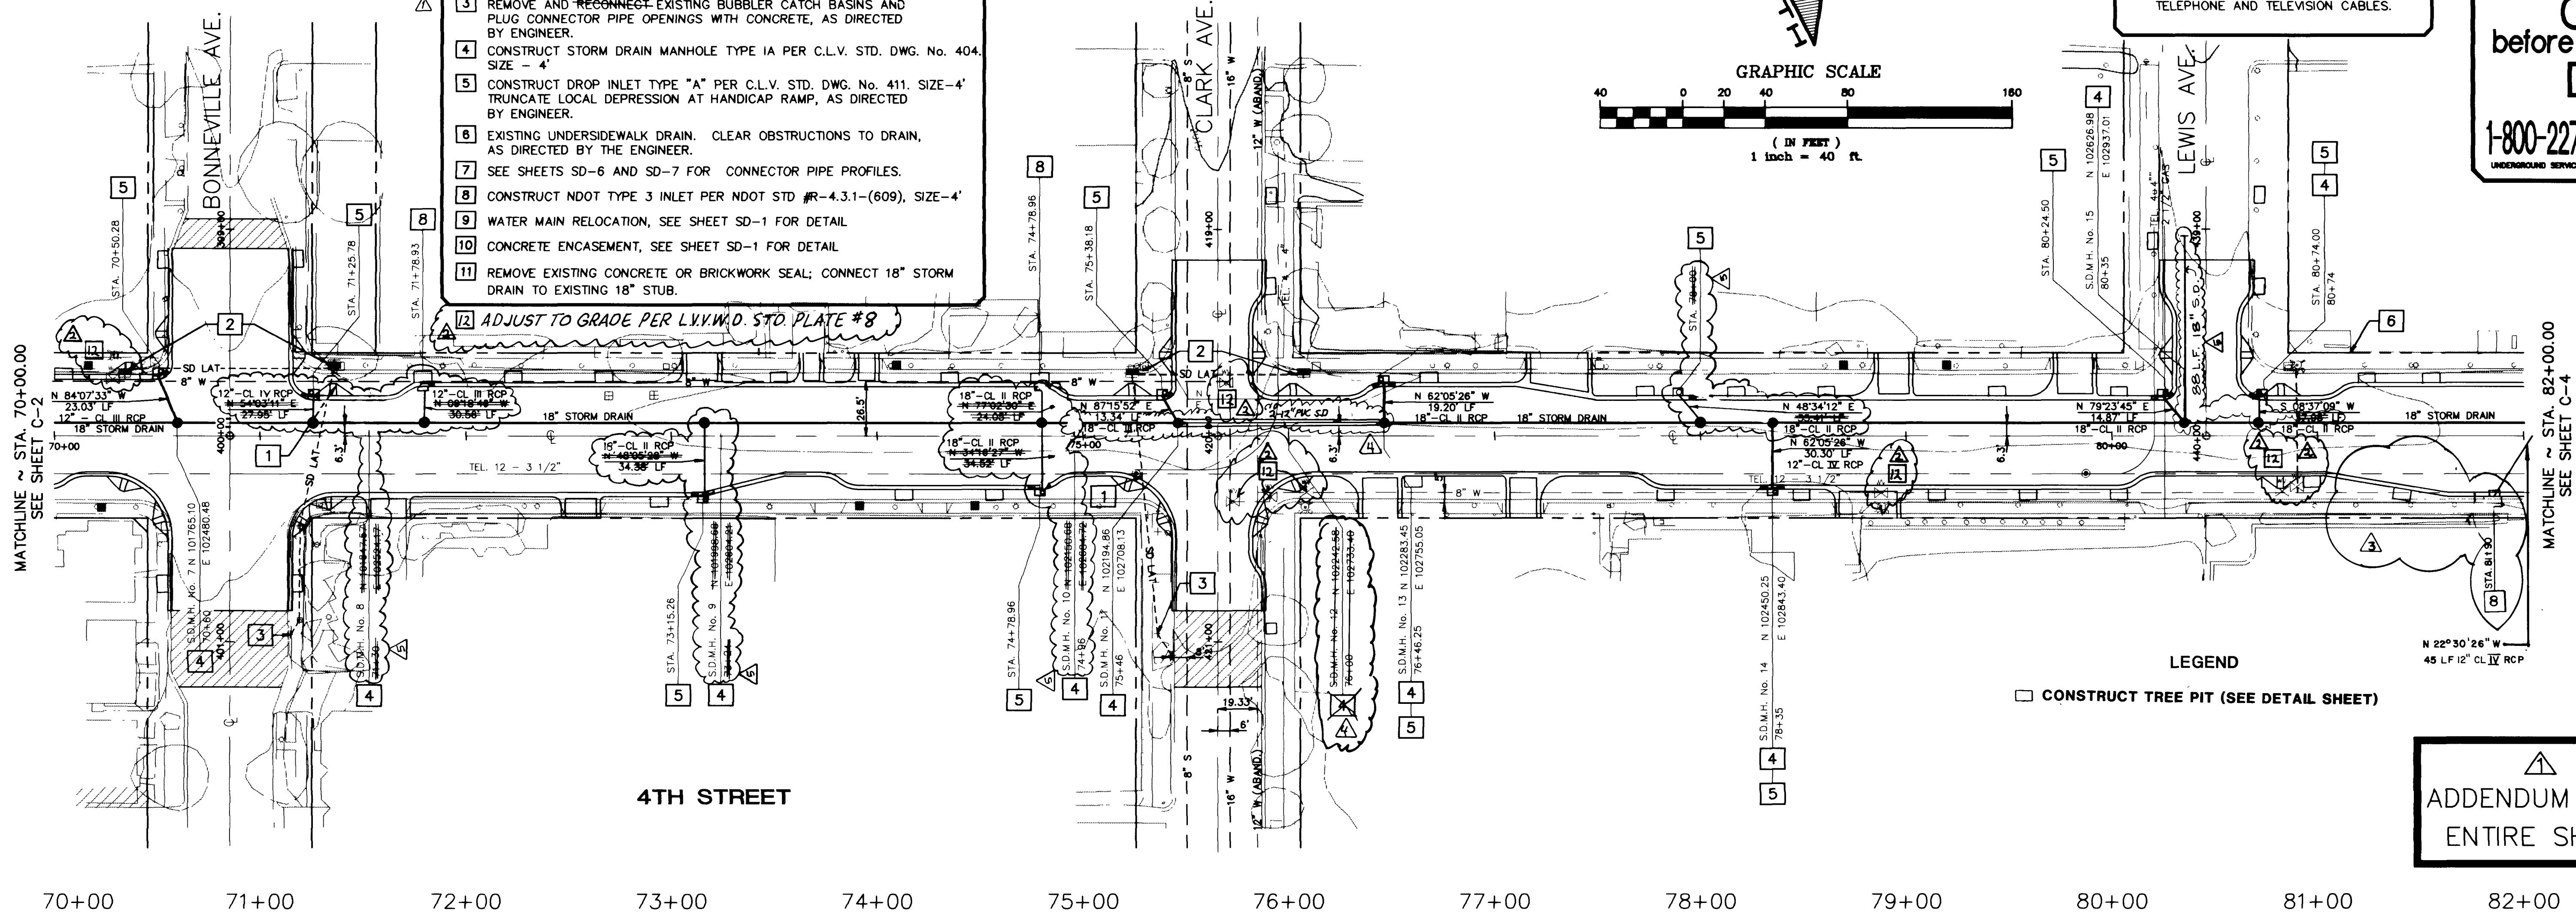

REVISION NO. 1, ISSUED AS ADDENDUM NO. 1, ENTIRE SHEET. THIS REVISION MODIFIES NOTES, ADD CLASS III RCP AND CLASS IV RCP IN PROFILE, ADD .2 FT DROP WITH CONNECTOR PIPE, INVERTS.	12-10-94	DBB
PER L.V.W.D. REVIEW	1-13-95	DBB
REVISION 3, ISSUED AS C.C.O., ADDS NDOT TYPE 3 CB AND CONNECTOR PIPE @ STA 81+1.90.	1-31-95	DBB
NO.	REVISIONS	DATE BY

DESIGNED BY	DBB
DRAWN BY	KOZ
CHECKED BY	
NOTE BOOK NO.	

6763 West Charleston Boulevard Las Vegas, Nevada 89102	Engineering, Inc. (702) 258-0115
---	-------------------------------------

City of Las Vegas NEVADA	DOWNTOWN CORRIDOR IMPROVEMENTS CITY OF LAS VEGAS DEPT. OF PUBLIC WORKS LAS VEGAS, NEVADA
-----------------------------	--

Call Form 1-16-95 DATE 12/05/94	SCALE: HORIZ: 1" = 40' VERT: 1" = 4'
------------------------------------	--

DWG. NO. 107-V-2286	FILE NO. 0135.0105	SHEET 21 of 51
SD-4		

20-2-70

