


HARDSCAPE SURFACE TREATMENTS


HARDSCAPE DESCRIPTION	
1	NATURAL GREY CONCRETE WITH LIGHT BROOM FINISH AND TOOLED JOINTS AS SHOWN.
2	INTEGRALLY COLORED (LIGHT BUFF), TOOLED, AND TROUELED CONCRETE WITH A LIGHT BROOM FINISH. REF. 1/2, AND 3/D-2.
3	INTEGRALLY COLORED (LIGHT PINK), PRE-CAST 12' x 12' CONCRETE PAVERS ON A CONCRETE SUB-BASE. REF. 1/D-5.
4	DECORATIVE VERGE TREATMENT OF INTEGRALLY COLORED (LIGHT BUFF) CONCRETE WITH A HEAVY SANDBLAST FINISH (UTILIZING A PRE-CUT PATTERN TEMPLATE) REF. 1/D-4.
5	INTEGRALLY COLORED (DARK BUFF) CONCRETE SIDEWALK RAMP. REF. 1/D-5.
6	INTEGRALLY COLORED (LIGHT PINK) PRECAST 12' x 12' CONCRETE PAVERS ON A CONCRETE SUB-BASE. REF. 4 AND 5/D-2.
7	TIE INTO EXISTING PAVING (SIDEWALK, BUILDING ACCESS, ETC.) THIS TIE-IN SHALL MATCH WIDTH AND GRADE OF EXISTING HARDSCAPE.

Sym.	Common Name	Size/Remarks
MISC.		
NB	NATIVE SANDSTONE BOULDERS	2' x 2' x 2' +/-
⊙	PRE-CAST CONCRETE BENCHES	REF. SPECS
⊙	PRE-CAST CONCRETE TRASH CANS	REF. SPECS
R1	PLANT ABBREVIATION (Typ.)	
12	PLANT QUANTITY (Typ.)	
S	EXISTING SINGLE-HEAD PARKING METER	
D	EXISTING DOUBLE-HEAD PARKING METER	
⊠	5' x 10' TREE GRATE (REF. DETAIL 3/D-3)	
⊠	5' x 5' TREE GRATE (REF. DETAIL 1/D-3)	

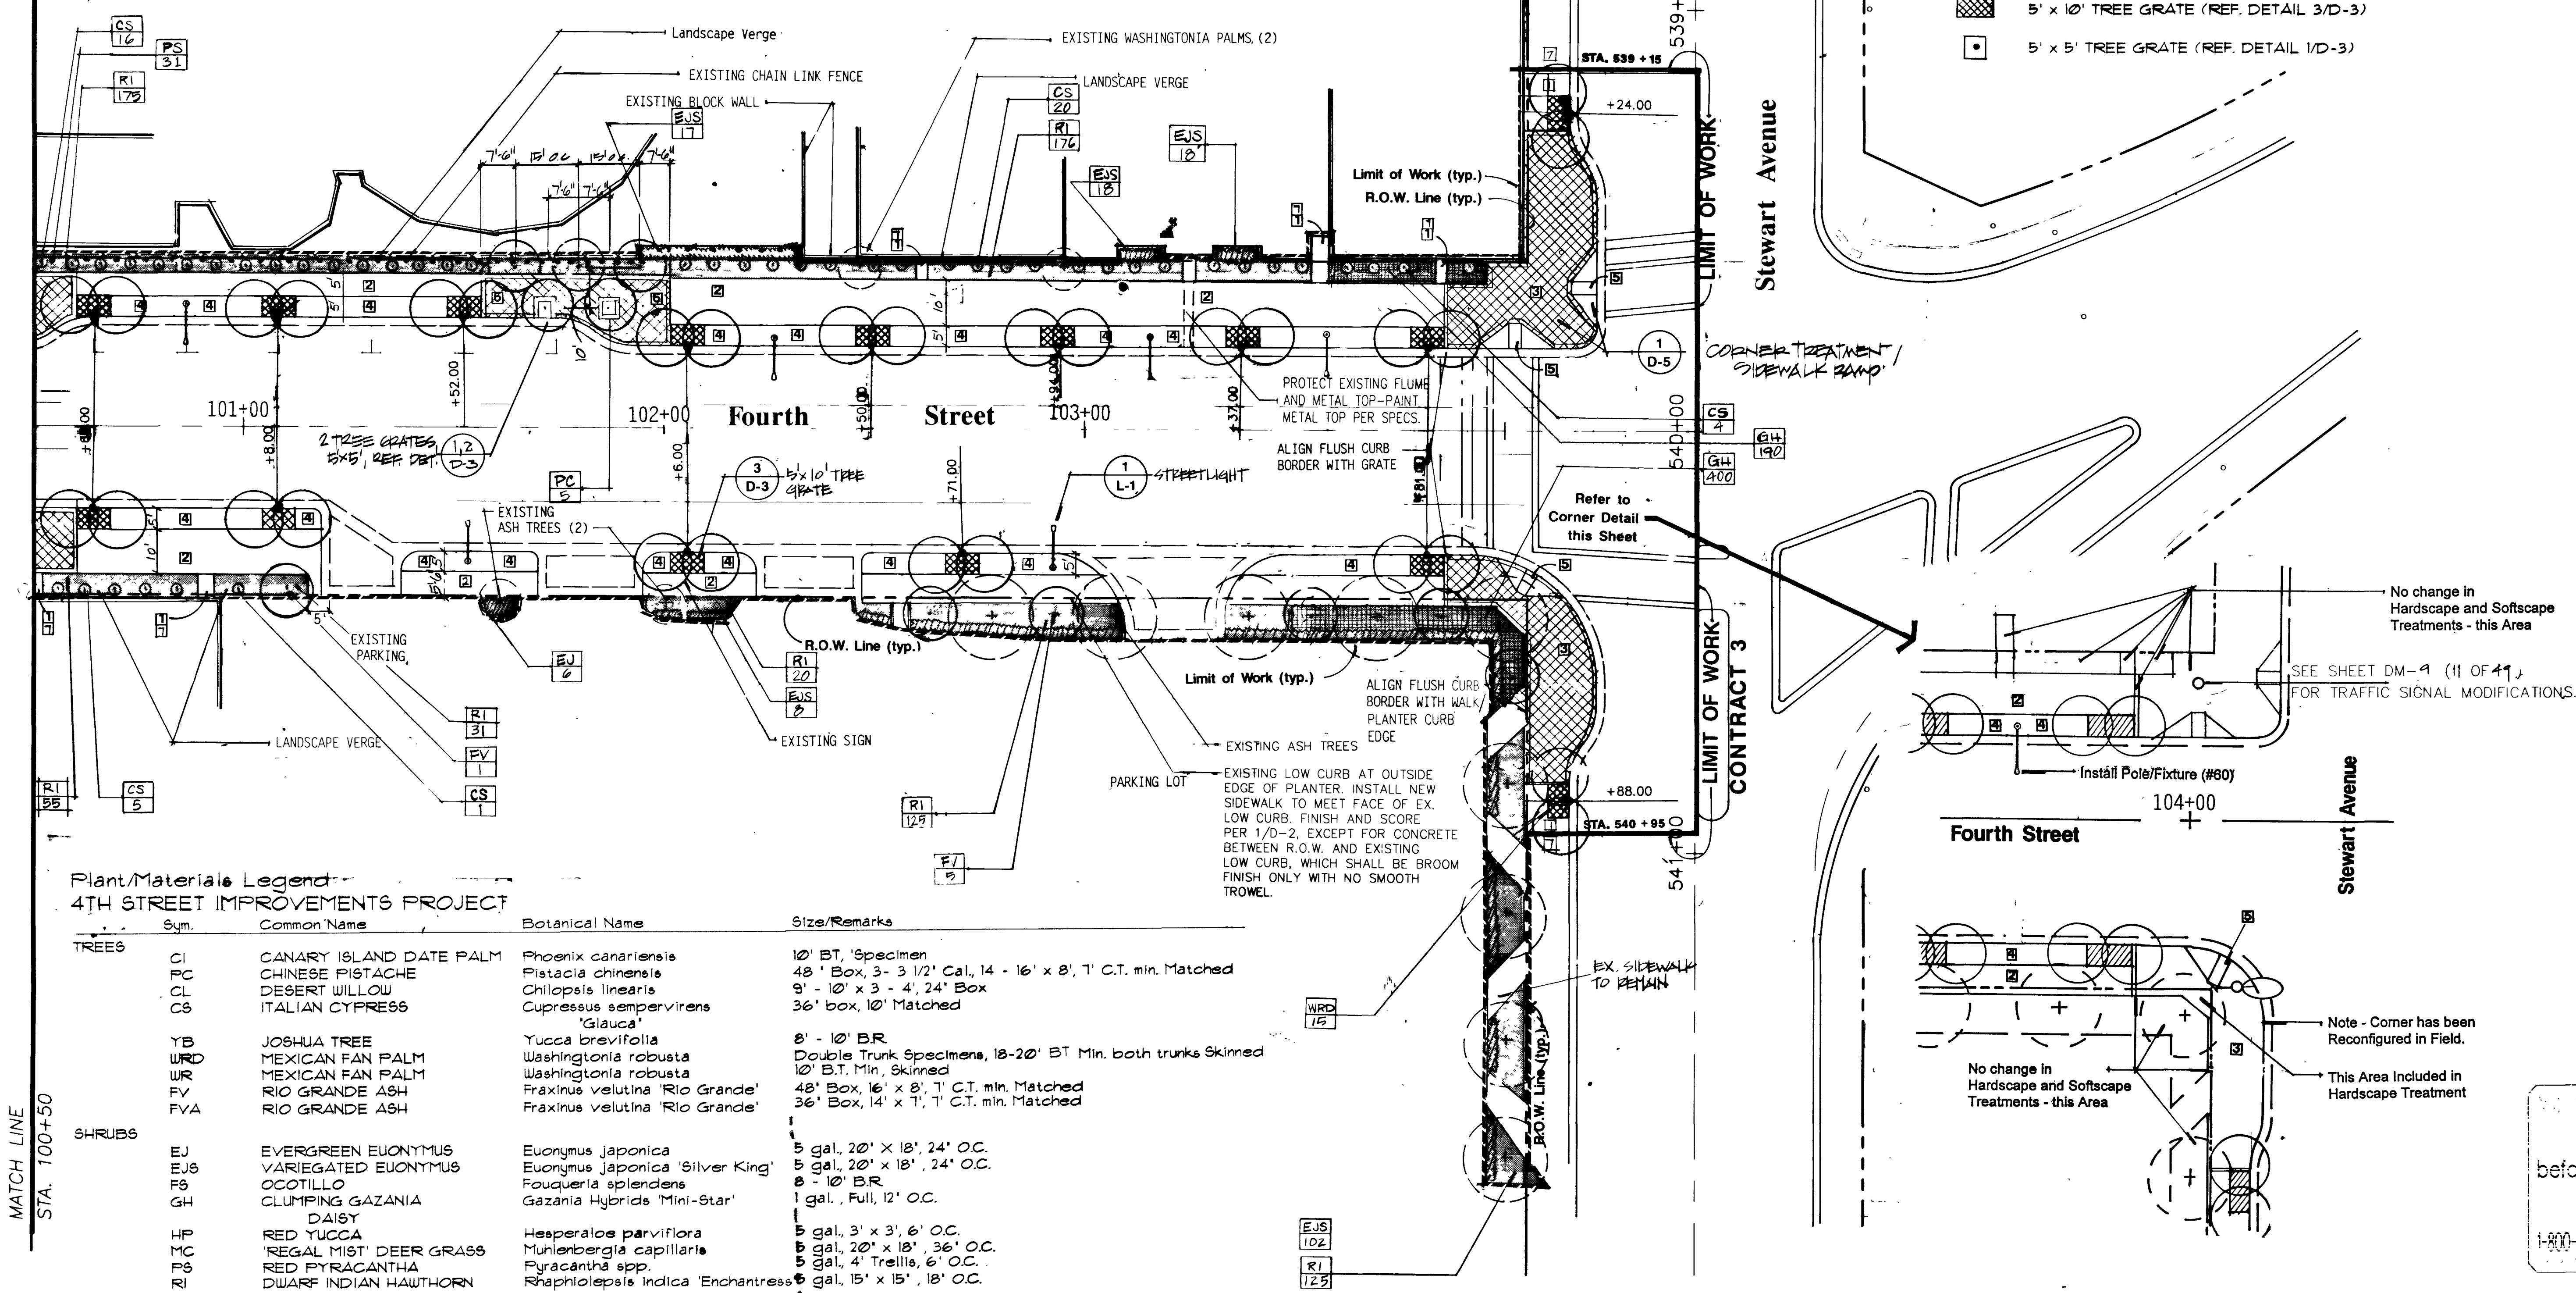

Plant/Materials Legend  
4TH STREET IMPROVEMENTS PROJECT

Sym.	Common Name	Botanical Name	Size/Remarks
<b>TREES</b>			
CI	CANARY ISLAND DATE PALM	Phoenix canariensis	10' BT, Specimen
PC	CHINESE PISTACHE	Pistacia chinensis	48" Box, 3 - 3 1/2' Cal, 14 - 16' x 8', 1' C.T. min. Matched
CL	DESERT WILLOW	Chilopsis linearis	9' - 10' x 3 - 4', 24" Box
CS	ITALIAN CYPRRESS	Cupressus sempervirens 'Glauc'	36" box, 10' Matched
YB	JOSHUA TREE	Yucca brevifolia	8' - 10' BR
WRD	MEXICAN FAN PALM	Washingtonia robusta	Double Trunk Specimens, 18-20' BT Min. both trunks Skinned
WR	MEXICAN FAN PALM	Washingtonia robusta	10' BT Min. Skinned
FV	RIO GRANDE ASH	Fraxinus velutina 'Rio Grande'	48" Box, 16' x 8', 1' C.T. min. Matched
FVA	RIO GRANDE ASH	Fraxinus velutina 'Rio Grande'	36" Box, 14' x 7', 1' C.T. min. Matched
<b>SHRUBS</b>			
EJ	EVERGREEN EUONYMUS	Euonymus japonica	5 gal, 20" x 18", 24" OC.
EJS	VARIEGATED EUONYMUS	Euonymus japonica 'Silver King'	5 gal, 20" x 18", 24" OC.
F8	OCOTILLO	Fouquieria splendens	8 - 10' BR
GH	CLUMPING GAZANIA	Gazania Hybrida 'Mini-Star'	1 gal., Full, 12" OC.
DAISY	DAISY		
HP	RED YUCCA	Hesperaloe parviflora	5 gal, 3' x 3', 6" OC.
MC	'REGAL MIST' DEER GRASS	Muhlenbergia capillaris	5 gal, 20" x 18", 36" OC.
PS	RED PYRACANTHA	Pyracantha spp.	5 gal, 4' Trellis, 6" OC.
RI	DWARF INDIAN HAWTHORN	Raphiolepis indica 'Enchantress'	5 gal, 15" x 15", 18" OC.

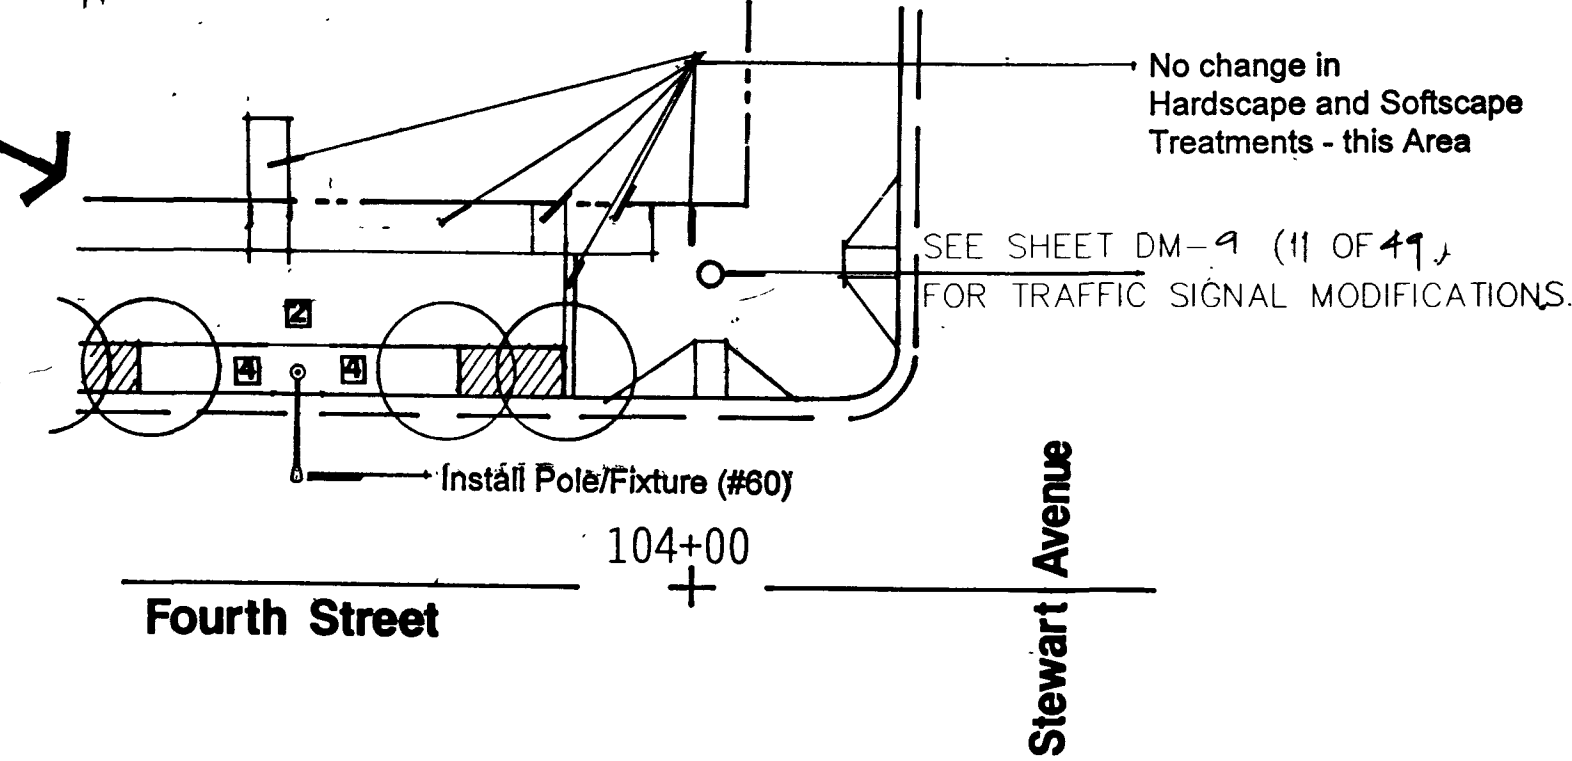

Call before you Dig.  
1-800-227-2600

		DESIGNED BY:		DOWNTOWN CORRIDOR IMPROVEMENTS	DATE 9/1/95 SCALE 1"=20' CONTRACT 3 - 4TH STREET (CHARLES DIN BLVD) TO STEWART AVE	HARDSCAPE LAYOUT PLAN (WITH LANDSCAPE) STA. 100+50 TO STA. 104+46	FILE NO. 107-V-2288 A HS-9 20 of 49
		DRAWN BY:		CITY OF LAS VEGAS DEPT. OF PUBLIC WORKS			
		CHECKED BY:		LAS VEGAS, NEVADA			
		NOTE BOOK NO:					

