



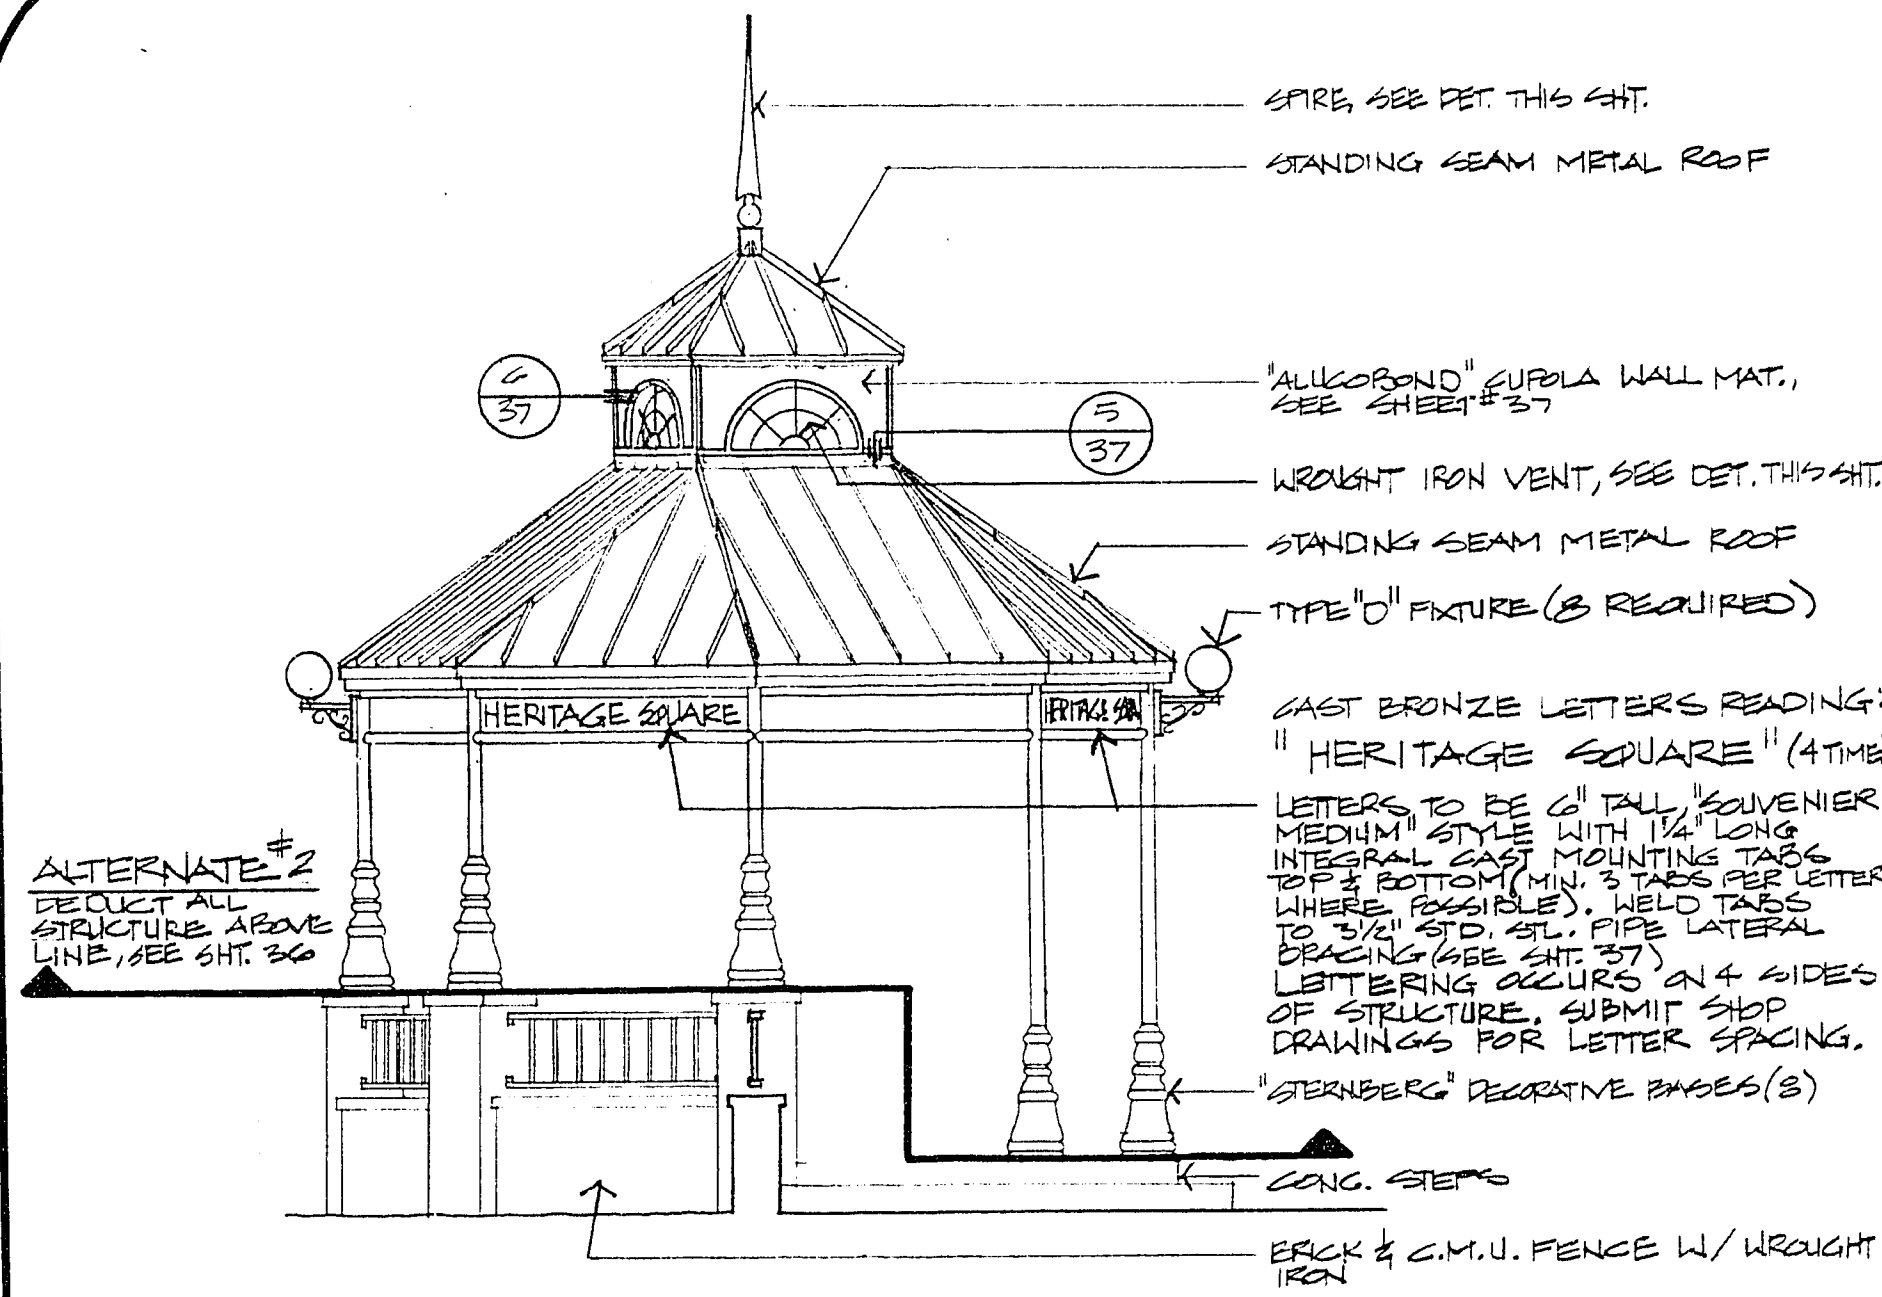


ELEVATION
1/4" = 1'-0"

ALTERNATE #2 NOTE:
SUB & GAF ALL UTILITIES FOR FUTURE CONNECTIONS

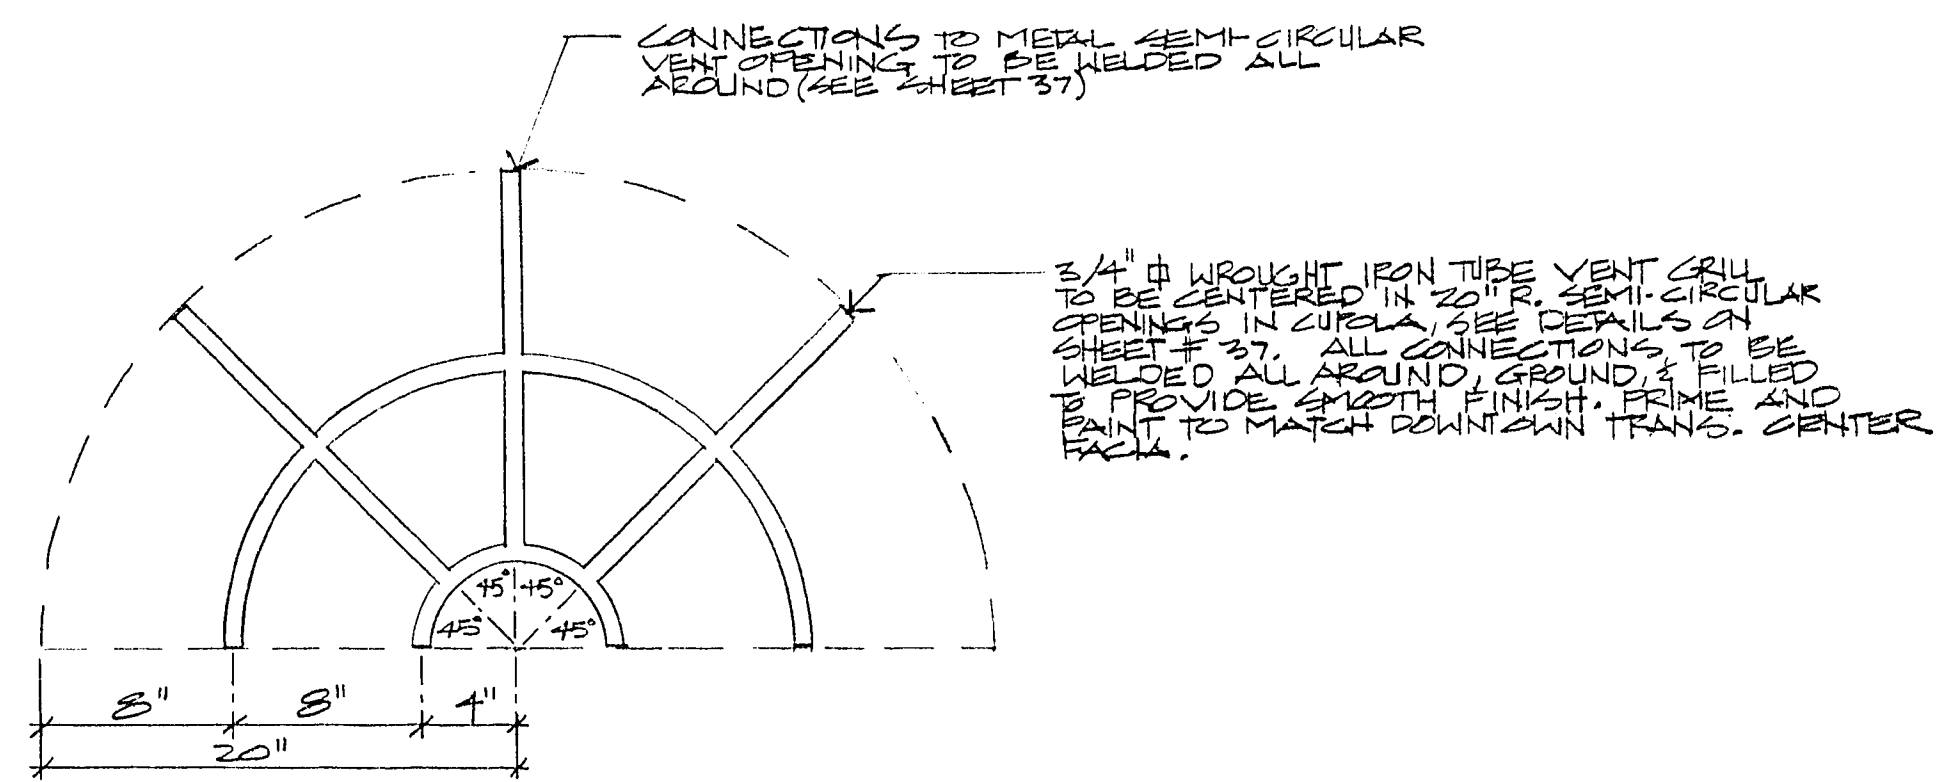

WROUGHT IRON VENT GRILL DETAIL
1/2" = 1'-0"

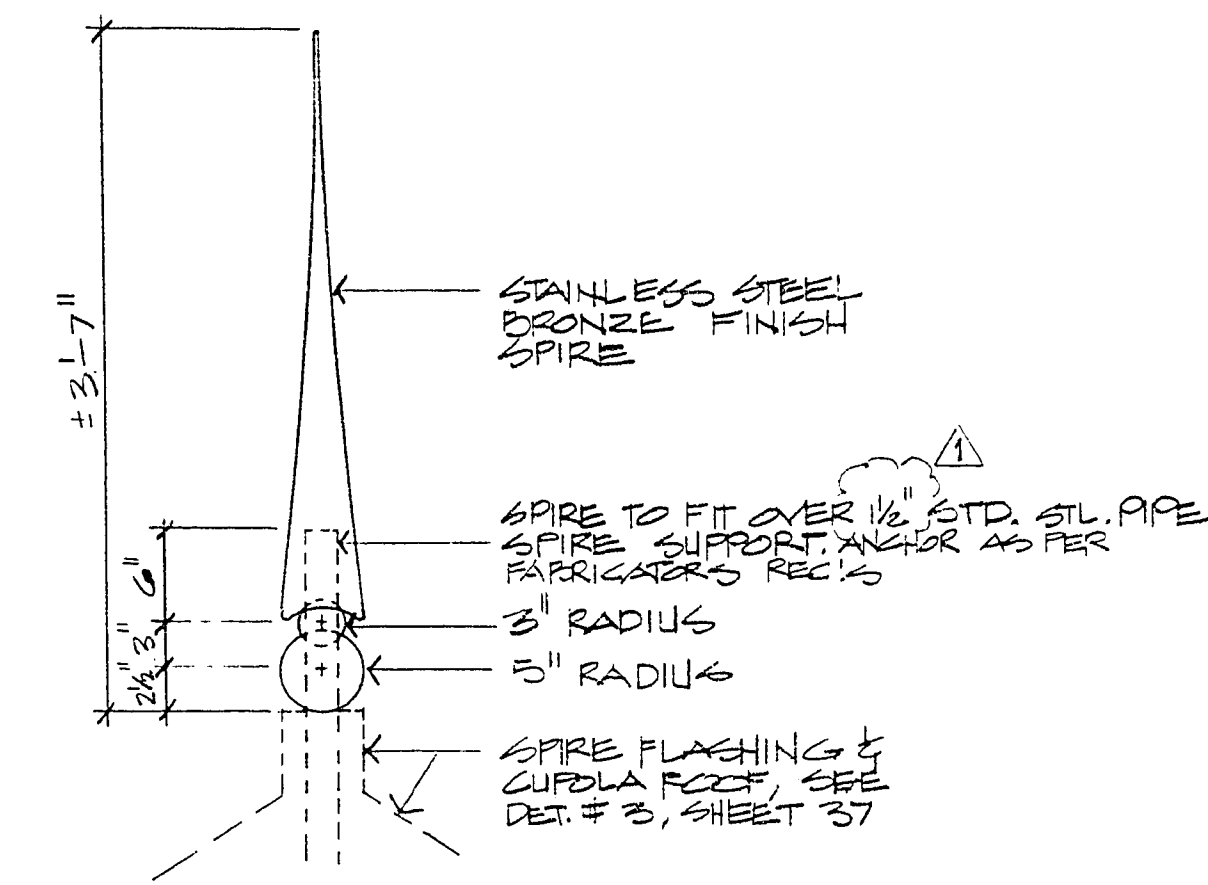


SPIRE DETAIL
1" = 1'-0"

WROUGHT IRON ON FENCE
SEE SHEET # 37
BRICK & C.M.U. FENCE,
SEE SHEET # 36

BENCH (SEE SPEC'S)
ANCHOR AS PER MFR. REQ'S EXCEPT USE THEFT PROOF BREAK-AWAY NUTS, PAINTED BLACK, INSTEAD OF ACORN NUTS

PAVERS (60 MM THK.)
1" MAX. SAND BED
4" THK. CONC. SLAB
SEE SHEET # 36
1" WIDE CONC. APRON (7" EXPOSED)

1 BENCH MOUNTING
NO SCALE

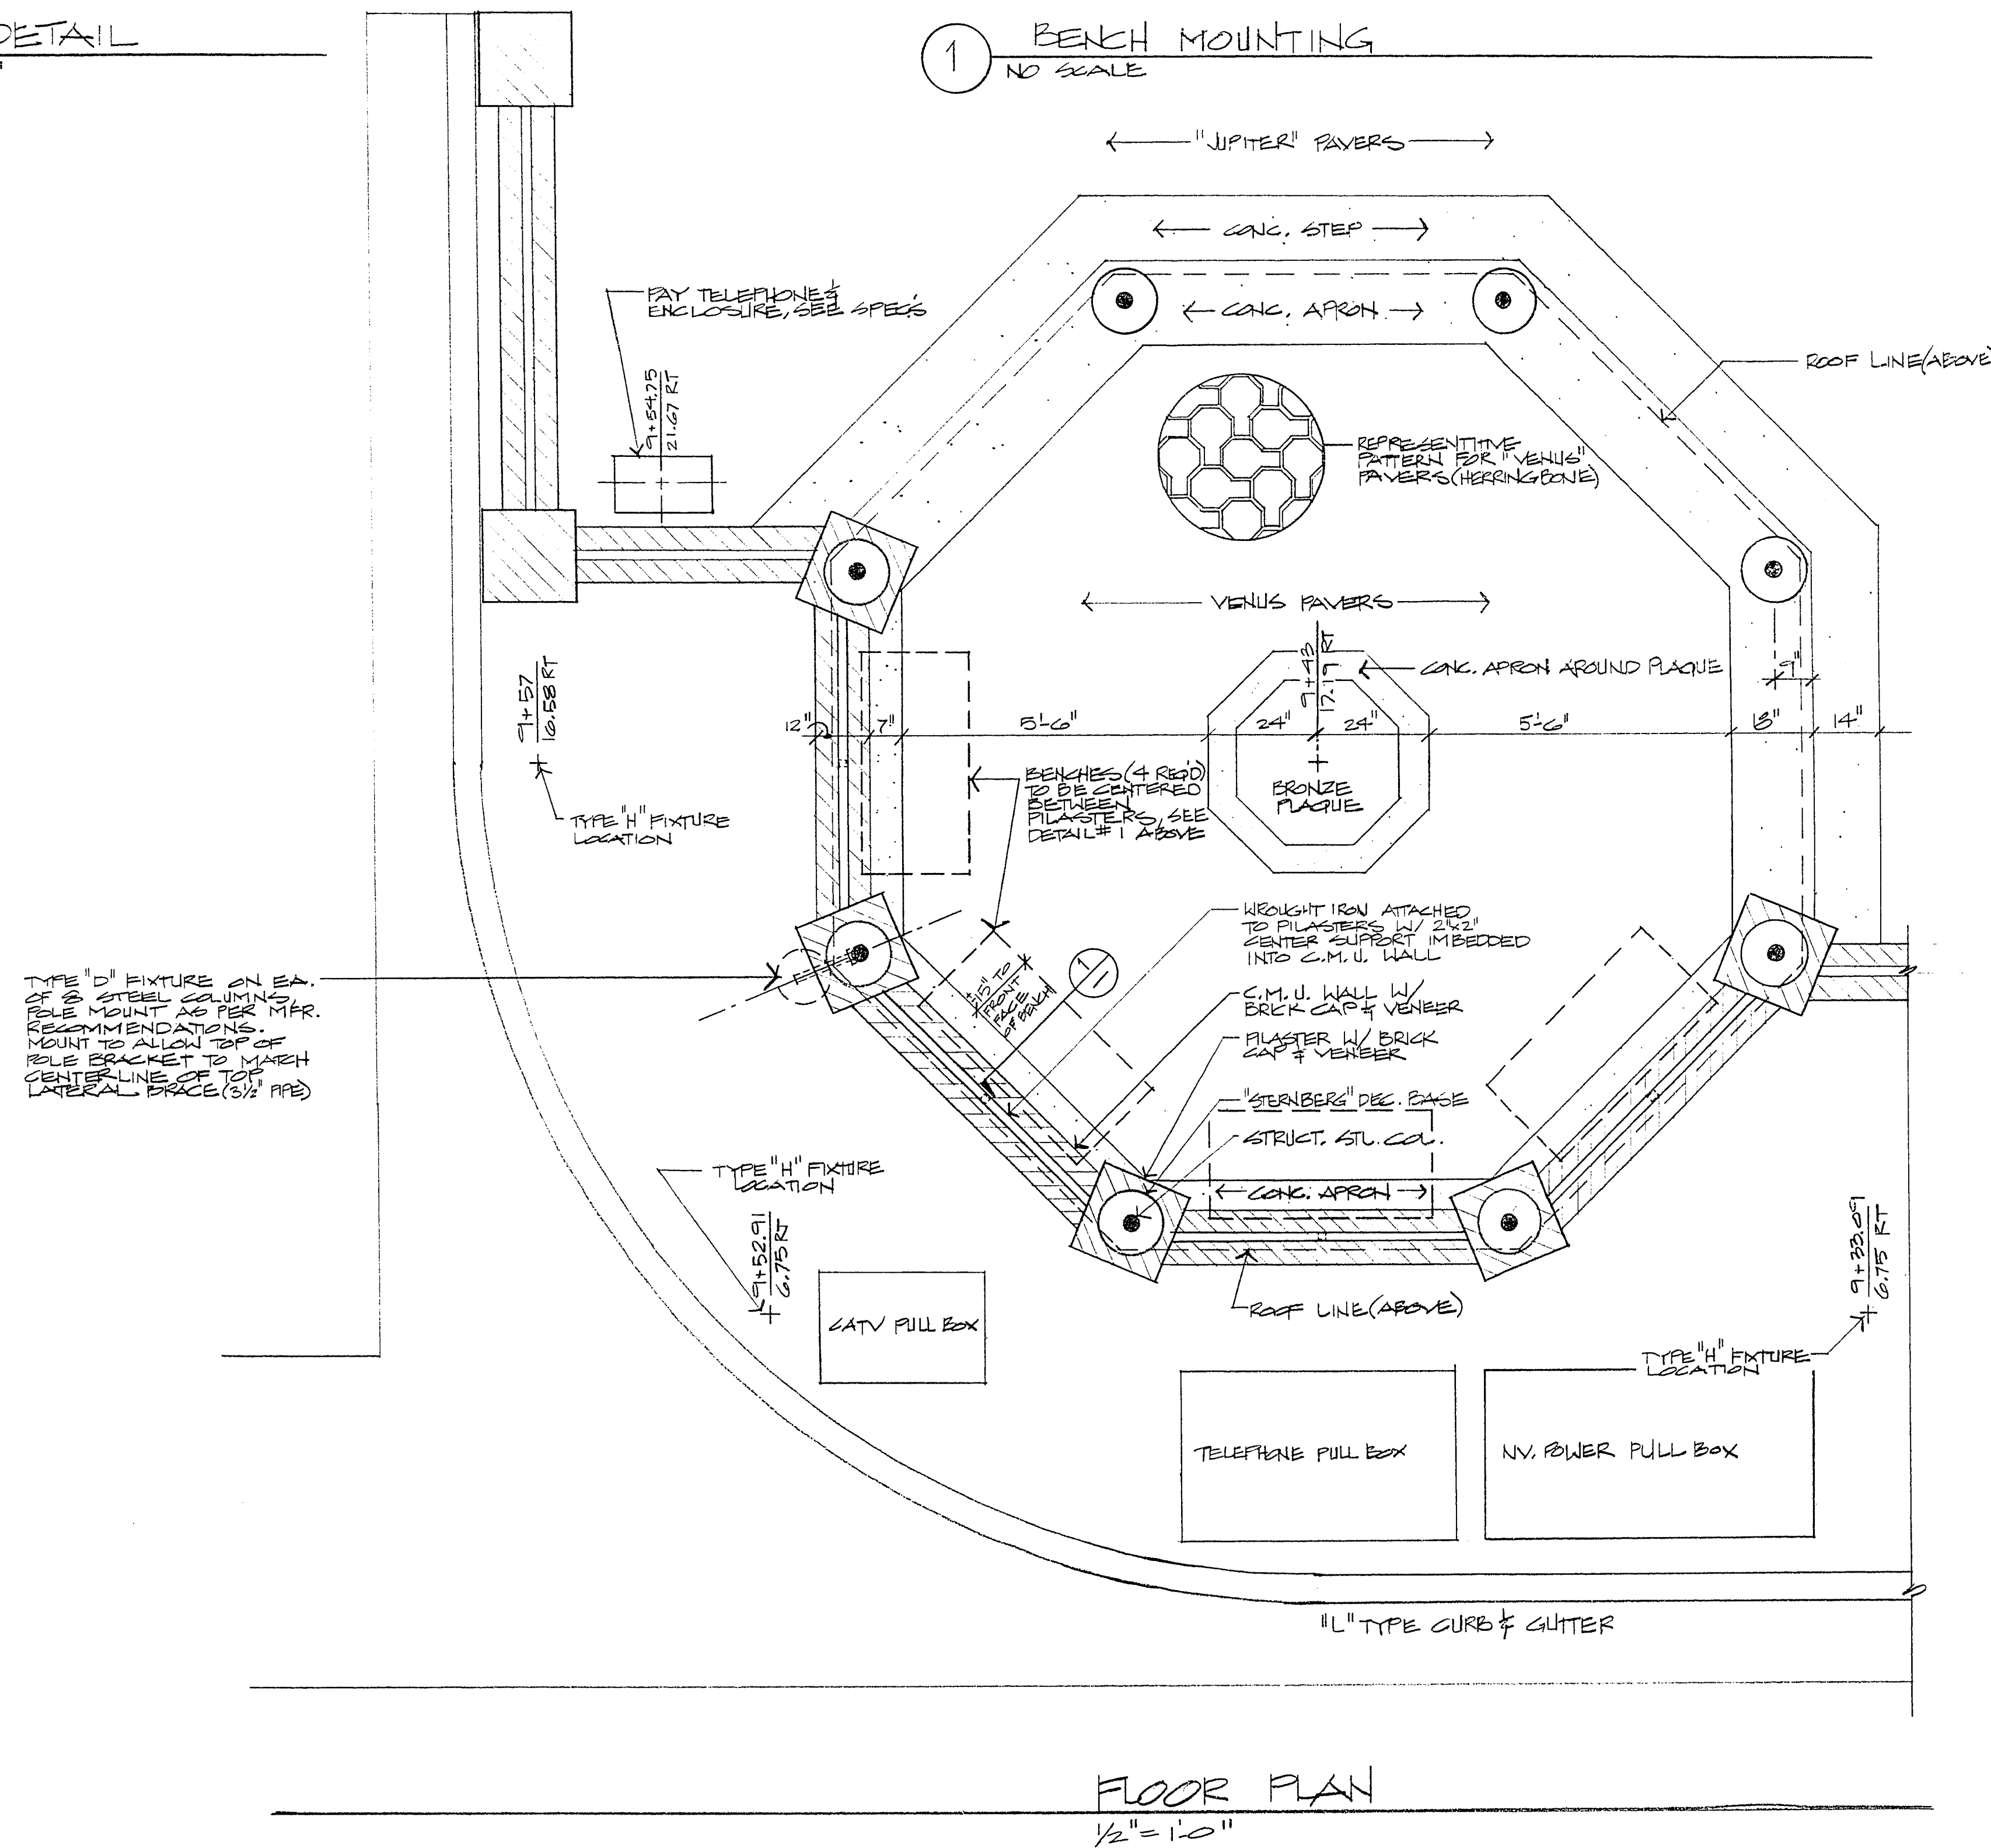


FLOOR PLAN
1/2" = 1'-0"



City of Las Vegas, Nevada
Department of Design and Development
Thomas B. Graham, AICP, RIA, Director
DESIGN BY: WALLACE
DRAWN BY: JACOB
SCALE: AS SHOWN
DATE: 4/2/85

REVISIONS	DATE
REVISED 2" STD. PIPE TO 1 1/2" STD. PIPE	5/15/86

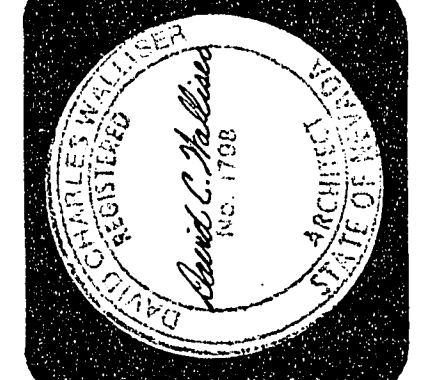

GAZEBO FLOOR PLAN, ELEVATIONS & DETAILS
BANDIAN TRANSPORTATION CENTER
OFF-SITE IMPROVEMENTS

PROJECT NO. 86-1715-14
DRAWING NO. 590-2E
SHEET 35 OF 51

30-13-85