

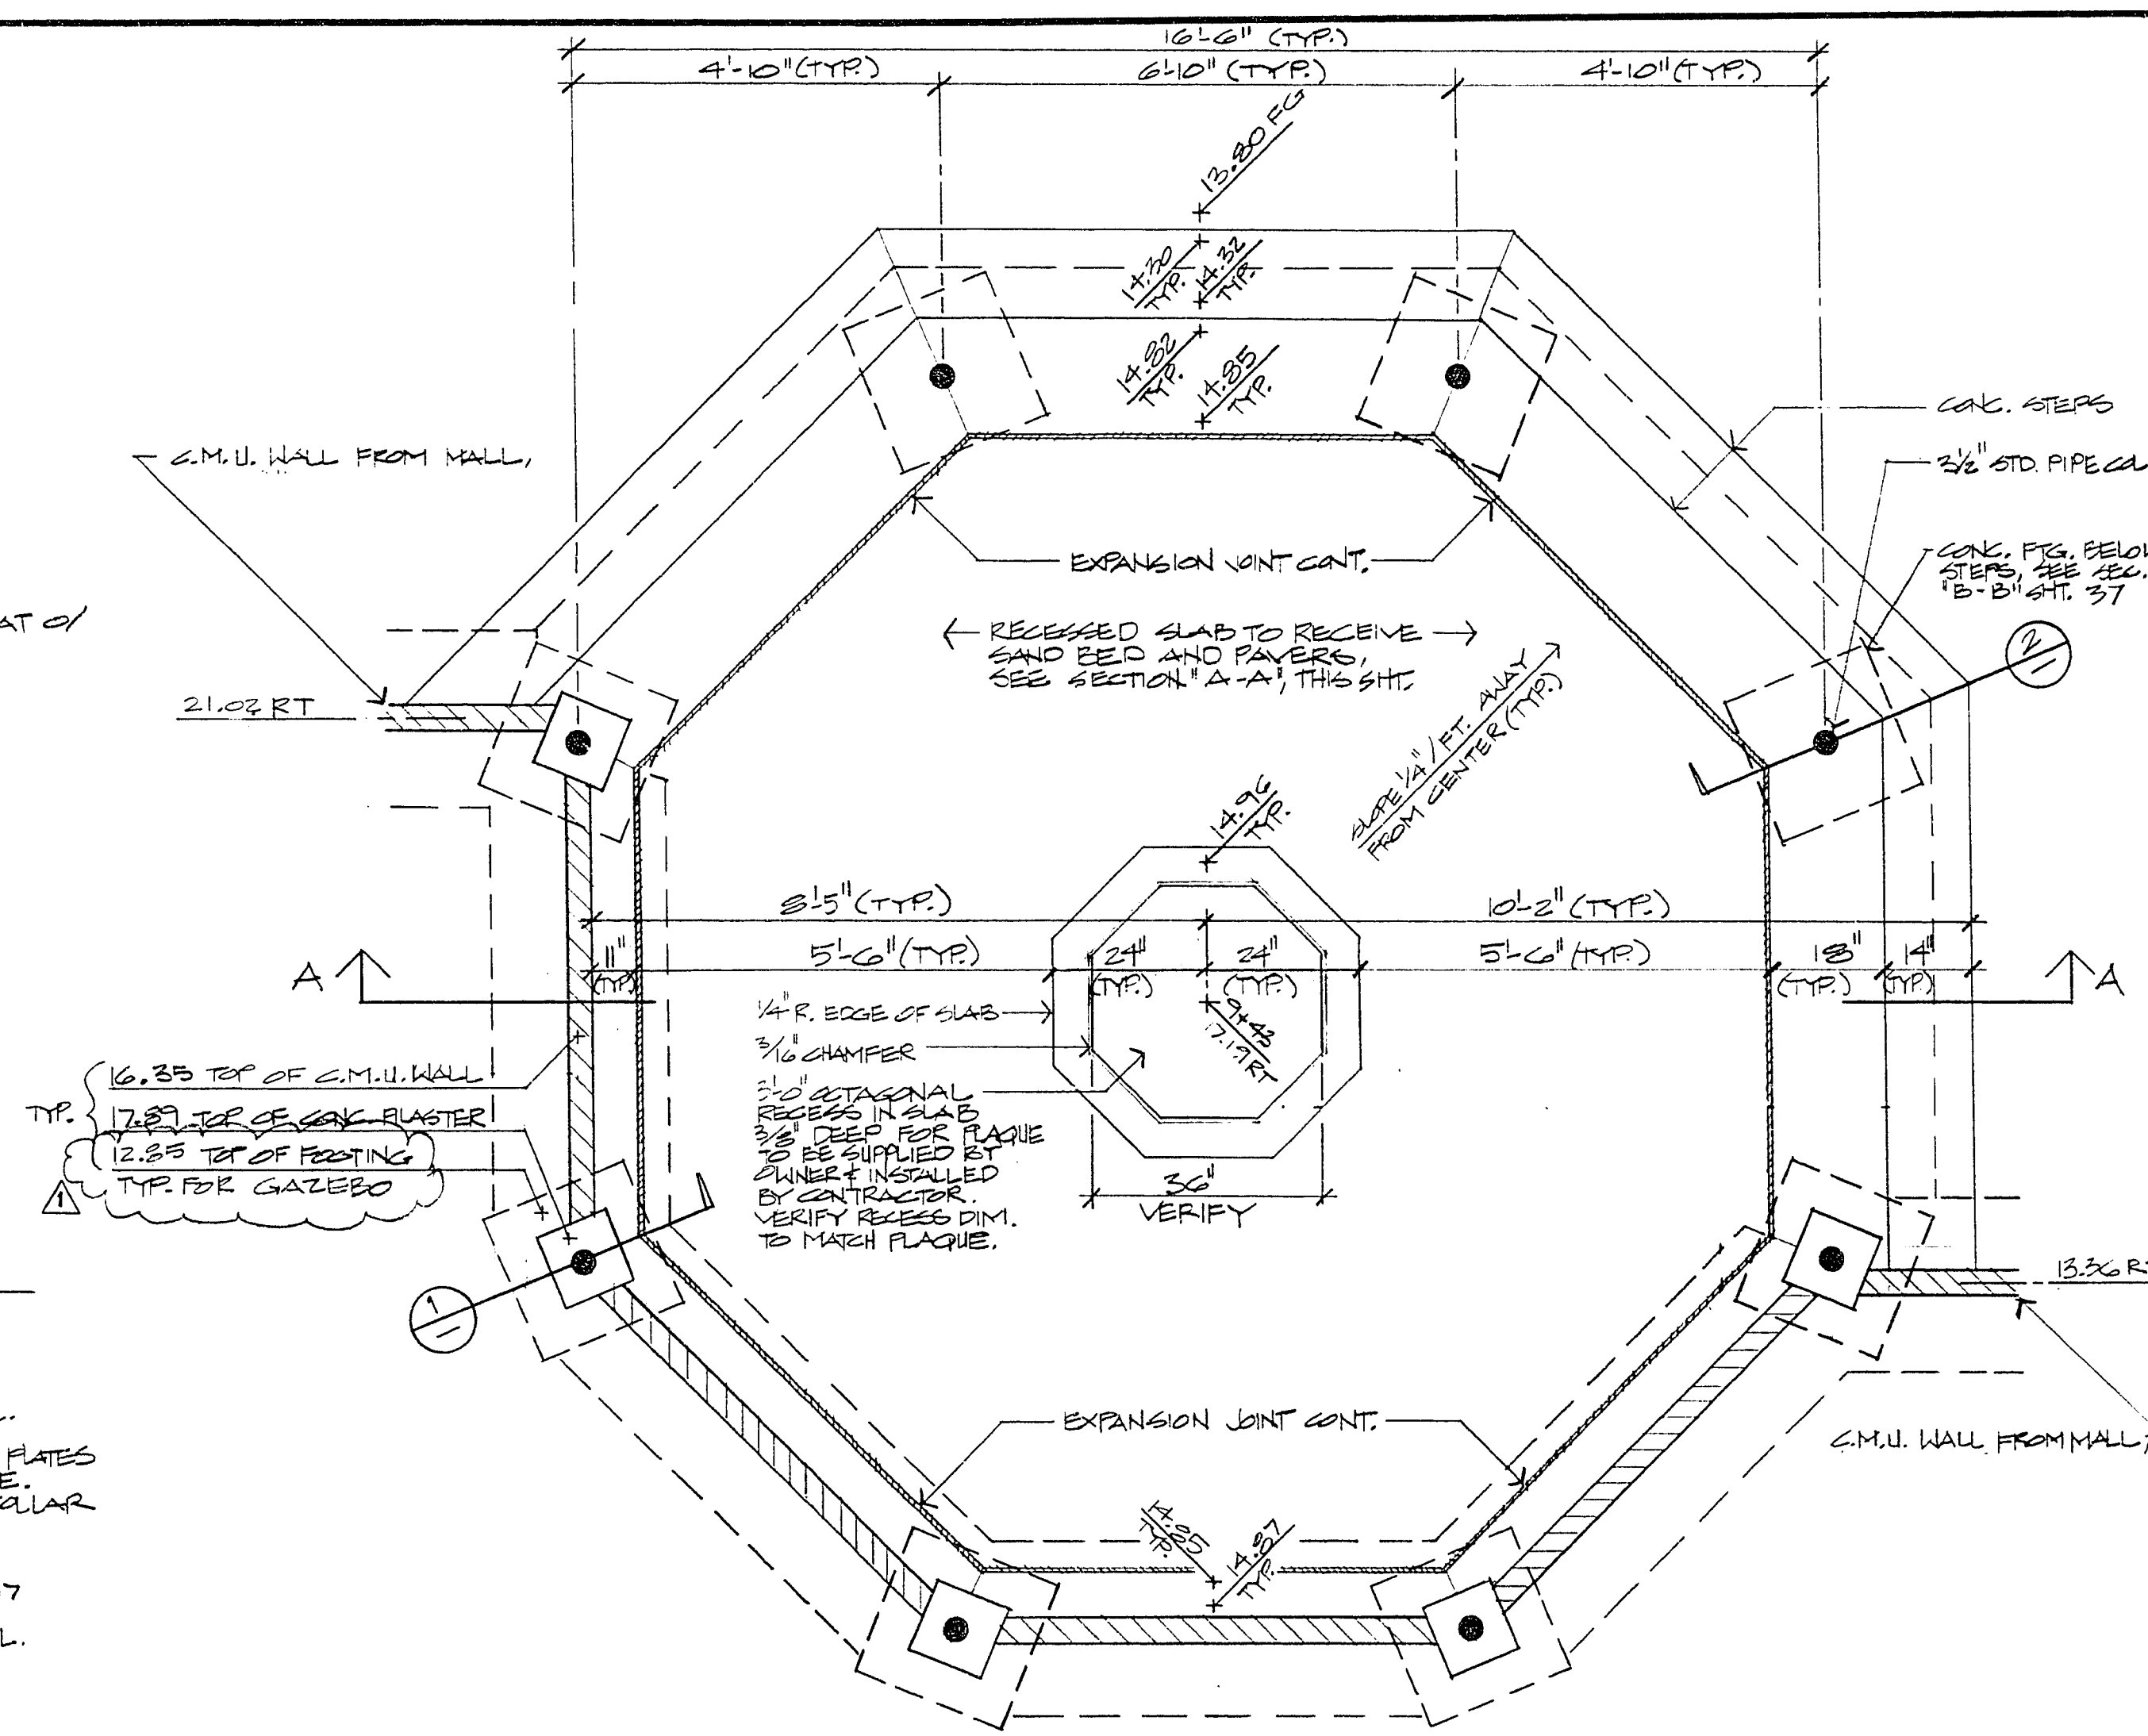
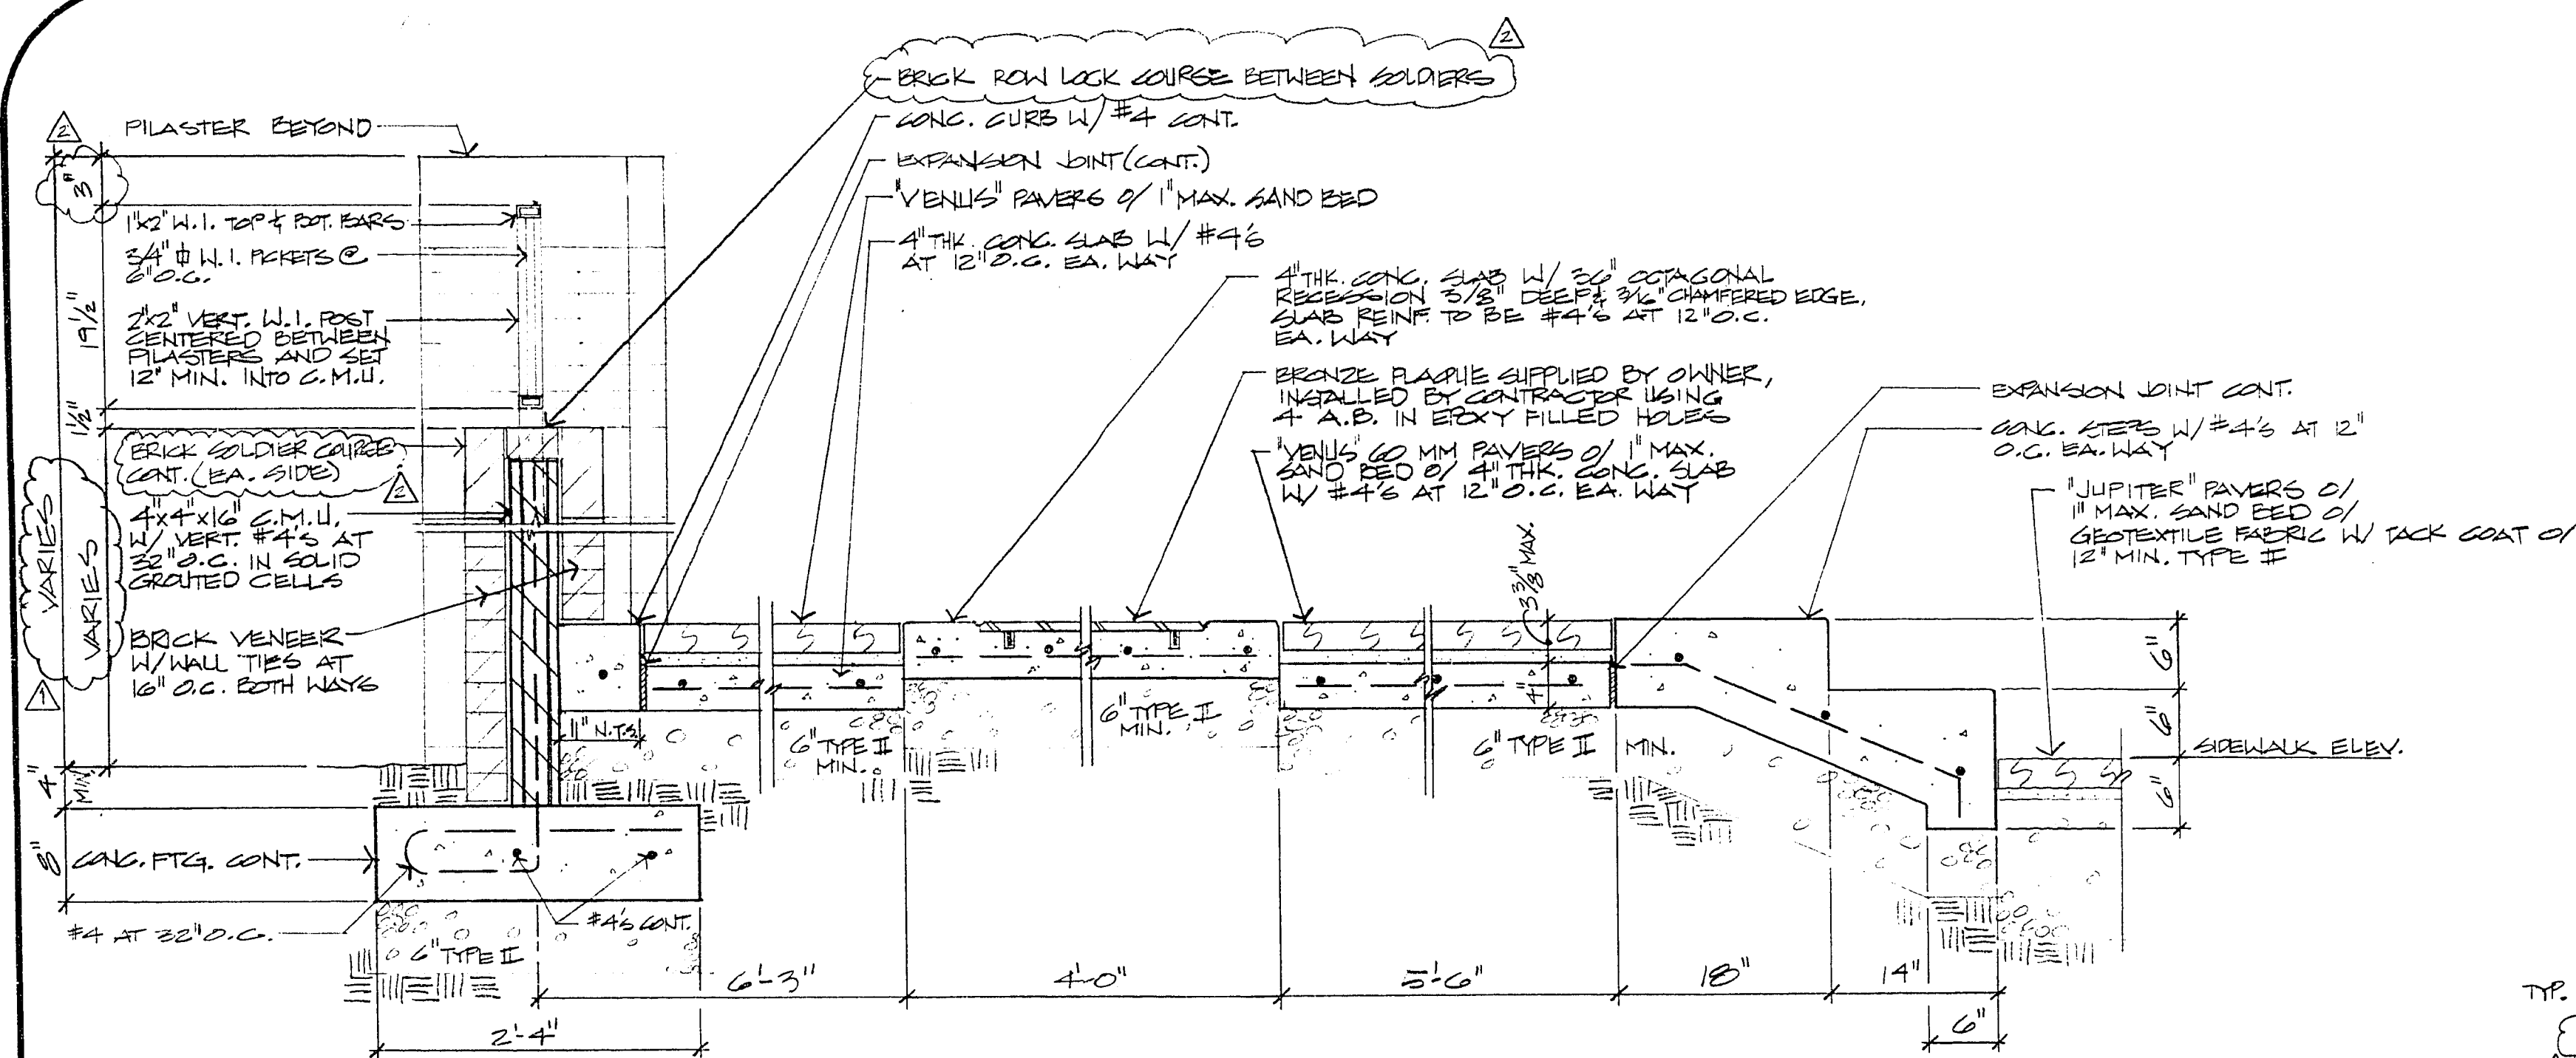
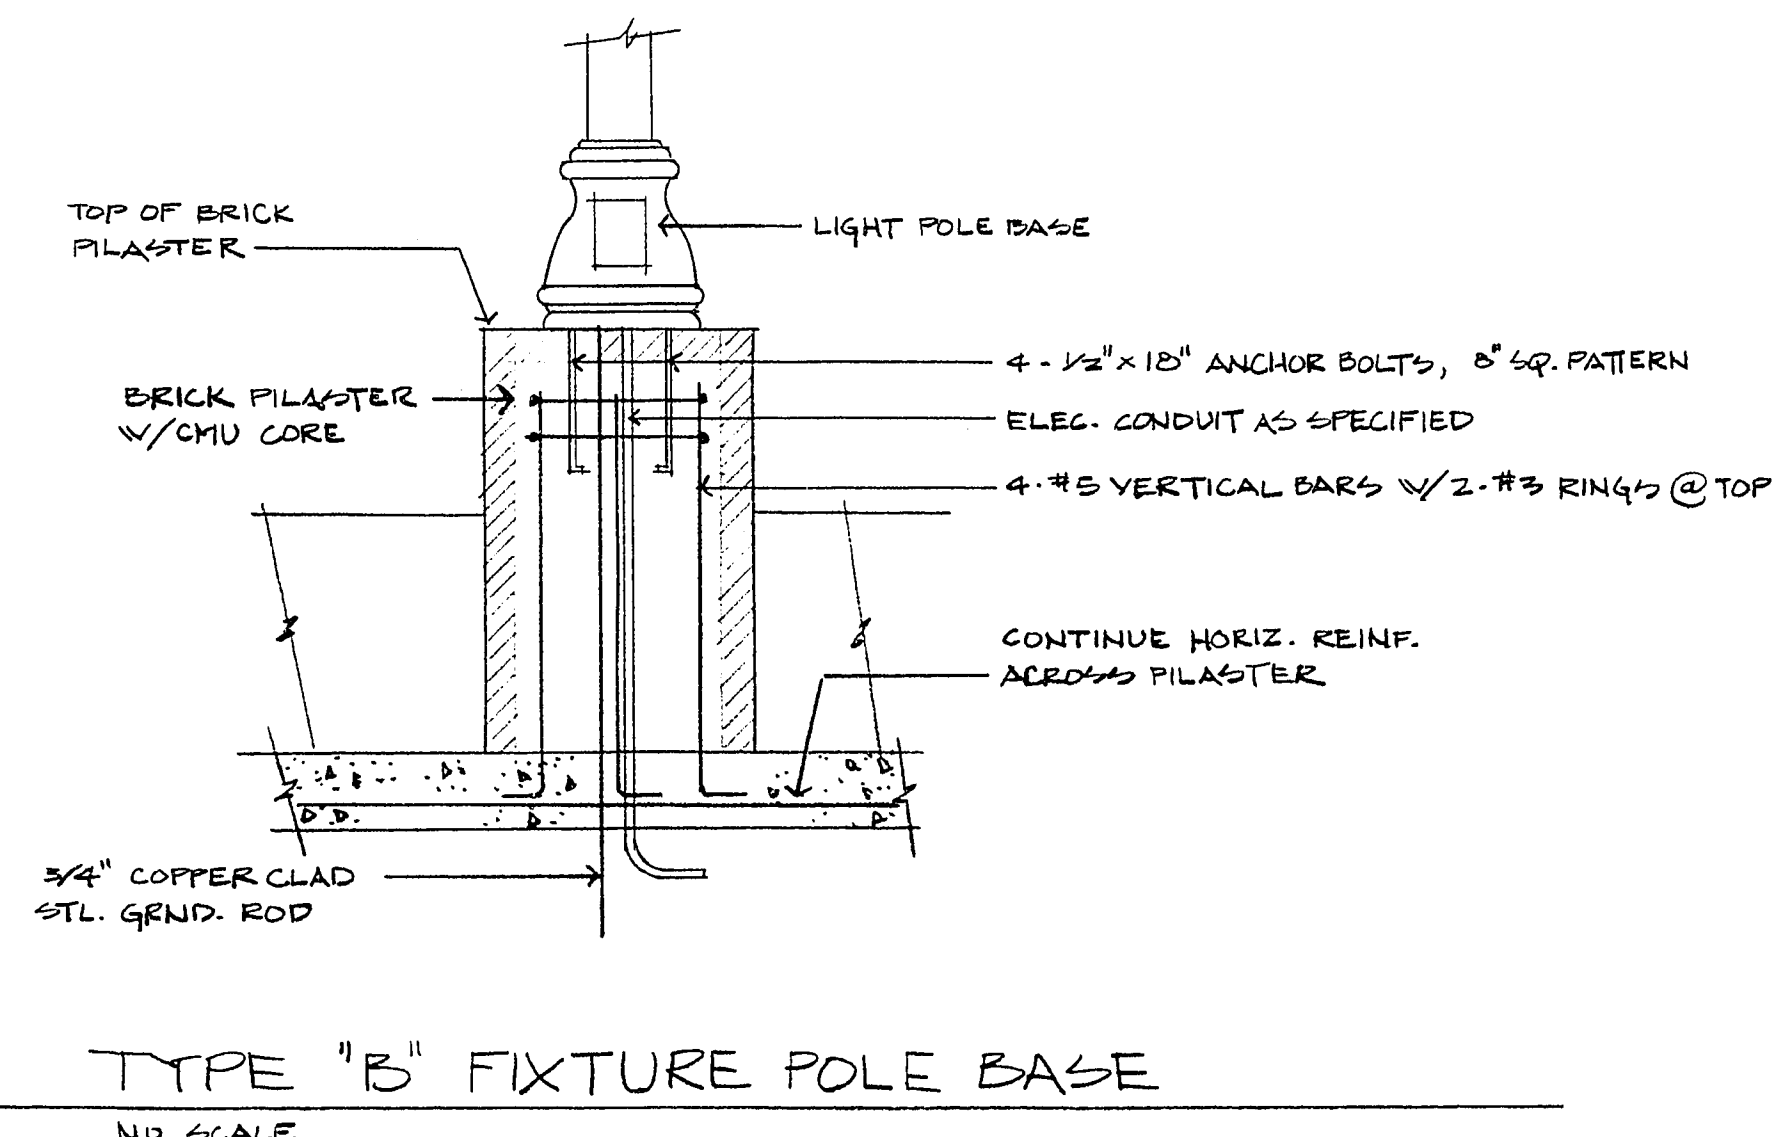
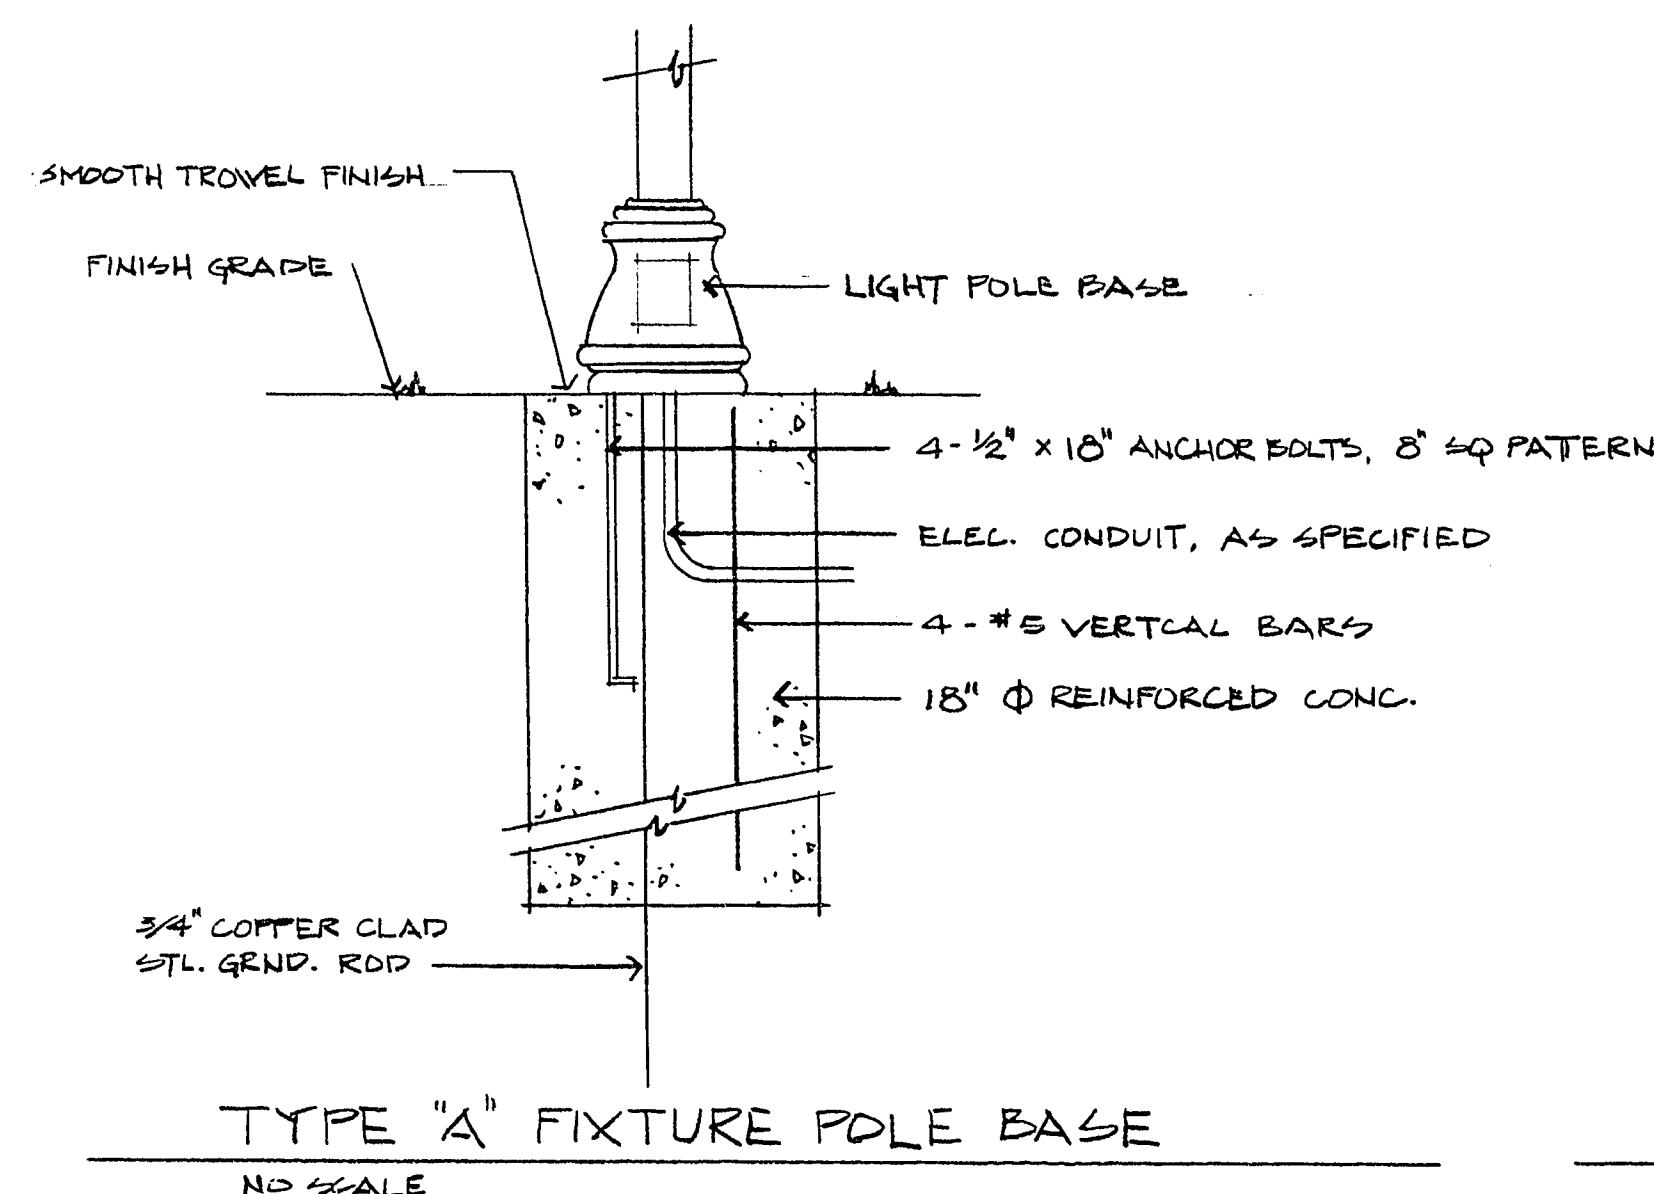


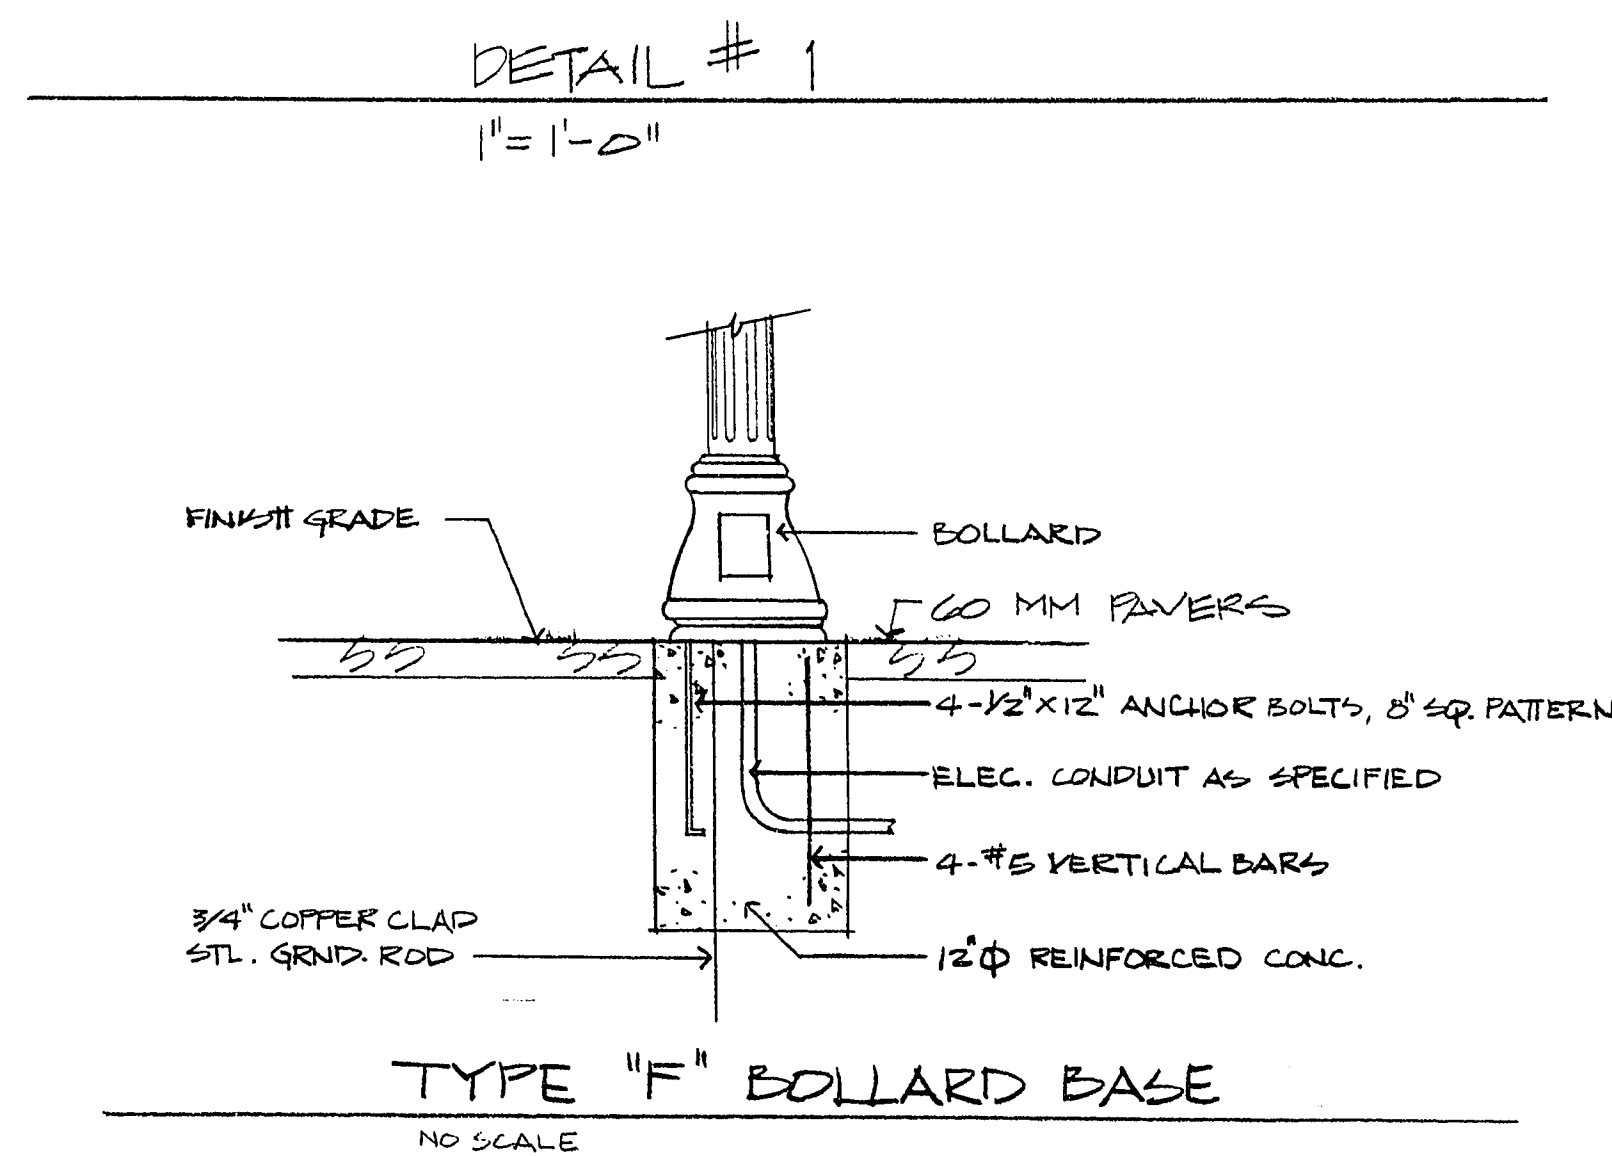

NOTE: ALL C.M.U. WALLS & CONC. PLASTERS (SHOWN) TO RECEIVE BRICK VENEER & CARP, SEE SECTION "A-A" & DETAIL #1 ON THIS SHEET AND SPECIFICATIONS.

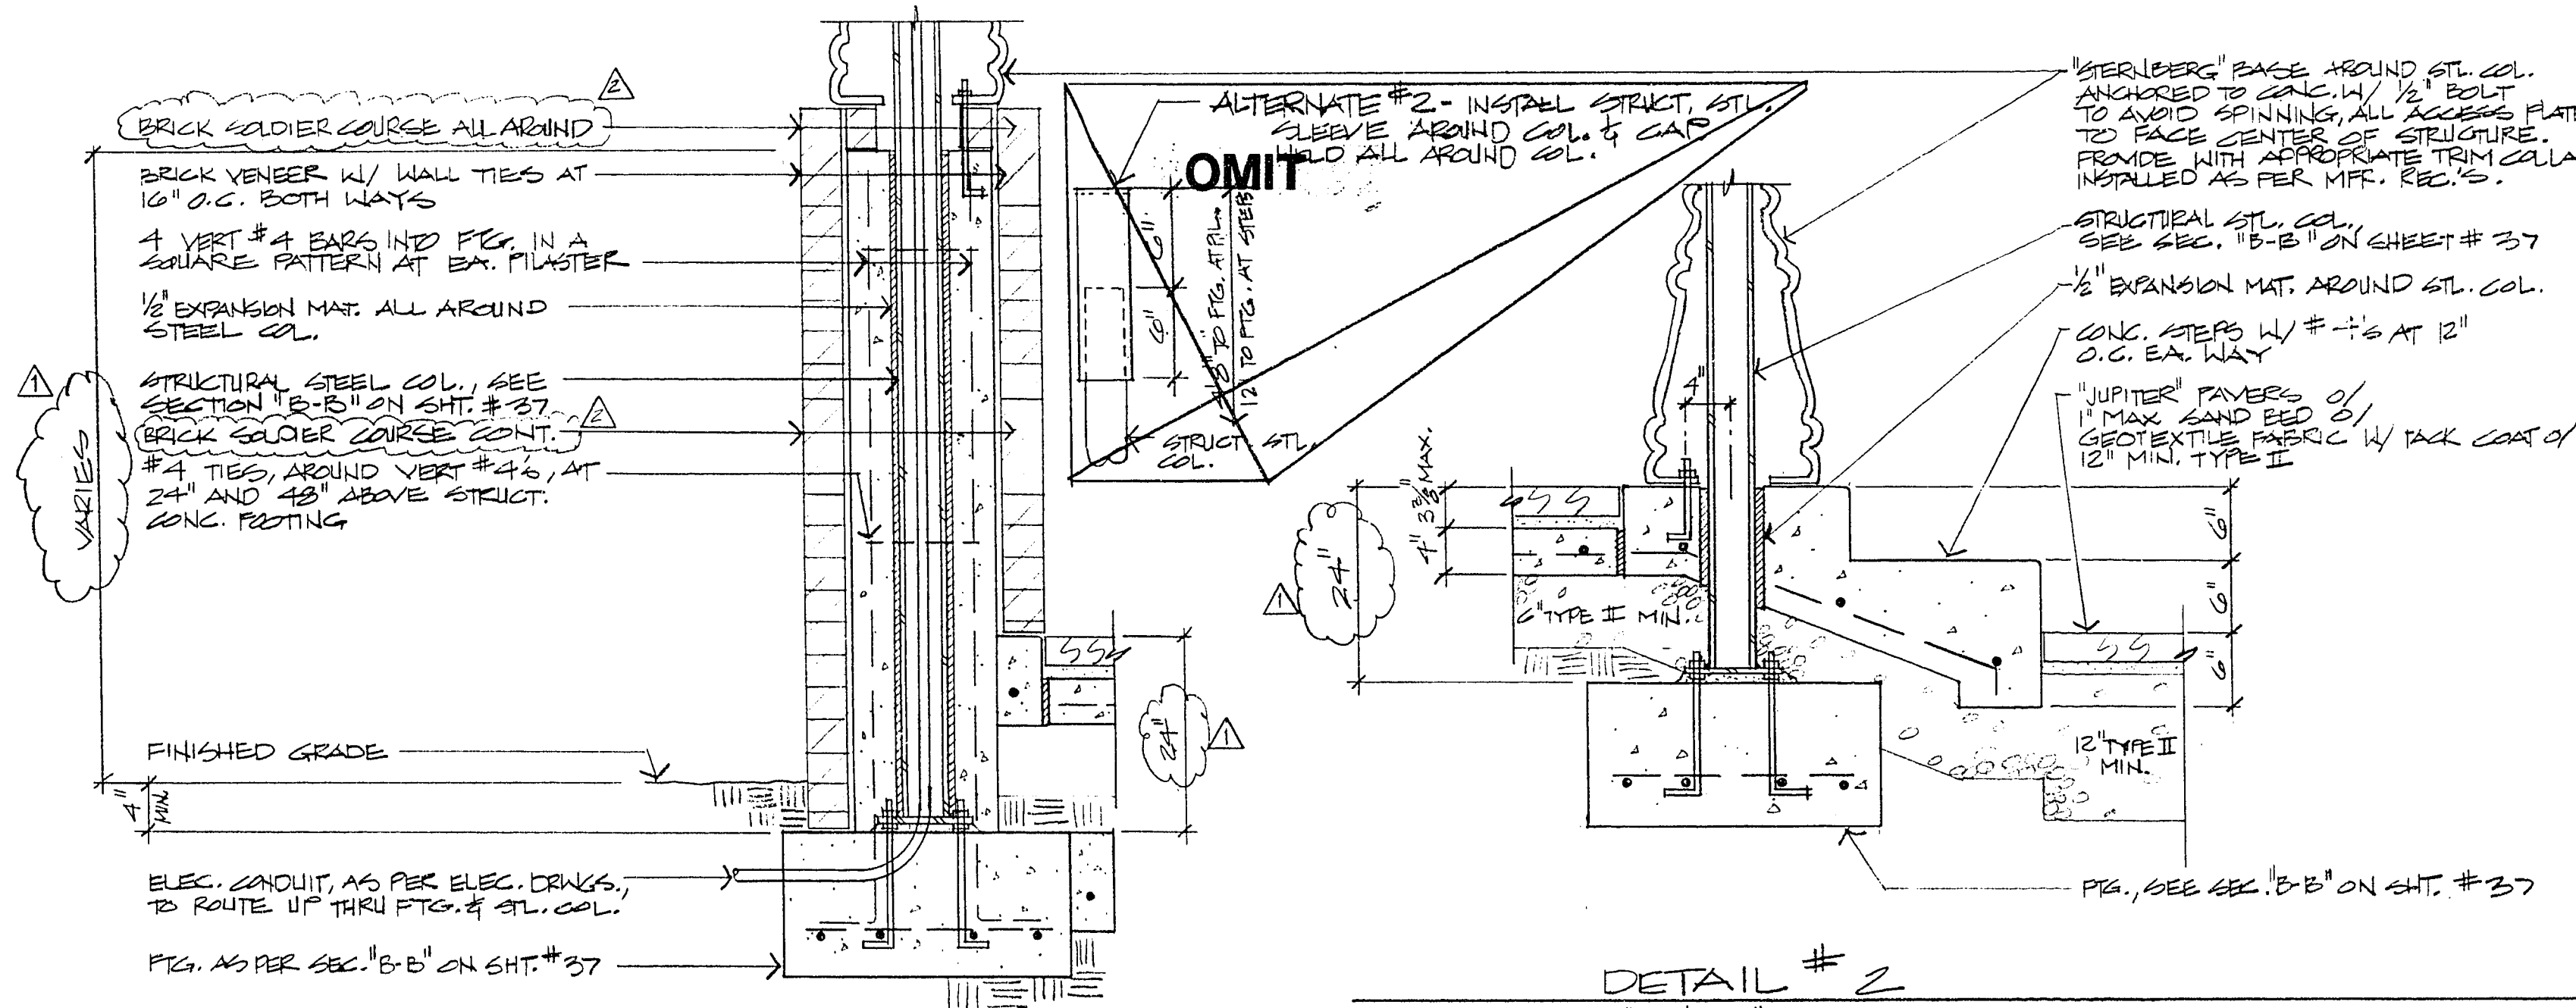

City of Las Vegas, Nevada
Department of
Design and Development
Thomas B. Graham, AICP, RLA, Director

REVISIONS	DATE
1. REVISE BRICK VENEER & CARP TO MATCH DETAIL #1	9-29-86
2. REVISE FOUNDATION PLAN TO MATCH DETAIL #1	9-29-86



GAZEBO FOUNDATION PLAN & DETS
DOWNTOWN TRANSPORTATION CENTER
OFF-SITE IMPROVEMENTS

PROJECT NO.
861715.14
DRAWING NO.
590-2E
SHEET 36 OF 51

30-13-86