




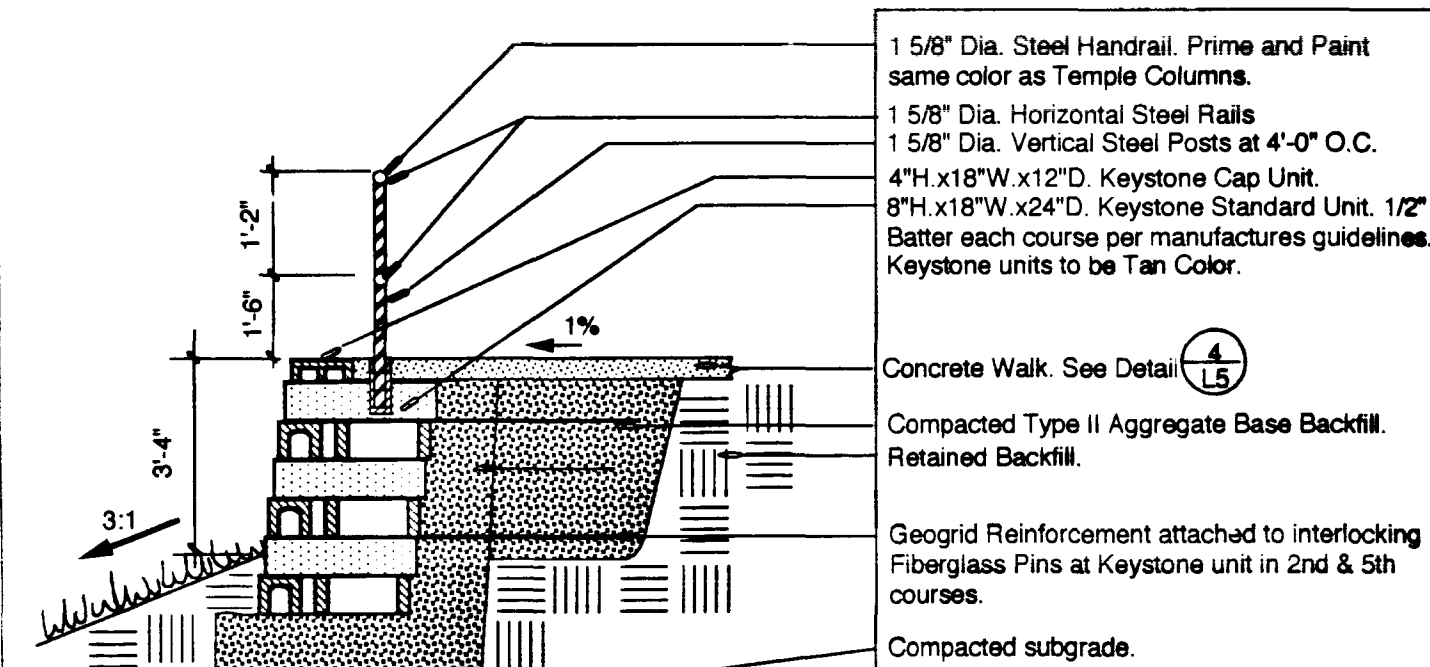


19 Gravity Retaining Wall with Walk & Handrail
L5

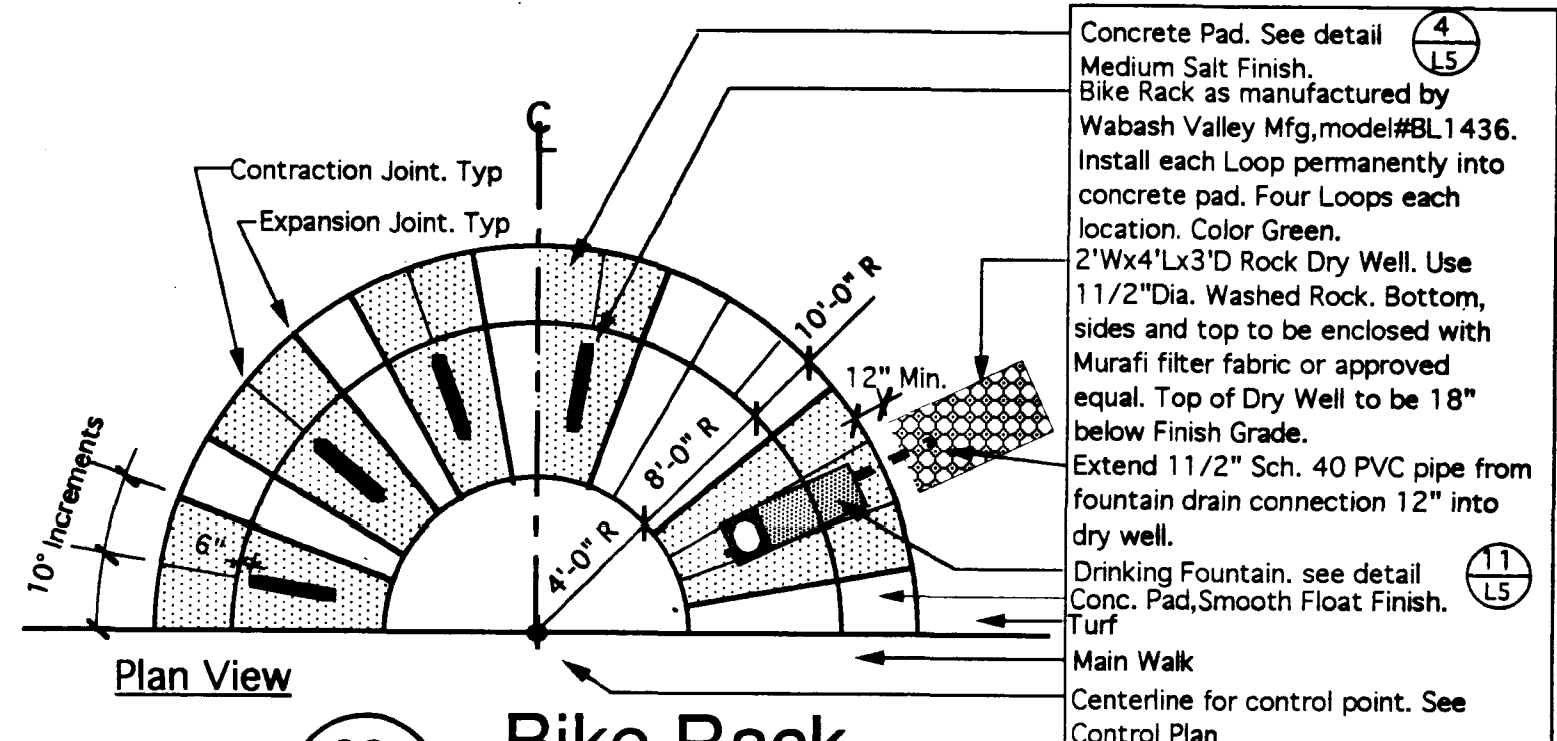


20 Bike Rack
L5

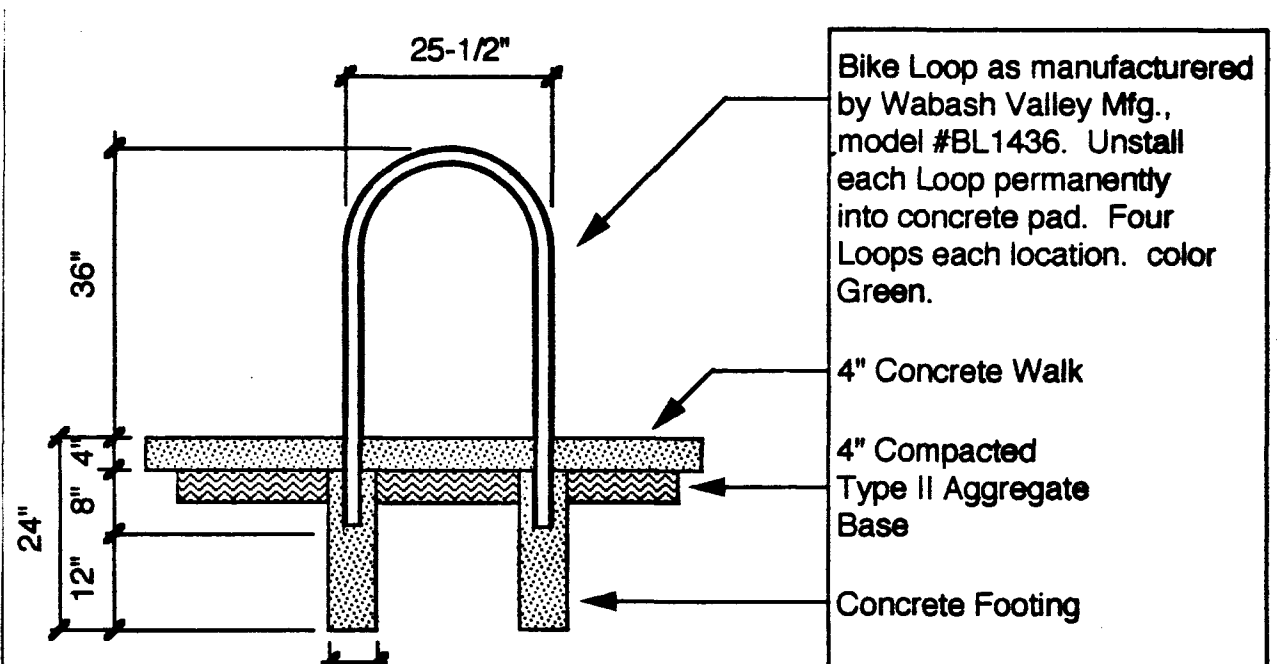


21 Bike Loop
L5

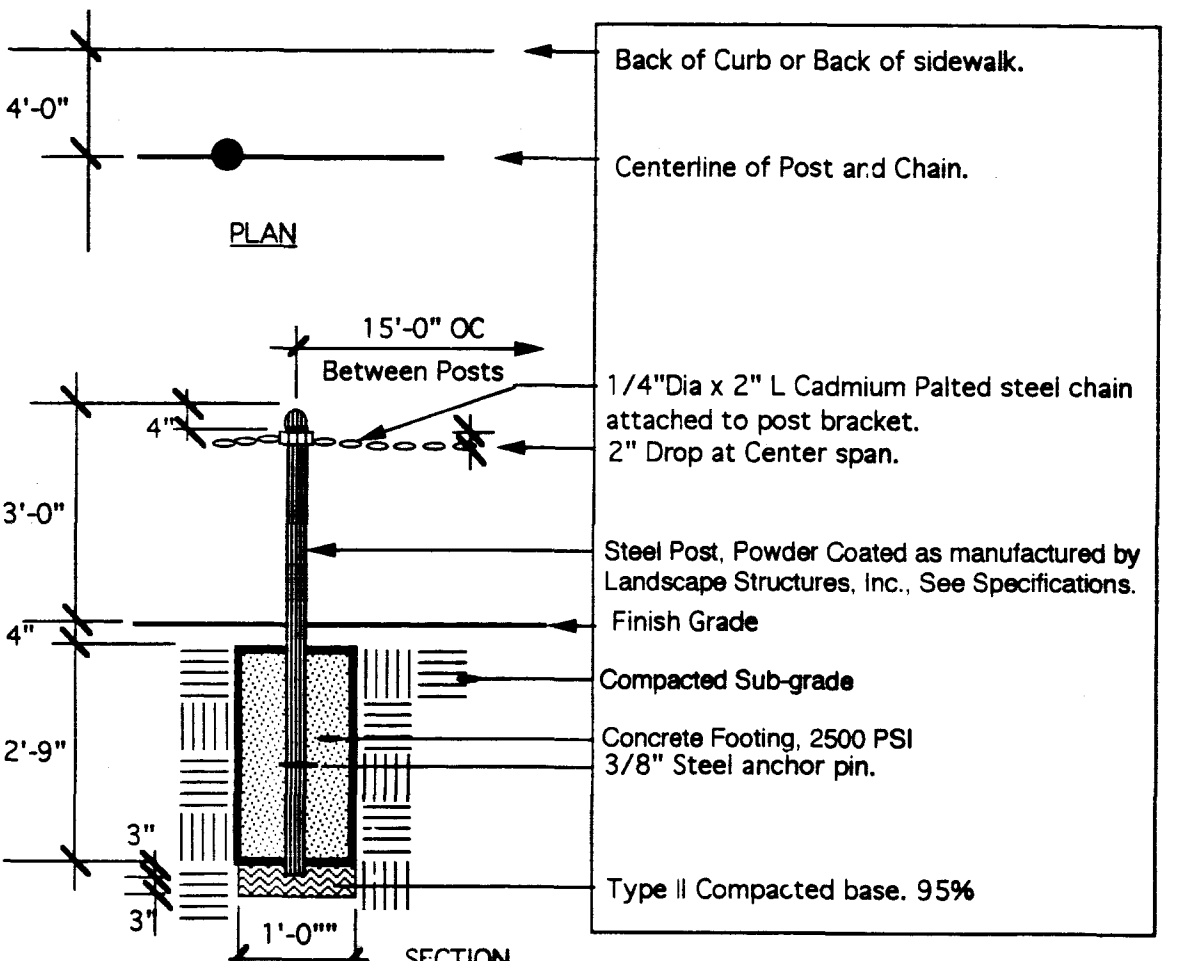


22 Post & Chain Fence
L5

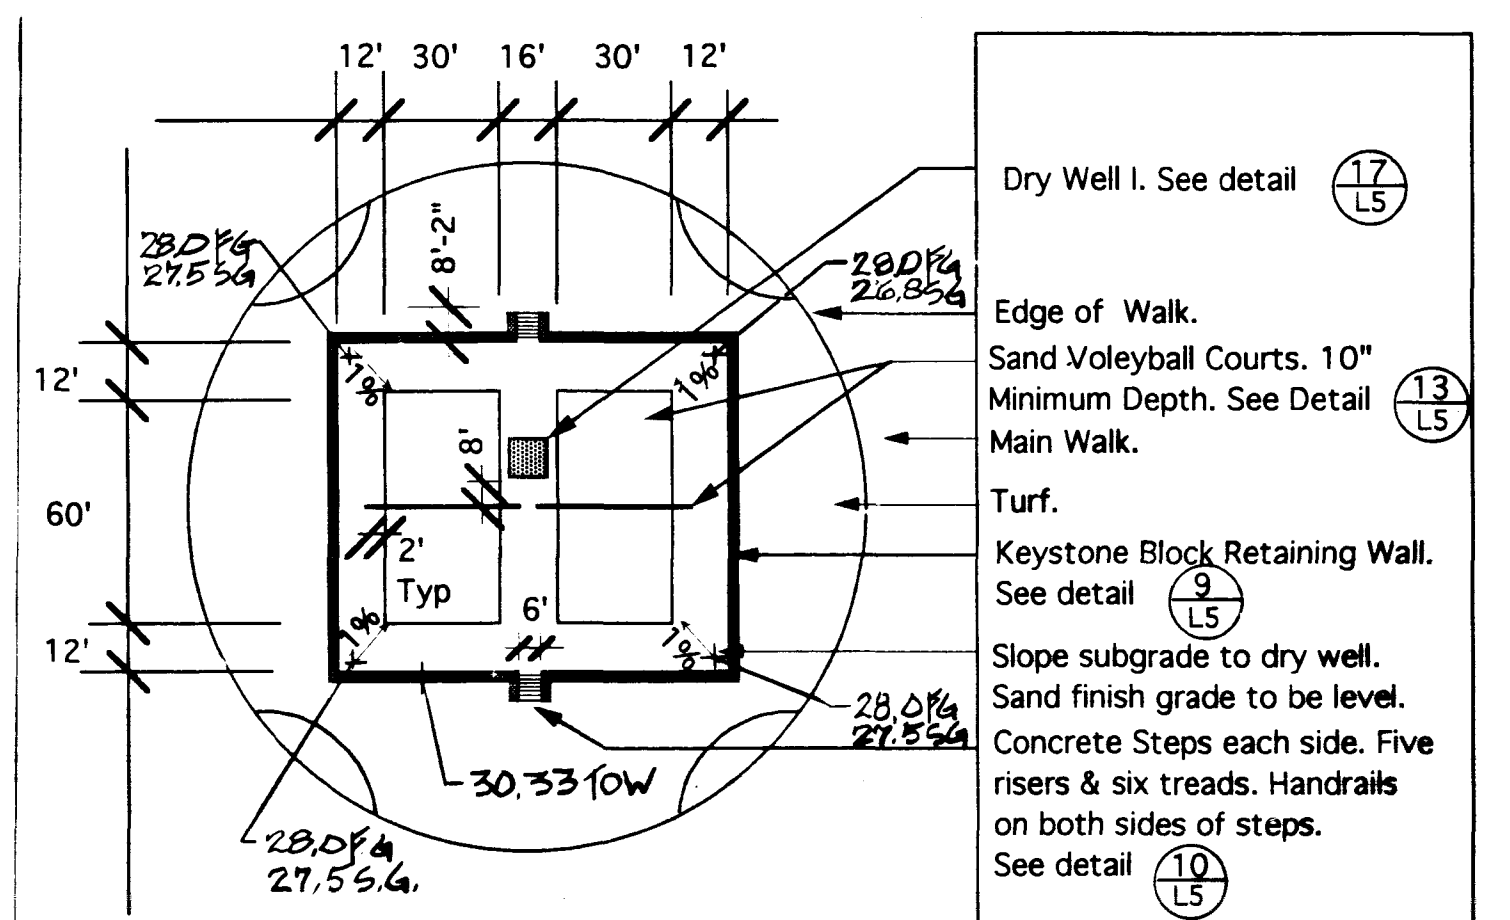


23 Volleyball Area Layout
L5

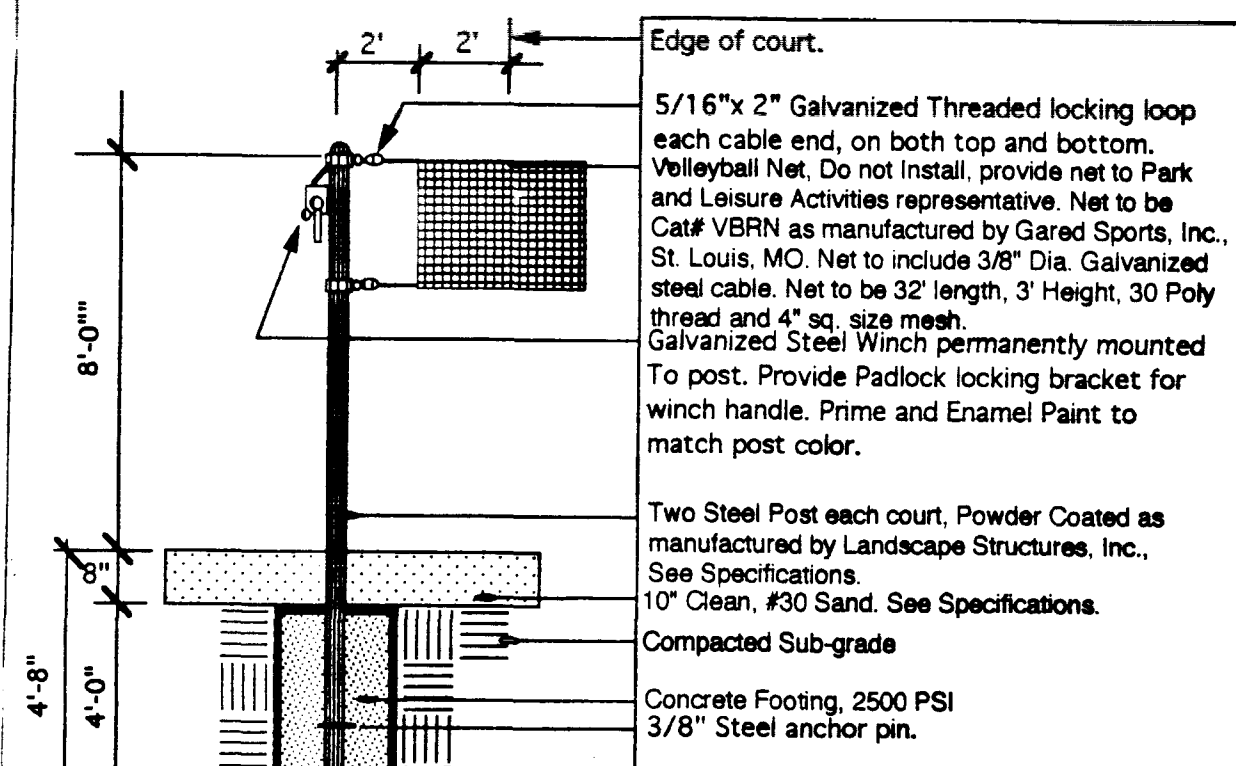


13 Volleyball Post
L5

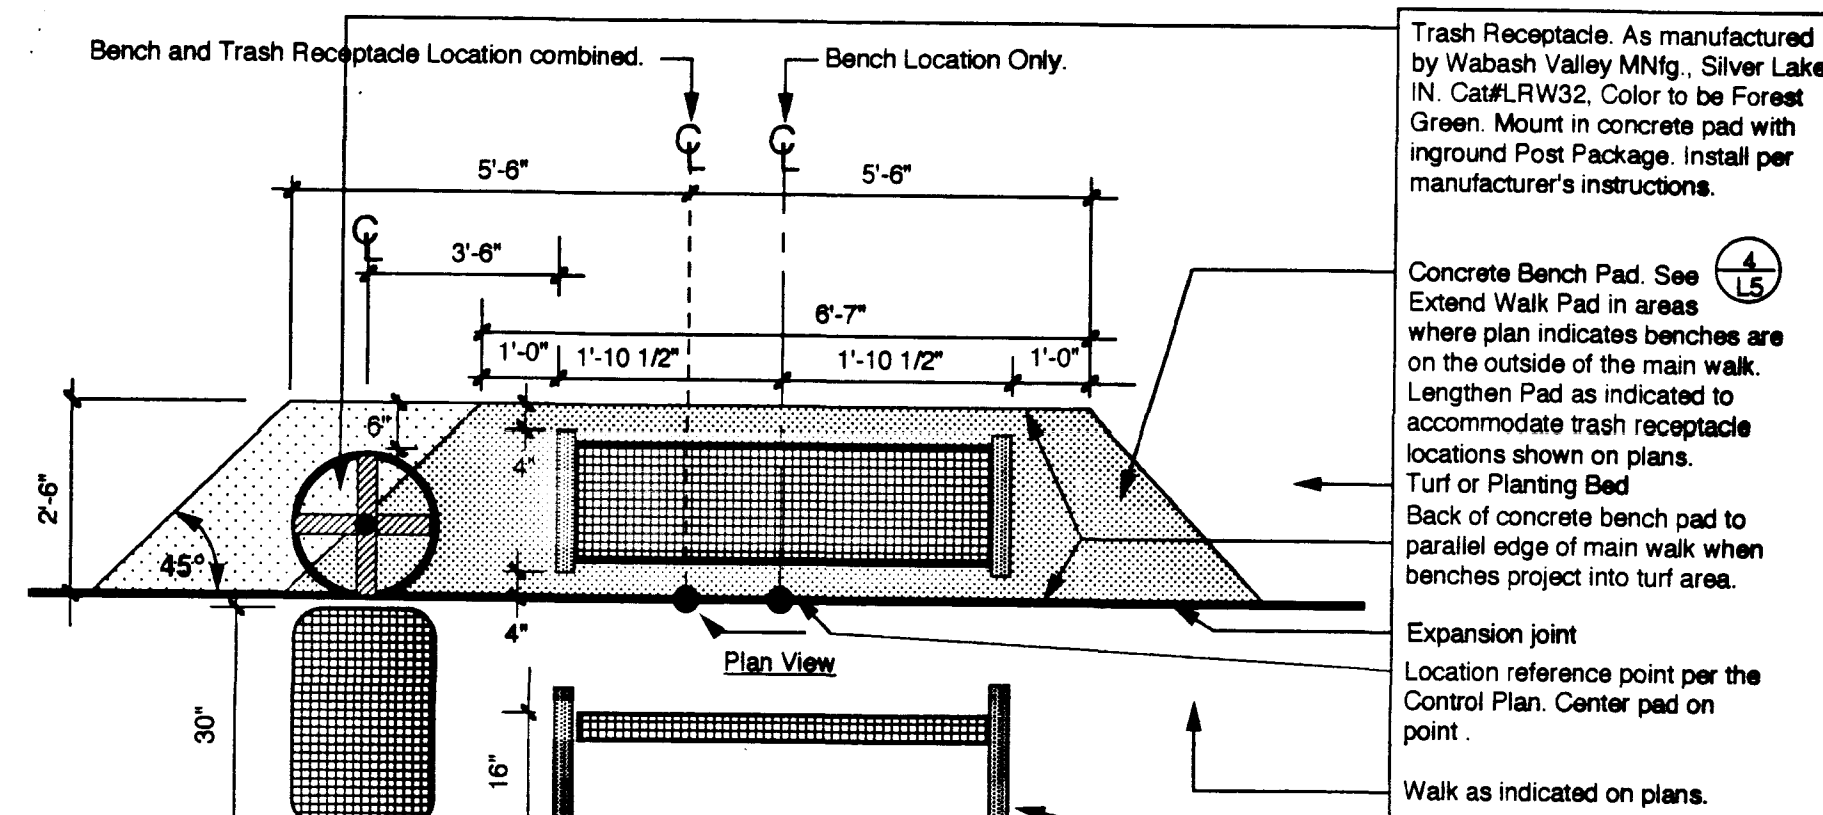


14 Bench - 1 & Trash Receptacle
L5

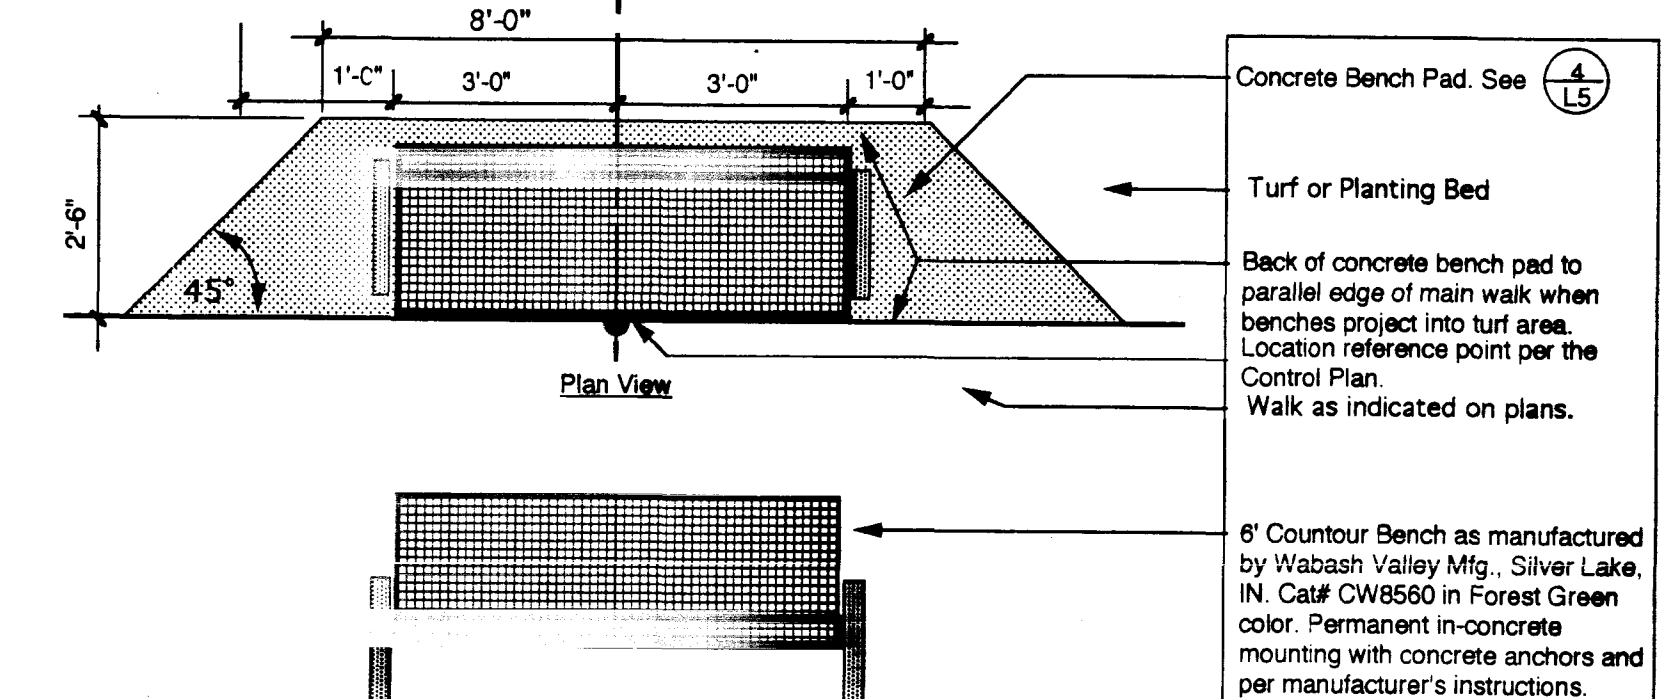


15 Bench - 2
L5

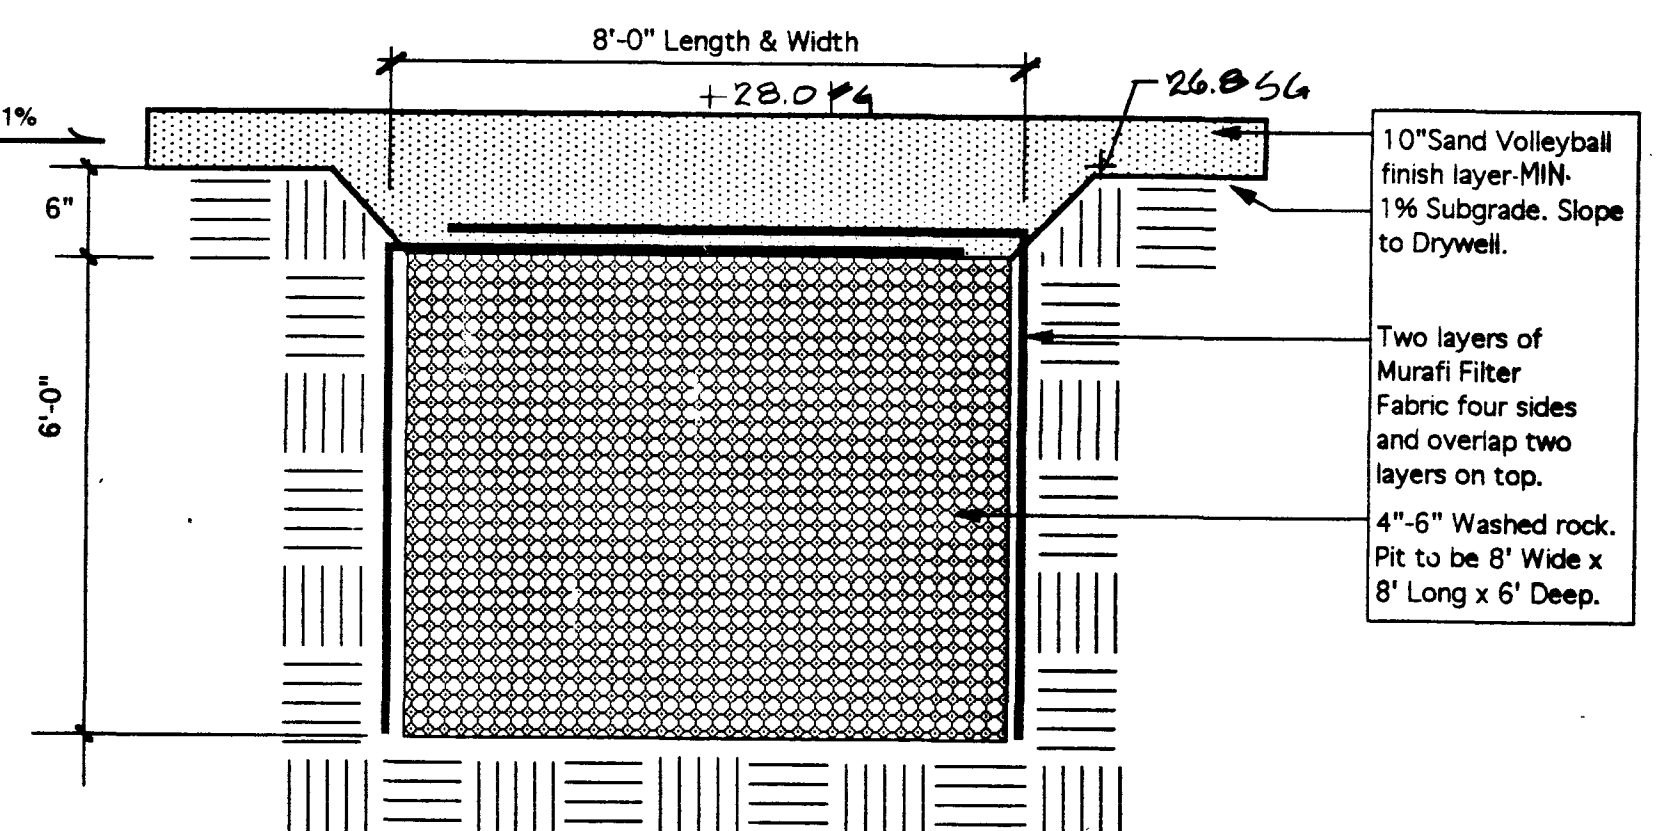


17 Dry Well - I
L5

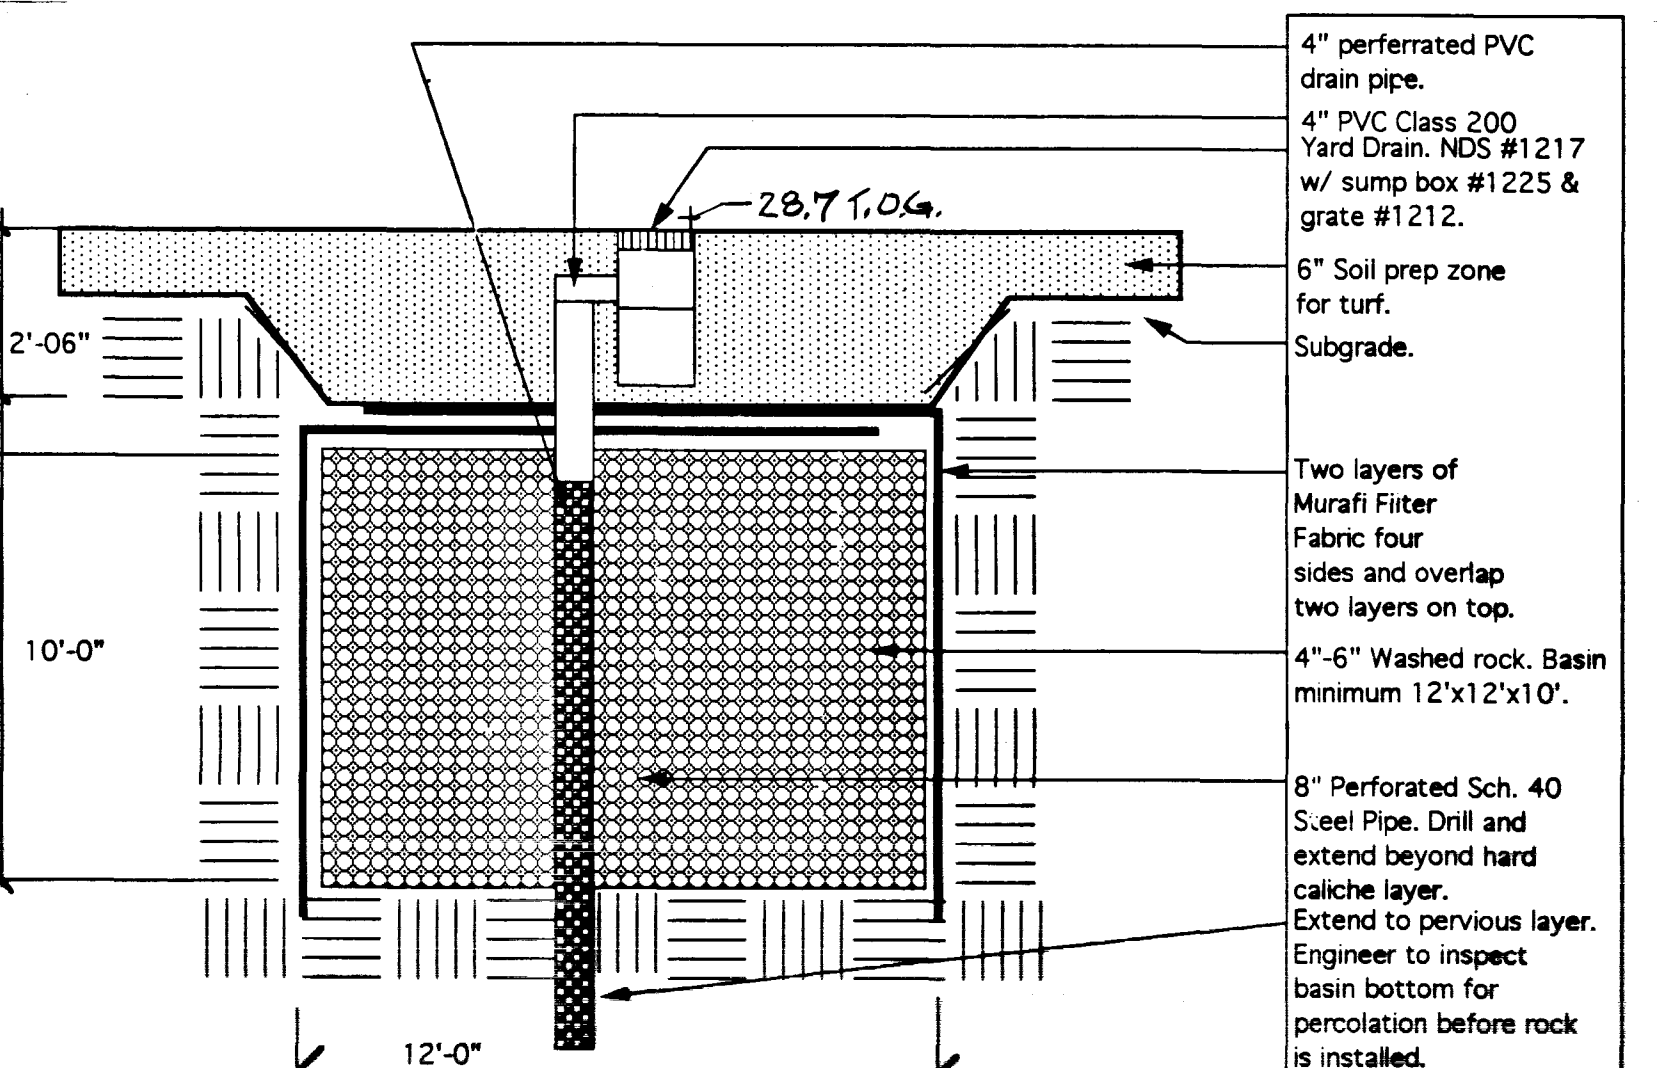


18 Dry Well - II
L5

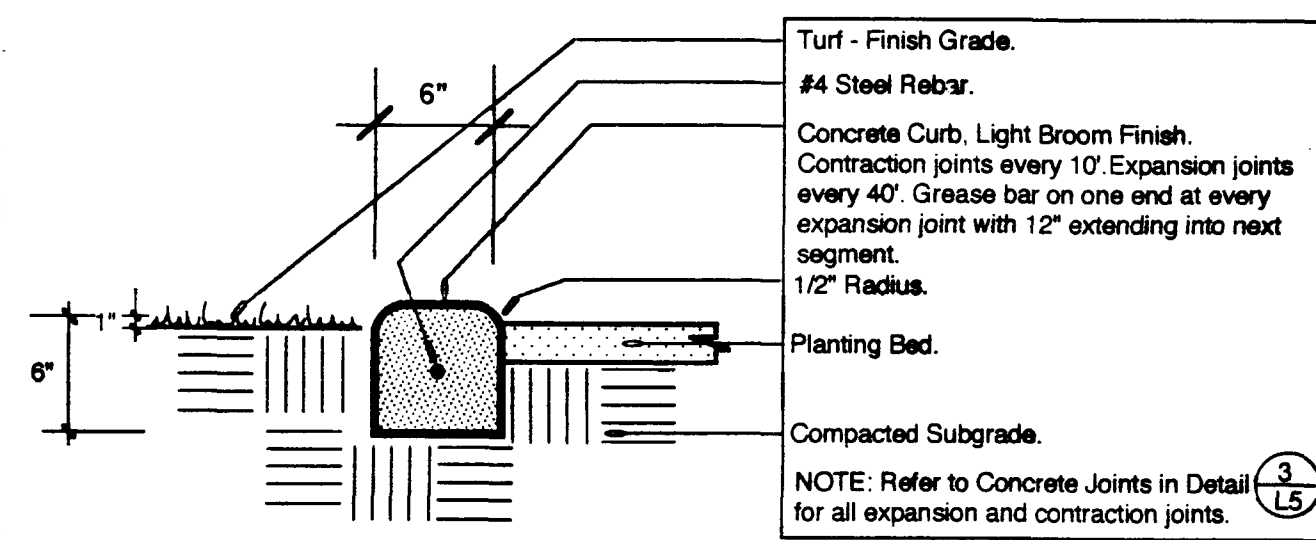


7 Concrete Mowing Curb
L5

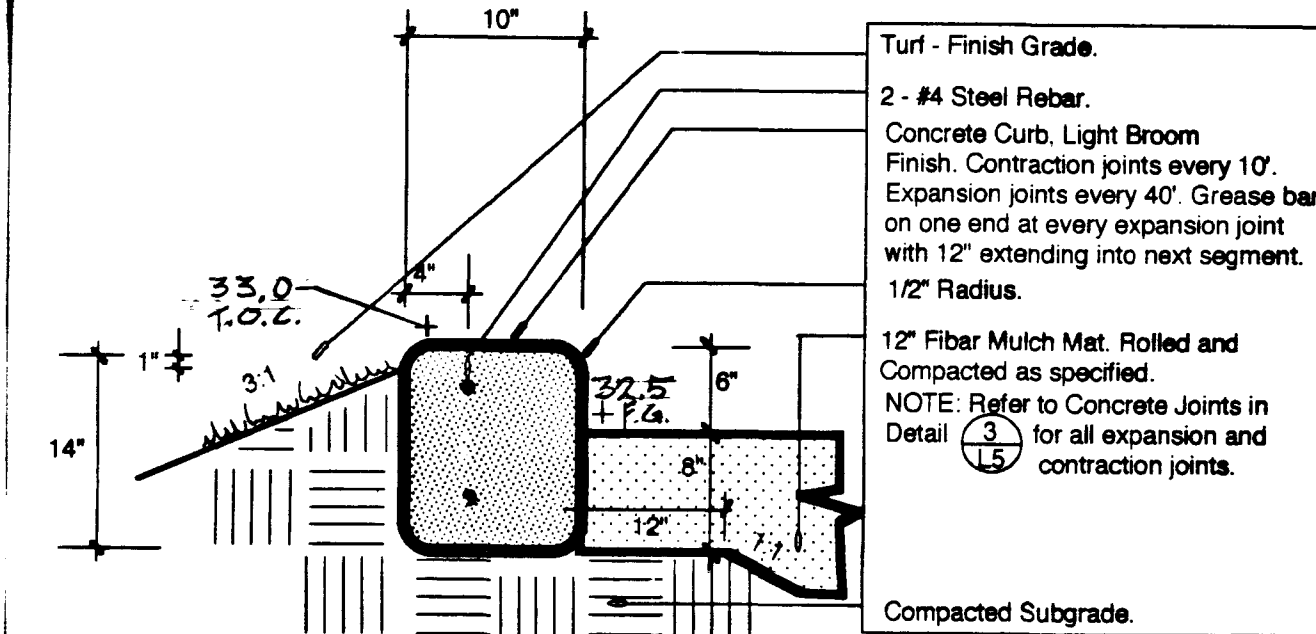


8 Concrete Playground Curb
L5

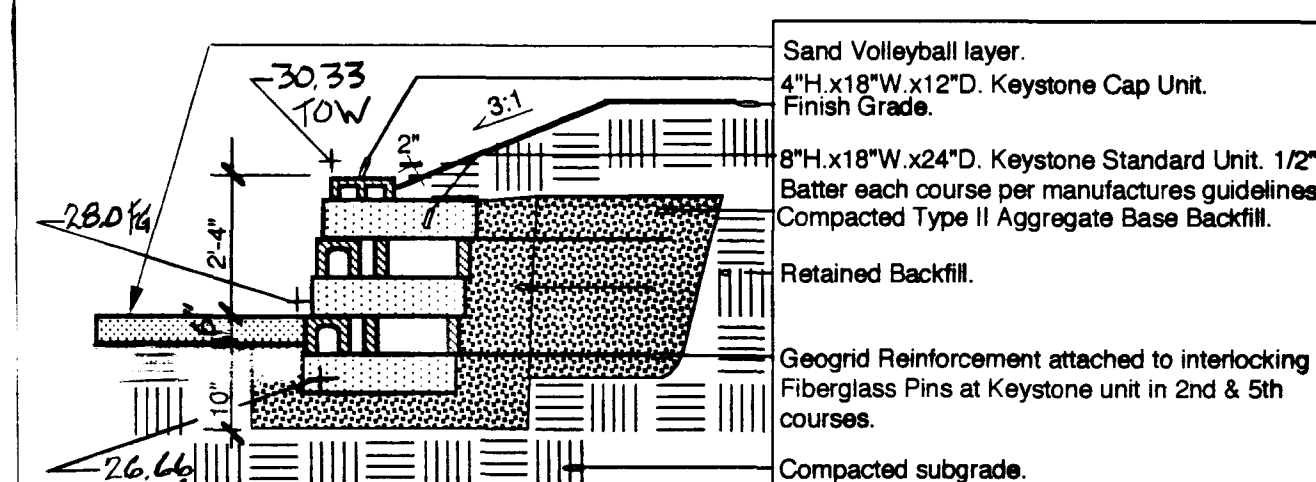


9 Volleyball Gravity Retaining Wall
L5

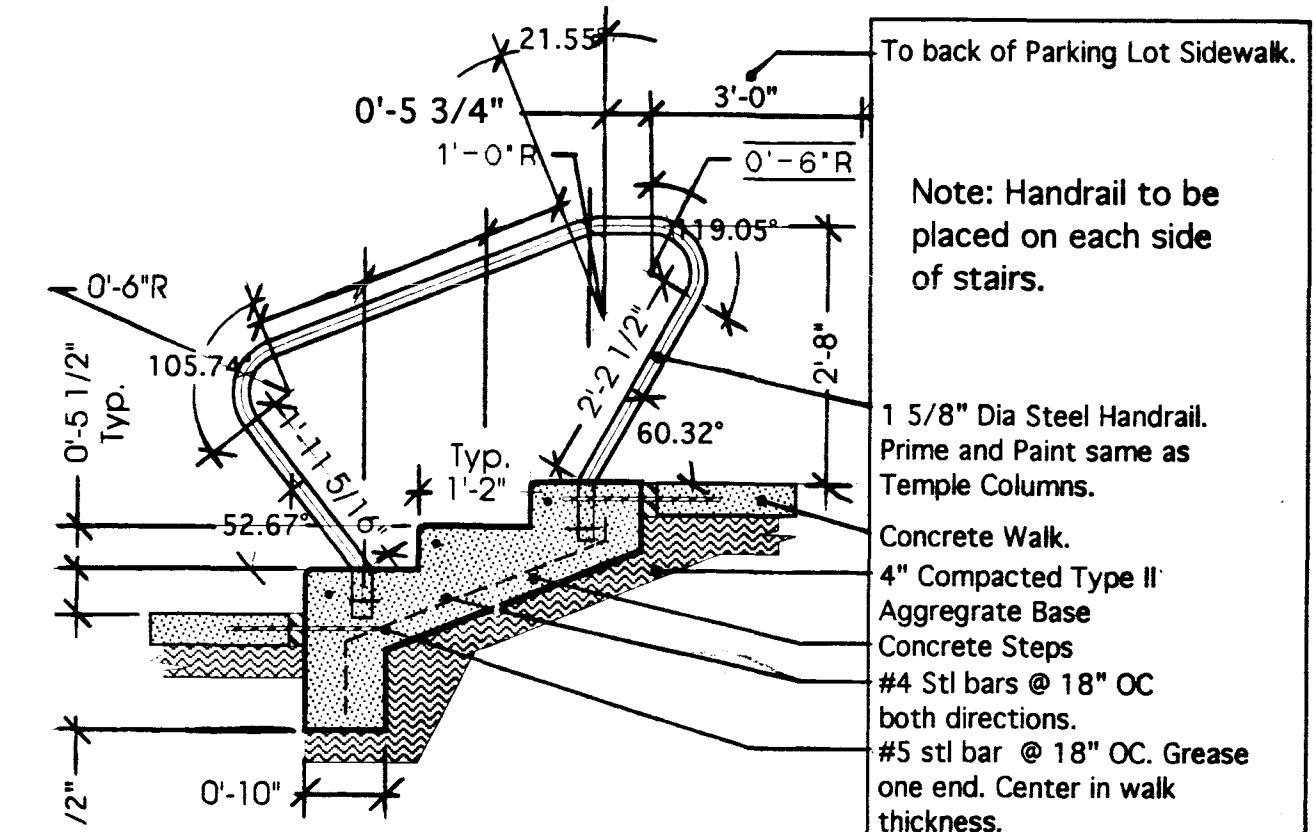


10 Concrete Steps w/ Handrails
L5

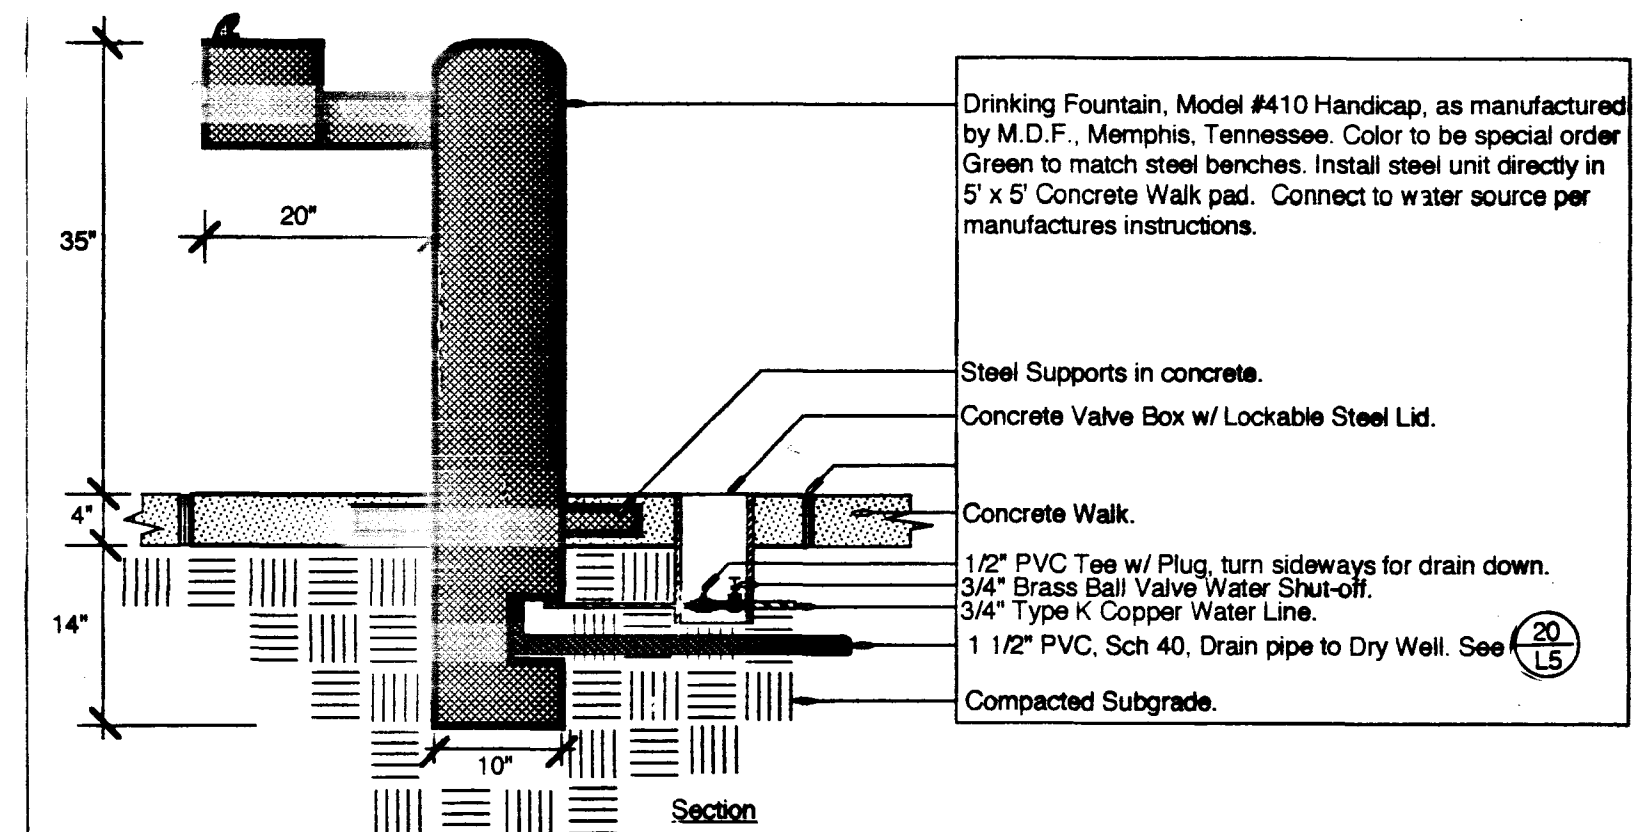


11 Drinking Fountain
L5

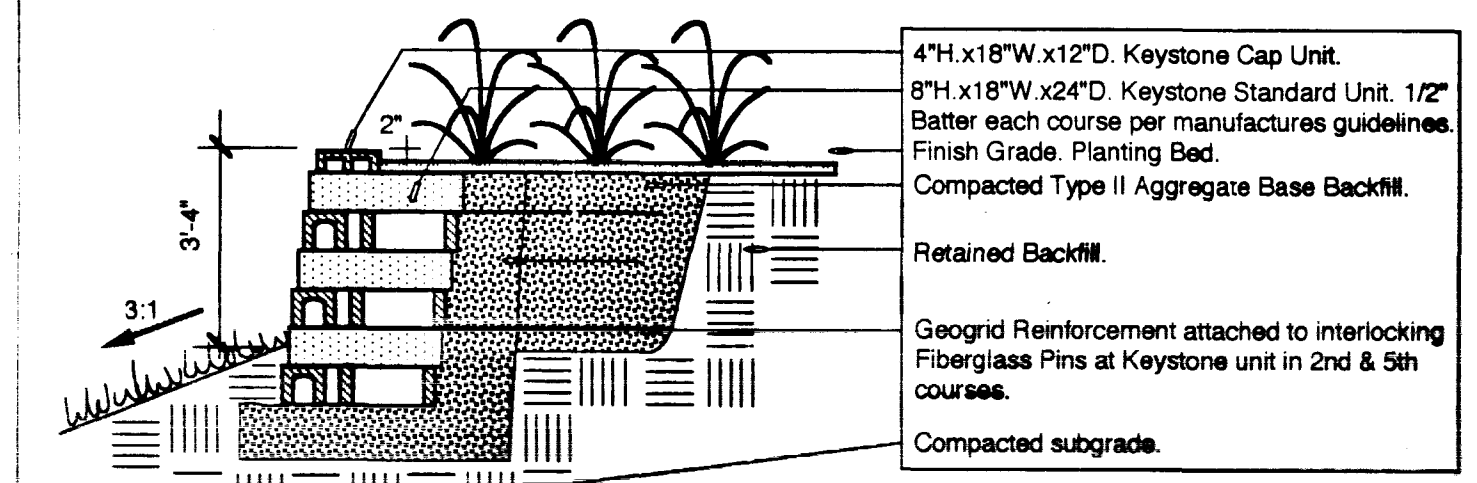


12 Gravity Retaining Wall
L5

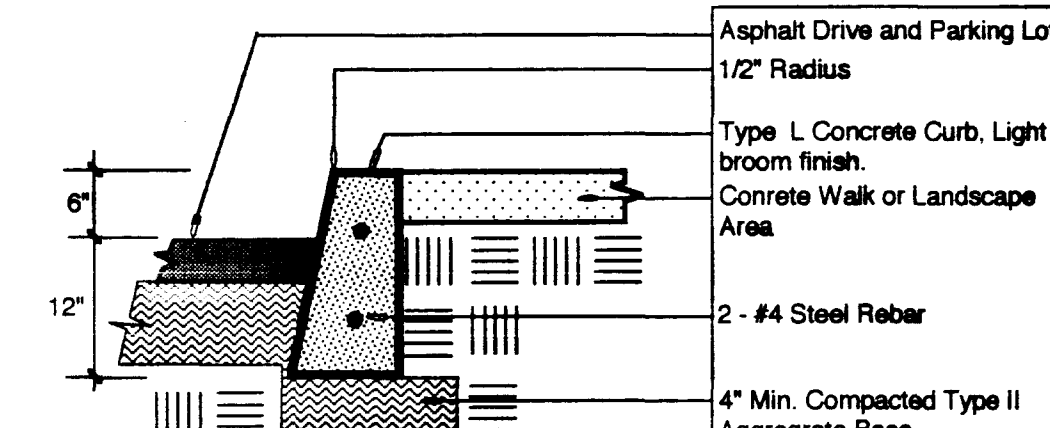


1 Parking Lot Curb
L5

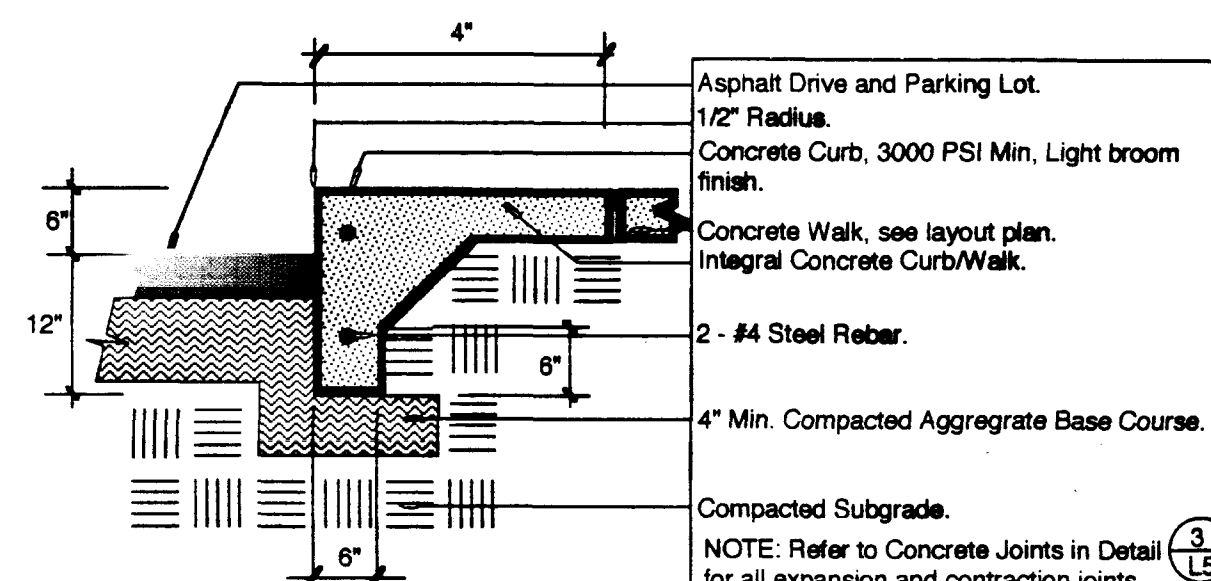


2 Integral Concrete Curb/Walk Detail
L5

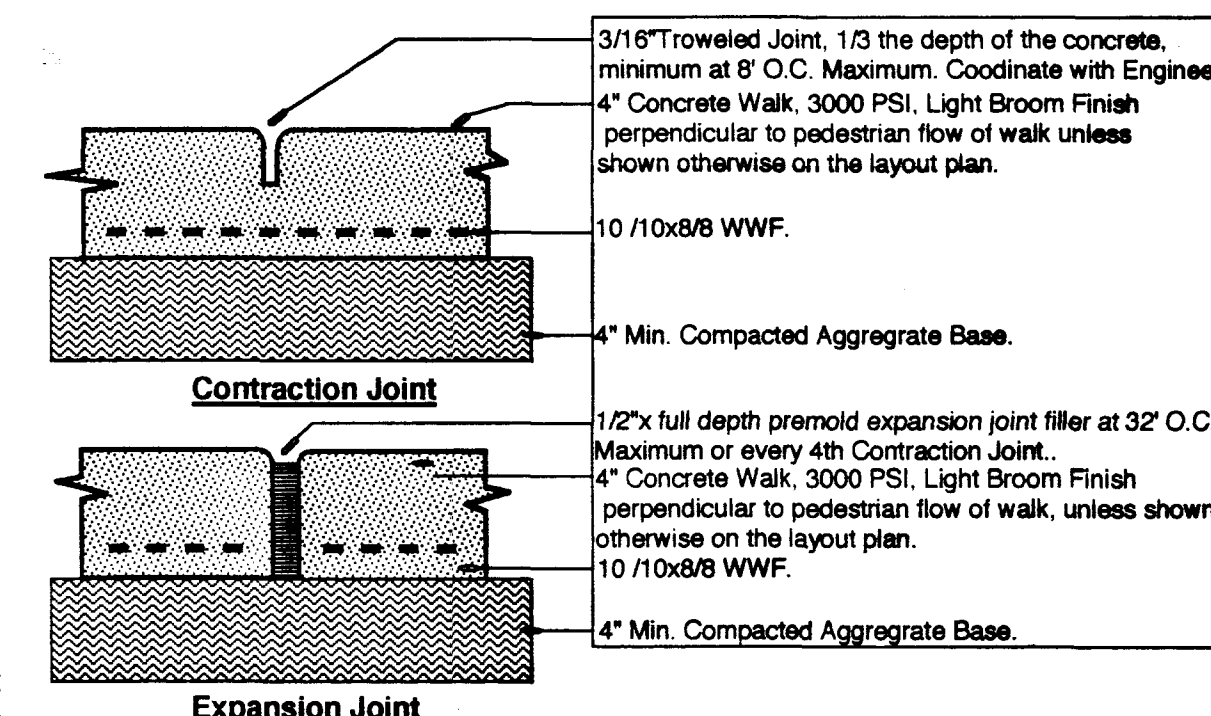


3 Concrete Joints
L5

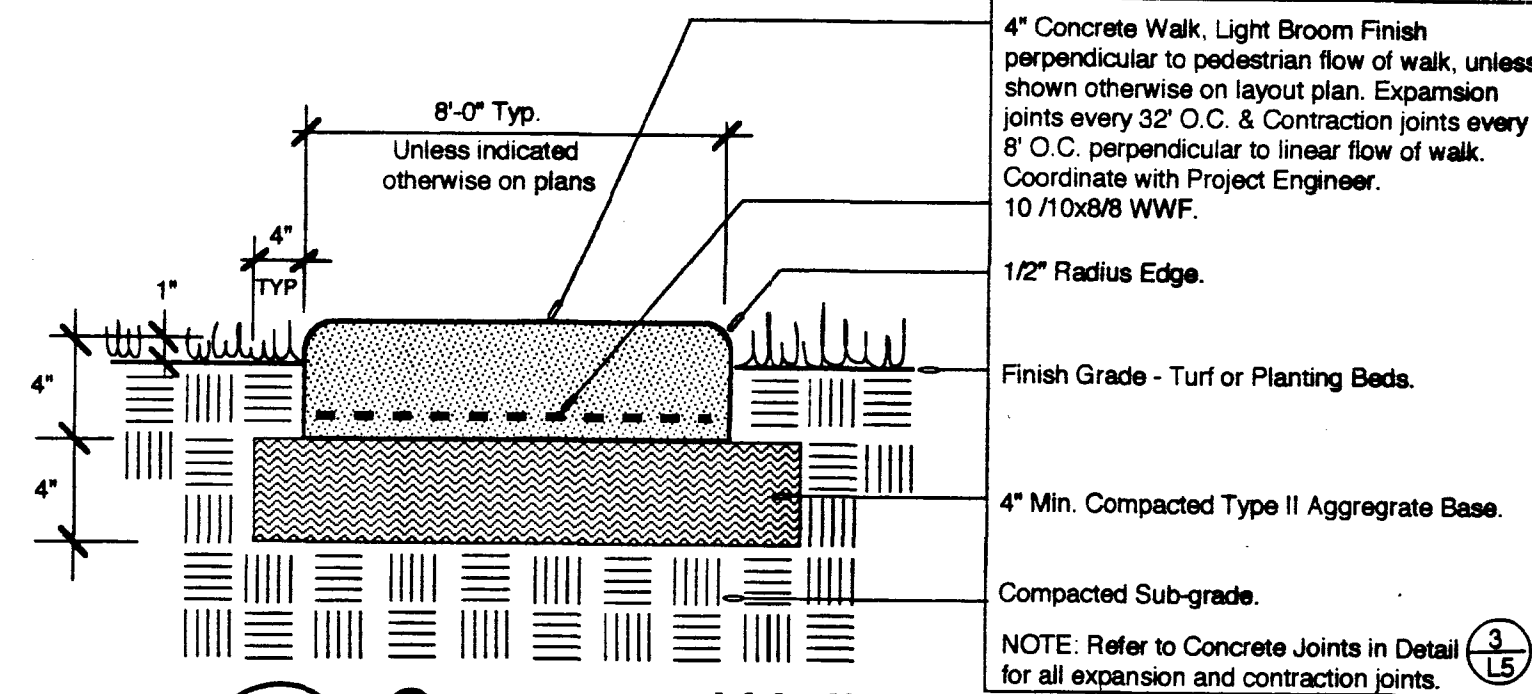

4 Concrete Walk Detail
L5

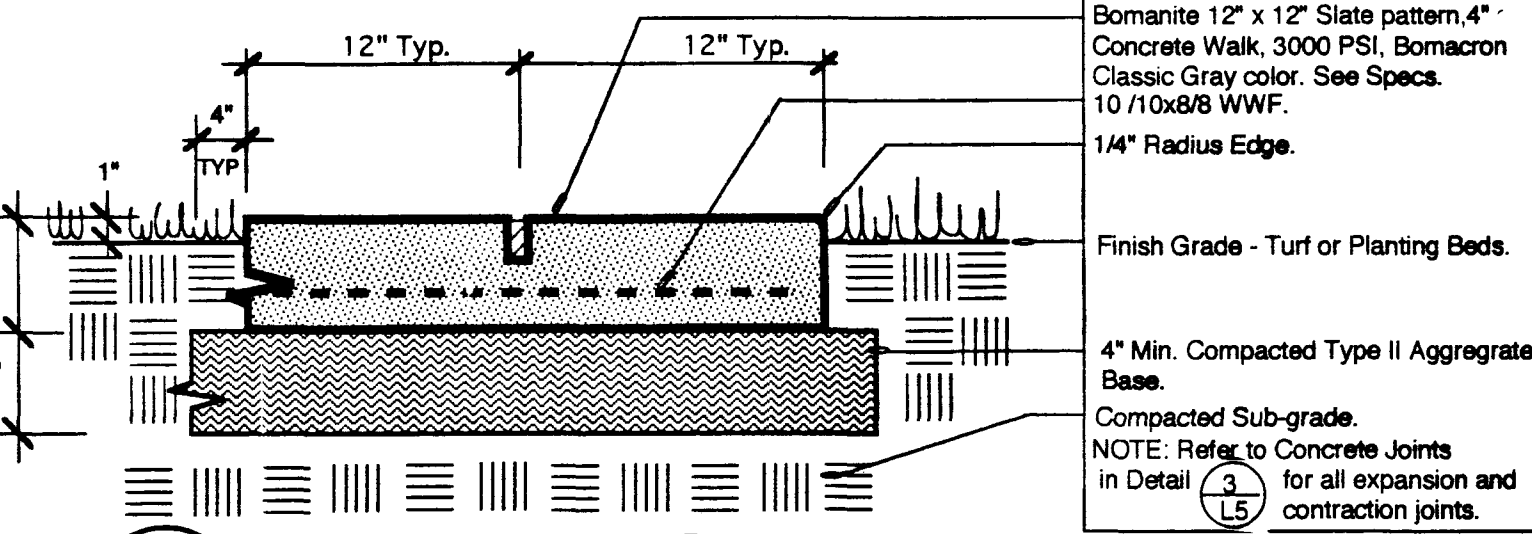

5 Enhanced Concrete Paving
L5

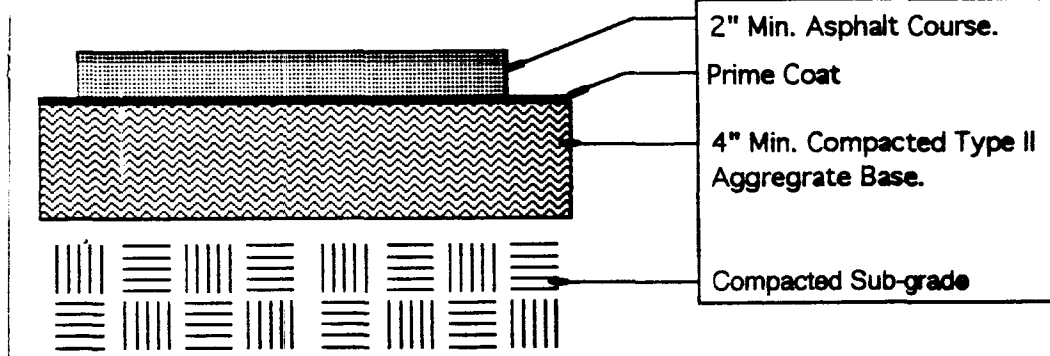

6 Asphalt Parking Lot
L5



1 Gravity Retaining Wall with Walk & Fenders




2 Bike Rack



3 Bike Loop



4 Post & Chain Fence

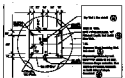

5 Volleyball Area Layout



6 Volleyball Post



7 Bench - 1 & Trash Receptacle



8 Bench - 2
























16 Gravity Retaining Wall



17 Parking Lot Curb



18 Integral Concrete Curb/Walk Detail



19 Concrete Joints



20 Concrete Walk Detail



21 Reinforced Concrete Retaining



22 Asphalt Parking Lot

