

MATCHLINE STATION 14+00
SHEET C4.05

ATWOOD AVENUE

CHEYENNE AVE.

BUFFALO DRIVE


SCALE: 1" = 60' HORIZ.
1" = 3' VERT.

Call before you Dig.

1-800-227-2608
UNDERGROUND SERVICE AGENCY

TEMPORARY ACCESS ROAD

MARTIN & MARTIN assumes no responsibility for utility locations. The utilities shown on this drawing have been plotted from the best available information. It is, however, the contractor's responsibility to field verify the location of all utilities prior to the commencement of any construction.

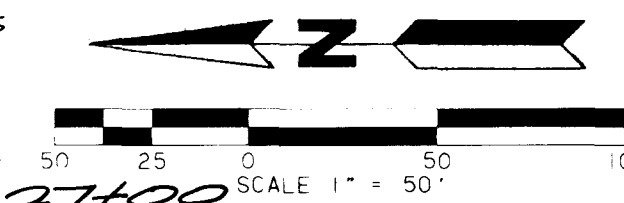

14+00 15+00 16+00 17+00 18+00 19+00 20+00 21+00 22+00 23+00 24+00

2370
2365
2360
2355
2350

2370
2365
2360
2355
2350

EXIST. GRADE @ E
(SEE NOTE 1)

REVISION	DATE	BY
1. ADDED SIGNAGE, WALKWAY, STRIPPING & REVISED PAVEMENT WIDTH	4.4.90	J.D.
2. ELIMINATED PAVEMENT ATWOOD TO CHEYENNE, REVISED PAVEMENT TO MATCH FUTURE FROM L.R. NELSON PLANS, MOVED ASPHALT WALKWAY	5.7.90	J.R.D.
3. ADDED SIGNS	6.19.90	J.R.D.
4. REVISED SIGNAGE PER (CLY)	11.30.90	M.L.H.

THESE DRAWINGS AS INSTRUMENTS OF SERVICES ARE AND SHALL REMAIN THE PROPERTY OF THE ARCHITECT.

THESE DRAWINGS ARE NOT TO BE SCALED



PROJECT NO. 0403	DATE 10/23/89
DESIGNED BY M. HEDGE	CHECKED BY R. YOUNG
DRAWN BY R. YOUNG	SUBMITTED BY J. DAVIS
DATE 10/23/89	PROJECT NO. 0403

MARTIN & MARTIN
CIVIL ENGINEERS
1701 S. CHARLESTON BLVD.
LAS VEGAS, NEVADA 89102
PHONE (702) 386-8005

CLARK COUNTY SCHOOL DISTRICT
SPECIAL PROJECTS - 4260 EUCALYPTUS ANNEX 799-5025 LAS VEGAS, NEVADA 89121

DOROTHY EISENBERG ELEMENTARY SCHOOL
BUFFALO DRIVE ACCESS ROAD PLAN PROFILE

PROJECT NO. 23
C4.05
715-68

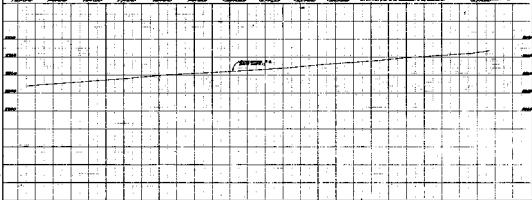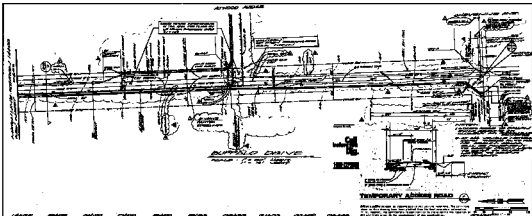

