
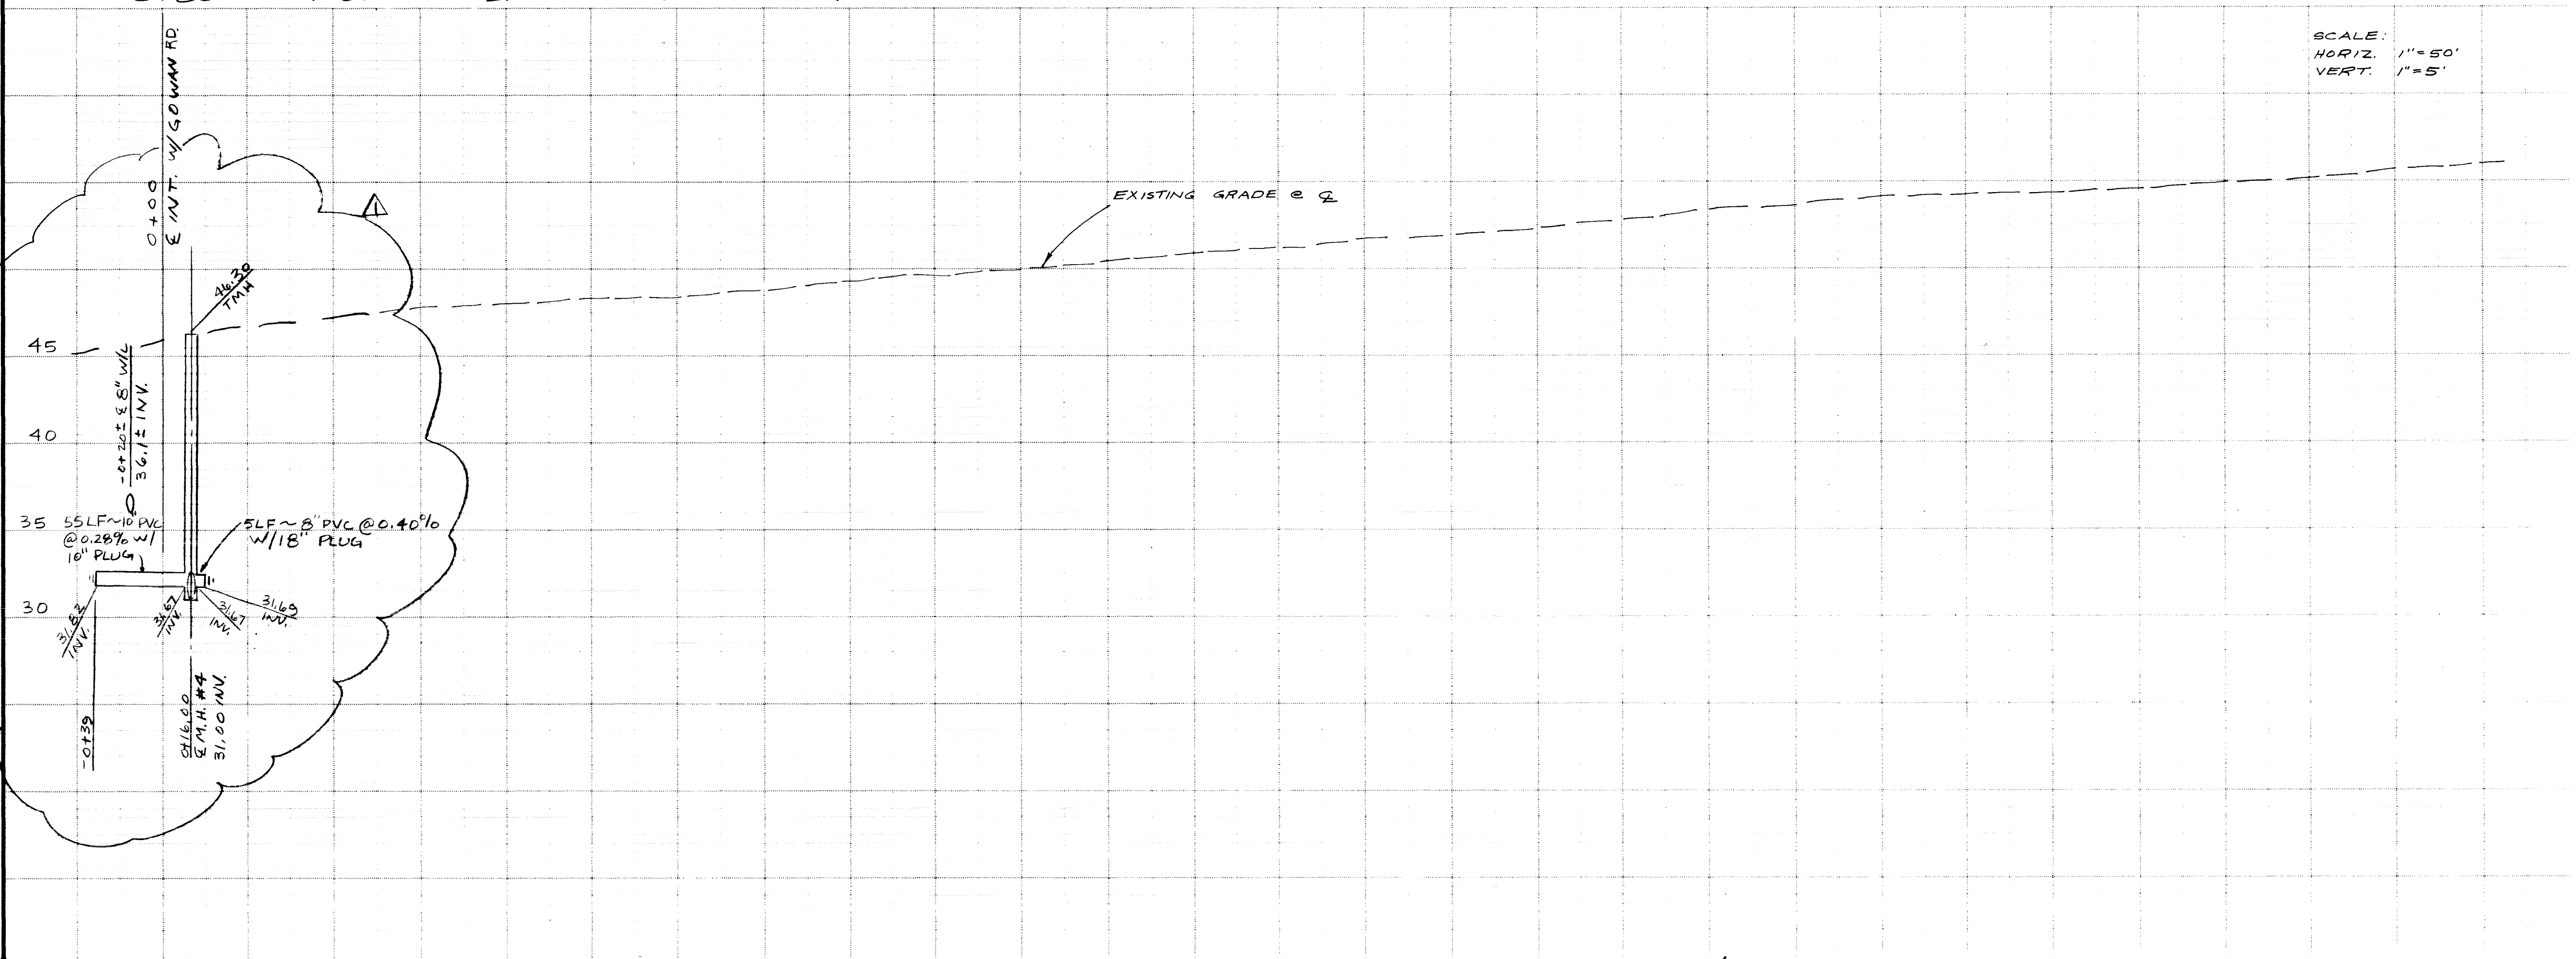


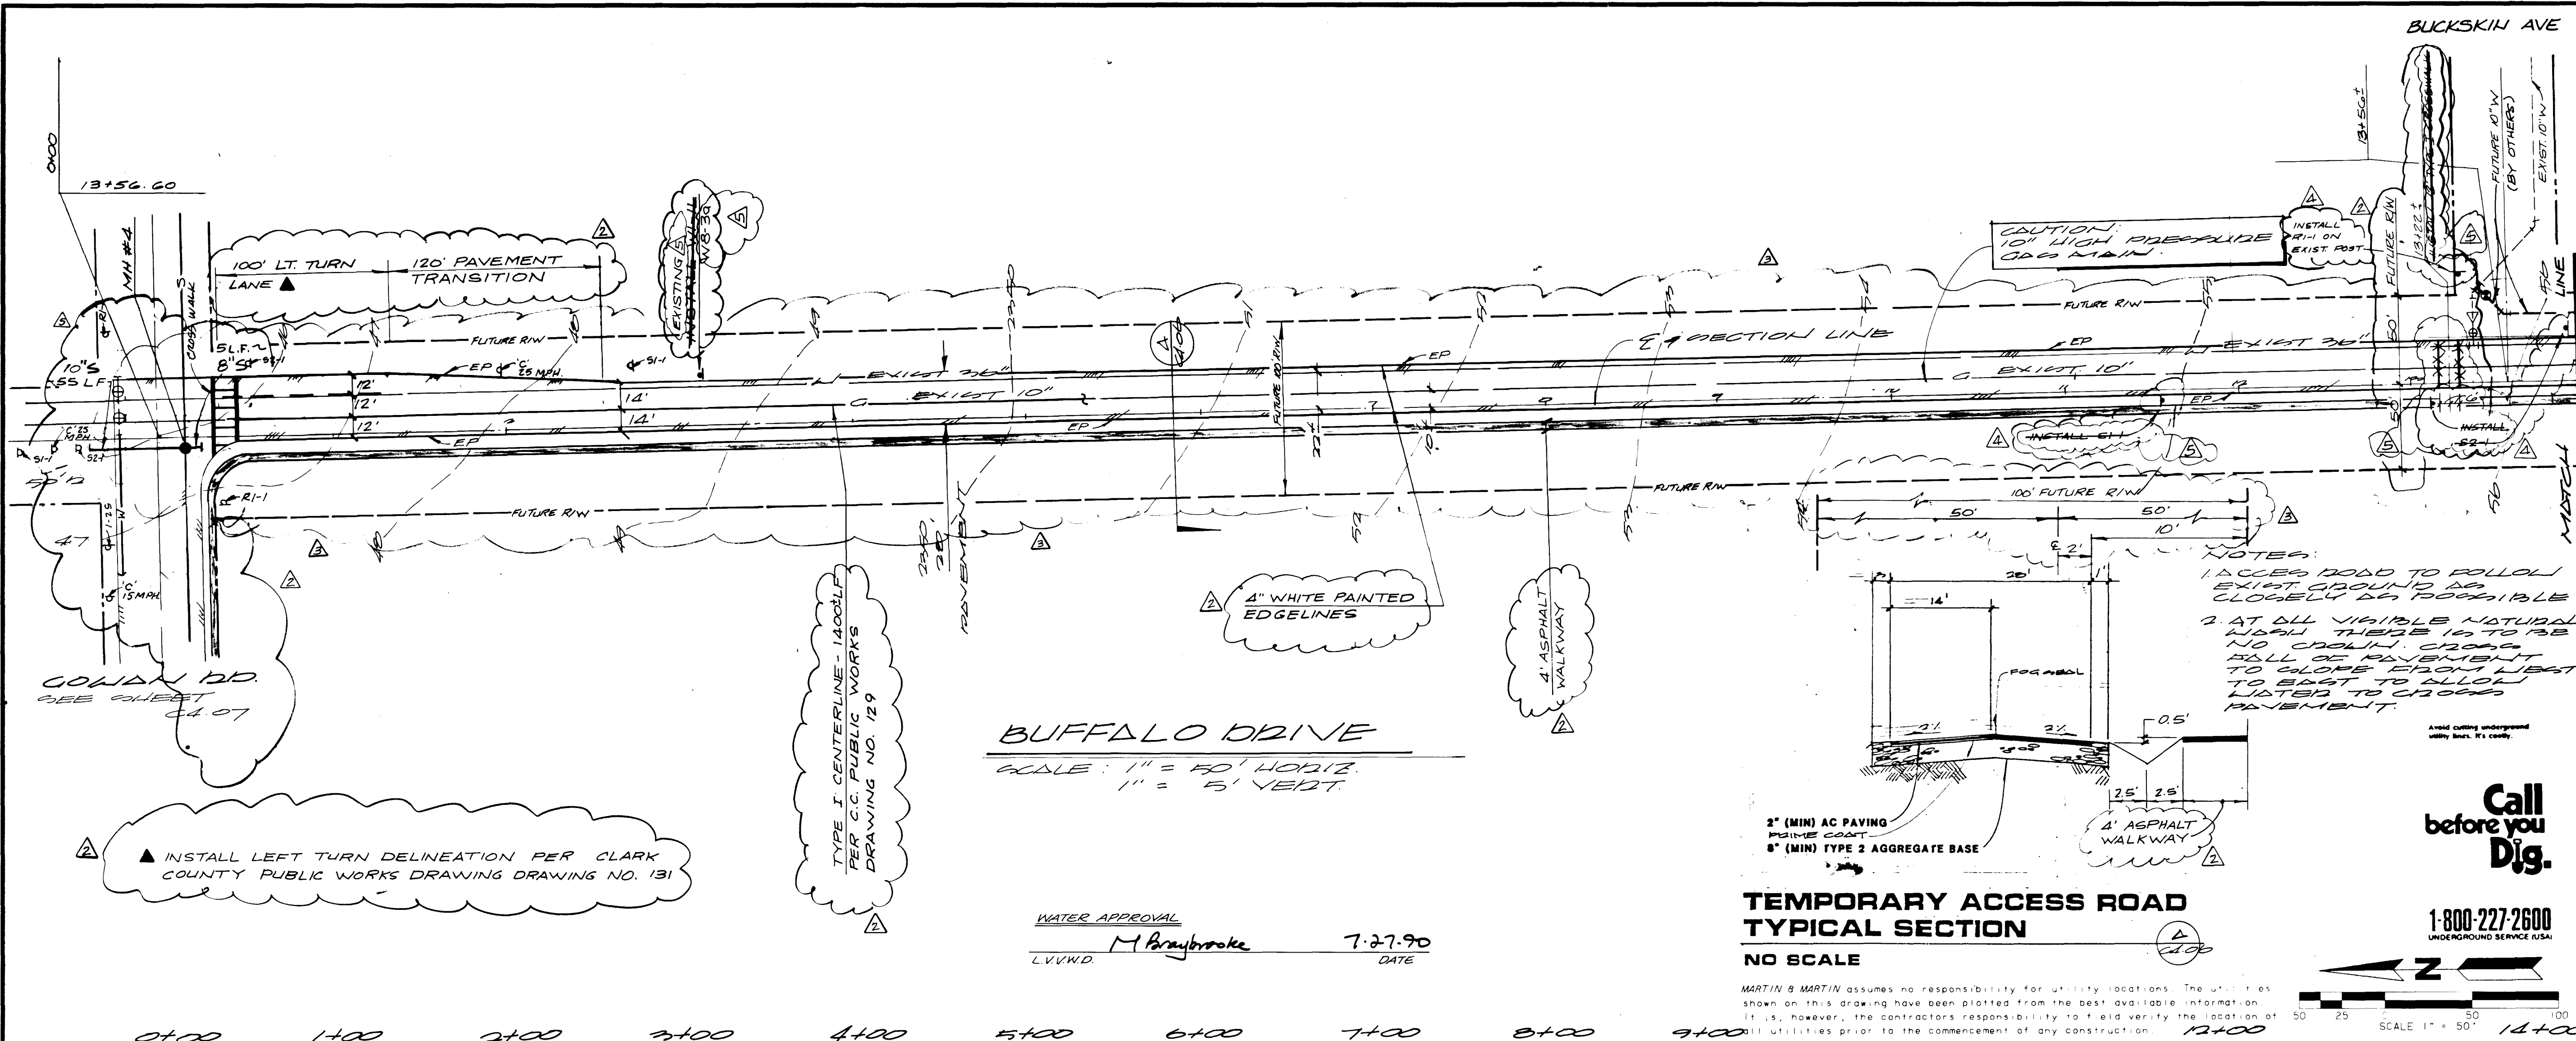

REV	DESCRIPTION	DATE	BY
▲	ADD SEWER PROFILE	2/18/89	MLH
	REVISE P.V.M.T. WIDTH ADD		
	STIPPLING & SIGNAGE, MODIFY		
	INTERSECTION SOWAN RD &		
	BUFFALO DRIVE	4.4.90	W.P.
	MOVED PAVEMENT & ASPHALT TO THE EAST SIDE. ADD FUTURE GAS LINE. ADD FUTURE WATER FROM L.R. NELSON ENGINEERS	6.7.90	J.D.
	ADD SIGNS	6.17.90	J.D.
▲	REVISED SIGNAGE FOR (CLV)	11/30/90	N.L.N.

**Call
before you
Dig.**

1-800-227-2600
UNDERGROUND SERVICE (USA)


SCALE:
HORIZ. 1" = 50'
VERT. 1" = 5'

THESE DRAWINGS AS INSTRUMENTS OF SERVICES ARE AND SHALL REMAIN THE PROPERTY OF THE ARCHITECT

THESE DRAWINGS ARE NOT TO BE SCALED

SCSD PROJECT NO	0403
CCSD REVIEW	
APPROVED BY	
DATE	
DATE	10/23/89
DRAWN BY	R. YOUNG
CHECKED BY	J. DAVIS
SUBMITTAL	
DATE	
BY	

MARTIN & MARTIN
CIVIL ENGINEERS
1701 W. CHARLESTON BLVD.
SUITE 420
LAS VEGAS, NEVADA 89102
PHONE (702) 796-0006

 

CLARK COUNTY SCHOOL DISTRICT



DOROTHY EISENBERG ELEMENTARY SCHOOL

DRAWING TITLE
BUFFALO DRIVE ACCESS ROAD PLAN PROFILE

SHEET NO 3

C4.06
715-68

28-C-180 715-68

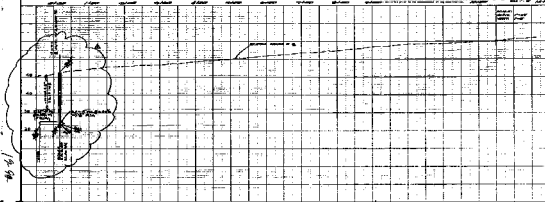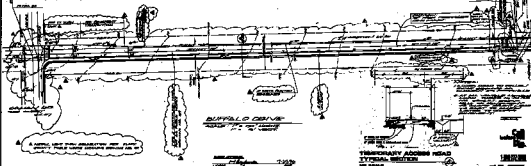





CLARK COUNTY SCHOOL DISTRICT
BUFFALO DRIVE ACCESS ROAD PLANT

C4.06
