
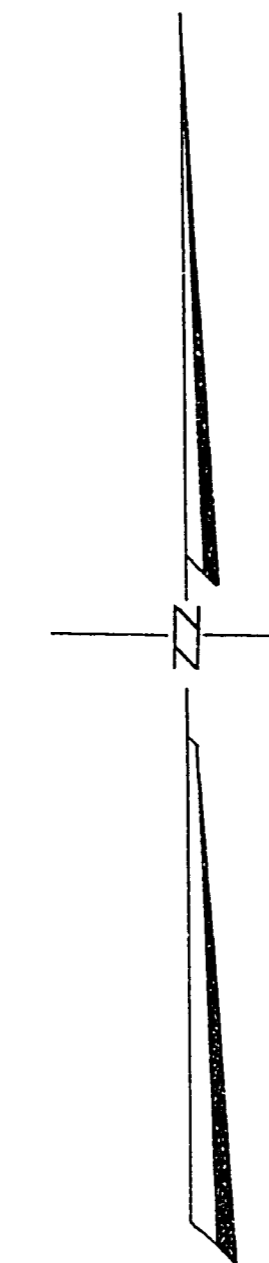


DAWSON PARK

TRACT N^o 3 UNITS N^o 1&2

BEING A PORTION OF THE SOUTH ONE HALF
OF SEC. 1 T.21S. R.61E. M. D. B. & M.

CITY OF LAS VEGAS COUNTY OF CLARK STATE OF NEVADA

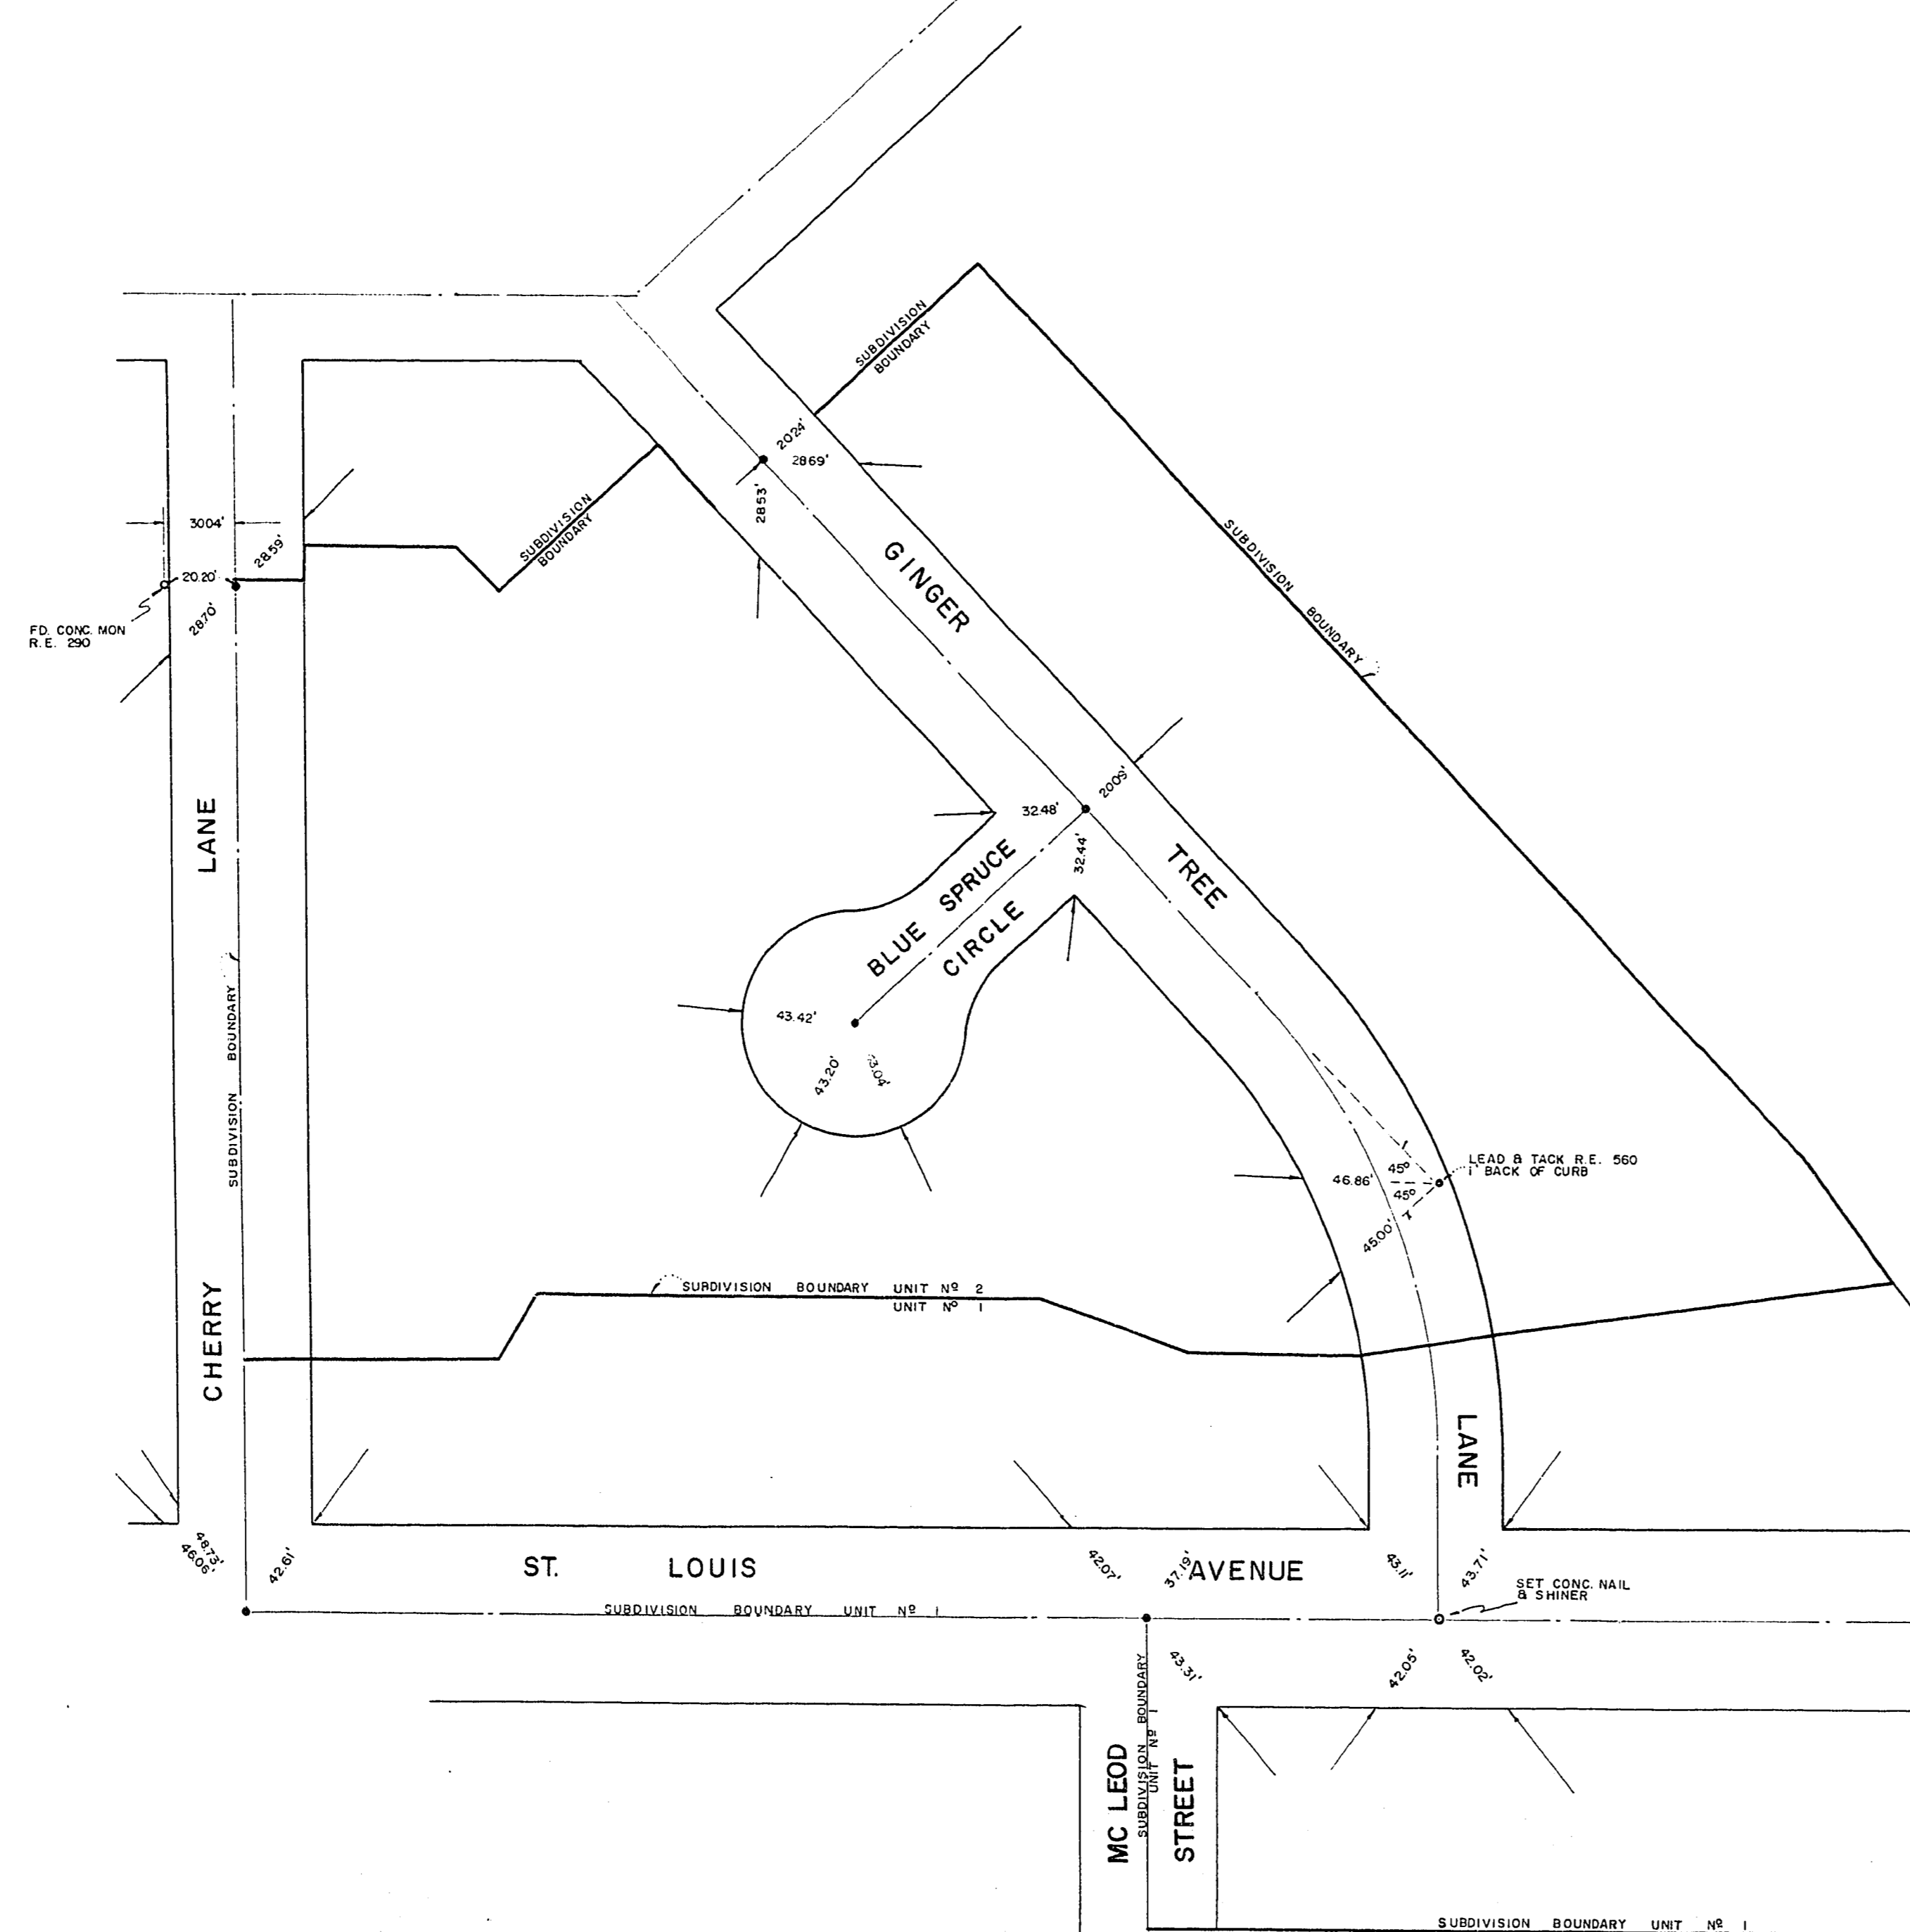

SCALE IN FEET



NOTE

TIES ARE MARKED BY (X) CUT IN TOP OF CURB
•..... SET CONCRETE MONUMENT

MONUMENT TIES
DAWSON PARK
TRACT N^o 3 UNITS N^o 1&2

DESIGNED BY _____	SCALE: AS SHOWN	DATE: FEB 3, 19 50	SHEET 1
DRAWN BY S.E.B.	TYSON ENGINEERING COMPANY CONSULTING ENGINEERS 1209 SOUTH "A" STREET LAS VEGAS, NEV.		OF 1 SHEETS
CHECKED BY B.L.V.			

36-30 058-12203-13