


# DEL REY PLAZA

MONUMENT  
TIE MAP

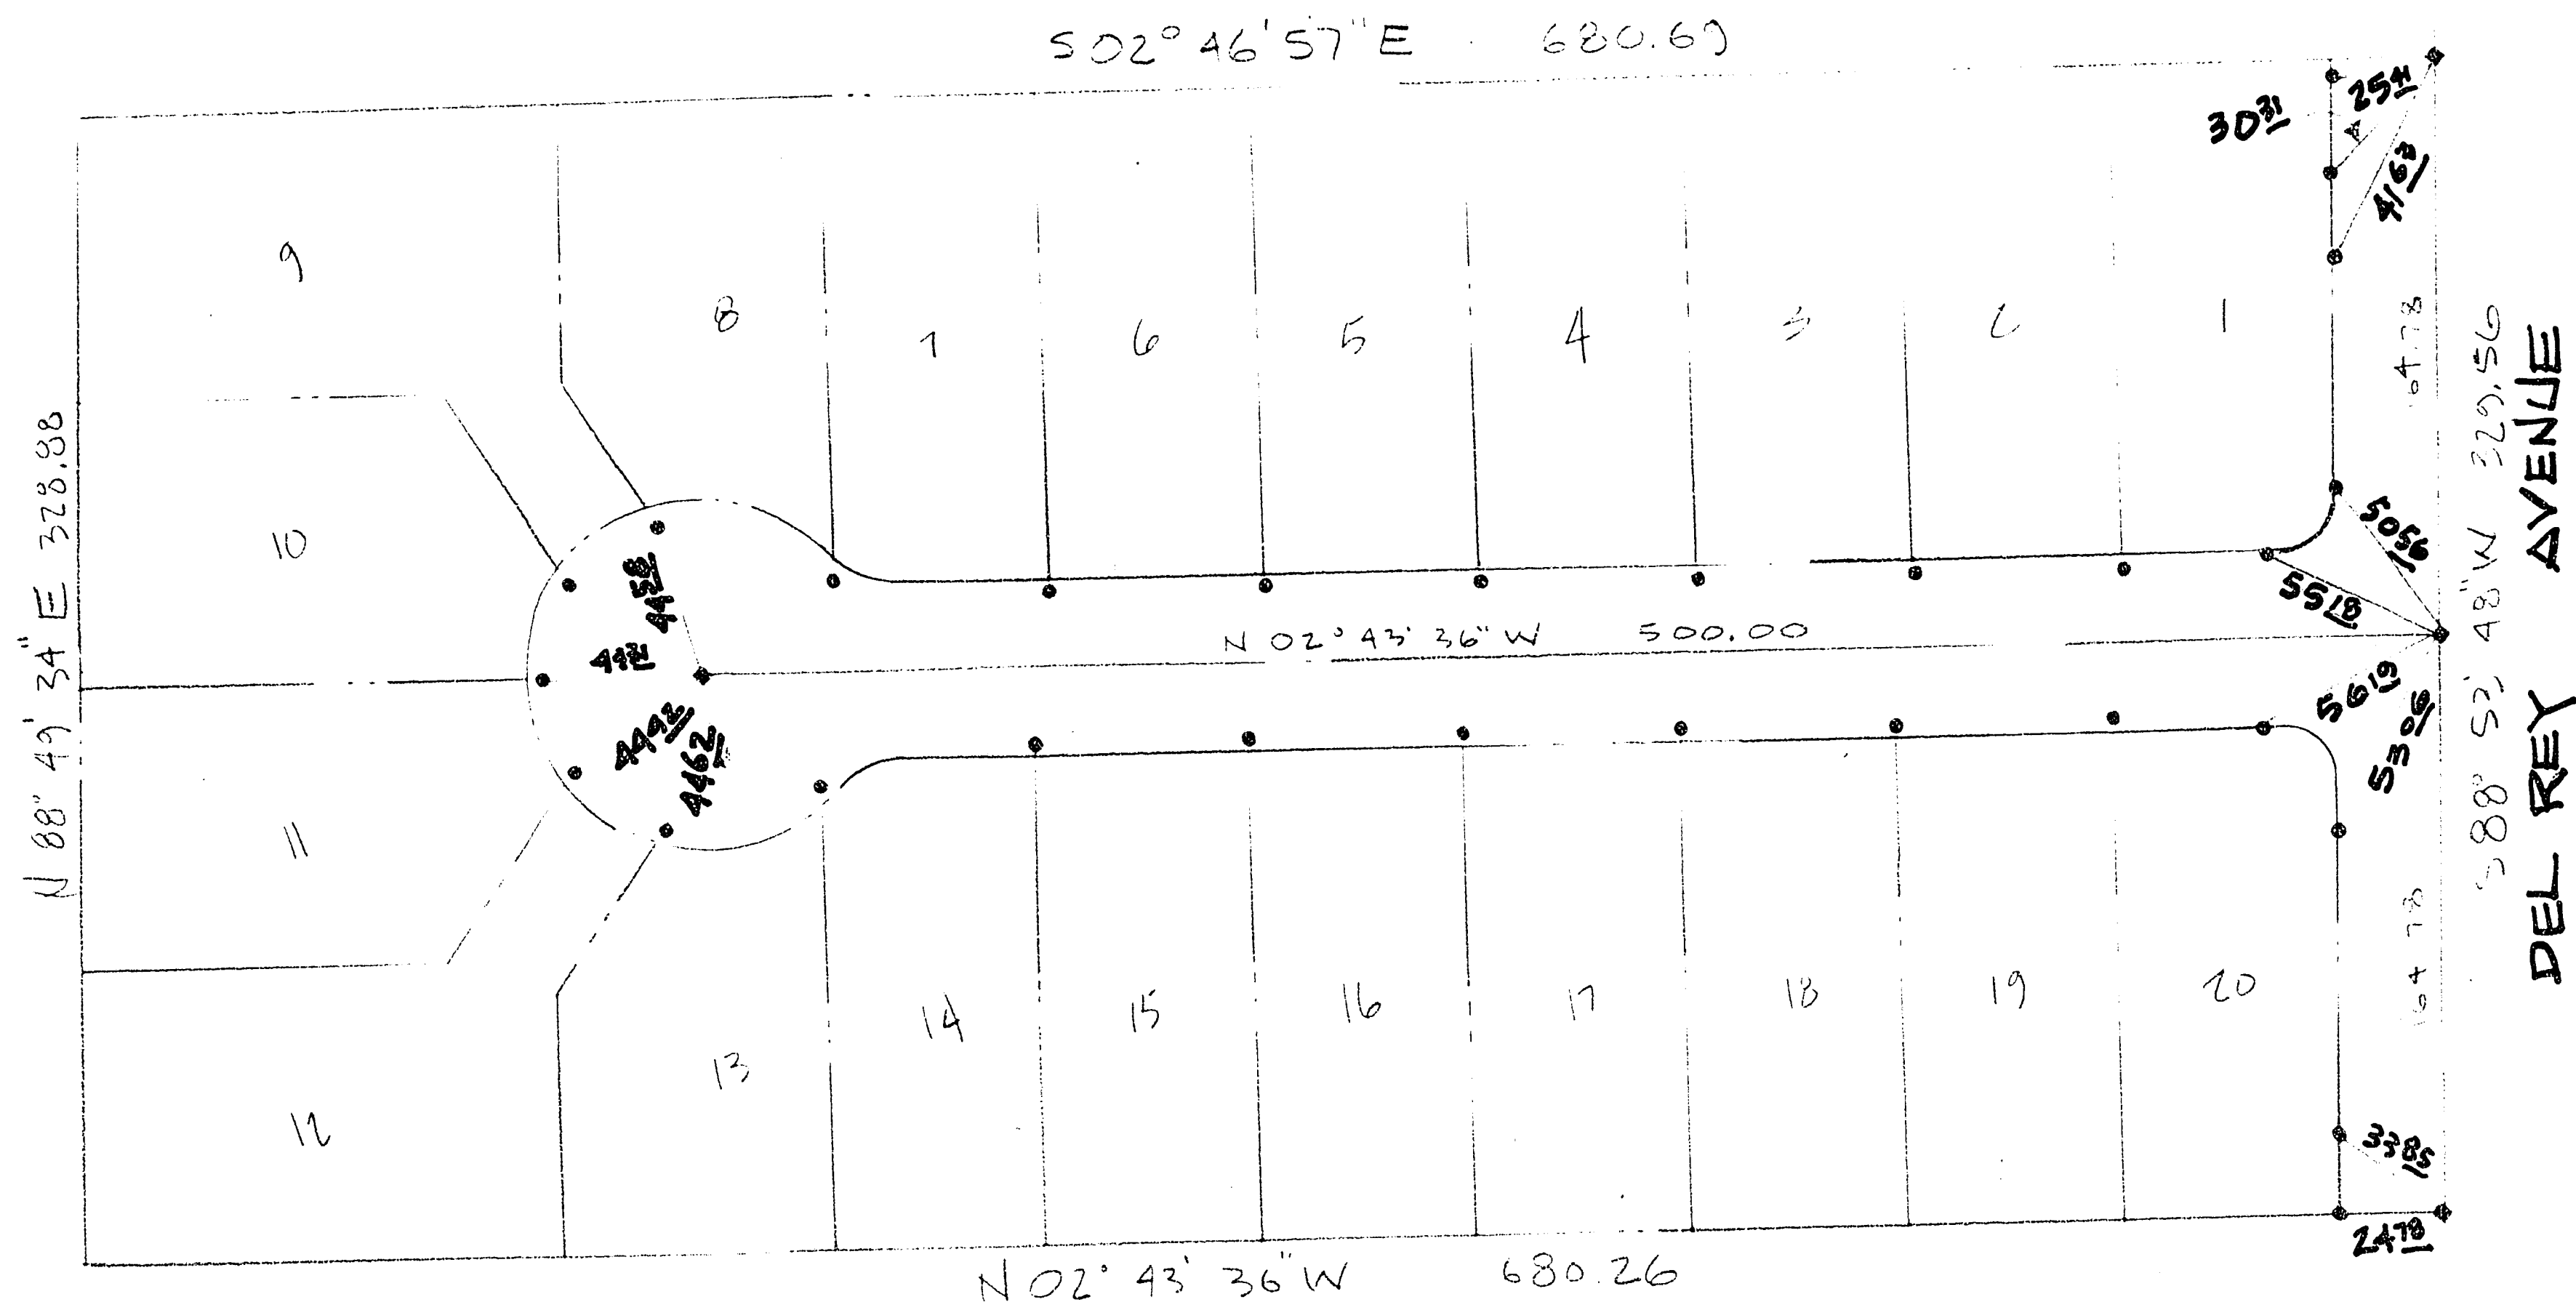


LEGEND:

- ◆ SET CONC MON
- SET N&S IN TC (RADIAL WHERE APPLICABLE)

I, BORIS NARIZNY, A REGISTERED LAND SURVEYOR IN THE STATE OF NEVADA HEREBY CERTIFY THAT THIS MAP REPRESENTS A SURVEY PERFORMED UNDER MY DIRECT SUPERVISION. THE MONUMENTS SHOWN ARE OF THE CHARACTER & POSITION INDICATED.

RAINBOW

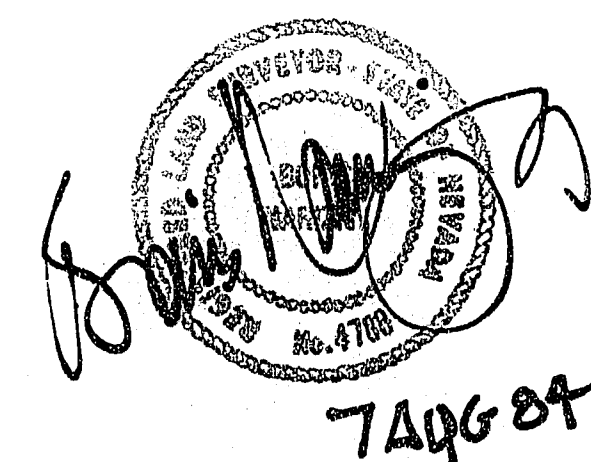

BORIS NARIZNY  
RLS 4788

SCALE 1"=40'

(702) 362-2850

DEL REY PLAZA NW $\frac{1}{4}$ NW $\frac{1}{4}$ SEC 2 T21S R60E M.D.M. ACES ENGINEERING SUITE F 4330 W DESERT INN LAS VEGAS, NEV 89102	
--	--