

DEL REY PLAZA SUBDIVISION
BOOK 31, PAGE 54 OF
PLATS

CURVES				
NO.	DELTA	RADIUS	LENGTH	TANGENT
C1	87°36'26"	20.00'	30.58'	19.18'
C2	90°00'00"	20.00'	31.42'	20.00'
C3	87°33'07"	4.00'	6.11'	3.83'
C4	91°36'27"	4.00'	6.40'	4.11'
C5	87°33'07"	15.00'	22.92'	14.37'
C6	91°36'27"	15.00'	23.98'	15.43'
C7	88°26'52"	15.00'	23.16'	14.60'
C8	92°23'34"	15.00'	24.19'	15.64'
C9	180°00'00"	4.00'	12.57'	0
C10	180°00'00"	6.00'	18.85'	0
C11	90°00'00"	4.00'	6.28'	6.28'

TANGENTS		
NO.	BEARING	DISTANCE
T1	S 2°43'41" E	8.34'
T2	N 0°20'07" W	7.50'
T3	N 0°20'07" W	7.59'
T4	N 89°39'53" E	4.28'
T5	S 87°13'00" W	21.67'
T6	S 2°43'41" E	6.88'
T7	S 43°02'53" W	9.82'
T8	S 46°57'07" E	10.00'
T9	N 43°02'53" E	9.82'
T10	N 88°49'27" E	8.79'
T11	S 87°16'19" W	21.36'
T12	S 87°16'19" W	28.92'

- LEGEND**
- MONUMENT FOUND AS INDICATED
 - ⊕ SCRIBED " + " IN SIDEWALK
 - SET 5/8" REBAR & ALUMINUM CAP RLS 5094
 - BACK OF CURB
 - - - CENTERLINE
 - BOUNDARY OR LOT LINE
 - 3 LOT NUMBER
 - P.U.E. PUBLIC UTILITY EASEMENT
 - S.F. SQUARE FEET

NOTES


- UNLESS OTHERWISE NOTED, TIES FROM BUILDINGS TO CURBS ARE PERPENDICULAR TO CURB LINES AND TIES BETWEEN BUILDINGS ARE PERPENDICULAR TO BUILDINGS.
- TOTAL AREA = 4.810 AC ±
- TOTAL NO. OF LOTS = 11

SURVEYOR'S CERTIFICATION

I, RITA M. LUMOS, A DULY REGISTERED LAND SURVEYOR IN THE STATE OF NEVADA, DO HEREBY CERTIFY THAT STREET AND REFERENCE MONUMENTS SHOWN ON THIS MAP HAVE BEEN MEASURED AND ESTABLISHED IN THE FIELD BY ME OR UNDER MY DIRECT SUPERVISION AND COMPLETED ON THE 1ST DAY OF MAY, 1986.

BASIS OF BEARINGS

THE WEST LINE OF THE NW 1/4 OF SECTION 2, T21S, R60E, M.D.M., BEARS N 2°40'13" W, AS SHOWN BY A RECORD OF SURVEY RECORDED JUNE 10, 1980 IN FILE 36, PAGE 8 OF SURVEYS, OFFICIAL RECORDS OF CLARK COUNTY, NEVADA.

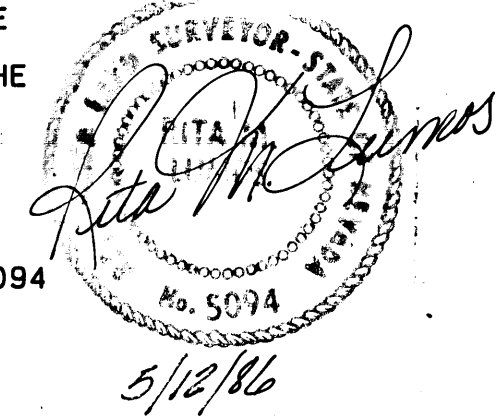

RITA M. LUMOS
REGISTERED LAND SURVEYOR NO. 5094

MONUMENTATION MAP
EXECUTIVE PARK
A PLANNED UNIT DEVELOPMENT

POR E1\2 NW1\4 NW1\4 NW1\4 SEC. 2, T21S, R60E,
M.D.M.
LAS VEGAS, NEVADA

JOB NO. 2-354-001-051
DESIGNED RKF
DRAWN HP 1000 & RKF
COMP.
CHECKED
DATE MAY, 1986
SHEET NO. 1 OF 1 SHEETS

SEA ENGINEERS/PLANNERS
SPARKS, NEVADA
LAS VEGAS, NEVADA