

BOOK  
890901

00347


CURVE DATA				
Curve No.	Δ	R	L	T
1	87° 34' 07"	15.00'	22.93'	14.38'
2	92° 12' 49"	15.00'	24.14'	15.59'
3	87° 34' 07"	15.00'	22.93'	14.38'
4	92° 25' 53"	15.00'	24.20'	15.65'
5	54° 39' 14"	15.00'	14.31'	7.76'
6	289° 18' 28"	45.50'	229.75'	-
7	52° 19' 21"	45.50'	41.47'	22.30'
8	92° 25' 53"	45.50'	73.40'	47.47'
9	74° 27' 45"	45.50'	59.13'	34.58'
10	70° 11' 29"	45.50'	55.74'	31.97'
11	65° 38' 12"	45.50'	52.12'	29.34'
12	79° 01' 02"	45.50'	62.75'	37.62'
13	87° 34' 07"	45.50'	69.54'	43.61'
14	57° 05' 07"	45.50'	45.33'	24.75'

# DESERT WIND


GOVERNMENT LOT 43 IN THE NE<sup>4</sup> OF SECTION 3, T.21S., R.60E., M.D.M.  
LAS VEGAS NEVADA

**LEGEND:**

- FOUND MONUMENT RLS 2984 UNLESS OTHERWISE NOTED
- SET MONUMENT RLS 3340
- ⑤ LOT NUMBER (0 TOTAL LOTS)
- FRONT & SIDE YARD SET BACK LINE
- ◆ REBAR & ALUM. CAP STAMPED WITH "RM" AND DISTANCE SHOWN
- BRASS CAP IN TOP OF CURB STAMPED WITH "RM" AND DISTANCE SHOWN

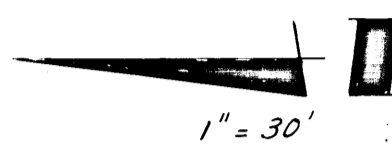


PM 49/11

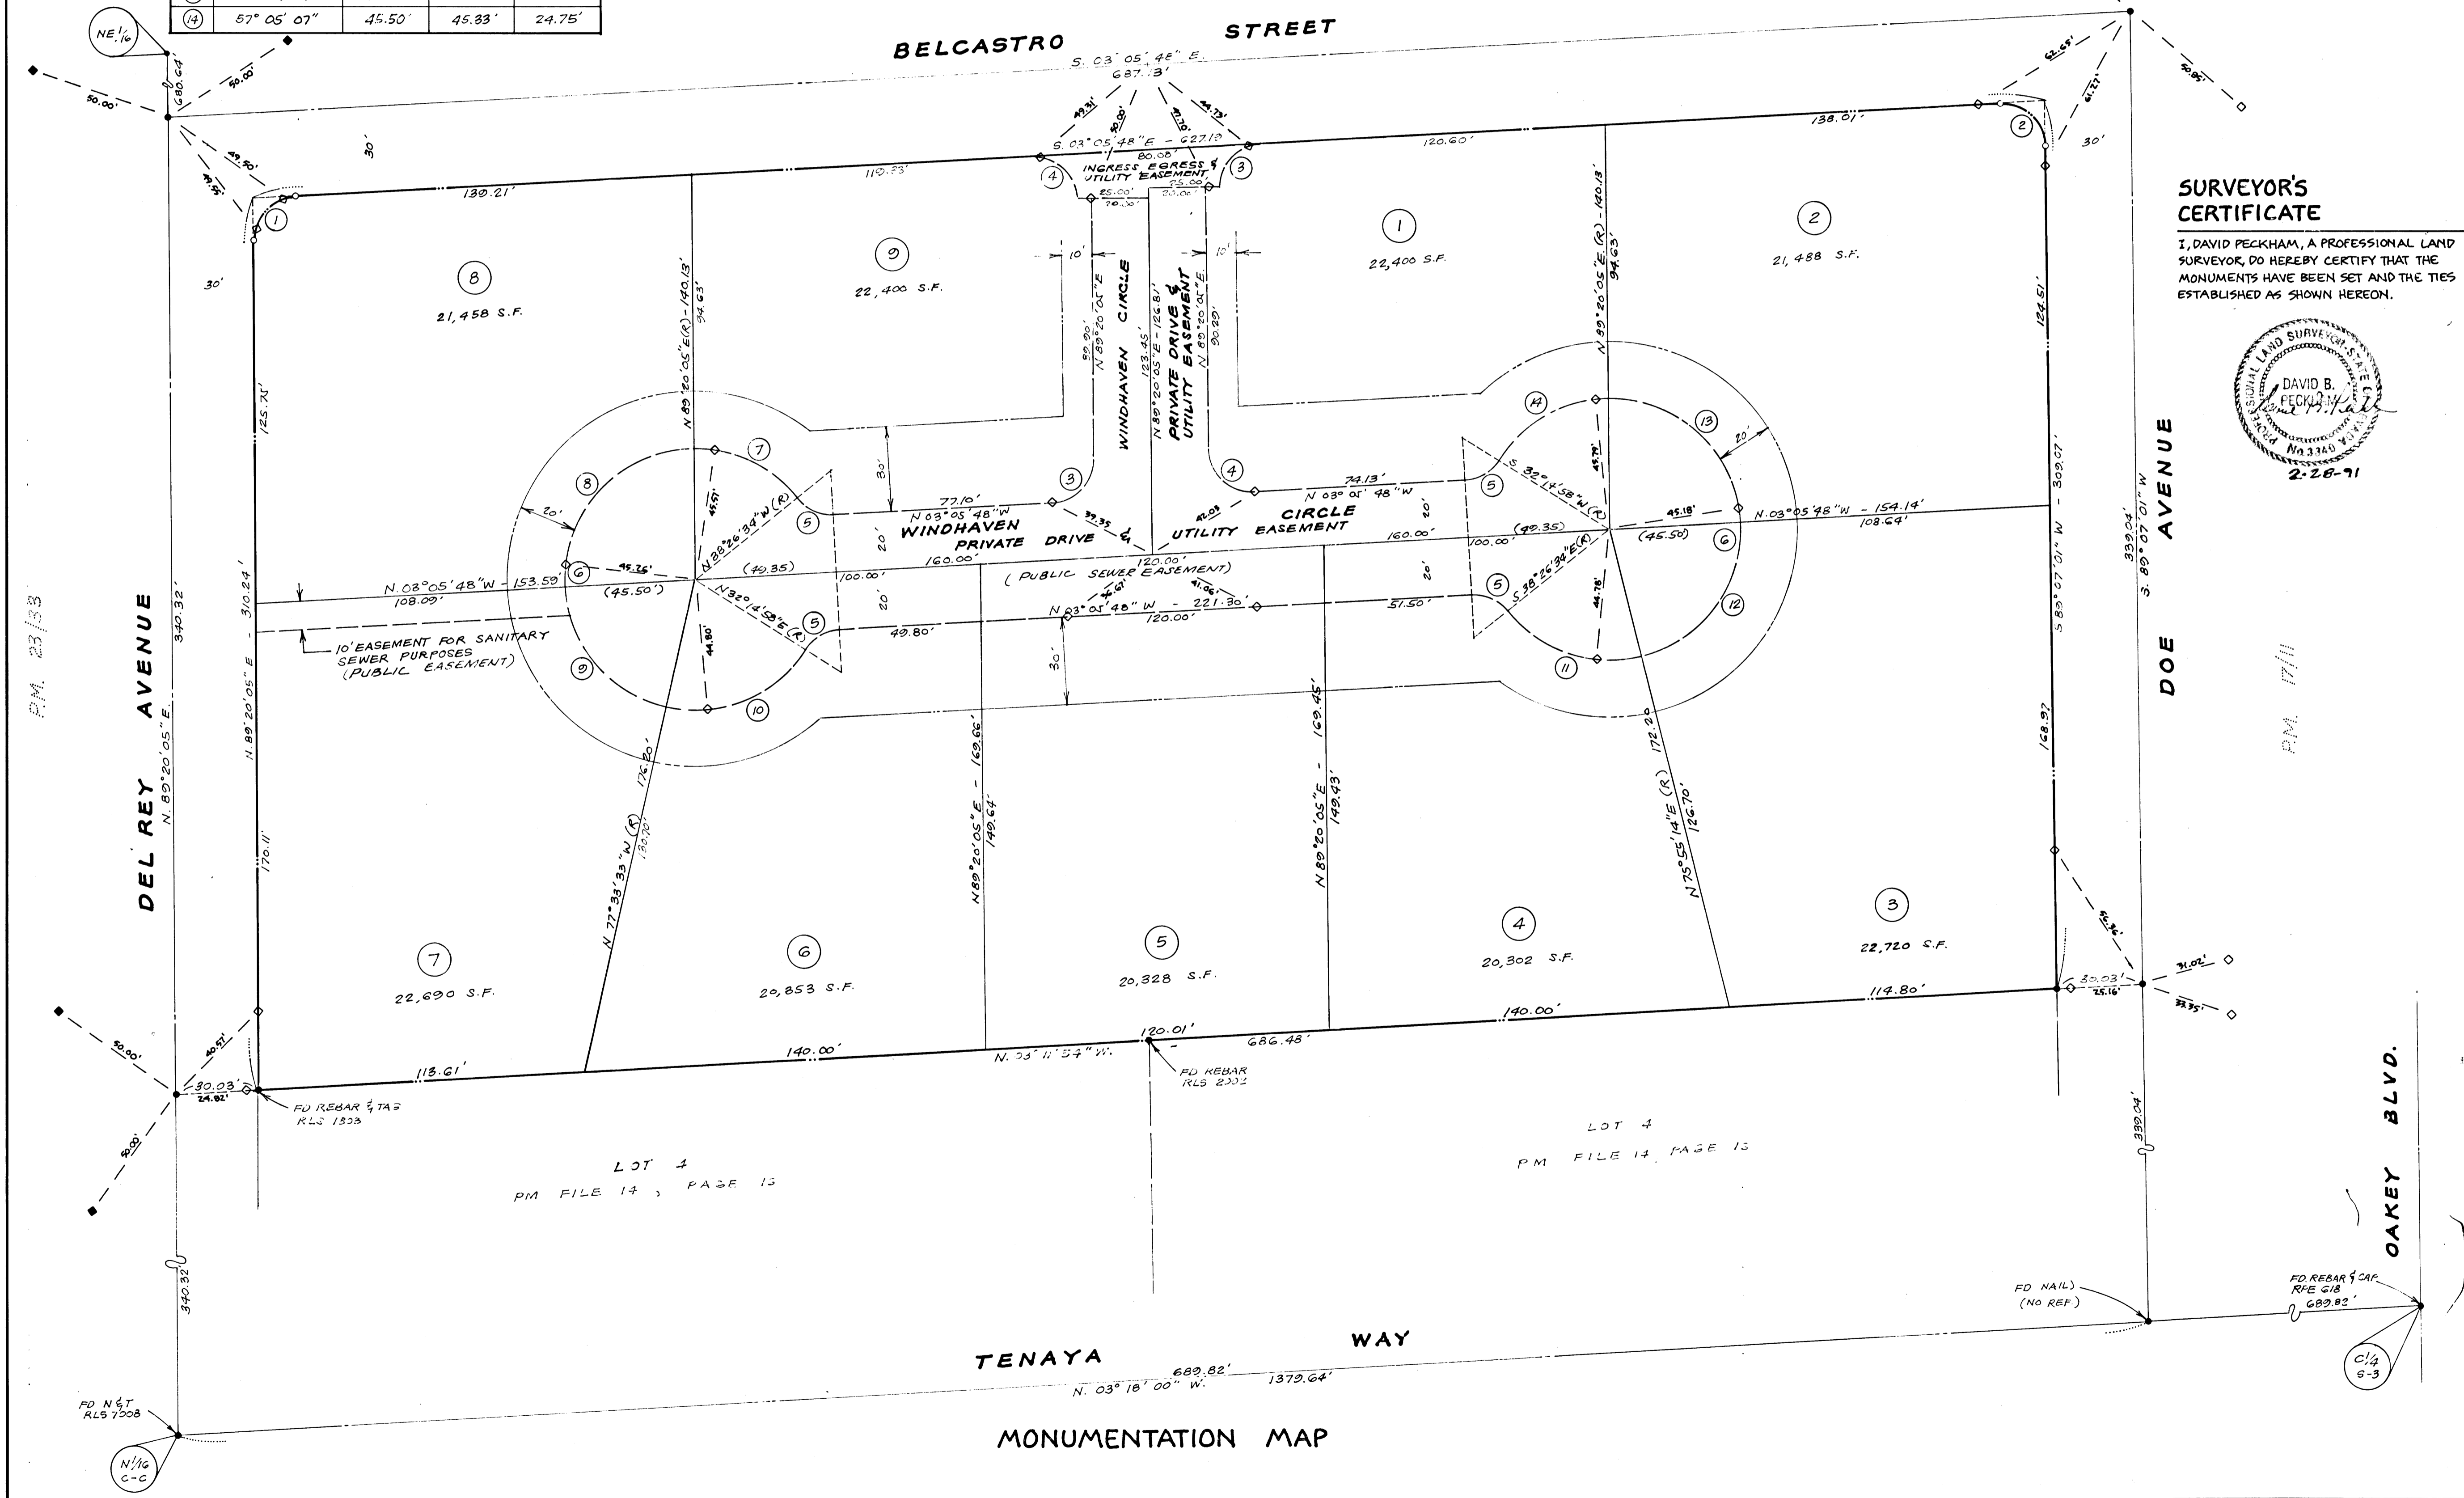

**SURVEYOR'S CERTIFICATE**

I, DAVID PECKHAM, A PROFESSIONAL LAND SURVEYOR, DO HEREBY CERTIFY THAT THE MONUMENTS HAVE BEEN SET AND THE TIES ESTABLISHED AS SHOWN HEREON.

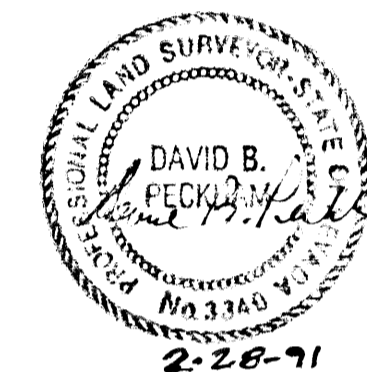

DOE AVENUE

OAKLEY BLVD.

TENAYA WAY

MONUMENTATION MAP

LOT 4  
PM FILE 14 PAGE 13

LOT 4  
PM FILE 14 PAGE 13