23-4-133

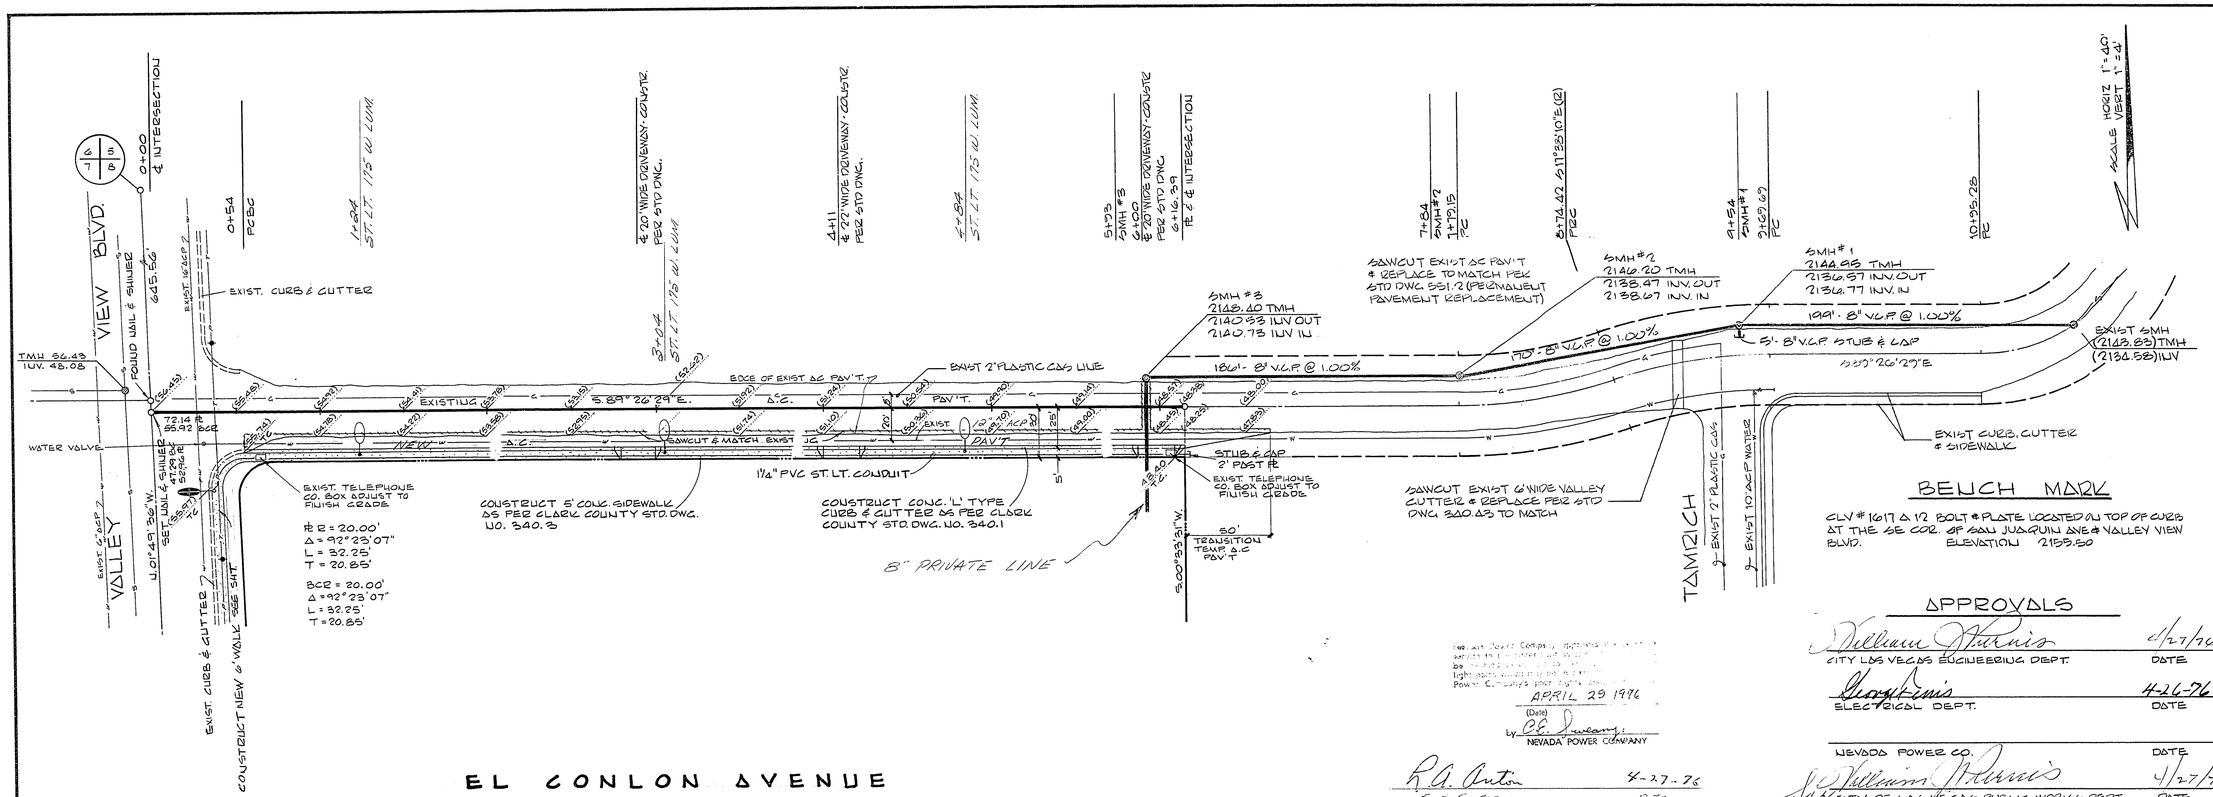

EL CONLON AVENUE

APRIL 29 1976
(Date)
by C.E. Sweany
NEVADA POWER COMPANY

R.A. Anton
Supt. Sig. Main
4-27-76
Date

APPROVALS

William J. Purvis — 4/27/76
CITY LAS VEGAS ENGINEERING DEPT. — DATE

George Lewis — 4-26-76
ELECTRICAL DEPT. — DATE

NEVADA POWER CO. — DATE

for William J. Purvis — 4/27/76
CITY OF LAS VEGAS PUBLIC WORKS DEPT — DATE

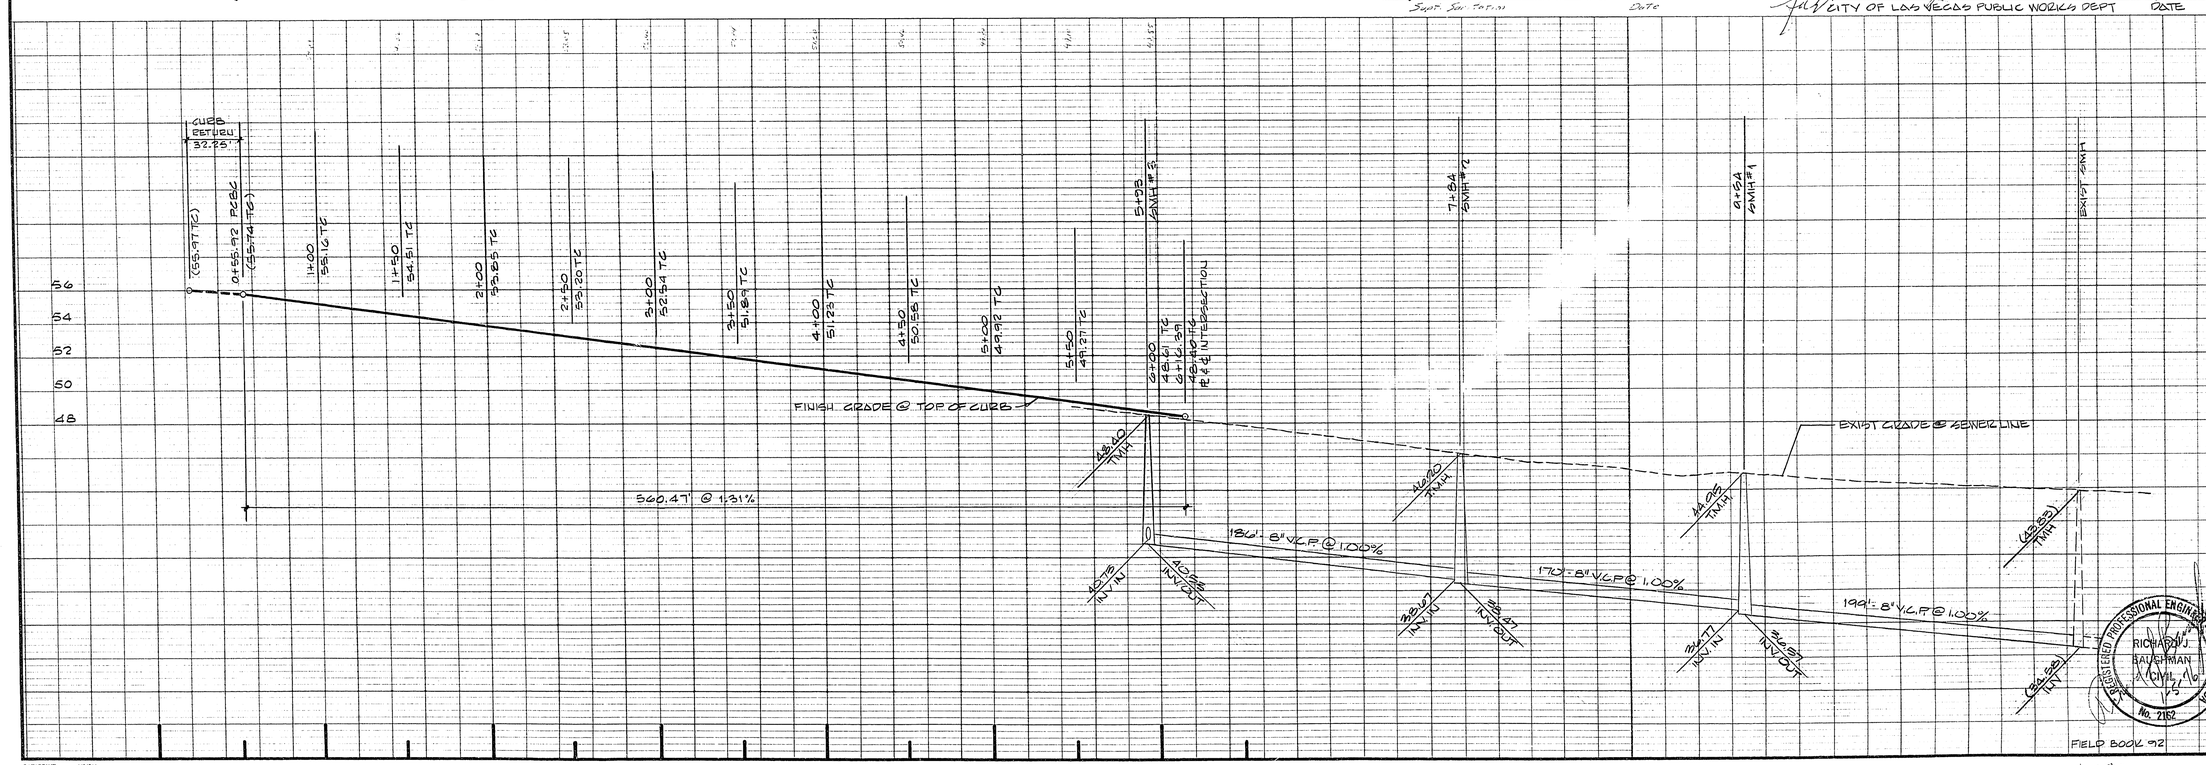

DATE	NO	REVISIONS	APP'D
11-76	1	REVISED EXISTING SEWER LINE	

PREPARED FOR:
CONSYST CONSTRUCTION INC.
c/o GEORGE W. GERTZ & A.I.A.
5200 W. SAHARA AVE.

DATE 2-27-76
DESIGN
DRAWN D P B
CHECK R J B
SCALE AS SHOWN

BAUGHMAN, HAUGHT & TURNER
CIVIL ENGINEERS MINING ENGINEERS
LAND SURVEYORS
2323 WEST CHARLESTON BOULEVARD 702 - 878-8771
LAS VEGAS, NEVADA 89102

STREET & STREET LIGHT DESIGN
SECTION 8, TOWNSHIP 21 SOUTH, RANGE 61 EAST, M.D.B.&M.
COUNTY CLARK NEVADA
EL CONLON AVENUE

SHEET C 1 OF 3
PROJ. NO

DATAPRINT N14266

23-4-134 107-V955