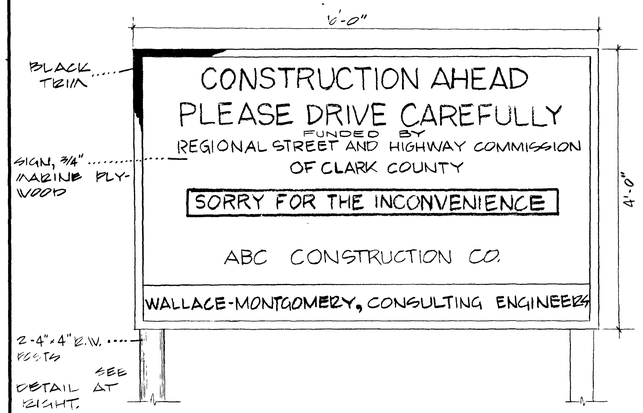

CONSTRUCTION SIGN
NO SCALE

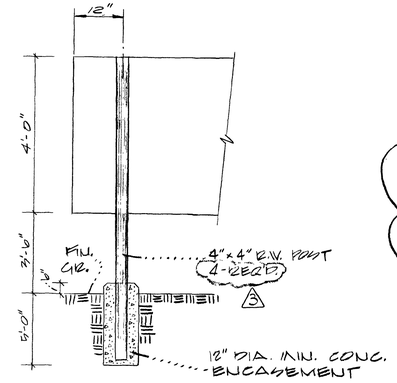

SIGN SUPPORT POST DETAIL
NO SCALE

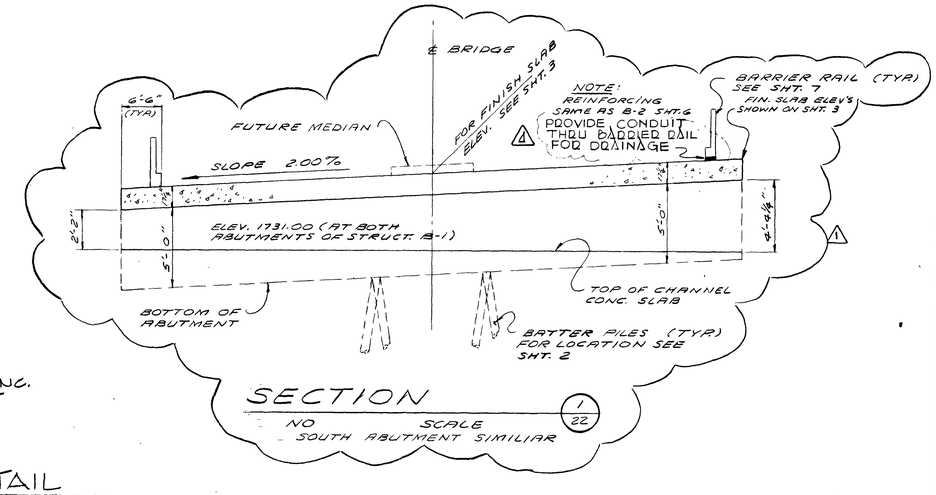

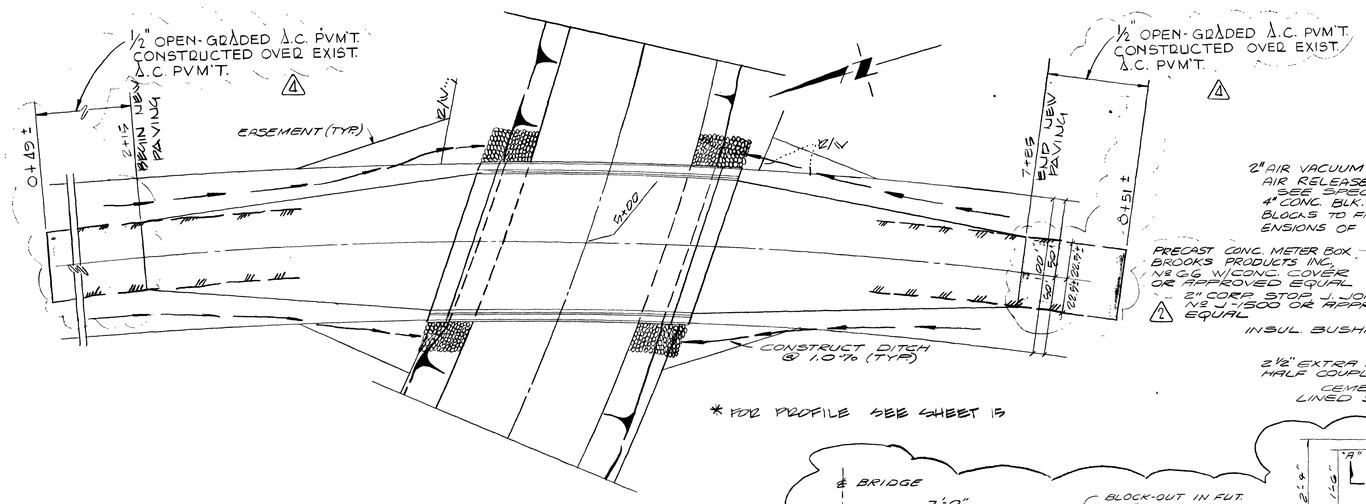

PLAN — STRUCTURE B-1
SCALE 1" = 40'-0"

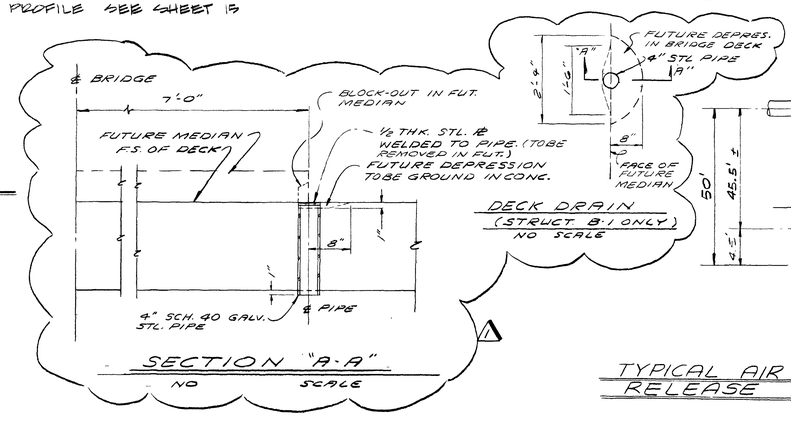

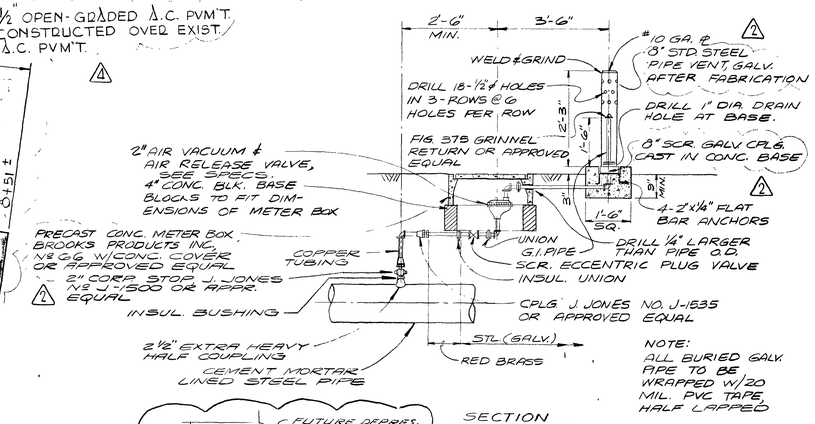

TYPICAL AIR VACUUM & AIR RELEASE VALVE ASSEMBLY
NO SCALE

REV	DATE	DESCRIPTION
	5/6/70	Added deck drain Det 15
1	1-4-74	Struct. B-1 Sec. (A)
2	1-4-74	B-DEV. PER ITEM 8 OF ADD. #1
3	5-5-75	AS-BUILT

RECOMMENDED G. C. WALLACE R.E. NO. 1815 DATE 11-8-71
MONTGOMERY ENGINEERS OF NEVADA R.E. NO. 2225 DATE 11-8-71

WALLACE - MONTGOMERY, A JOINT VENTURE
MONTGOMERY ENGINEERS OF NEVADA
G. C. WALLACE, Consulting Engineer 735-7198
735-5709
LAS VEGAS, NEVADA

REGIONAL STREET AND HIGHWAY COMMISSION, CLARK CO., NEV.
E. CHARLESTON BLVD. - BRIDGES AND CHANNEL IMPROVEMENTS

MISCELLANEOUS DETAILS

SHEET 22 OF 29 SHEETS

AS-BUILT DRAWING

327-V148