


LAS VEGAS BOULEVARD

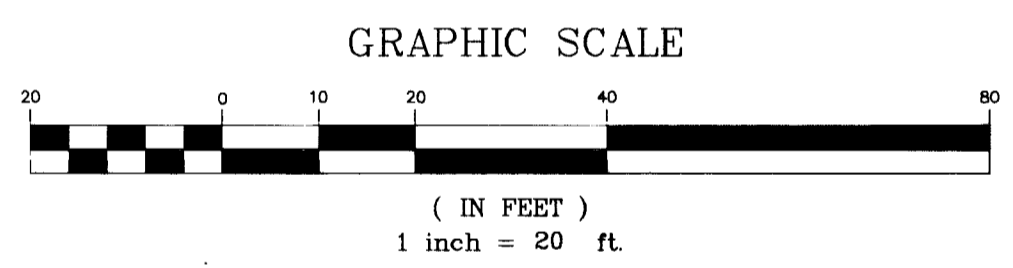


NOTE

① STREET LIGHT REMOVAL:
 CHIP FOUNDATION DOWN 18" BELOW FINISH GRADE, CUT ANCHOR RODS FLUSH, REMOVE WIRE SAUCUT SIDEWALK AT THE EXISTING JOINTS, REMOVE AND REPLACE EXISTING SIDEWALK IN FULL SECTION, COLOR AND FINISH TO MATCH EXISTING. ALL EXISTING STREET LIGHTS REMOVED SHALL BE RETURNED TO THE CITY OF LAS VEGAS YARD AT 3100 E. BONANZA ROAD. CALL 229-6331 BEFORE RETURNING TO MAKE ARRANGEMENTS. AFTER BASE REMOVAL CONNECT EXISTING STREET LIGHT CONDUIT TOGETHER PAST BASE FOR FUTURE USE.

- NOTICE**
1. CONTRACTOR SHALL REFER TO CIVIL DRAWINGS FOR ADDITIONAL CONDUIT PROVISIONS BETWEEN MEDIANS.
 2. REFER TO PALM TREE LEGEND, SHEET E-1, FOR QUANTITY AND LOCATION OF LANDSCAPE LIGHTING
 3. PROVIDE 3" INTERCONNECT CONDUIT W/FULL WIRE IN SAME TRENCH AS STREET AND LANDSCAPE LIGHTING ENTIRE LENGTH OF THIS PROJECT - PROVIDE 3" FULLBOX 500' O.C.
 4. STREET AND LANDSCAPE LIGHTING CONDUIT SHALL BE ROUTED ALONG ONE SIDE OF MEDIAN, BUT WITHIN MEDIAN. CONDUIT SHALL NOT BE ROUTED BELOW PLANTING. MAXIMUM 12" FROM BACK OF CURB ON OPPOSITE SIDE OF WATER LINES.
 5. ALL TREES SHALL NOT BE LOCATED WITHIN 10' OF STREET LIGHTS.
 6. REFER TO DWG. NO. 107-V-2288B FOR AREA SOUTH OF PROJECT.

RECORD DRAWINGS

DATE	5/2/21
REVISIONS	△ OWNER REVISIONS
DRAWN BY	CRG
CHECKED BY	DOB
DESIGNED BY	CRG
DATE	10-28-96
JOB No.	1003002
SHEET No.	E-2
POGGENMEYER DESIGN GROUP ENGINEERS LANDSCAPE ARCHITECTS PLANNERS 2801 NORTH TENAYA WAY LAS VEGAS, NEVADA 89128 (702) 255-8100	
DEPARTMENT OF PUBLIC WORKS	PROJECT: DOWNTOWN ENTRY CORRIDOR IMPROVEMENTS LAS VEGAS BLDG. REAUTHORIZATION 4TH STREET TO CHALKBOURNE BLVD.
SHEET: LIGHTING PLAN	STA 55+34.20 to 59+00
DRAWING NO. E-2	24/28

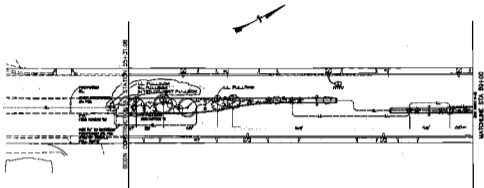

LAS VEGAS BOULEVARD









