
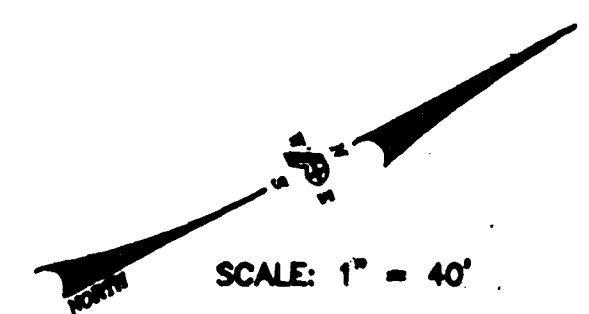


FED. RD. REG. NO.	STATE	PROJECT NO.	COUNTY	SHEET NO.
9	NEVADA	STP-604 (3)	CLARK	TC-5

PAVEMENT RE-SURFACING PHASE
(COLD MILLING)

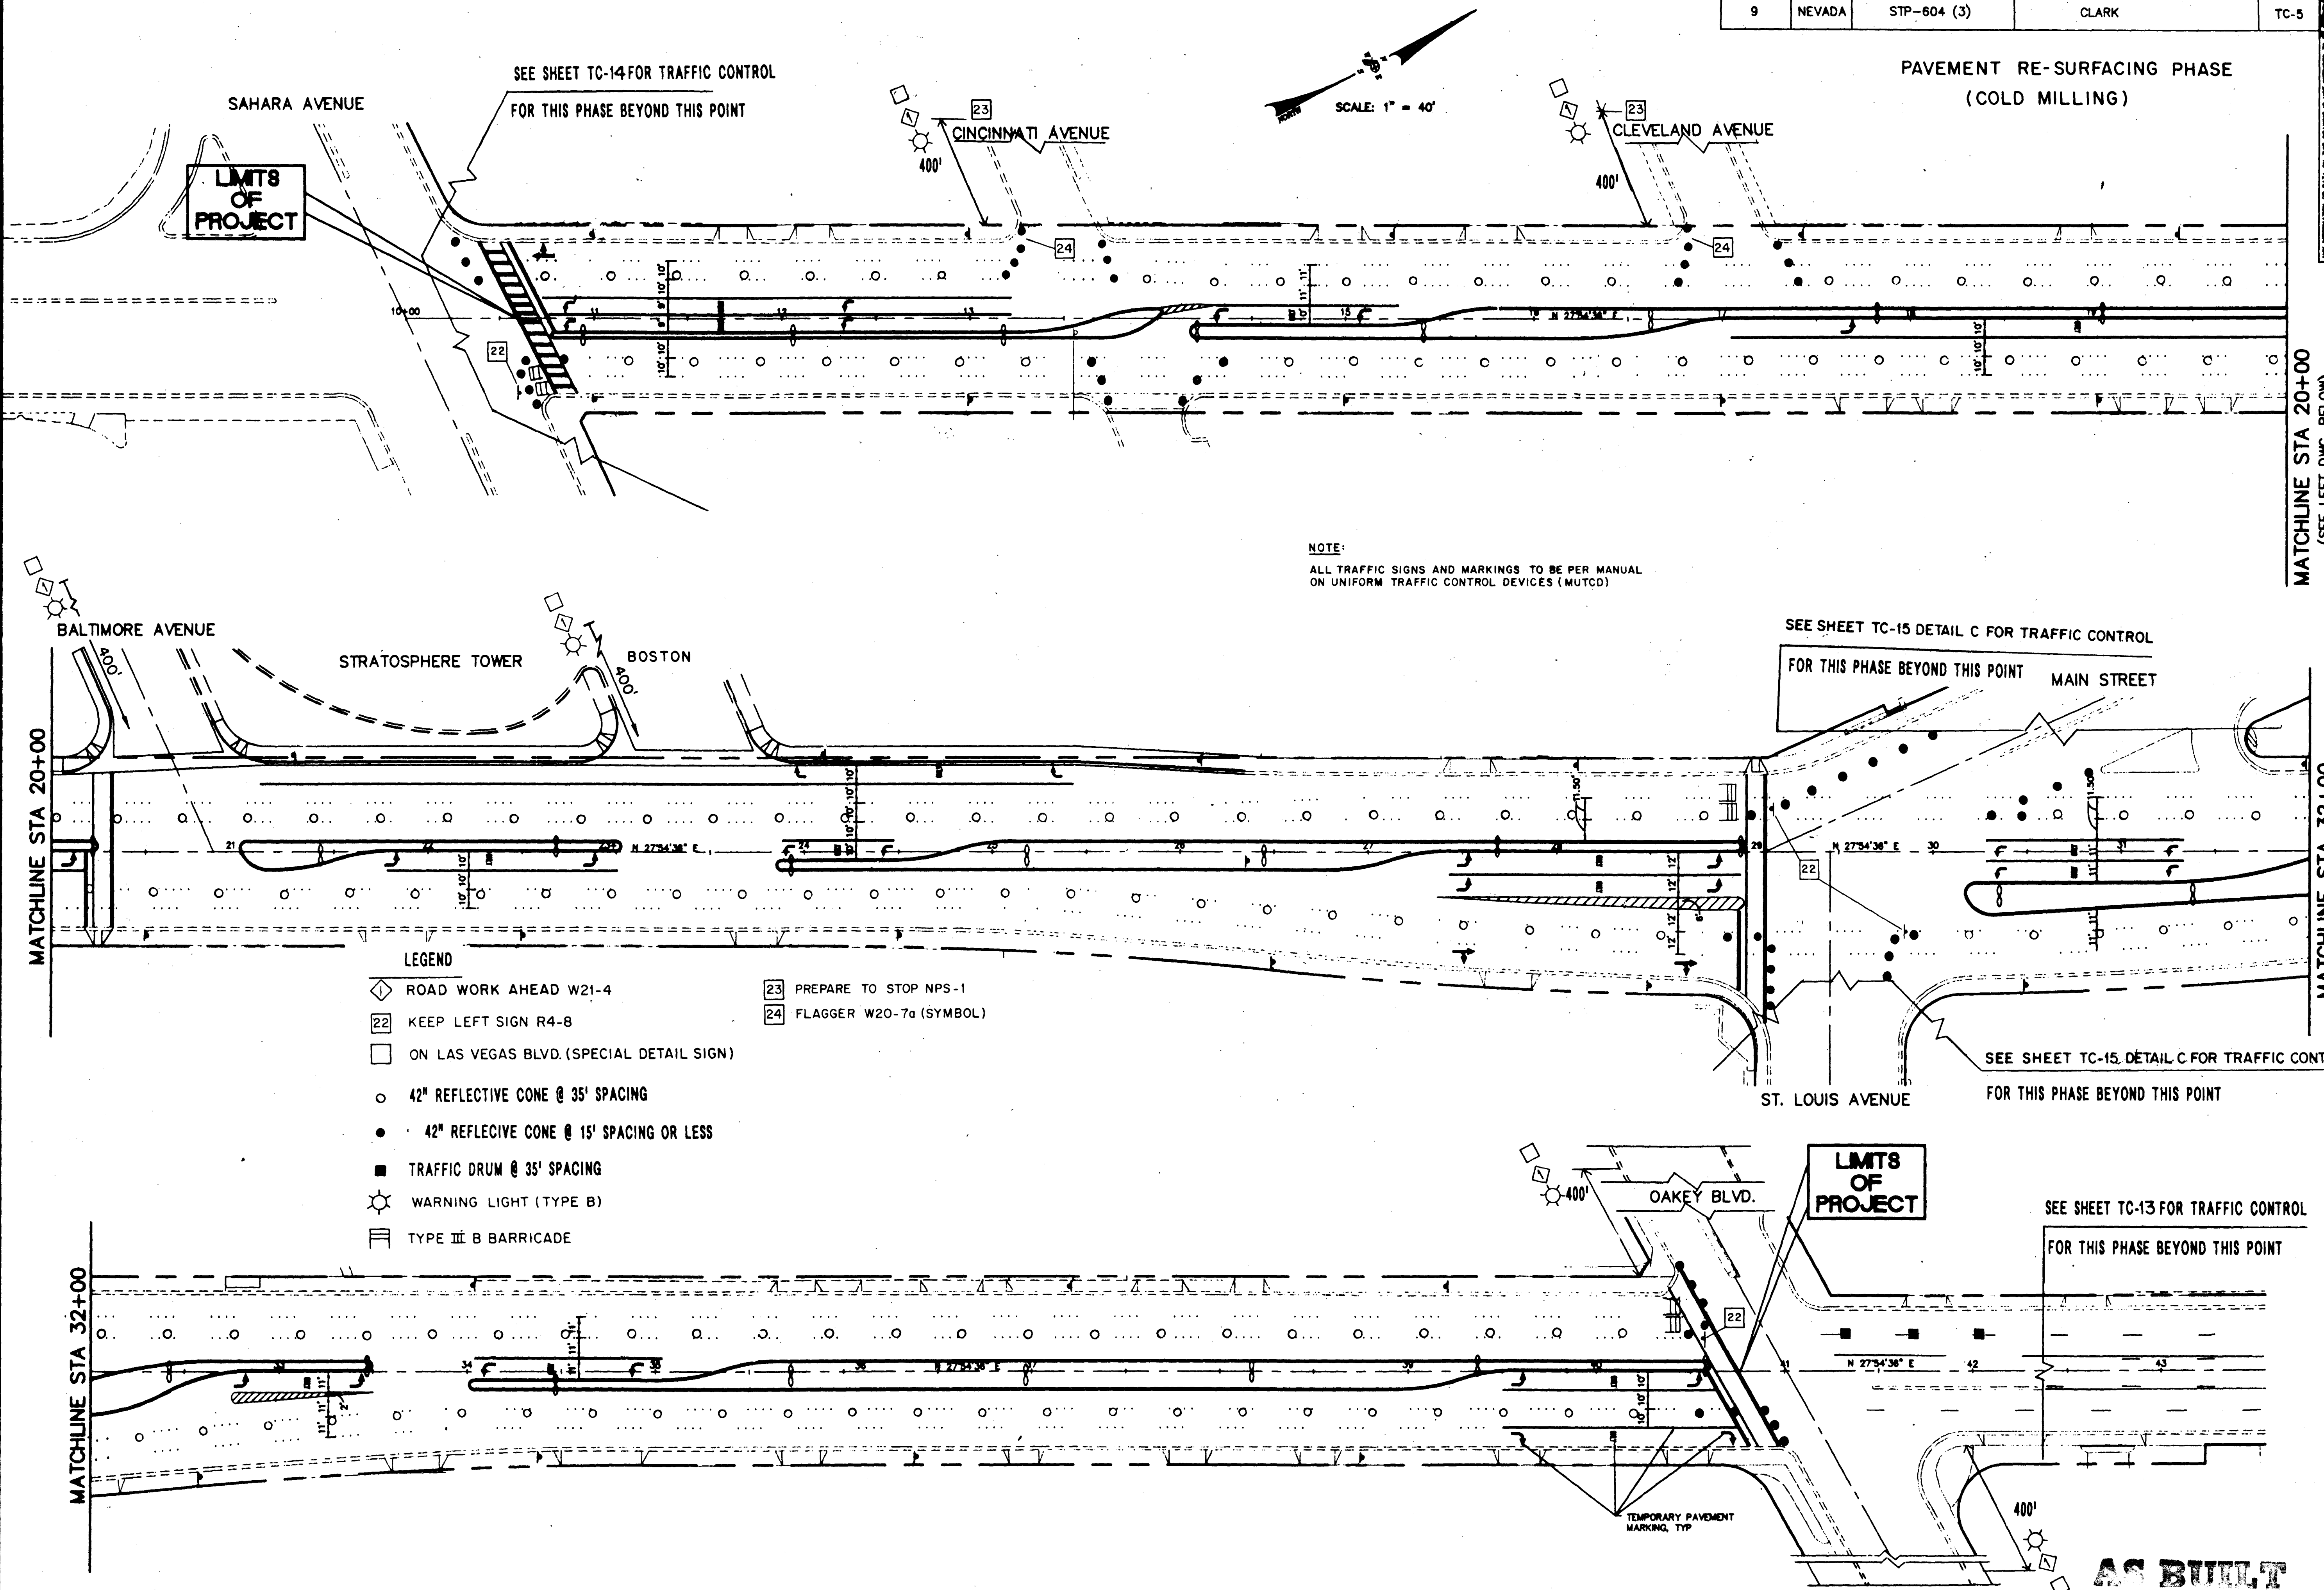

NOTE:
ALL TRAFFIC SIGNS AND MARKINGS TO BE PER MANUAL ON UNIFORM TRAFFIC CONTROL DEVICES (MUTCD)

- LEGEND**
- ROAD WORK AHEAD W21-4
 - KEEP LEFT SIGN R4-8
 - PREPARE TO STOP NPS-1
 - FLAGGER W20-7a (SYMBOL)
 - ON LAS VEGAS BLVD. (SPECIAL DETAIL SIGN)
 - 42" REFLECTIVE CONE @ 35' SPACING
 - 42" REFLECTIVE CONE @ 15' SPACING OR LESS
 - TRAFFIC DRUM @ 35' SPACING
 - WARNING LIGHT (TYPE B)
 - TYPE III B BARRICADE

DATE: _____

REVISIONS: _____

DESIGNED BY: DWS
DATE: 02-15-95

DRAWN BY: RAP
CHECKED BY: TEP

ENGINEERS: SURVEYORS: PLANNERS:

POGGEMEYER DESIGN GROUP

2601 NORTH TENAYA WAY LAS VEGAS, NEVADA 89128 (702) 255-8100

4 1995

DEPARTMENT OF PUBLIC WORKS

PROJECT: DOWNTOWN ENTRY CORRIDOR IMPROVEMENTS

SHEET: SAHARA AVENUE TO OAKLEY BOULEVARD TRAFFIC CONTROL PLAN

DRAWING NO. 24
TC-5

