FED. RD. REG. NO.	STATE	PROJECT NO.	COUNTY	SHEET NO.
9	NEVADA	STP-604 (3)	CLARK	TC-12

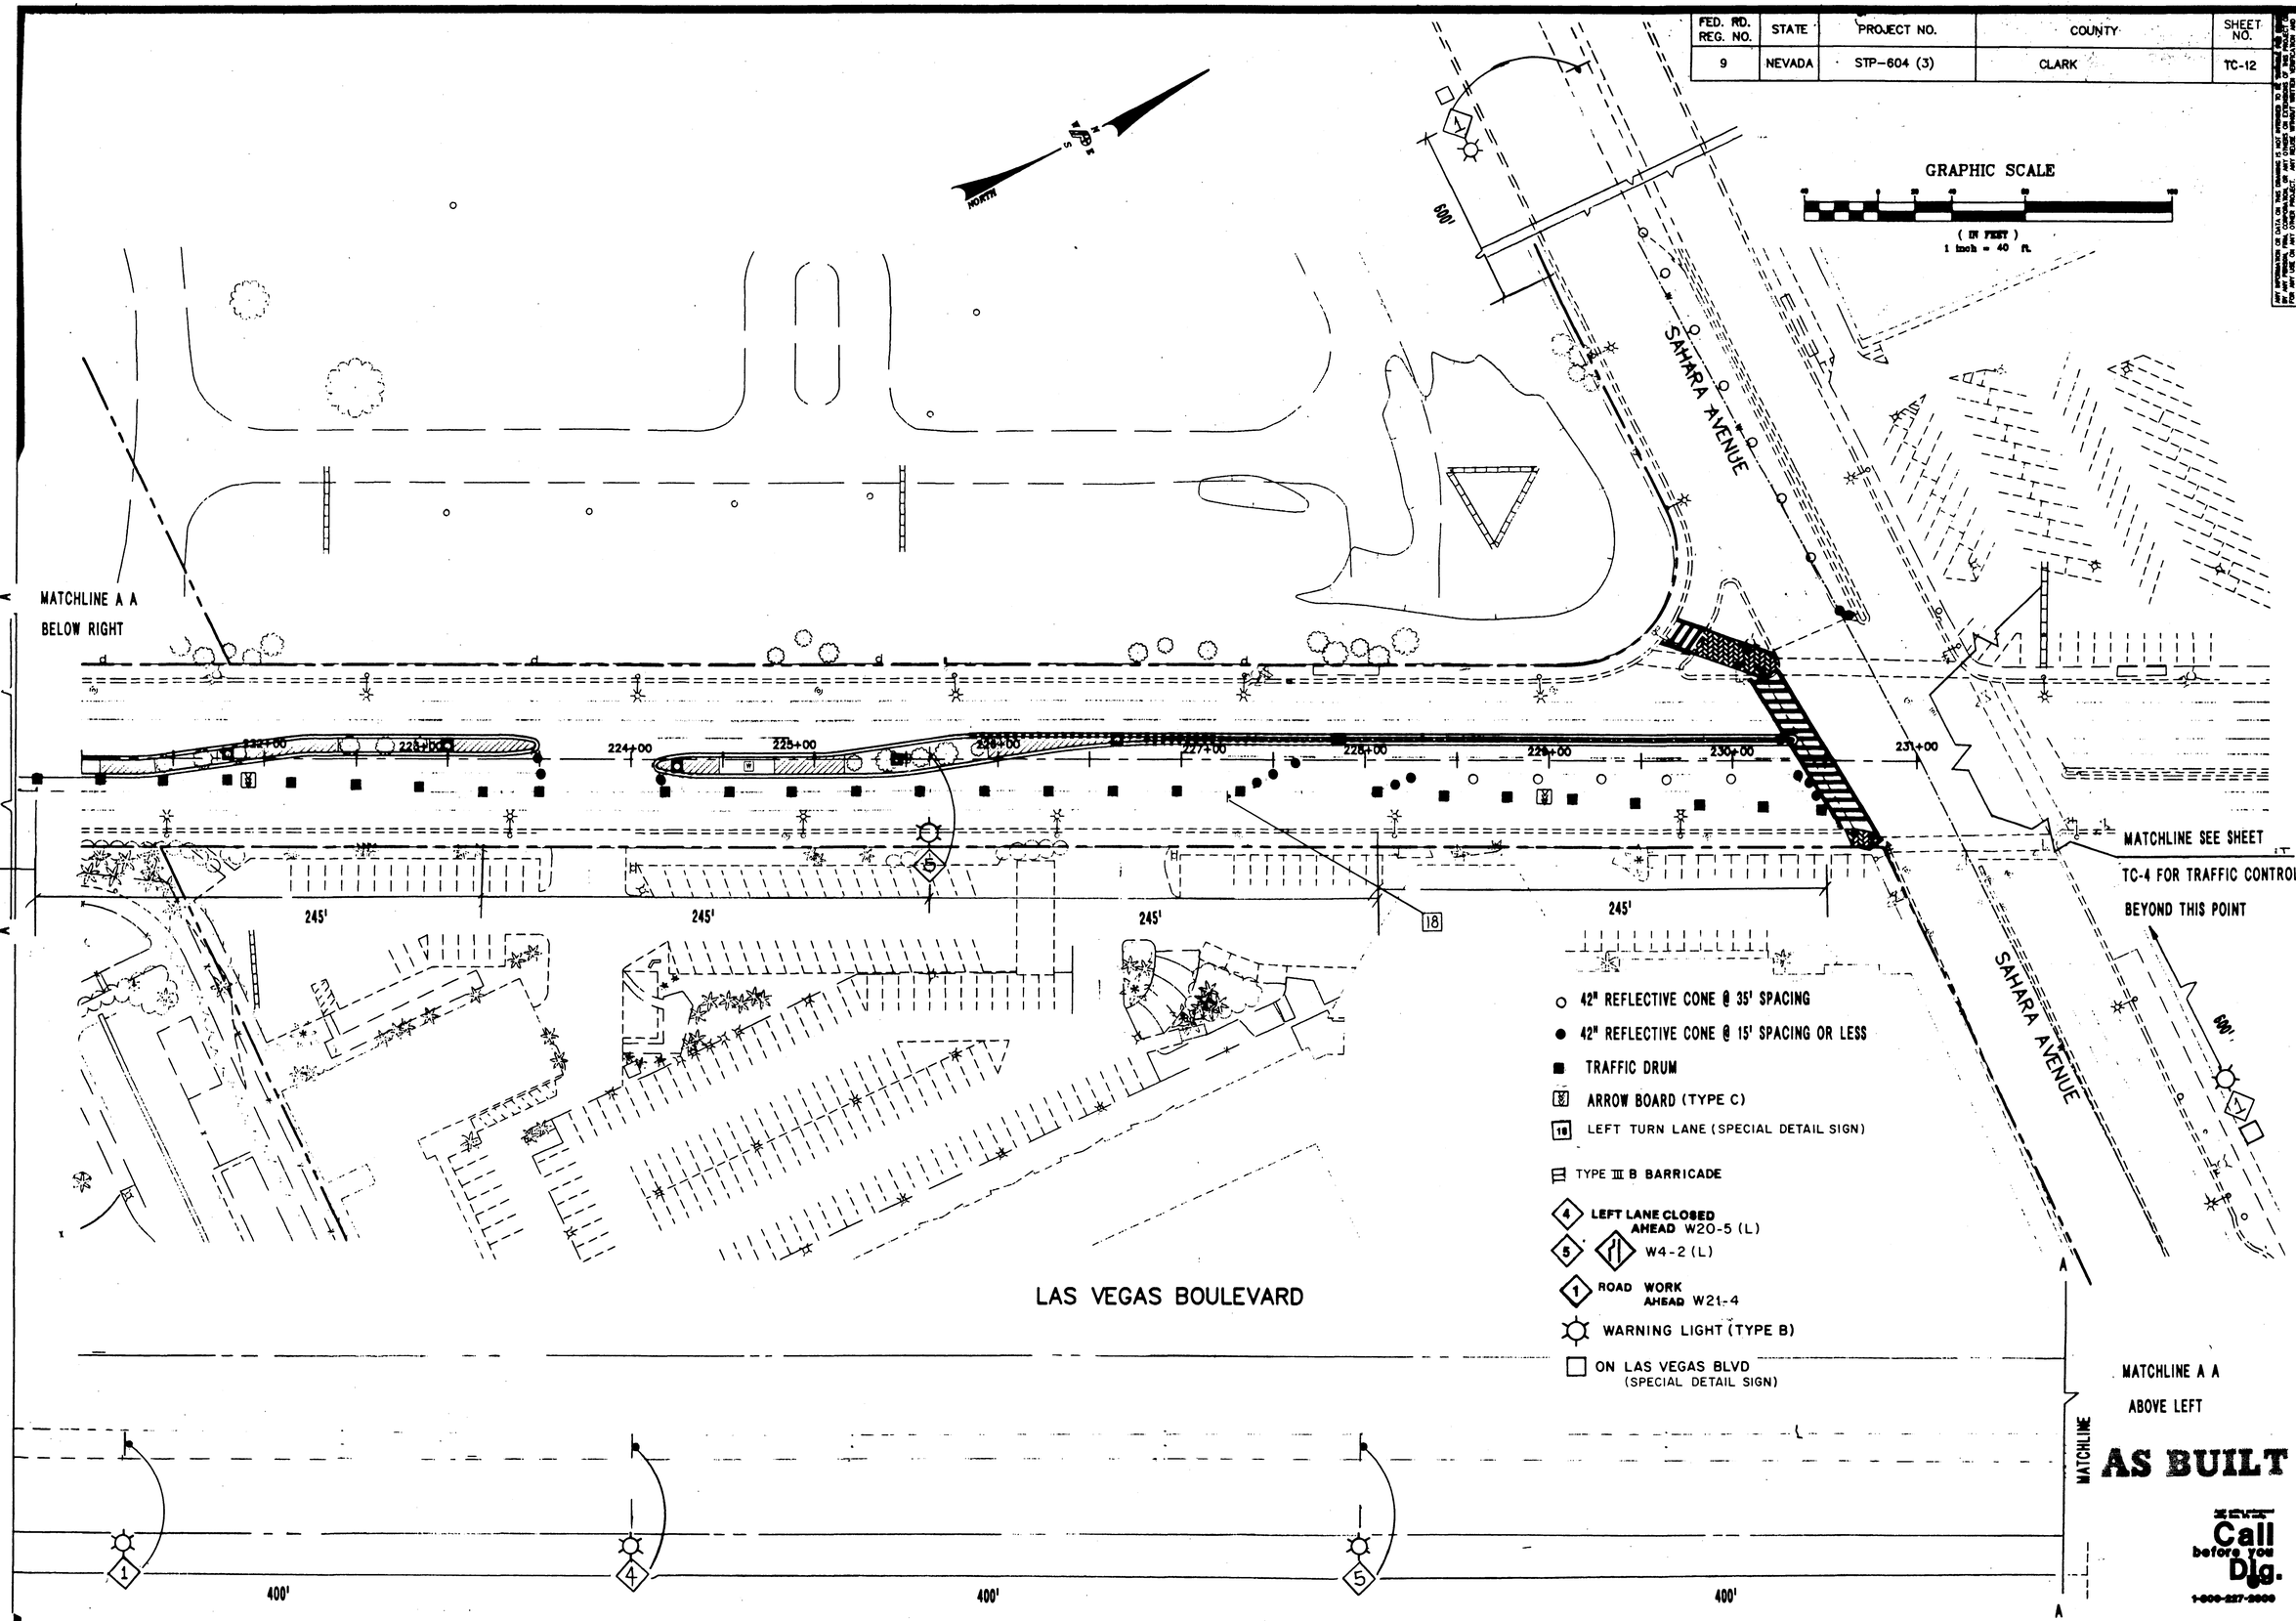

REVISIONS | DATE

DRAWN BY RAP
CHECKED BY TEP
DESIGNED BY DWS
DATE 04-21-95
JOB NUMBER 94144
SHEET #

POGGEMEYER DESIGN GROUP
ENGINEERS SURVEYORS PLANNERS
1140 ALMOND TREE LANE, SUITE 306 LAS VEGAS, NEVADA 89104 (702) 735-5108

DEPARTMENT OF PUBLIC WORKS

PROJECT: DOWNTOWN ENTRY CORRIDOR IMPROVEMENTS

SHEET: SAHARA AVENUE TO OAKEY BOULEVARD TRAFFIC CONTROL PLAN

CITY OF LAS VEGAS

DRAWING NO. TC-12

37/52

17349

367

107-V2288F

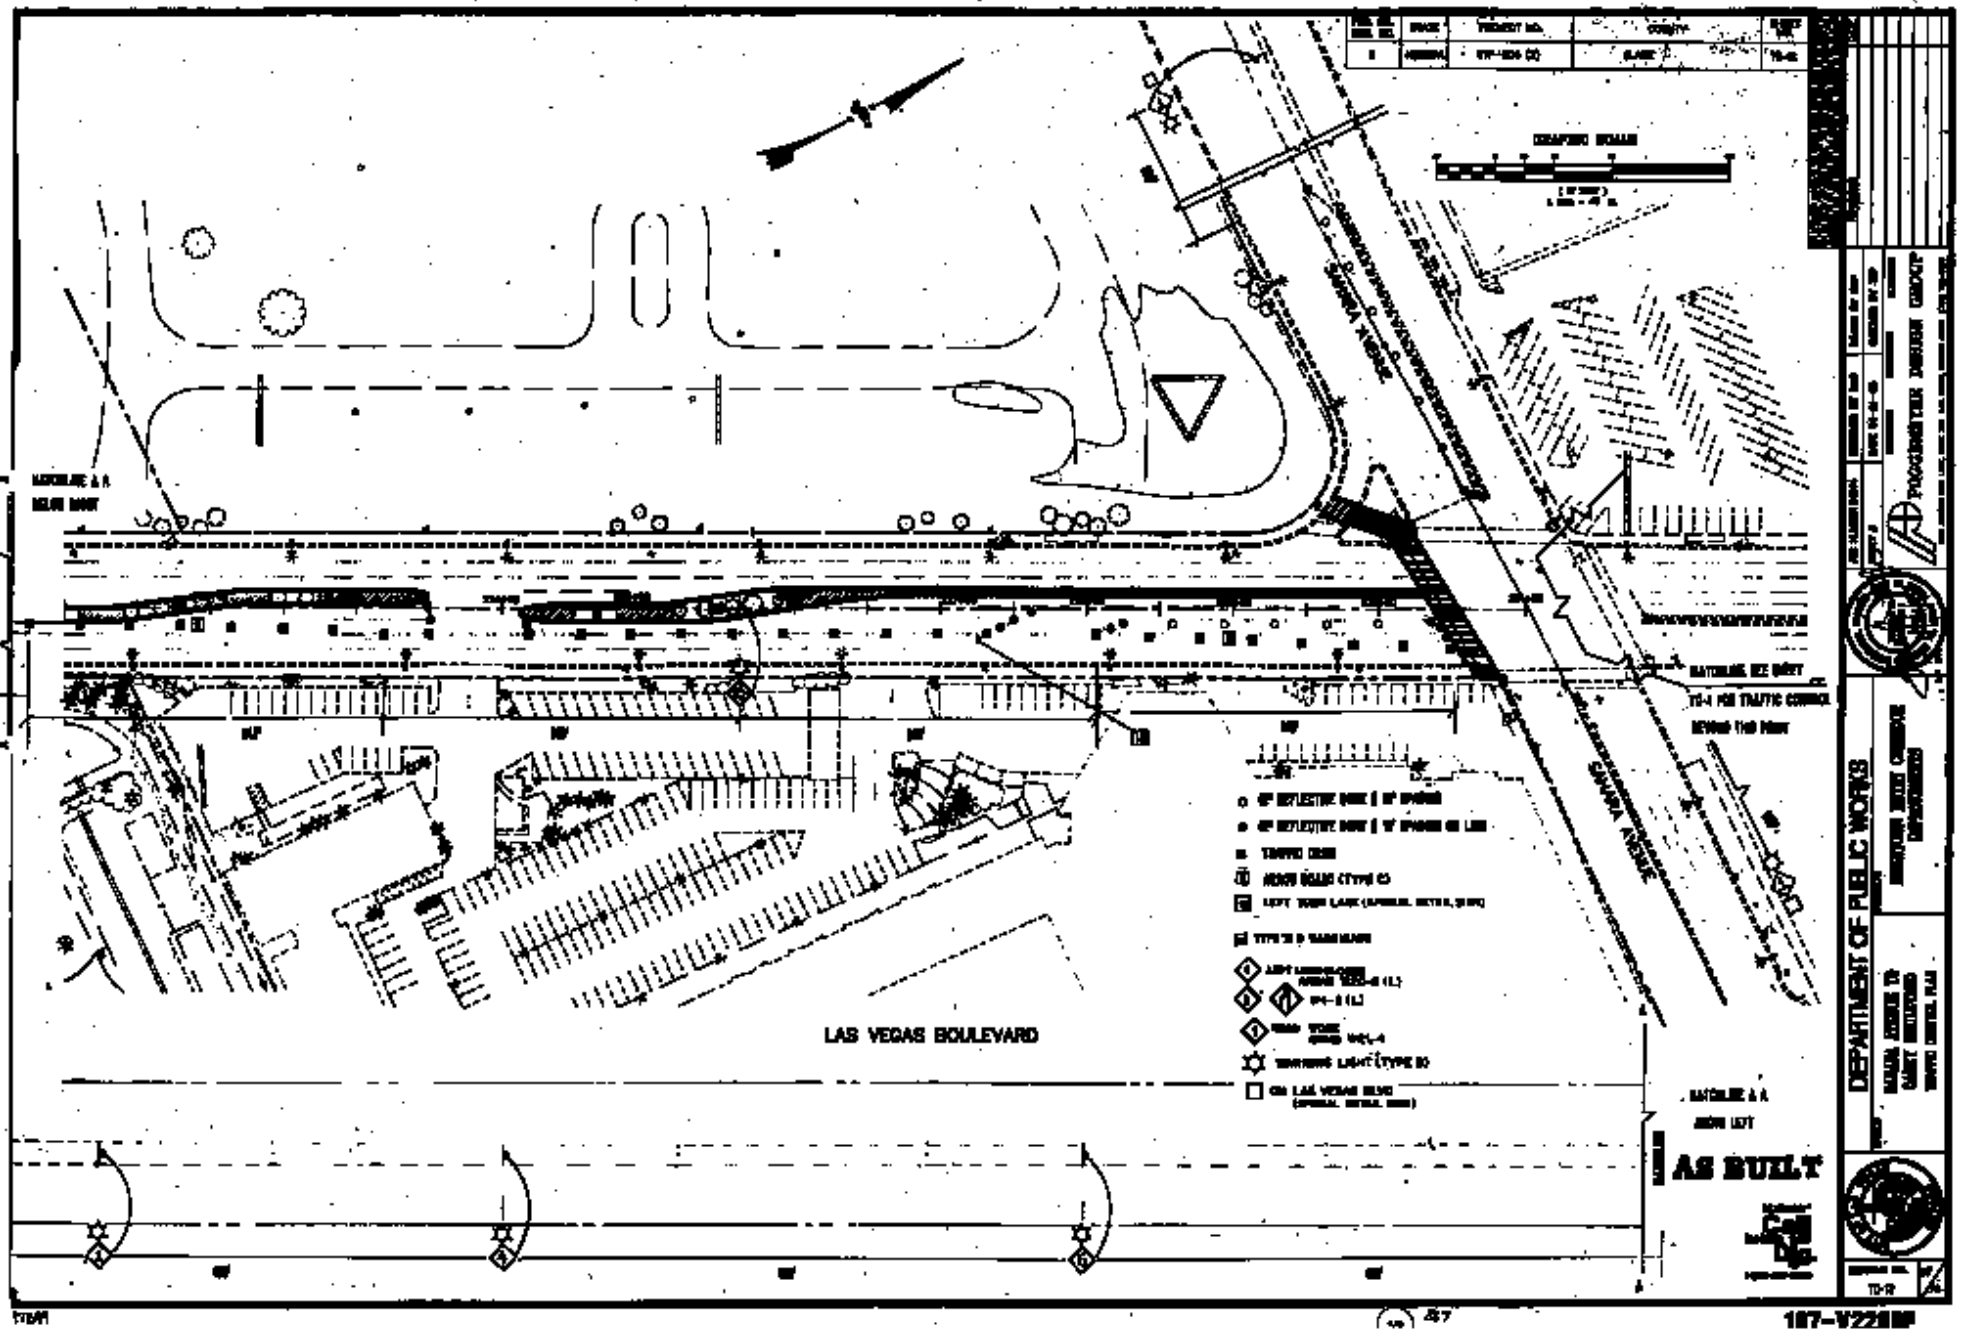
LAS VEGAS BOULEVARD
SAHARA AVENUE
SAHARA AVENUE
DEPARTMENT OF PUBLIC WORKS
AS BUILT