


MATCHLINE
STA. 16+00.00
SEE ABOVE RIGHT

MATCHLINE
STA. 16+00.00
SEE ABOVE RIGHT

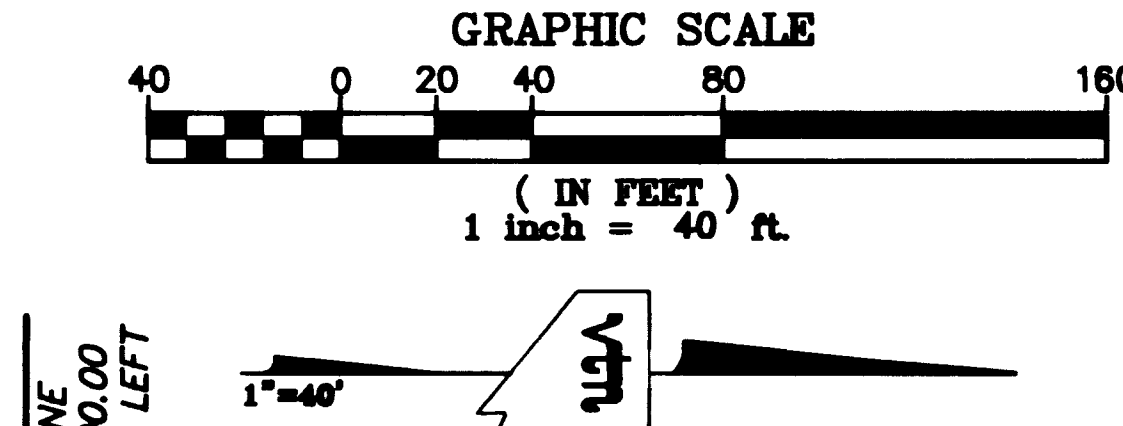

SIGNAGE AND DELINEATION LEGEND

- (A) INSTALL TYPE 4 LANE LINE DELINEATION USING TYPE "A" & "T" MARKERS PER USDOCCA STD. DWG. NO. 244A.
- (B) INSTALL WHITE TURN LANE STORAGE LINE DELINEATION USING TYPE "A" & "T" MARKERS PER USDOCCA STD. DWG. NO. 248.
- (C) INSTALL YELLOW TYPE 1 CENTERLINE DELINEATION PER USDOCCA STD. DWG. NO. 244.
- (D) INSTALL YELLOW TYPE 2 CENTERLINE DELINEATION PER USDOCCA STD. DWG. NO. 244.
- (E) INSTALL 24" WIDE STOP BAR USING WHITE COLD POLYMER FILM.
- (F) INSTALL 10' WIDE CROSSWALK USING WHITE COLD POLYMER FILM. SEE TYPICAL DETAIL ON SHEET T1.
- (G) INSTALL ARROWS AND "ONLY" USING WHITE COLD POLYMER FILM.
- (H) INSTALL YELLOW REFLECTIVE MEDIAN NOSE MARKERS PER USDOCCA STD. DWG. NO. 248.
- (I) INSTALL WHITE DROP LANE DELINEATION PER USDOCCA STD. DWG. NO. 248A.
- (J) INSTALL 4" TYPE II FILM MARKING.
- (K) EXISTING SIGN & POST TO REMAIN.
- (L) EXISTING SIGN ON STREET LIGHT POLE TO REMAIN.
- (M) EXISTING SIGN & POST TO BE REMOVED.
- (N) EXISTING SIGN ON STREET LIGHT POLE TO BE REMOVED.
- (O) INSTALL R3-7R "RIGHT LANE MUST TURN RIGHT" (30"x30").
- (P) INSTALL 0M-3R "OBJECT MARKER" SYMBOL (12"x36").
- (Q) INSTALL 24" WIDE CHEVRONS PER USDOCCA STD. DWG. 245.
- (R) INSTALL LIMIT 45" "SPEED LIMIT 45" (24"x30").
- (S) INSTALL W3-1A "STOP AHEAD" SYMBOL (36"x36").
- (T) INSTALL R1-1 "STOP SIGN" SYMBOL (30"x30").
- (U) INSTALL R6-3A "NO PARKING" (24"x24") SYMBOL & R7-1AP "ANY TIME W/ DOUBLE HEAD ARROW" SYMBOL (24"x24").
- (V) INSTALL R6-1R "ONE WAY" SYMBOL (36"x12").
- (W) INSTALL R3-2 "NO LEFT TURN" SYMBOL (24" x 24") & R3-4 "NO U-TURN" SYMBOL (24" x 24").

STREET LIGHTING LEGEND

- (1) INSTALL STREET LIGHT POLE AND FOUNDATION WITH 250w LUMINAIRE PER USDOCCA STD. DWG. NO. 314.
- (2) EXISTING STREET LIGHT POLE, FOUNDATION & LUMINAIRE TO REMAIN.
- (3) REMOVE EXISTING STREET LIGHT POLE AND LUMINAIRE AND RETURN TO THE CITY OF LAS VEGAS 3100 E. BONANZA.
- (4) INSTALL NO. 3-1/2 STREET LIGHT PULL BOX PER USDOCCA STD. DWG. NO. 326.
- (5) INSTALL NO. 5 STREET LIGHT PULL BOX PER USDOCCA STD. DWG. NO. 326.
- (6) INSTALL NO. 5 INTERCONNECT CONDUIT PULL BOX PER STD. DWG. 404.120 AT 300' MAXIMUM SPACING.
- (7) SEE TRAFFIC SIGNAL UNDERGROUND PLANS FOR INSTALLATION OF INTERSECTION LUMINAIRES.

WIRING AND CONDUIT LEGEND

- (1) INSTALL 1-1/4" CONDUIT WITH (2) #4 & (1) #6
- (2) INSTALL 1-1/4" CONDUIT ONLY
- (3) INSTALL 3" INTERCONNECT CONDUIT WITH PULL STRING.


NOTES

- 1. ALL WORK TO BE DONE IN ACCORDANCE TO THE UNIFORM STANDARD DRAWINGS AND SPECIFICATIONS FOR PUBLIC WORKS' CONSTRUCTION OFF-SITE IMPROVEMENTS CLARK COUNTY AREA NEVADA AS ADOPTED BY THE CITY OF LAS VEGAS.
- 2. ALL STREET LIGHTING WIRE AND CONDUIT IS 24, 1/8, 1 1/4" C UNLESS NOTED OTHERWISE. ALL STREET LIGHTING WIRE SHALL BE COPPER WITH THW INSULATION.
- 3. ALL PULLBOXES ARE NO. 3-1/2 UNLESS NOTED OTHERWISE.
- 4. FIELD VERIFY EXISTING UNDERGROUND CONDUIT AND PULLBOXES. UTILIZE EXISTING CONDUIT WHERE POSSIBLE AND INSTALL NEW CONDUIT AS REQUIRED PER PLANS.

ALL LANE DIMENSIONS ARE FROM FACE OF MEDIAN CURB TO LIP OF GUTTER OR EDGE OF A.C.

FROM STA. 13+50± LT. TO STA. 37+00 LT.
REFER TO ATTACHED POGGEMEYER SHEET R13
FOR TRAFFIC IMPROVEMENTS AND STREET LIGHTING
WEST OF DURANGO DRIVE CENTERLINE

CONTRACTOR SHALL BE RESPONSIBLE FOR PULLING INTERCONNECT CABLE FROM THE CONTROLLER ON THE CORNER OF CHEYENNE AVE AND SOARING GULLS DRIVE TO THE CONTROLLER ON THE NORTHWEST CORNER OF CHEYENNE AVENUE AND DURANGO DRIVE AND TO THE EXISTING PULL BOX AS SHOWN.

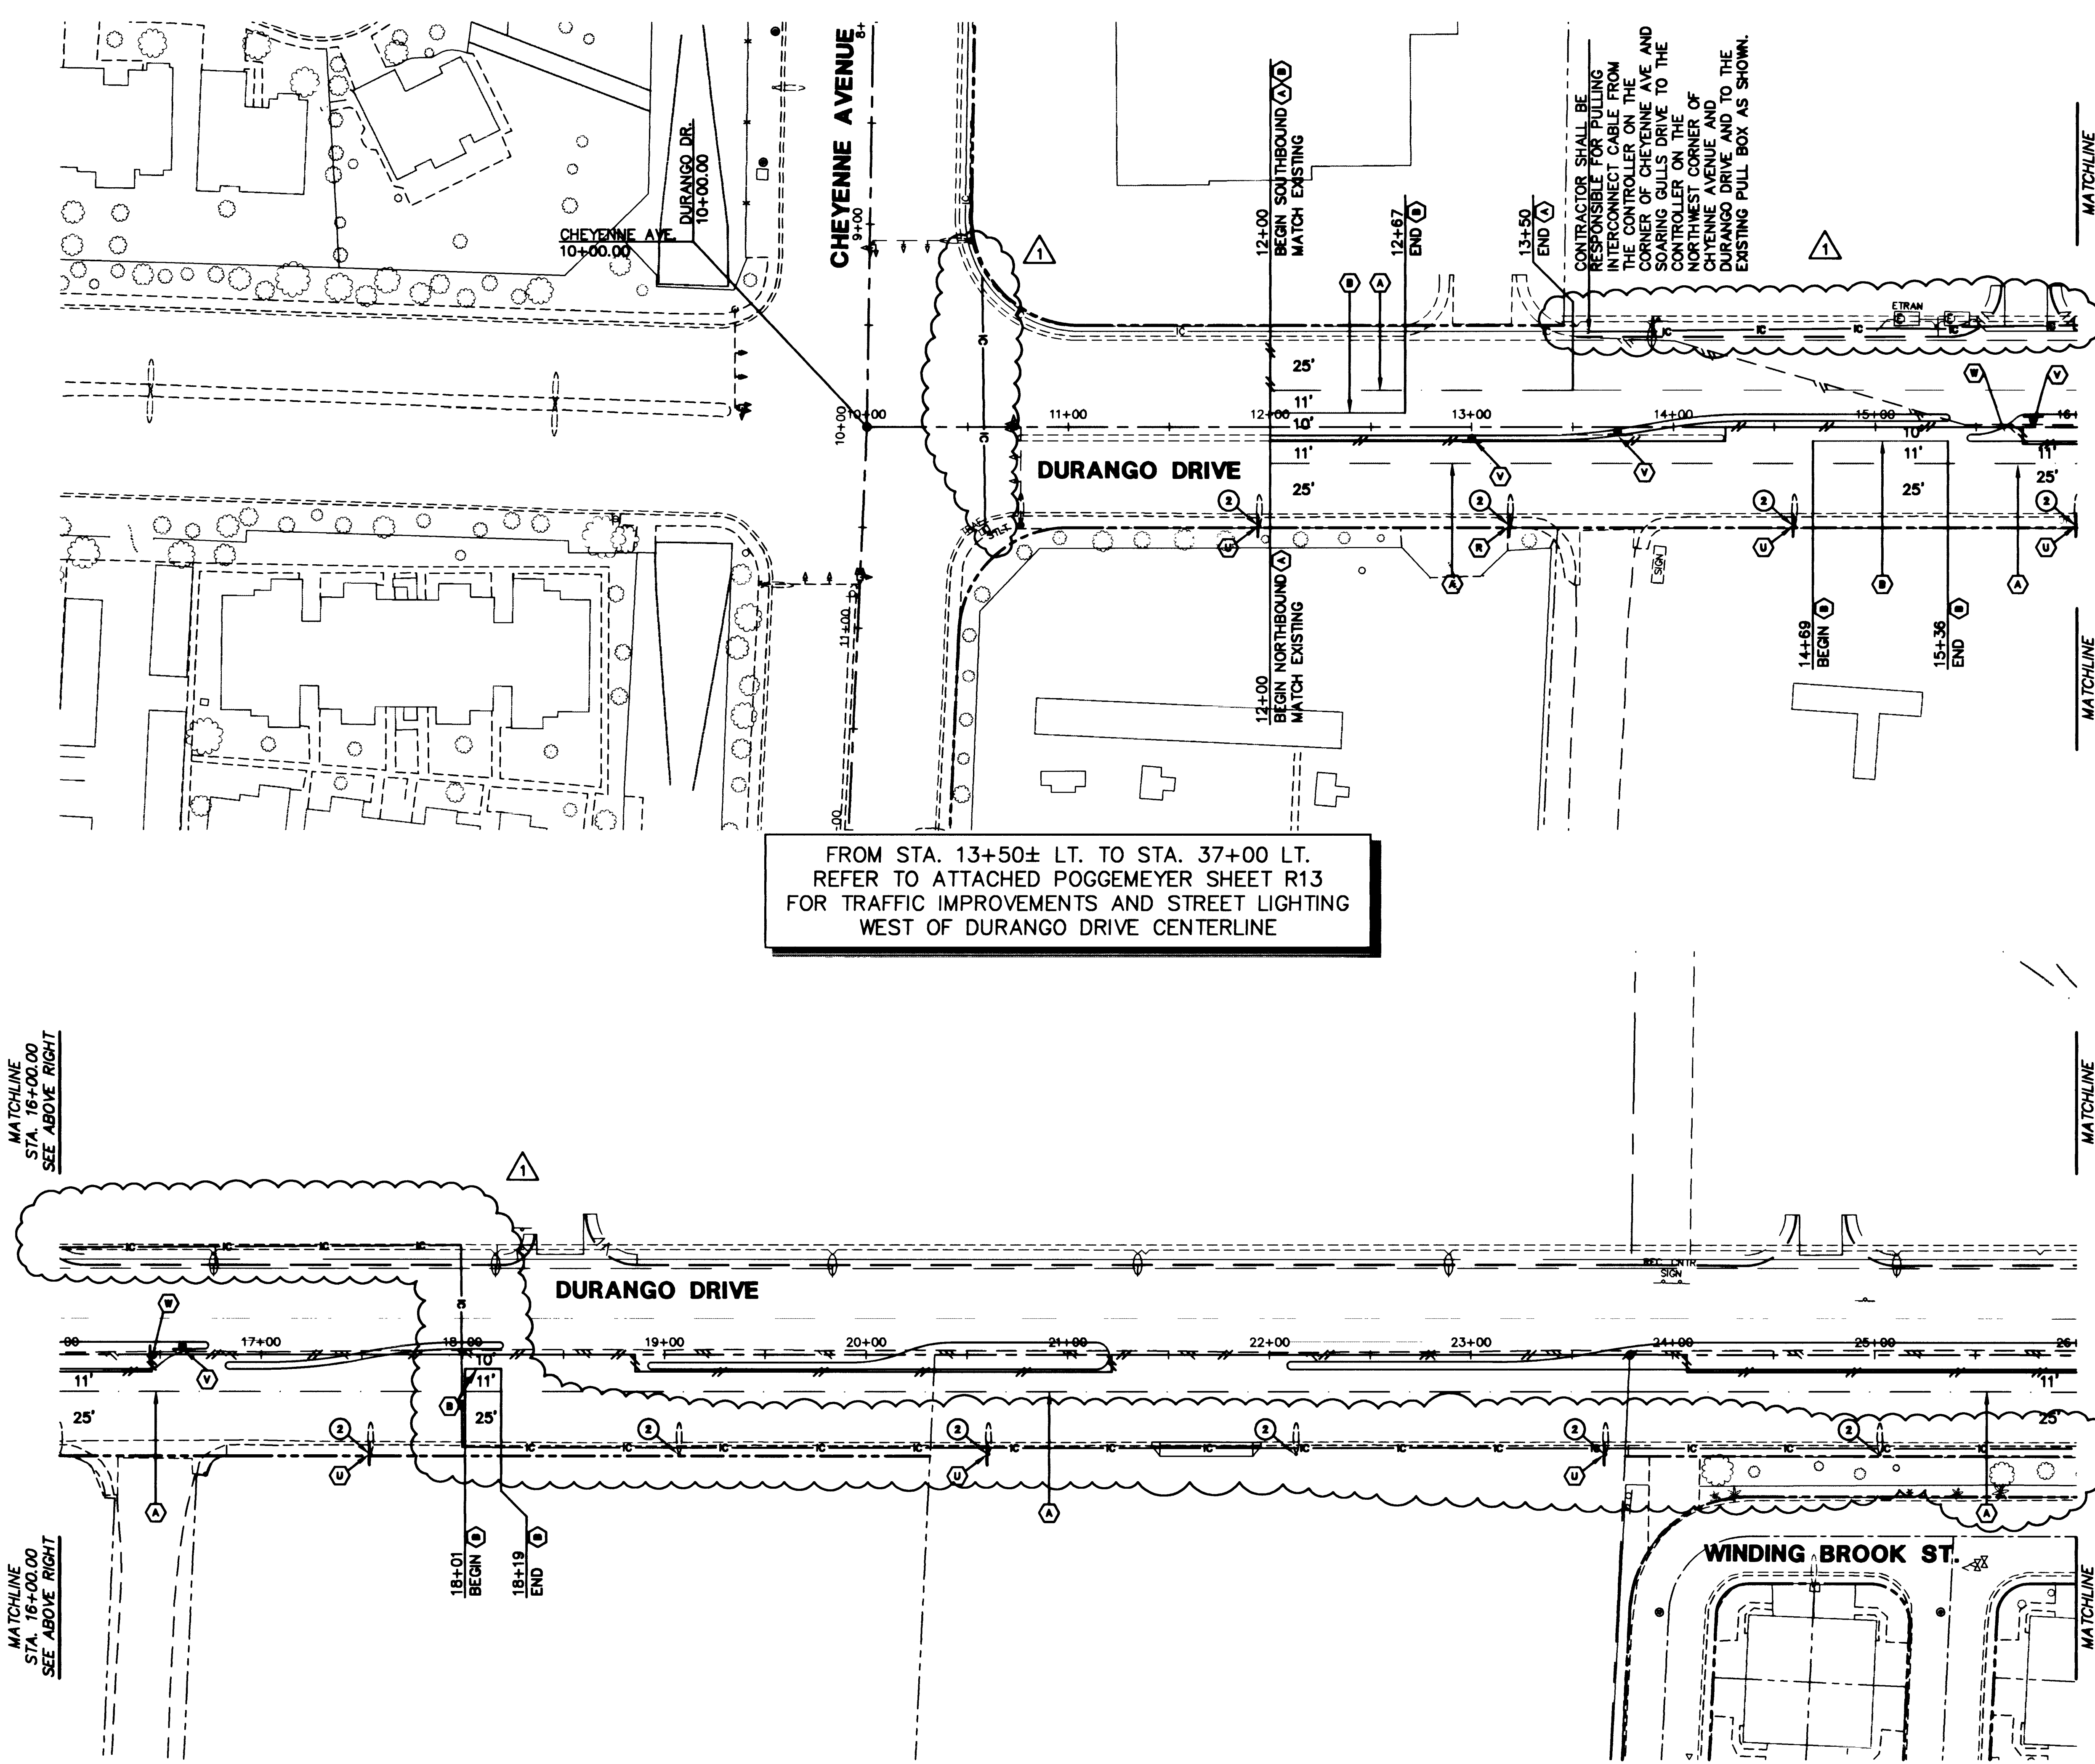

NO. 5249	REVISION
BY: RCH	DATE
DATE: 07/17/98	BY
SCALE: HORIZ. 1"=40'	REV
VERT. NONE	DATE
DRAWING: T3	REV
SHEET: 78	DATE
OF: 106	DATE
SHEETS	DATE

DEPARTMENT OF PUBLIC WORKS
CITY OF LAS VEGAS

CONSULTING ENGINEERS • PLANNERS • LAND SURVEYORS
2727 SOUTH RAINBOW BOULEVARD
LAS VEGAS, NEVADA 89102-5148 PHONE (702) 873-7550 FAX (702) 362-2597

vtn nevada

STRIPING & STREET LIGHTING PLAN
STA. 10+00.00 TO STA. 26+00.00
DURANGO ROAD
DURANGO DRIVE IMPROVEMENTS
CHEYENNE AVENUE TO LONE MOUNTAIN ROAD

SEAL

NO. 5249
RCH
BY: TMM, WBM
DATE: 07/17/98
SCALE: HORIZ. 1"=40'
VERT. NONE
DRAWING: T3
SHEET: 78
OF: 106
SHEETS