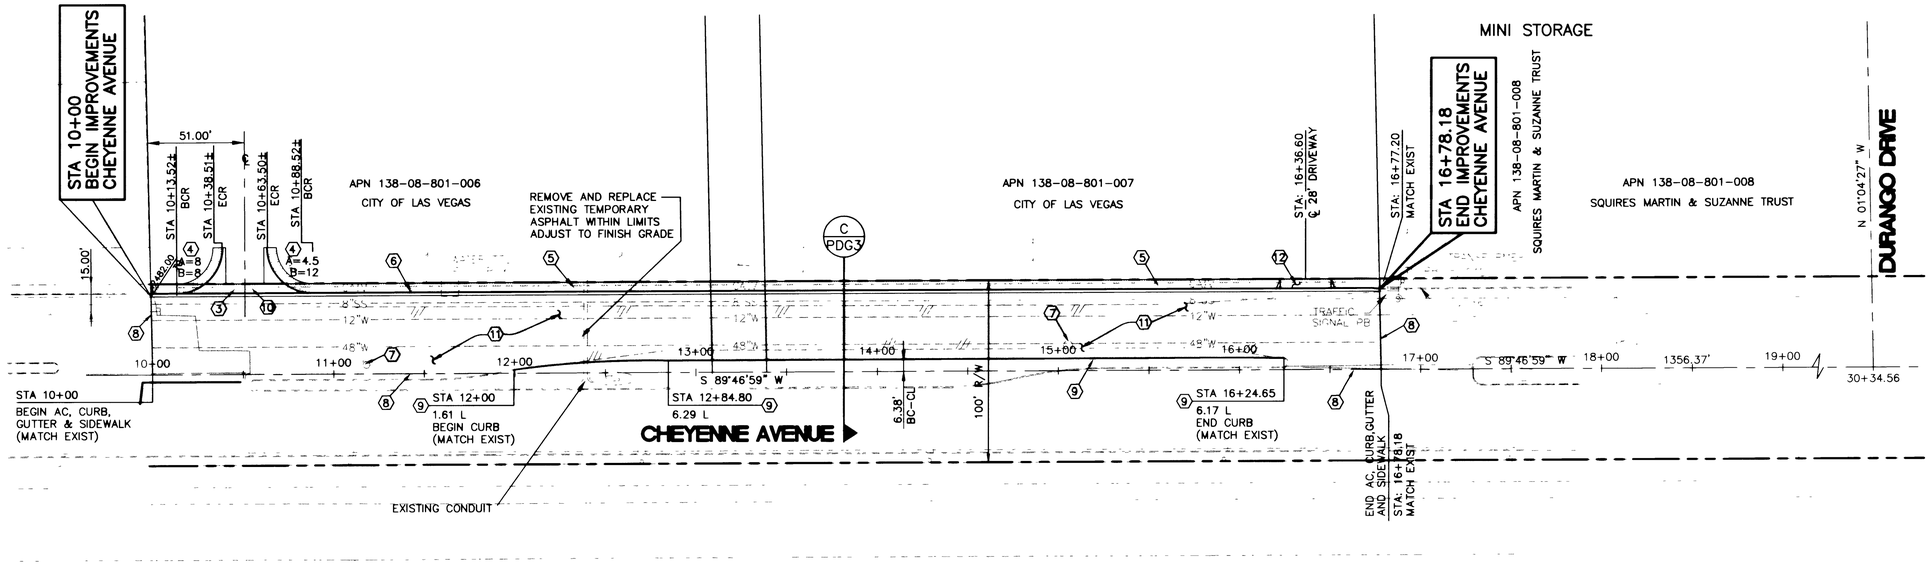

PLAN – CHEYENNE AVE.

SCALE: HORZ 1" = 40'

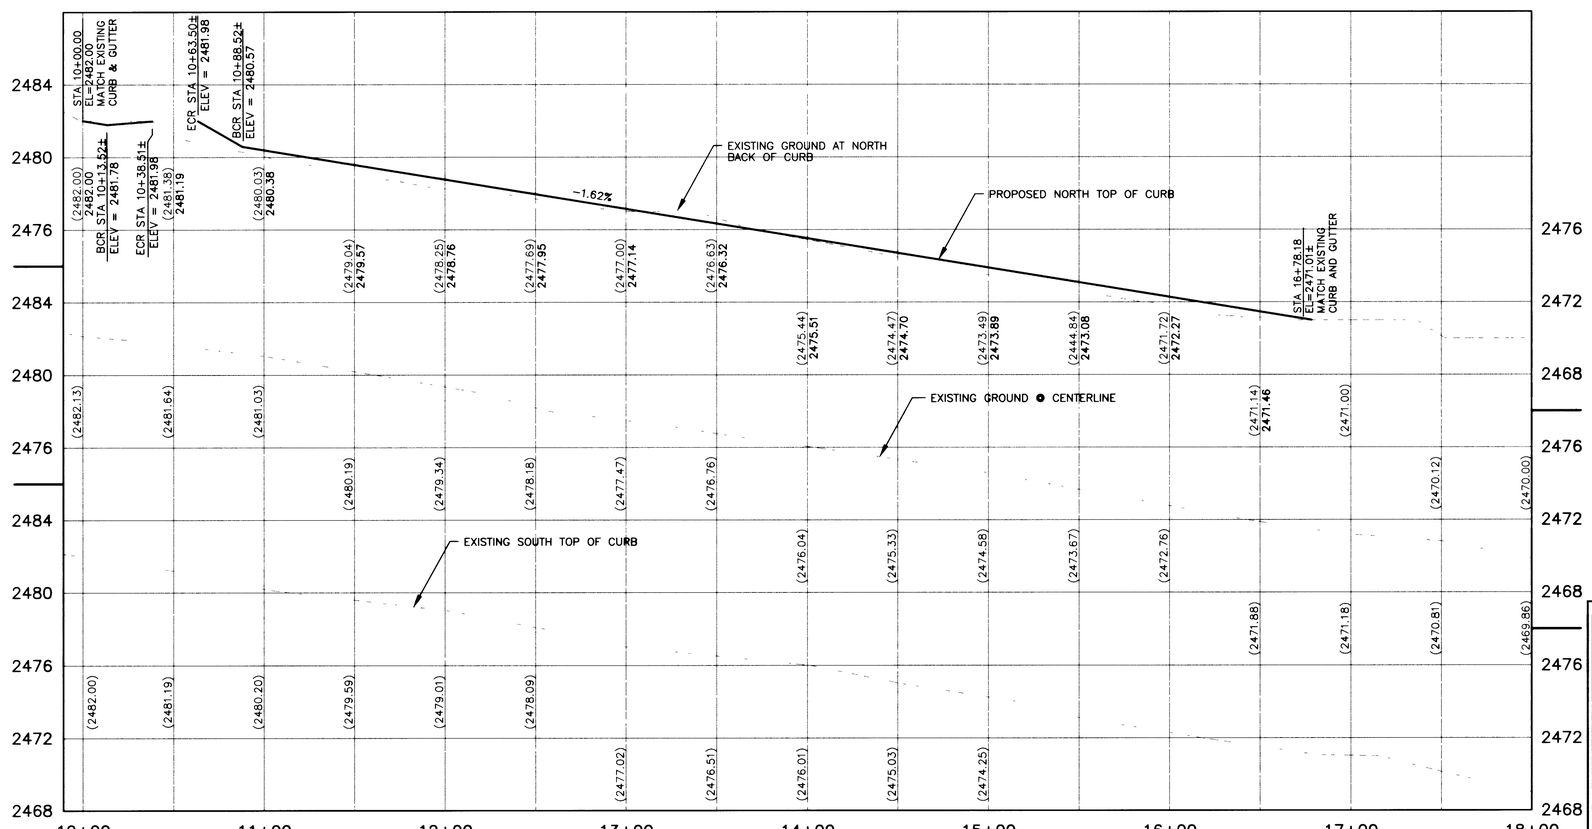

PROFILE – CHEYENNE AVE

SCALE: HORZ 1" = 40'
VERT 1" = 4'

GRAPHIC SCALE

(IN FEET)
1 inch = 40 ft.

CONSTRUCTION KEYNOTES

1. CONSTRUCT 5" ASPHALTIC CONCRETE OVER 8" OF TYPE II AGGREGATE BASE IN ACCORDANCE WITH DETAIL NO A/PDG3
2. RELOCATE EXISTING F.H. AS SHOWN HEREON
3. CONSTRUCT COMMERCIAL DRIVEWAY ENTRANCE PER CLARK COUNTY AREA STD DWG NO. 225
4. CONSTRUCT HANDICAP RAMP PER CLARK COUNTY AREA STD DWG NO. 235 CASE I
5. CONSTRUCT SIDEWALK IN ACCORDANCE WITH USD NO. 234.
6. CONSTRUCT "L" TYPE CURB AND GUTTER IN ACCORDANCE WITH USD NO. 216.
7. ADJUST TO GRADE IN ACCORDANCE WITH USD NO. 408 (MANHOLES) NO. 517 (VALVE BOX) NO. 506 (METER BOX).
8. SAWCUT EXISTING PAVEMENT AND MATCH EXISTING, AS SHOWN HEREON
9. CONSTRUCT "A" TYPE CURB IN ACCORDANCE WITH USD NO. 219
10. CONSTRUCT 8' CROSS GUTTER PER CLARK COUNTY AREA STD AREA DWG NO. 228
11. CONSTRUCT 4" ASPHALTIC CONCRETE OVER 8" OF TYPE II AGGREGATE BASE IN ACCORDANCE WITH DETAIL NO B/PDG3
12. CONSTRUCT 28' COMMERCIAL DRIVEWAY PER CLARK COUNTY AREA STD AREA DWG NO. 224

RECORD DRAWINGS
NOT FOR CONSTRUCTION

1. TO ALTER THESE DOCUMENTS FOR ANOTHER PROJECT BY ANYONE OTHER THAN THE ORIGINAL ARCHITECT IS A VIOLATION OF NRS 623.
2. THIS RECORD DRAWING HAS BEEN PREPARED IN PART, BASED UPON INFORMATION FURNISHED BY THE GENERAL CONTRACTOR. WHILE THIS INFORMATION IS BELIEVED TO BE RELIABLE, THE DESIGN PROFESSIONAL CANNOT ASSURE ITS ACCURACY, AND THUS IS NOT RESPONSIBLE FOR THE ACCURACY OF THIS RECORD DRAWING OR FOR ANY ERRORS OR OMISSIONS WHICH MAY HAVE BEEN INCORPORATED INTO IT AS A RESULT. THE DESIGN PROFESSIONAL CANNOT AND DOES NOT WARRANT THEIR ACCURACY.
3. INFORMATION THAT MAY BE INCLUDED WOULD BE SIGNIFICANT CHANGES TO ROOM ARRANGEMENTS ON THE FLOOR PLANS AND ASSOCIATED DRAWINGS, MINOR DIMENSION OR CONSTRUCTION DETAIL CHANGES MAY NOT BE INCLUDED.

CONTRACTOR _____ DATE _____

Avoid cutting underground utility lines. It's costly.

Call before you Dig
1-800-227-2600

ENGINEERS PLANNERS SURVEYORS
LANDSCAPE ARCHITECTS
POGGEMEYER DESIGN GROUP
2601 NORTH TENAYA WAY
LAS VEGAS, NEVADA 89128 (702) 255-8100

GREELEY AND HANSEN
ENGINEERS
4625 SOUTH POLARIS AVENUE, SUITE 210
LAS VEGAS, NEVADA 89103 (702) 736-7062
322-83

DESIGNED	SW
DRAWN	FT
CHECKED	MBH
APPROVED	

REGISTERED PROFESSIONAL ENGINEER STATE OF NEVADA
STEPHEN L. WEATHERMAN
CIVIL
No. 9266

NO.	DATE	APPD	REVISION

CITY OF LAS VEGAS, NEVADA
DEPARTMENT OF PUBLIC WORKS
NORTHWEST WATER RESOURCE CENTER
100% DESIGN

ROADWAY IMPROVEMENTS
CHEYENNE AVENUE – STA 10+00 TO 20+00
PLAN AND PROFILE

PROJ NO.	7190
DWG	PDG 9
SHEET	9 OF 13
DATE	07.21.98
REV	0

FILE: GHBLOCKS SCALE: 1:1 03/25/1997 at 09:34 - CADD-002 *13_c4*

107-V2884